

**SURVEYOR'S CERTIFICATE**


I, GERALD L. WIRTHLIN, A PROFESSIONAL LAND SURVEYOR IN THE STATE OF NEVADA, DO HEREBY CERTIFY THAT THE MONUMENTS HAVE BEEN SET AND THE TIE DISTANCES ESTABLISHED AS SHOWN HEREON. THIS SURVEY WAS COMPLETED ON JANUARY 21, 1997.

GERALD L. WIRTHLIN  
PROFESSIONAL LAND SURVEYOR  
NEVADA CERTIFICATE No. 7008




**LEGEND**


- SET TYPE III MONUMENT, PLS 7008
- SET TYPE IV MONUMENT, PLS 7008
- CENTERLINE
- BOUNDARY LINE
- ..... TIE DIMENSION

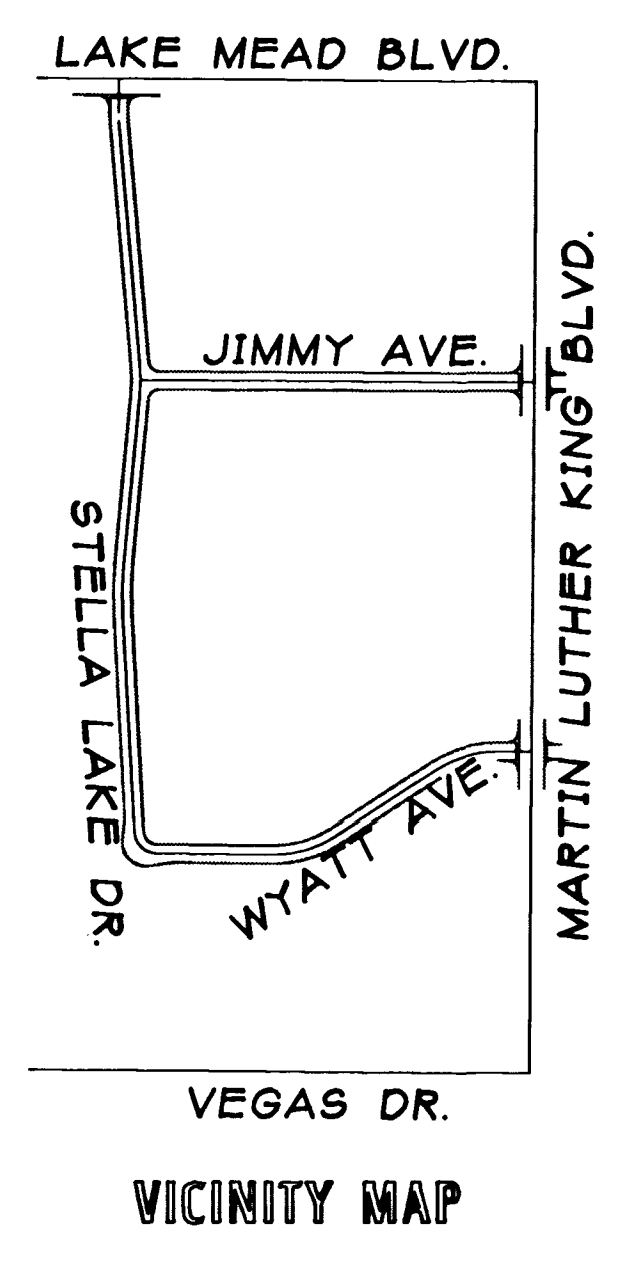

VICINITY MAP

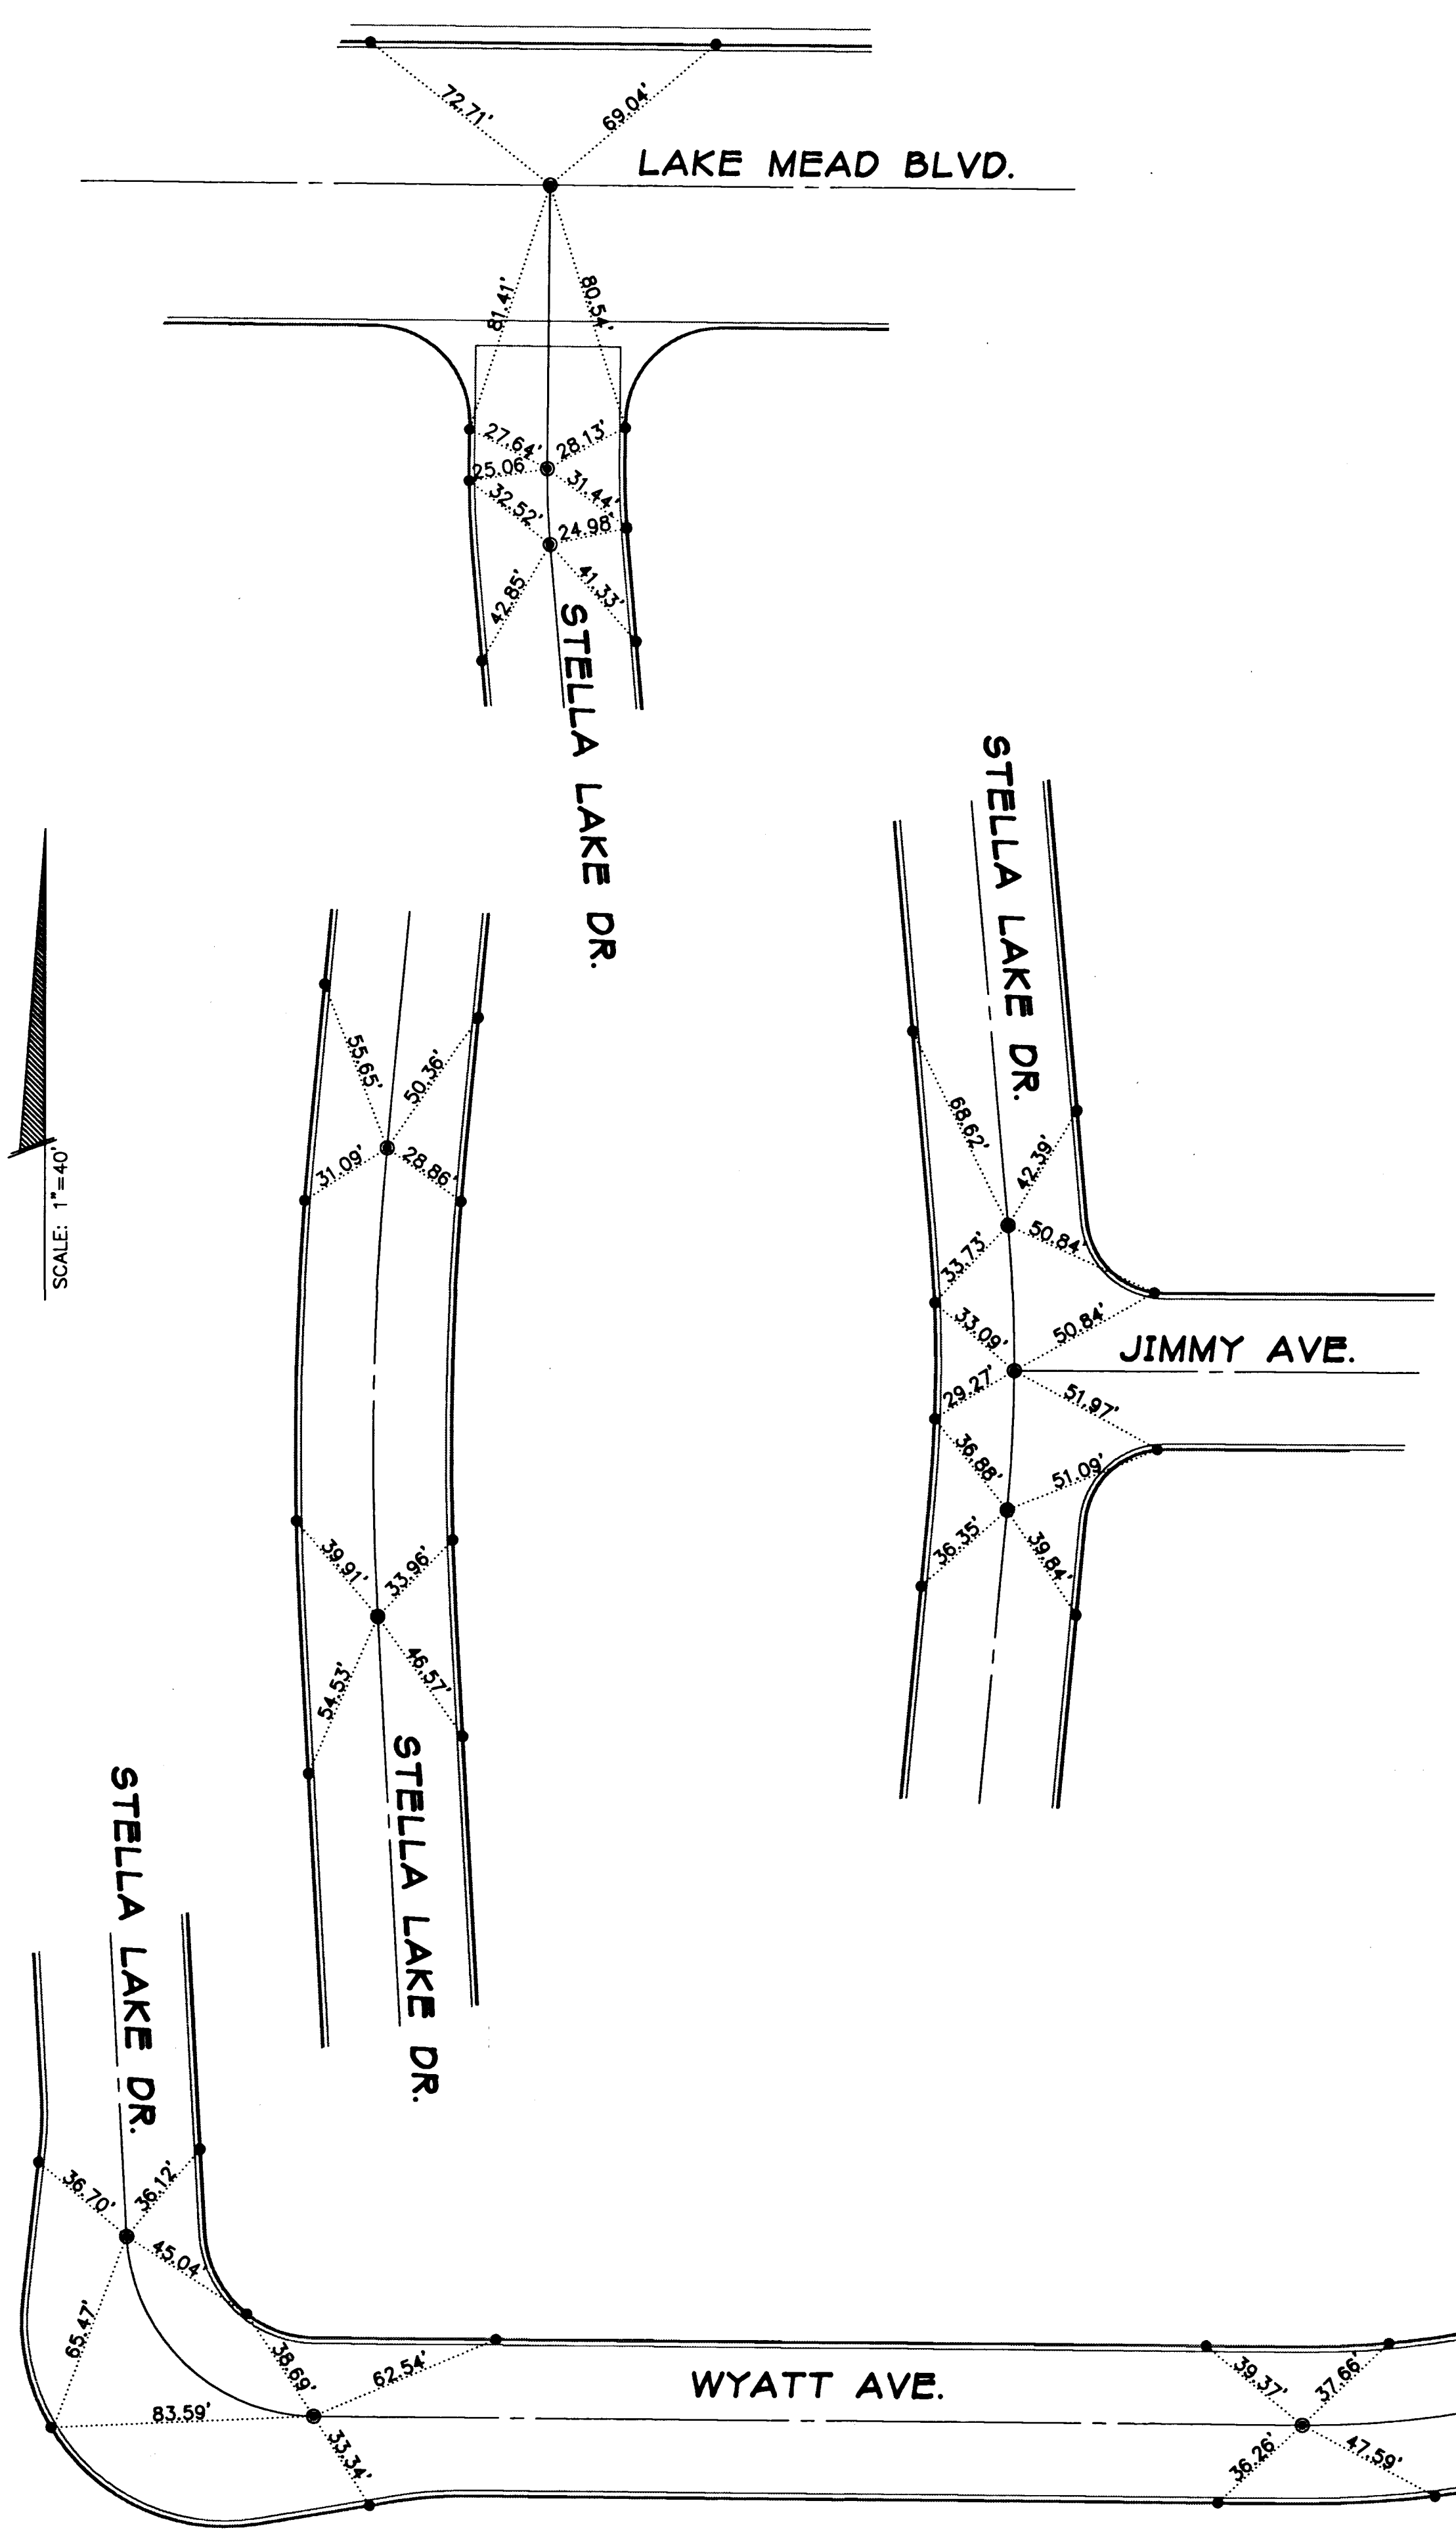

SCALE: 1"=40'

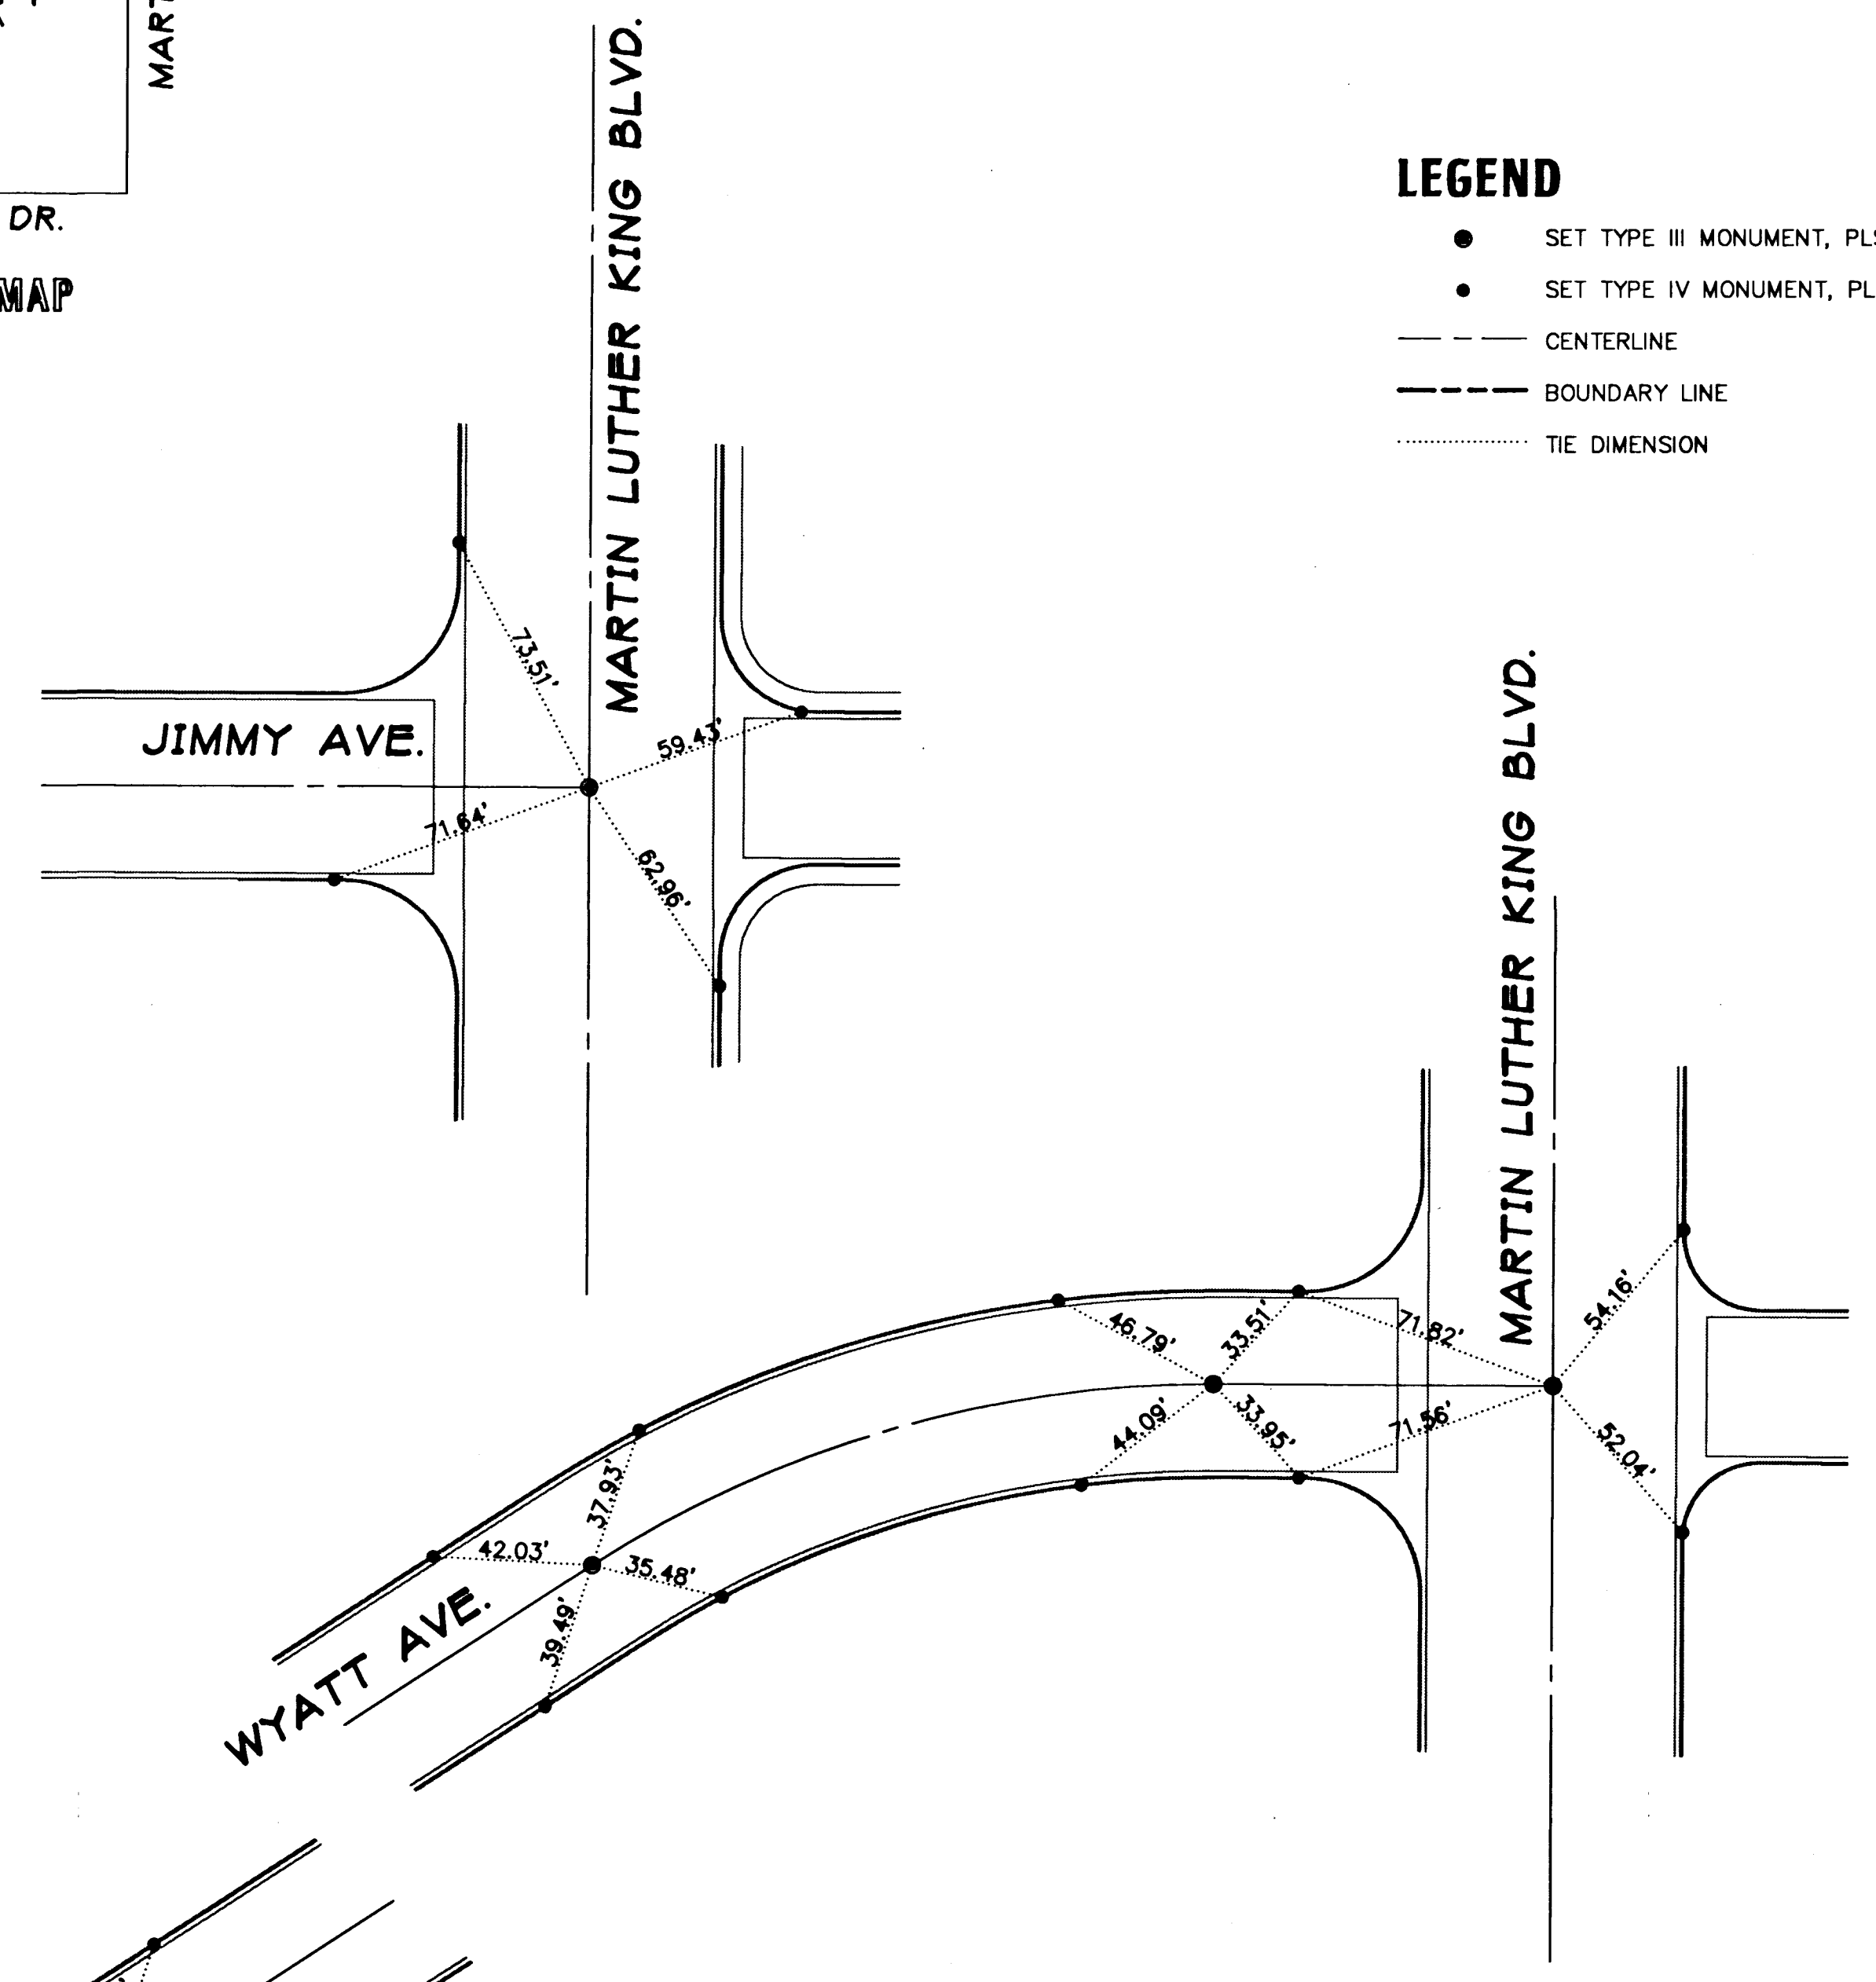

<b>MONUMENTATION / TIE MAP</b>	
A PORTION OF THE E 1/2 OF THE SW 1/4 OF SECTION 21, TOWNSHIP 20 SOUTH, RANGE 61 EAST, M.D.M. CLARK COUNTY, NEVADA	
<b>LAS VEGAS ENTERPRISE PARK</b>	
LAS VEGAS PAVING CORP. GERALD "CROCKETT" WIRTHLIN PLS #7008	1 of 1 OFFICE 379-9362 MOBILE 058-4442













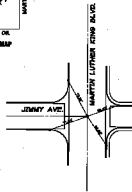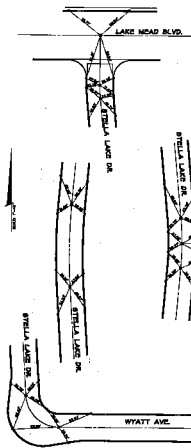




