


2050



# CITY OF LAS VEGAS ENGINEERING DEPT.

Approval of this plan by the City of Las Vegas, Nevada, does not relieve the Subdivider of responsibility for errors in calculation, design, or planning by the Subdivider's Engineer or Surveyor.







**APPROVED AS TO DESIGN ONLY**  
Contractor will be responsible for all details, dimensions and conformity to the design drawings.  
By: KCH  
City of Las Vegas, Nevada  
Office of the City Engineer  
Approved by: [Signature]  

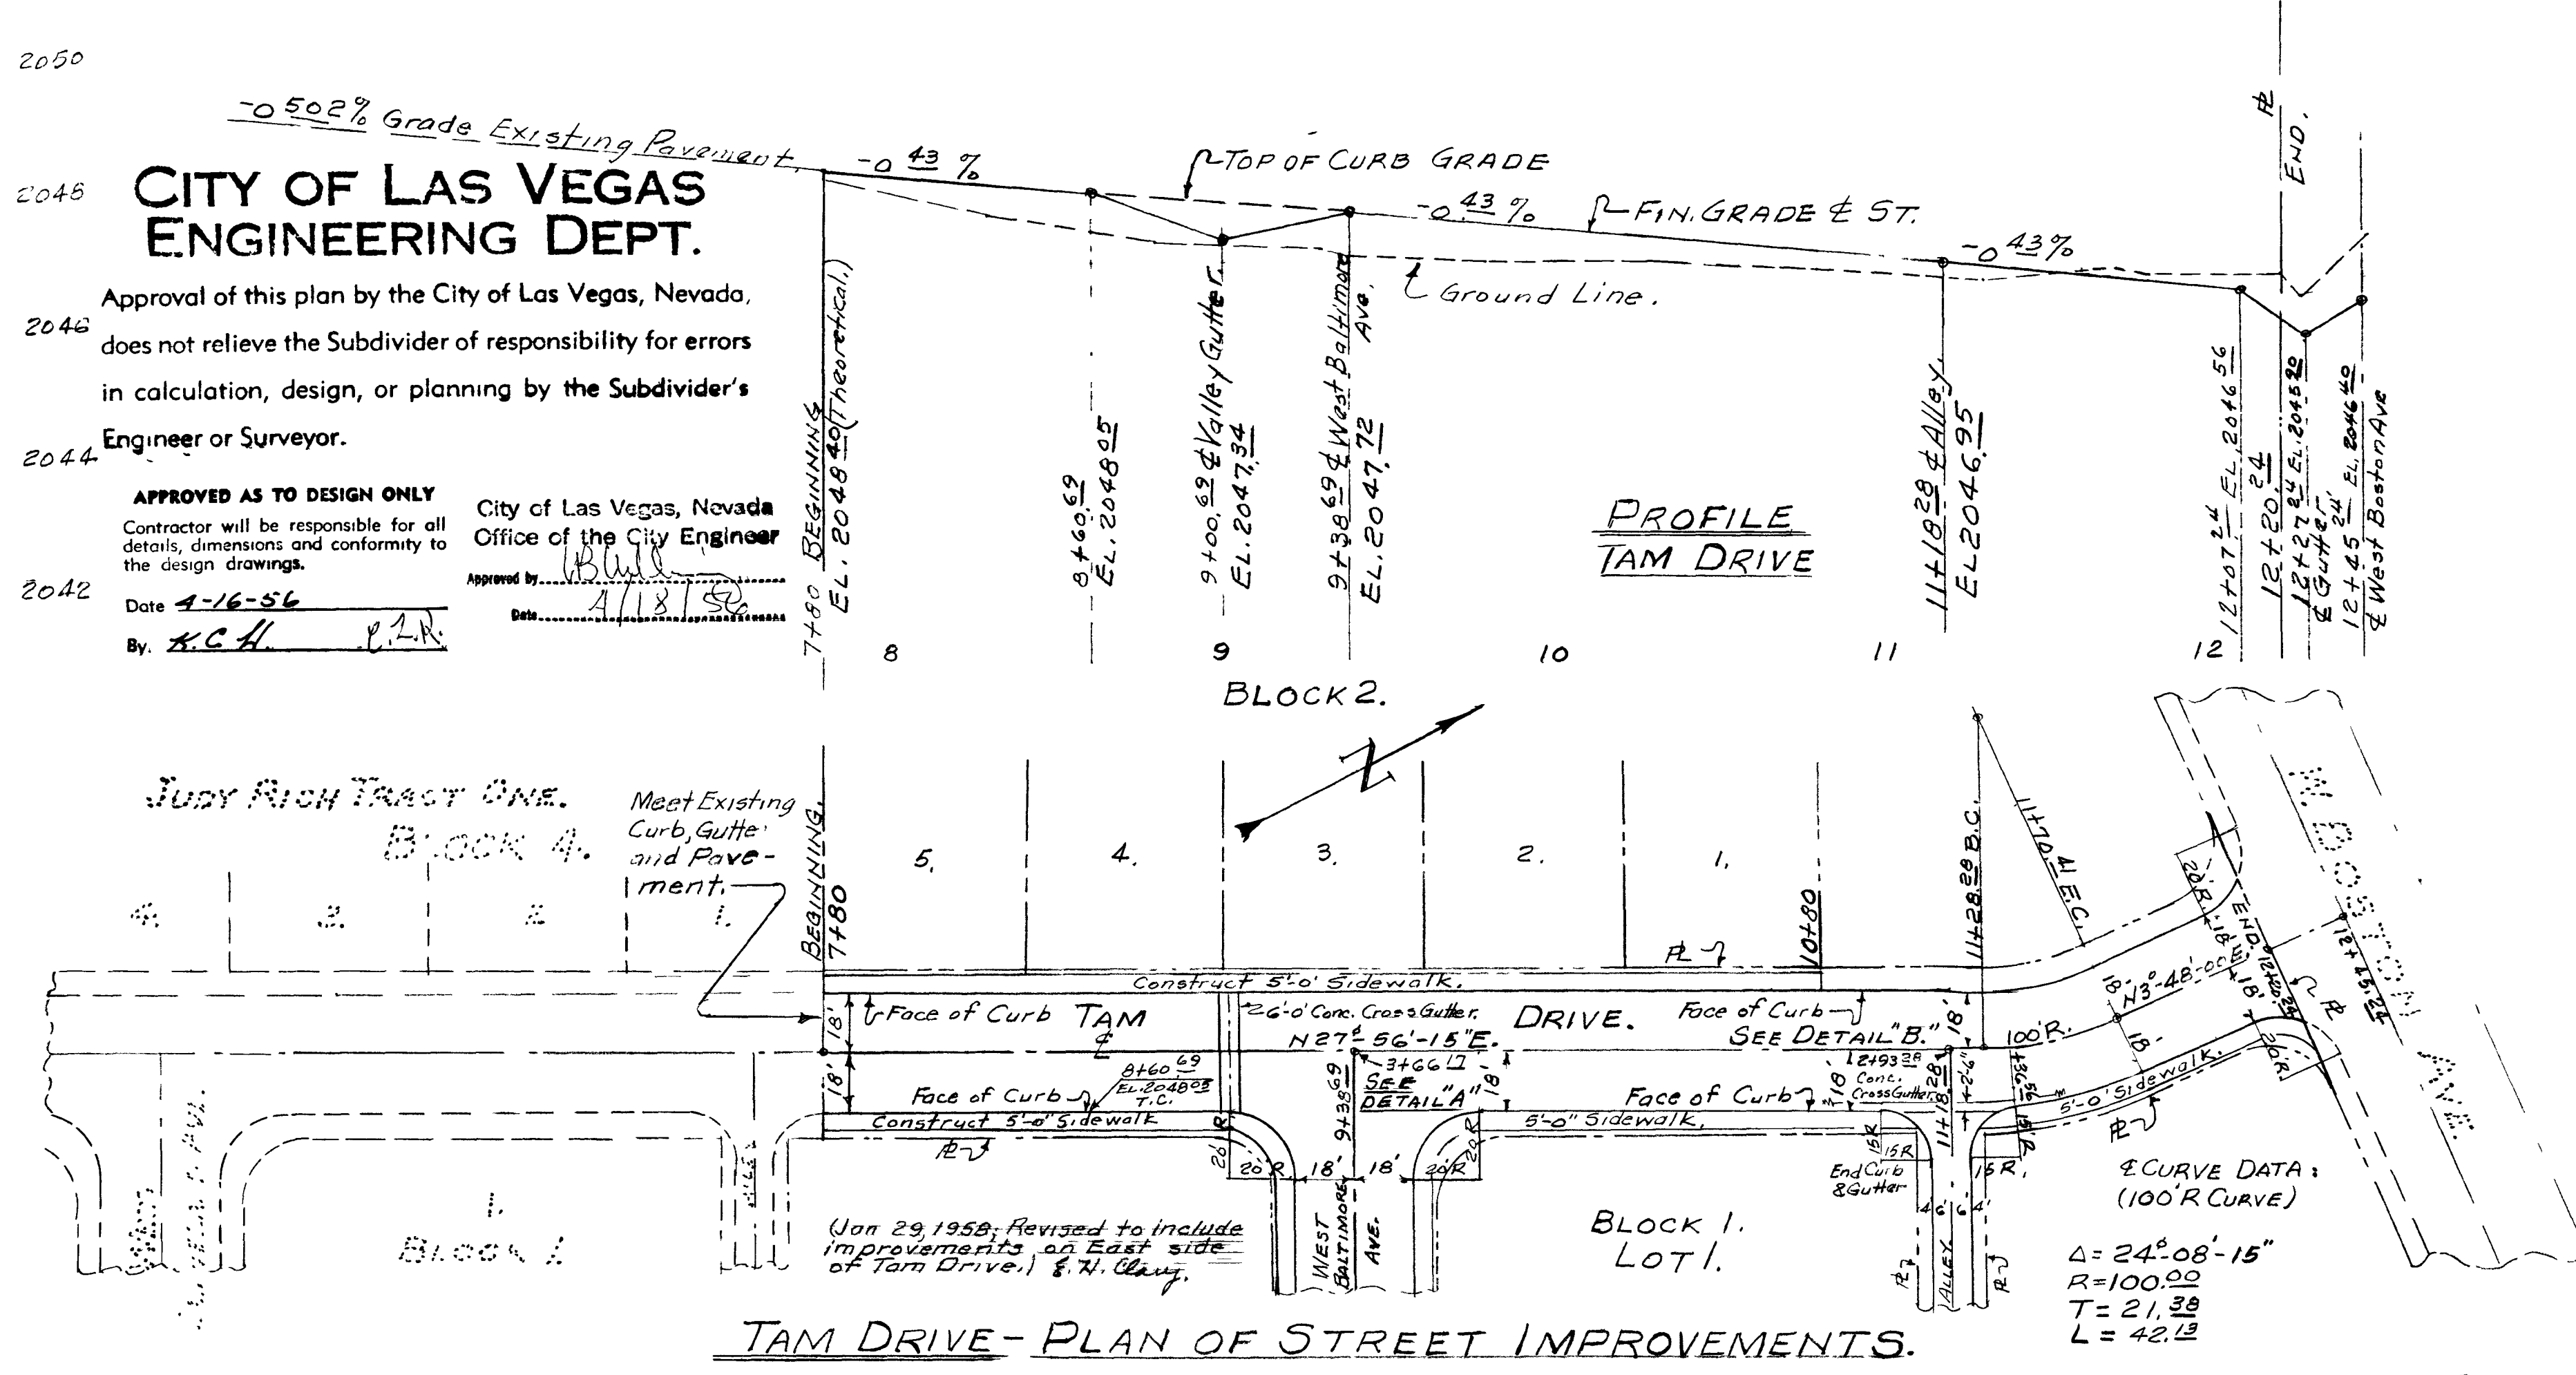

2050

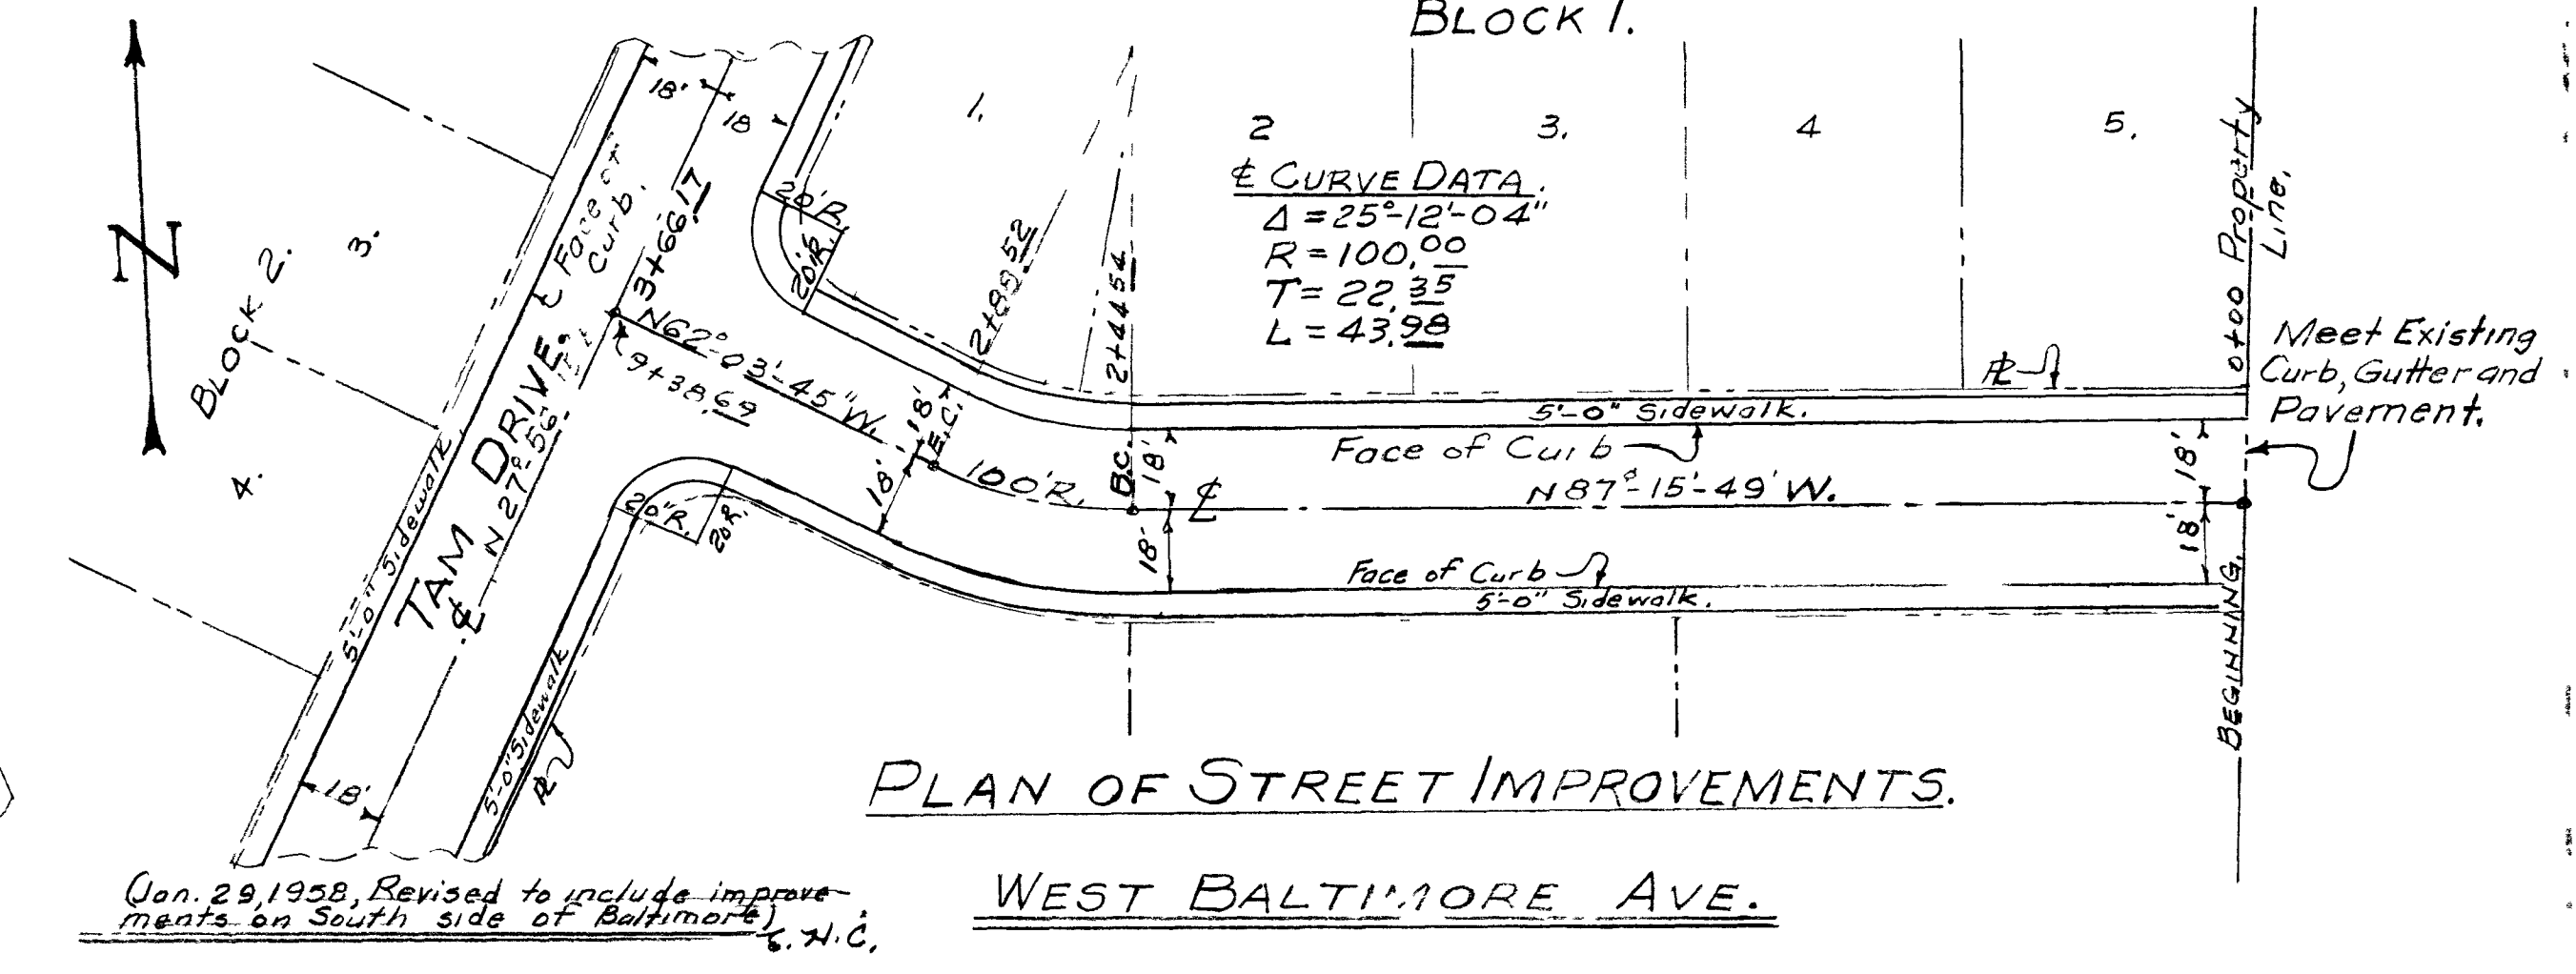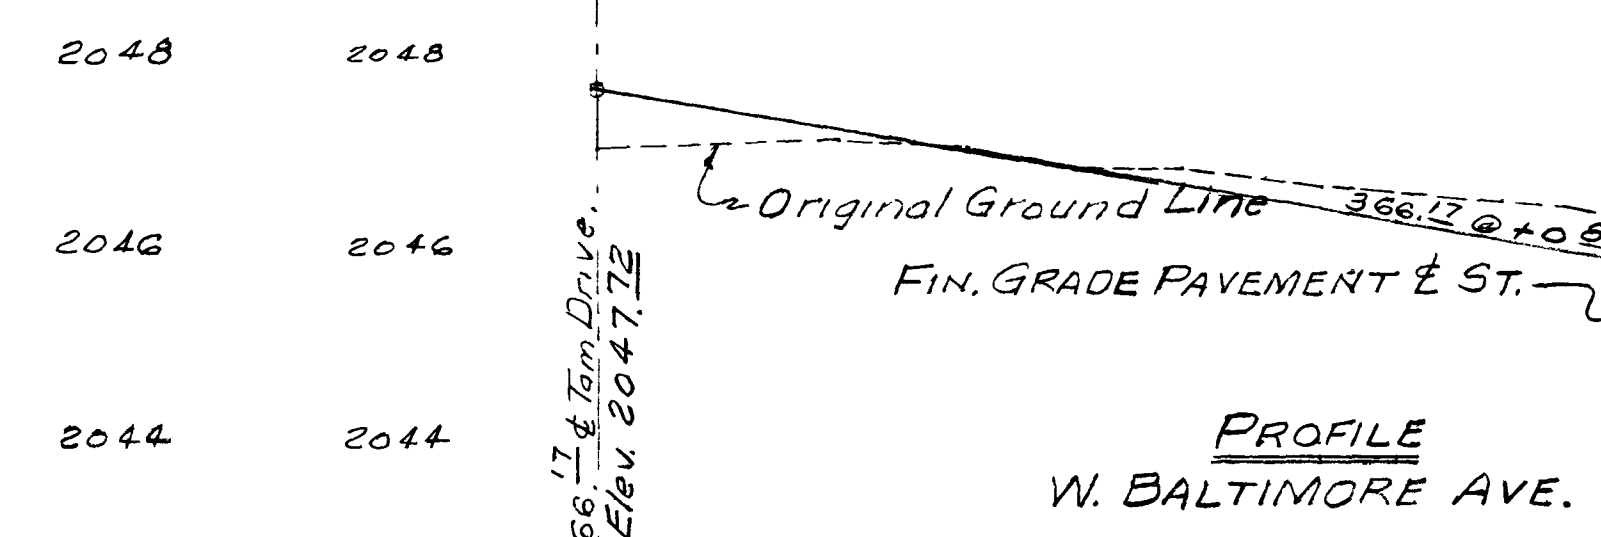

2050

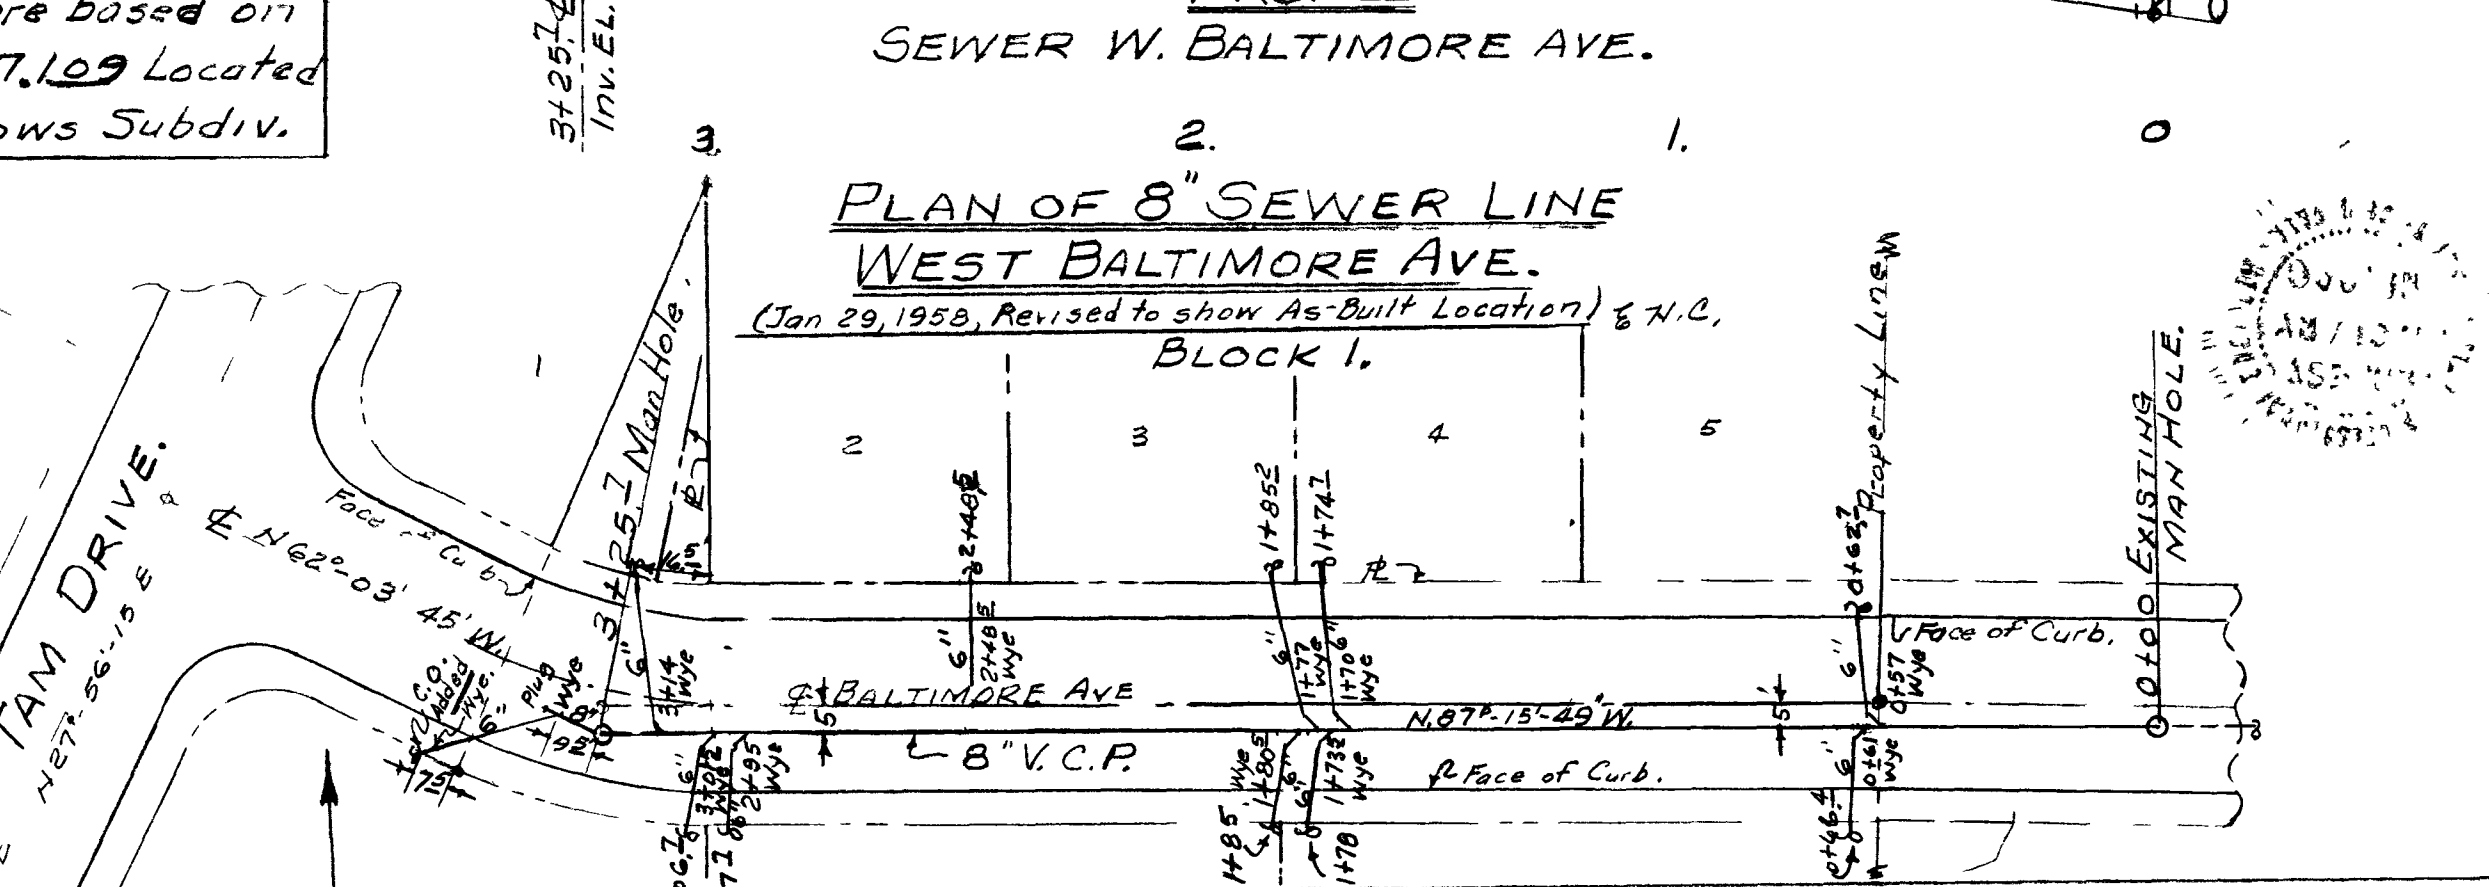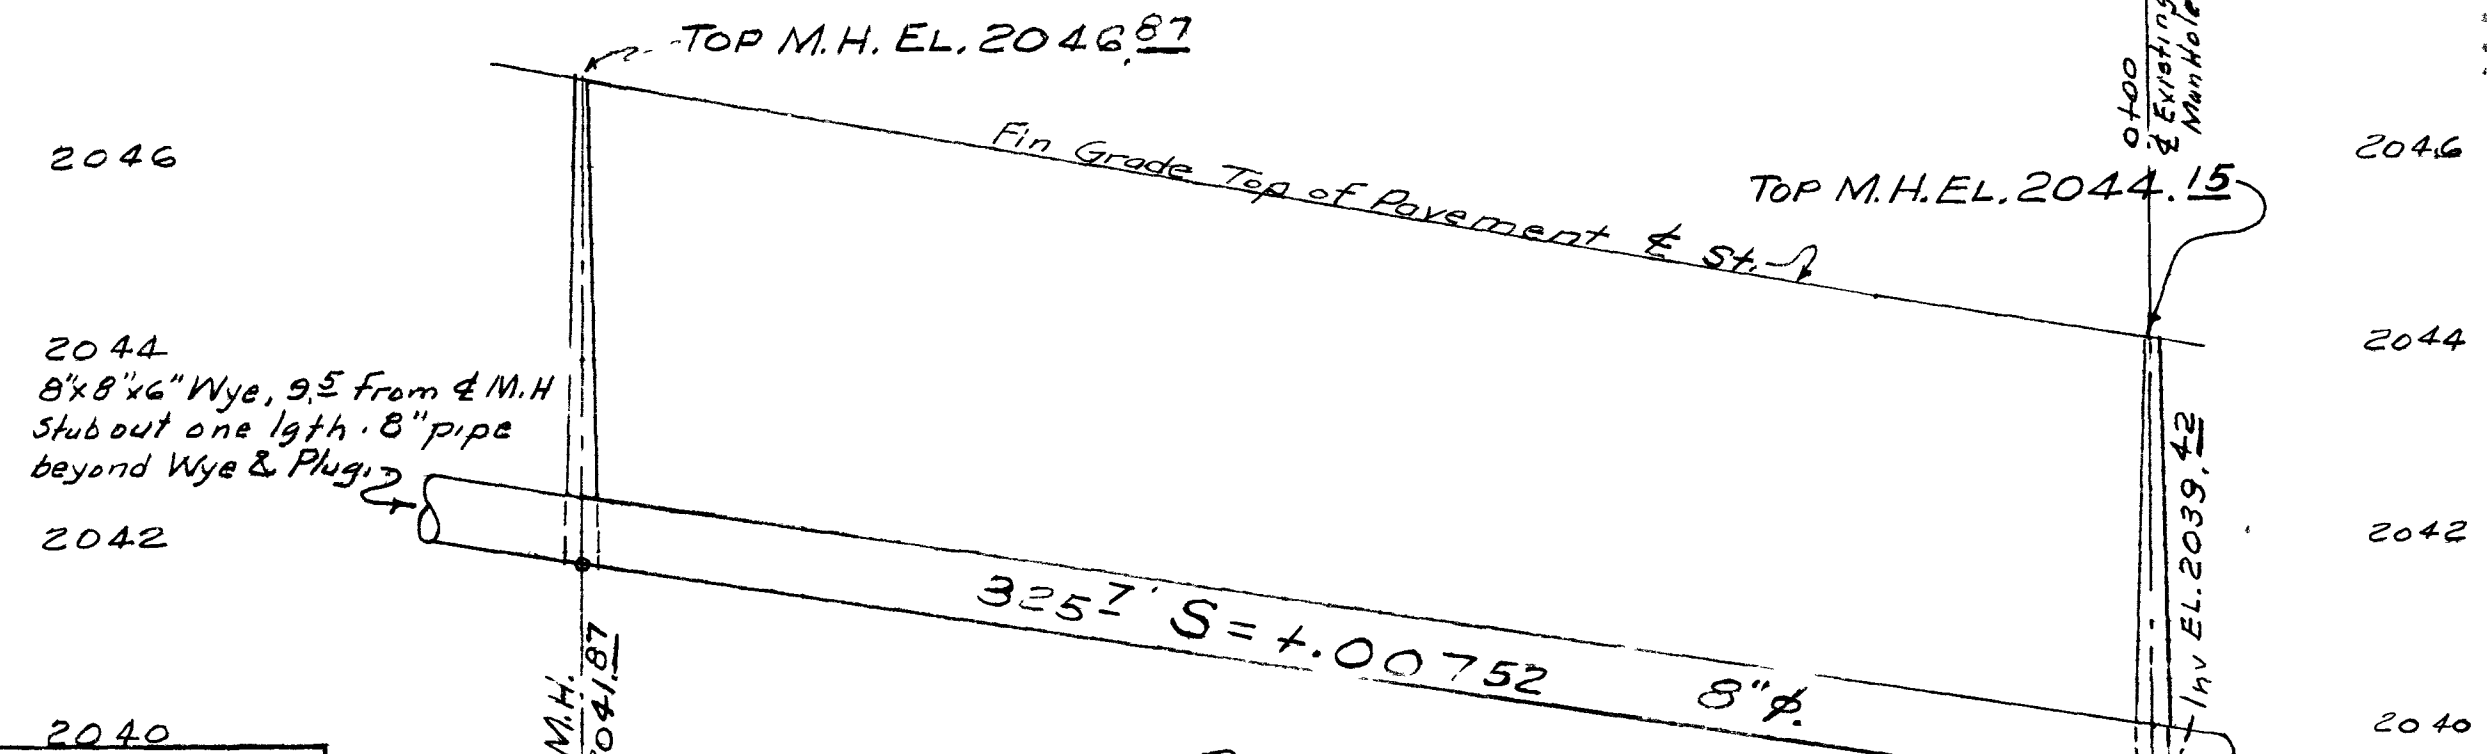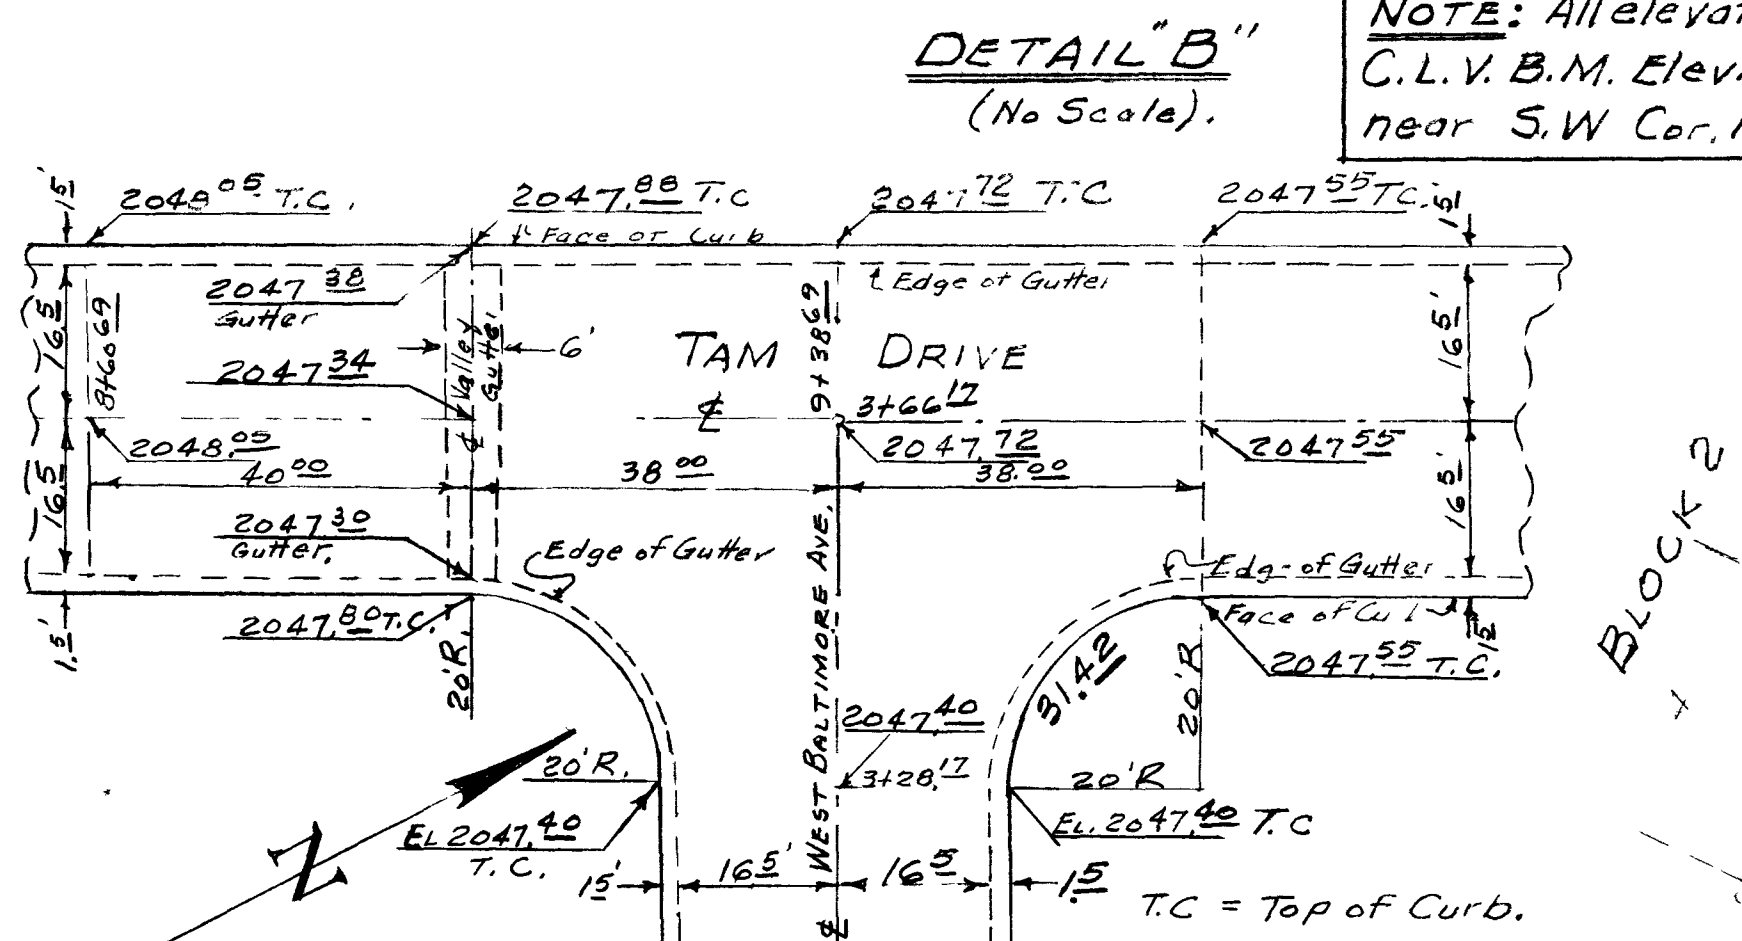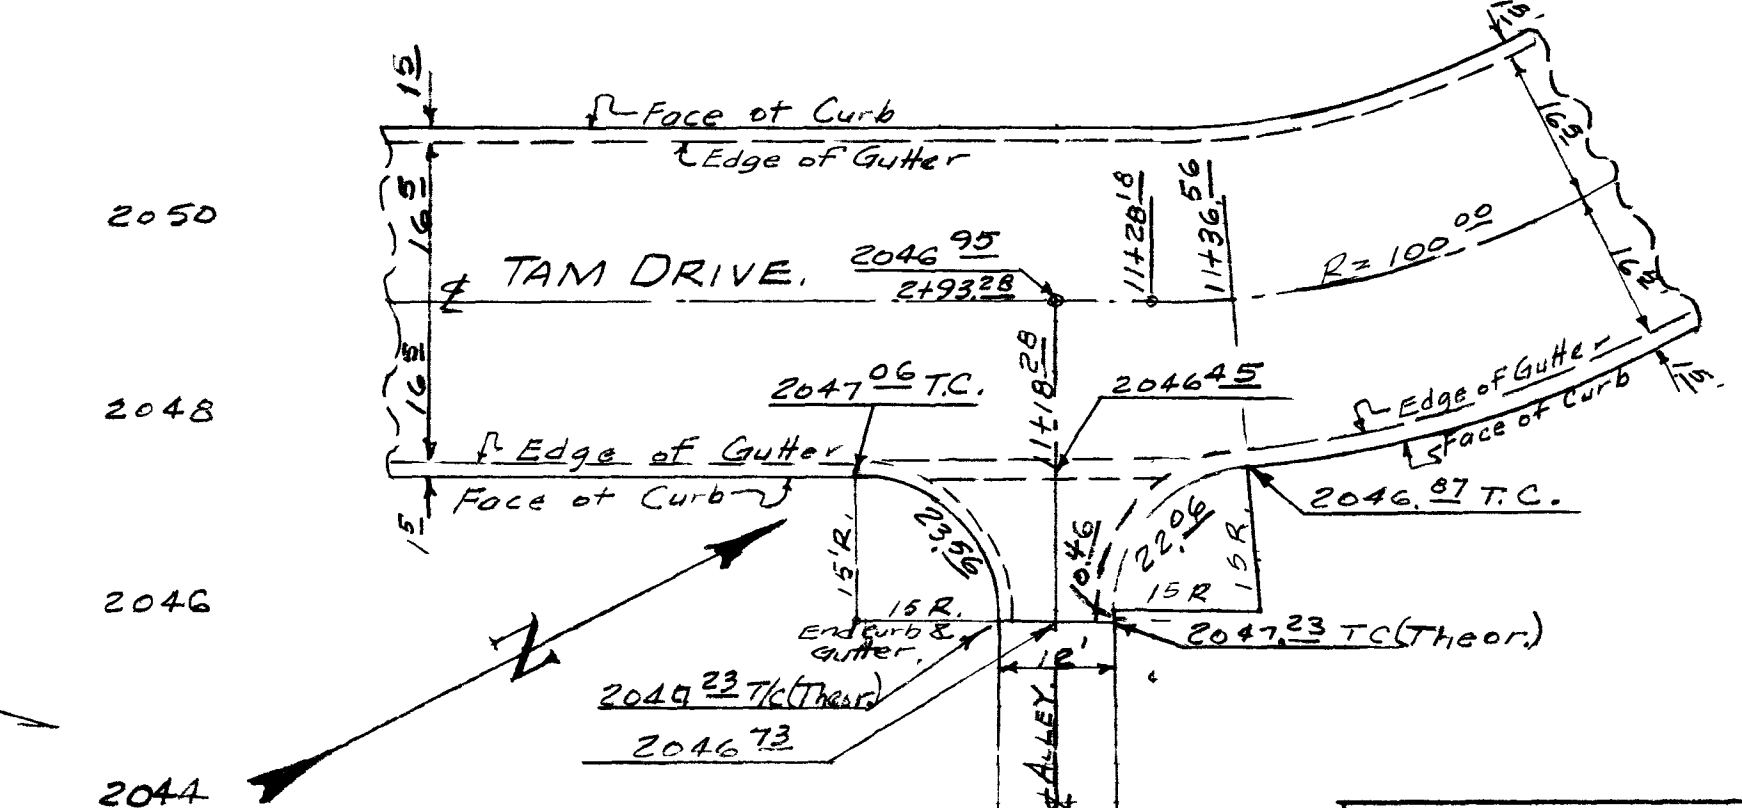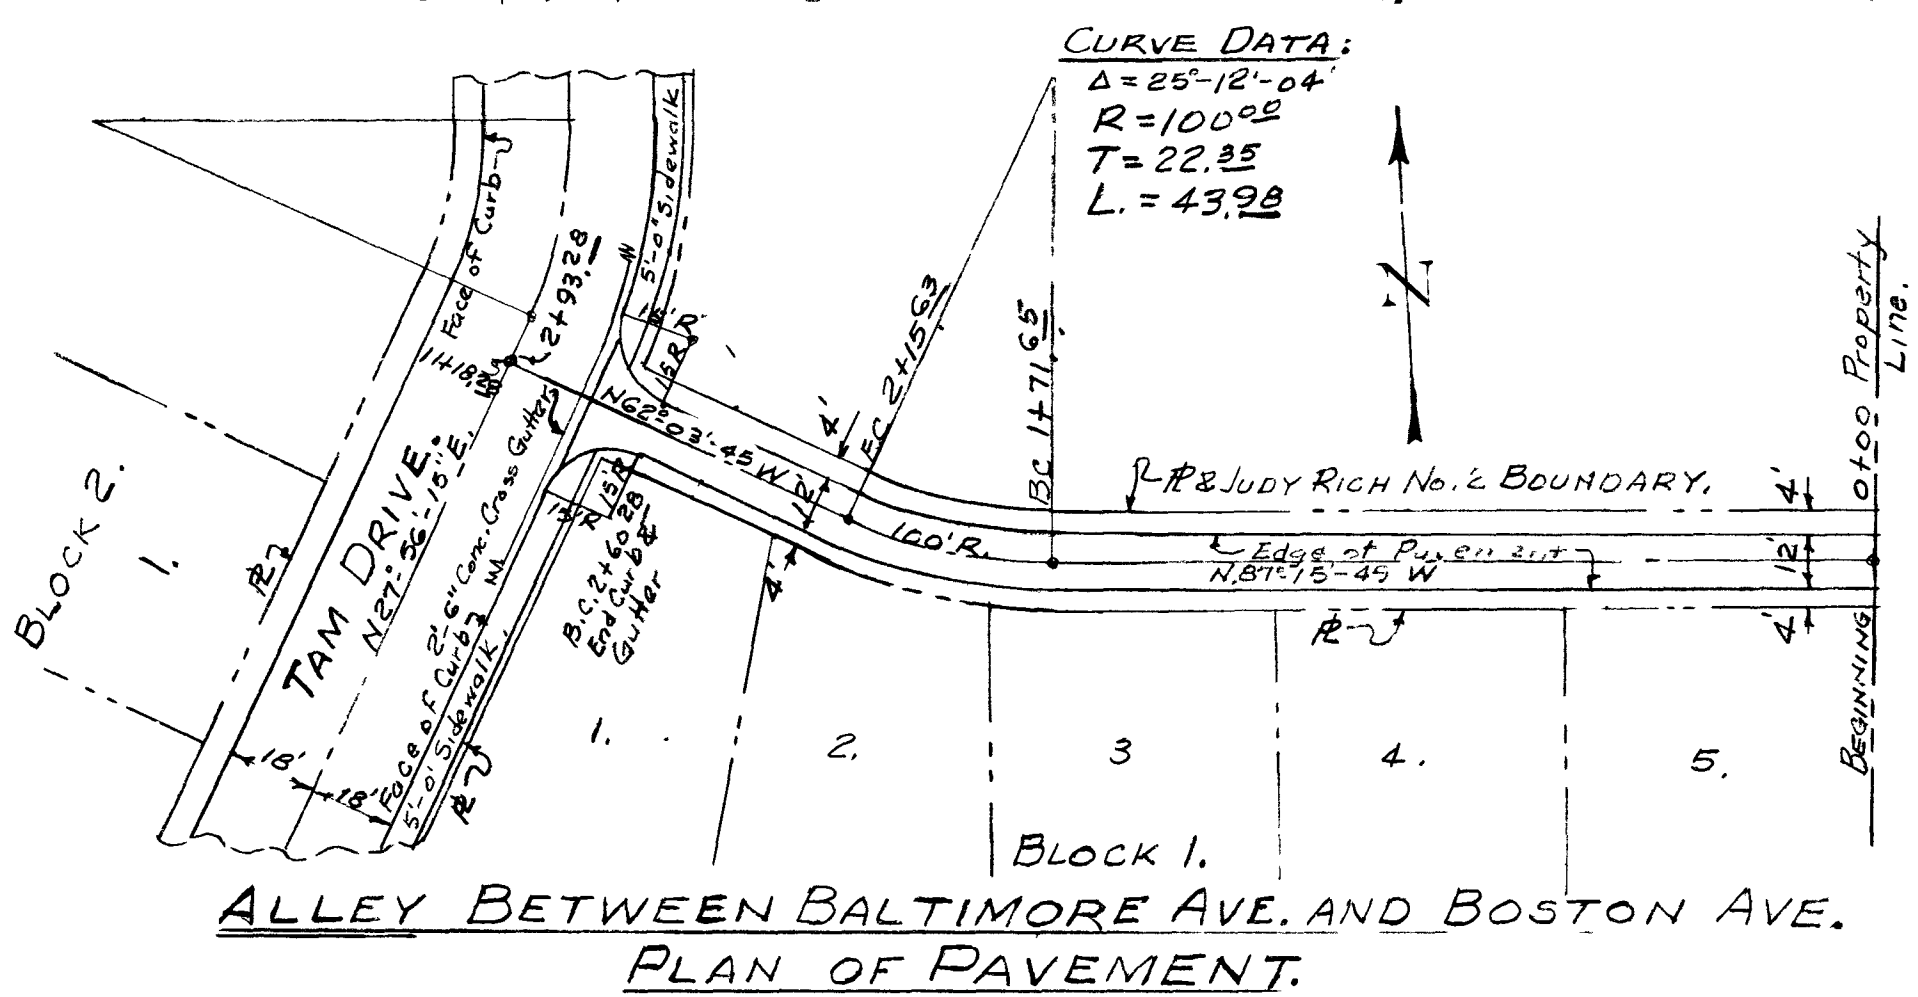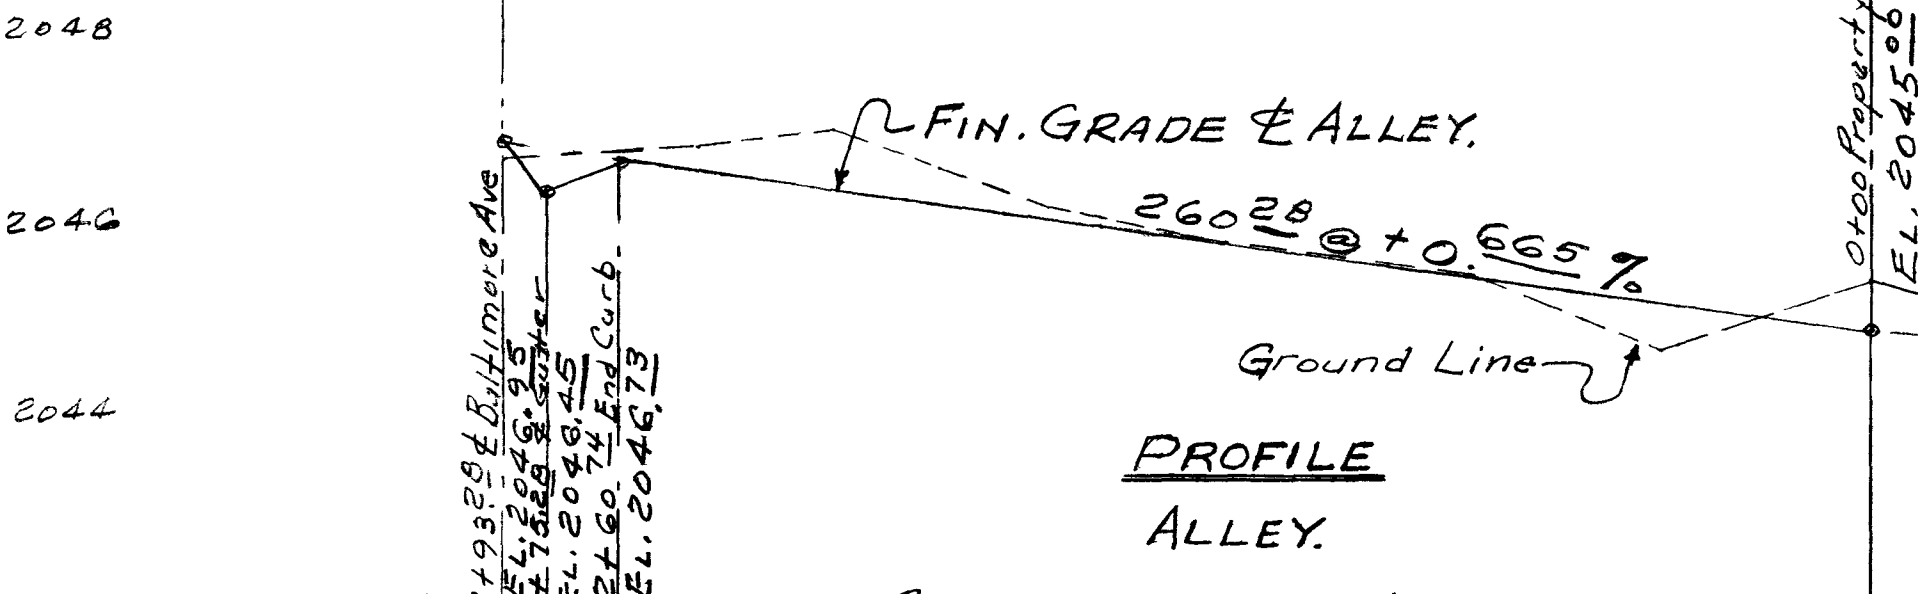

GENERAL NOTE: All work and materials must meet City of Las Vegas Specifications.

**JUDY RICH TRACT NO. 2 - CITY OF LAS VEGAS, NEV. PLAN & PROFILE OF STREETS, ALLEY & SEWER.**

Prepared by: Ernest H. Clary, P.E.  
 Nevada No. 290  
 Dated: City of Las Vegas Elevations.  
 Signed: Ernest H. Clary


1077-1900-2  
 17.7.133

**CITY OF LAS VEGAS  
ENGINEERING DEPT.**






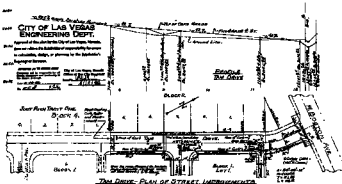



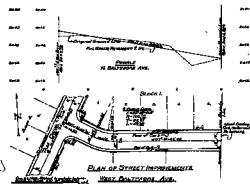



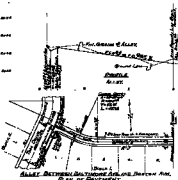


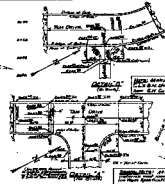


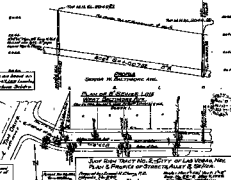


**NOTICE:** All work on this project shall be done in accordance with the specifications of the City of Las Vegas.