

LAS VEGAS CITY HALL MONITORING CONTROL




SCALE: 1" = 100'

CO-ORDINATES

PT.	NORTH	EAST	ELEVATION
CH-1	5000.0000	5000.0000	
CH-2	4926.1434	5869.0860	2005.79
CH-3	4959.9133	6799.9923	
CH-4	5452.9684	6806.6923	
CH-5	5371.2867	5830.9488	2014.84
CH-6	5425.3652	4954.9794	
CH-7	5178.1957	5830.9486	2014.70
CH-8	5089.7052	5787.7091	2008.90
CH-9	5133.1625	6018.0129	2007.47

CONTROL LOCATION

- CH-1 3' +/- E. OF BRICK PAVING @ E. SIDE OF CASINO CENTER, 8' +/- N. OF C/L STEWART
- CH-2 1' +/- S. OF BACK OF CURB S. SIDE STEWART S. OF CITY HALL, 25' +/- W. OF W. DRIVEWAY
- CH-3 C/L WALK N.W. QUAD 7TH & STEWART, 2' +/- N. OF SIDEWALK INTERSECTION
- CH-4 C/L WALK N.W. QUAD 7TH & MESQUITE, 15' +/- N. OF SIDEWALK INTERSECTION
- CH-5 12' +/- N. OF NORTH ENTRANCE TO CITY HALL PLAZA AT GARAGE DRIVE THROUGH
- CH-6 FLOW LINE OF GUTTER S.W. QUAD CASINO CENTER & MESQUITE, 15' +/- S. OF DO NOT ENTER SIGN
- CH-7 W. SIDE OF CITY HALL PLAZA 32' +/- N.E. OF TOP OF STAIRS, 2' +/- N.E. OF BLDG. ANGLE PT.
- CH-8 S.W. SIDE CITY HALL 2' +/- N.W. OF N.W. CORNER OF POND @ S. SIDE OF BLDG.
- CH-9 20' N.W. OF S.E. CORNER OF EAST PORTION OF CITY HALL BLDG.

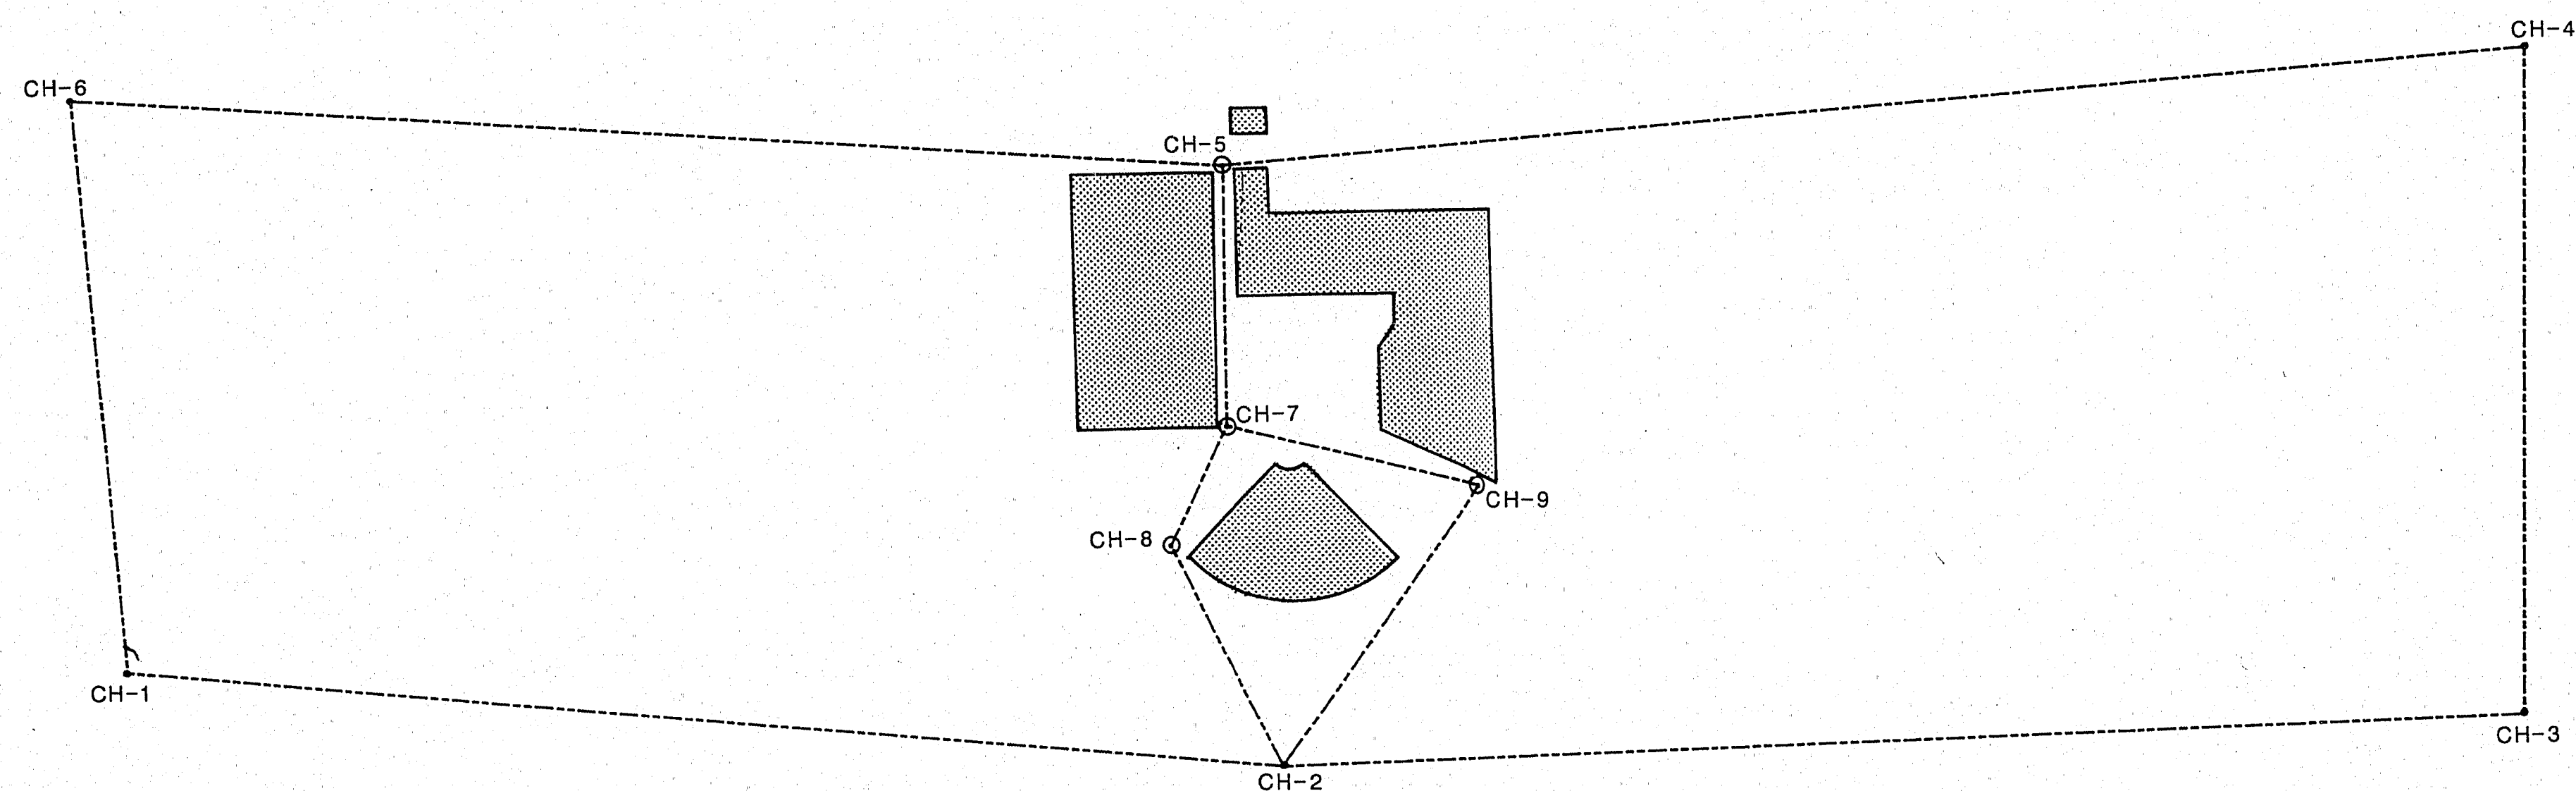

SURVEYORS NOTE

CONTROL HAS BEEN SET TO A FIELD ACCURACY TOLERANCE WHICH WILL ALLOW FOR VERIFICATION OF HORIZONTAL OR VERTICAL MOVEMENT IN EXCESS OF 0.01 FOOT (1/8")

VERTICAL FIELD CONTROL COMPLETED 2-20-89

HORIZONTAL FIELD CONTROL COMPLETED 2-21-89

LEGEND


- SET 2 1/2" BRASS CAP (DOME TOP)
- SET 2 1/2" BRASS CAP (FLAT TOP)

BASIS OF BEARINGS

NORTH (ASSUMED PT CH-7 TO CH-5)

BENCH MARK

CITY OF LAS VEGAS B.M. #06134A5.
BOLT & PLATE TOP OF CURB N.W.
QUADRANT 7TH ST. & STEWART AVE.
(ELEVATION 1997.32)

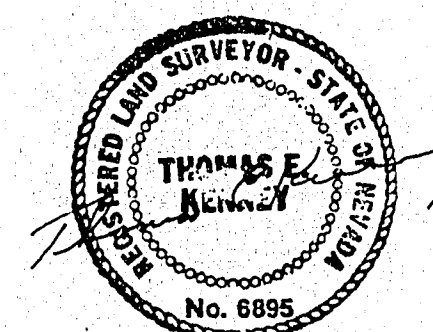

2-27-89