


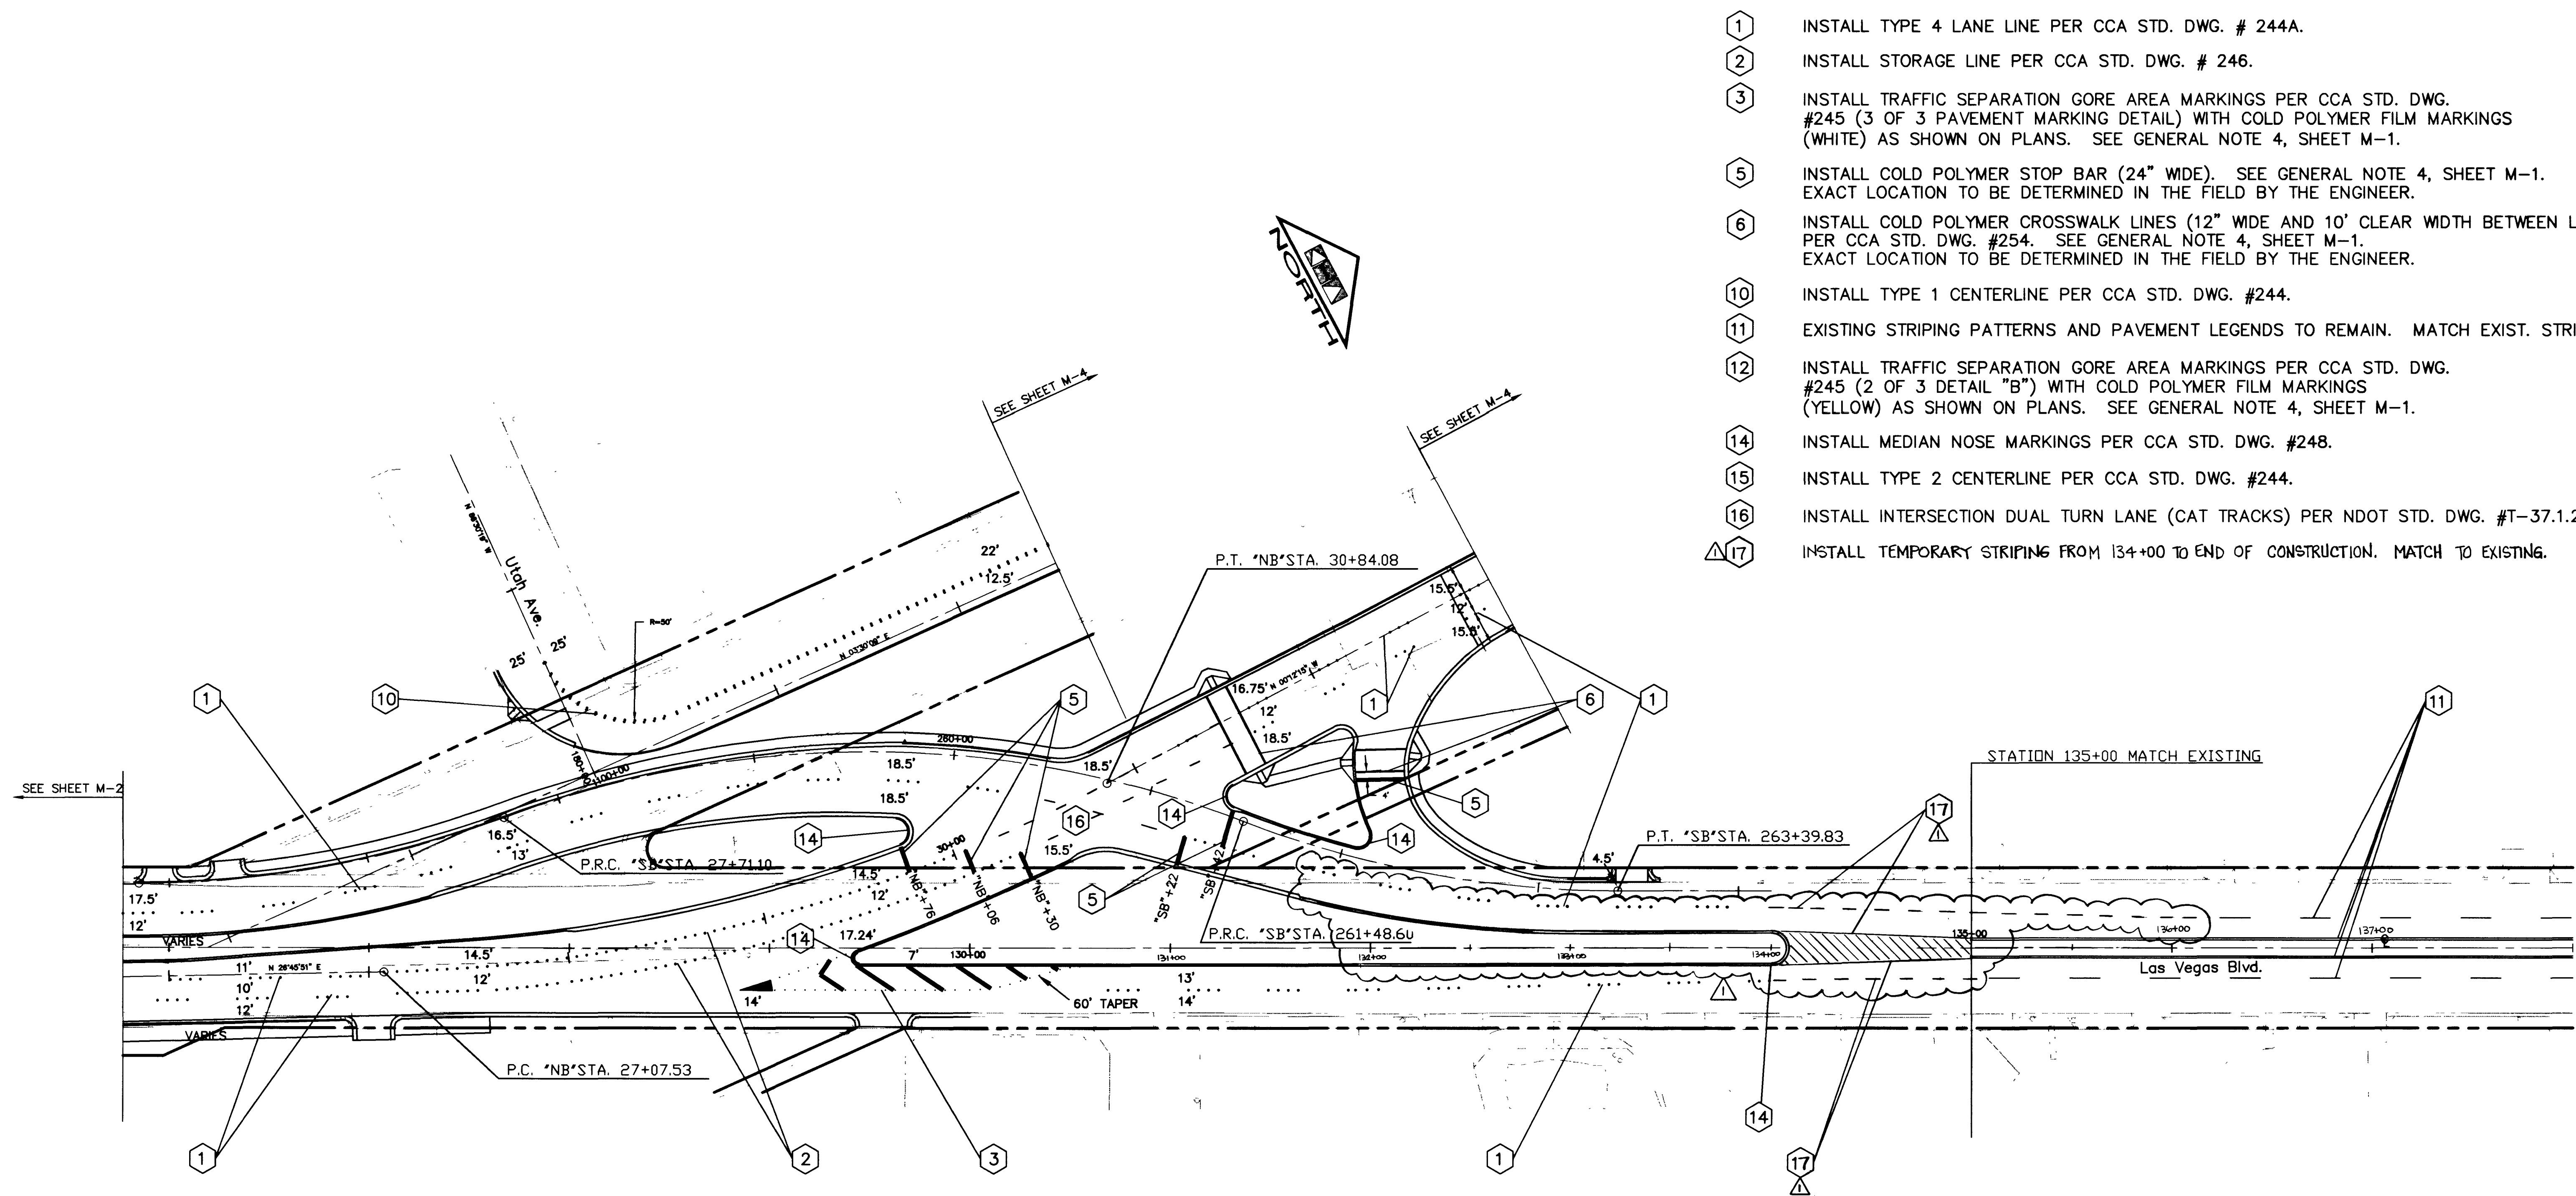

4TH STREET/LAS VEGAS BOULEVARD INTERSECTION


LANE WIDTH DIMENSIONS SHOWN ARE
MEASURED TO THE BACK OF CURB

- 1 INSTALL TYPE 4 LANE LINE PER CCA STD. DWG. # 244A.
- 2 INSTALL STORAGE LINE PER CCA STD. DWG. # 246.
- 3 INSTALL TRAFFIC SEPARATION GORE AREA MARKINGS PER CCA STD. DWG. #245 (3 OF 3 PAVEMENT MARKING DETAIL) WITH COLD POLYMER FILM MARKINGS (WHITE) AS SHOWN ON PLANS. SEE GENERAL NOTE 4, SHEET M-1.
- 5 INSTALL COLD POLYMER STOP BAR (24" WIDE). SEE GENERAL NOTE 4, SHEET M-1. EXACT LOCATION TO BE DETERMINED IN THE FIELD BY THE ENGINEER.
- 6 INSTALL COLD POLYMER CROSSWALK LINES (12" WIDE AND 10' CLEAR WIDTH BETWEEN LINES) PER CCA STD. DWG. #254. SEE GENERAL NOTE 4, SHEET M-1. EXACT LOCATION TO BE DETERMINED IN THE FIELD BY THE ENGINEER.
- 10 INSTALL TYPE 1 CENTERLINE PER CCA STD. DWG. #244.
- 11 EXISTING STRIPING PATTERNS AND PAVEMENT LEGENDS TO REMAIN. MATCH EXIST. STRIPING.
- 12 INSTALL TRAFFIC SEPARATION GORE AREA MARKINGS PER CCA STD. DWG. #245 (2 OF 3 DETAIL "B") WITH COLD POLYMER FILM MARKINGS (YELLOW) AS SHOWN ON PLANS. SEE GENERAL NOTE 4, SHEET M-1.
- 14 INSTALL MEDIAN NOSE MARKINGS PER CCA STD. DWG. #248.
- 15 INSTALL TYPE 2 CENTERLINE PER CCA STD. DWG. #244.
- 16 INSTALL INTERSECTION DUAL TURN LANE (CAT TRACKS) PER NDOT STD. DWG. #T-37.1.2 (633).
- 17 INSTALL TEMPORARY STRIPING FROM 134+00 TO END OF CONSTRUCTION. MATCH TO EXISTING.

Time: 15:45:00.0
Date: 05/09/1996
Drawing File: 990302\PH2\M-3

Avoid cutting underground
utility lines. It's costly.
**Call
before
you
Dig.**
1-800-227-2600
UNDERGROUND SERVICE ALERT (USA)

NO.	REVISIONS	DATE	BY
1	MEDIAN ISLAND GEOMETRICS REVISED	12-27-96	DLA

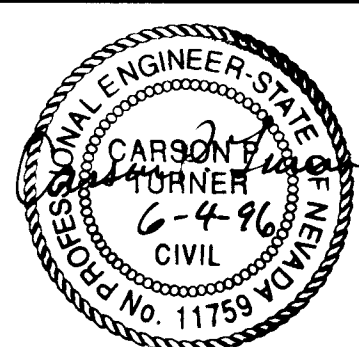

**Kimley-Horn
and Associates, Inc.**

Las Vegas, Nevada

© 1996

DESIGNED BY	CDR
DRAWN BY	CDR
CHECKED BY	<i>[Signature]</i>
NOTE BOOK NO.	




DOWNTOWN CORRIDOR IMPROVEMENTS
CITY OF LAS VEGAS DEPT. OF PUBLIC WORKS
LAS VEGAS, NEVADA

DATE	6/96
SCALE	1"=40'

MARKING PLAN
STA.25+77 TO STA.33+00

DWG. NO.	107-V-2288B
FILE NO.	9903.02
SHEET 33 OF 46	M-3


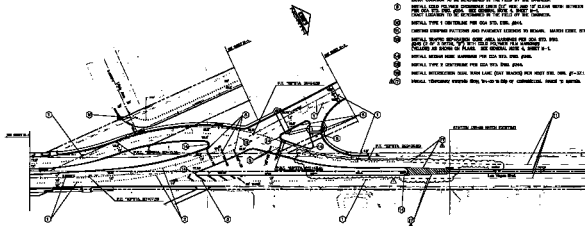

4TH STREET/LAS VEGAS BOULEVARD INTERSECTION














