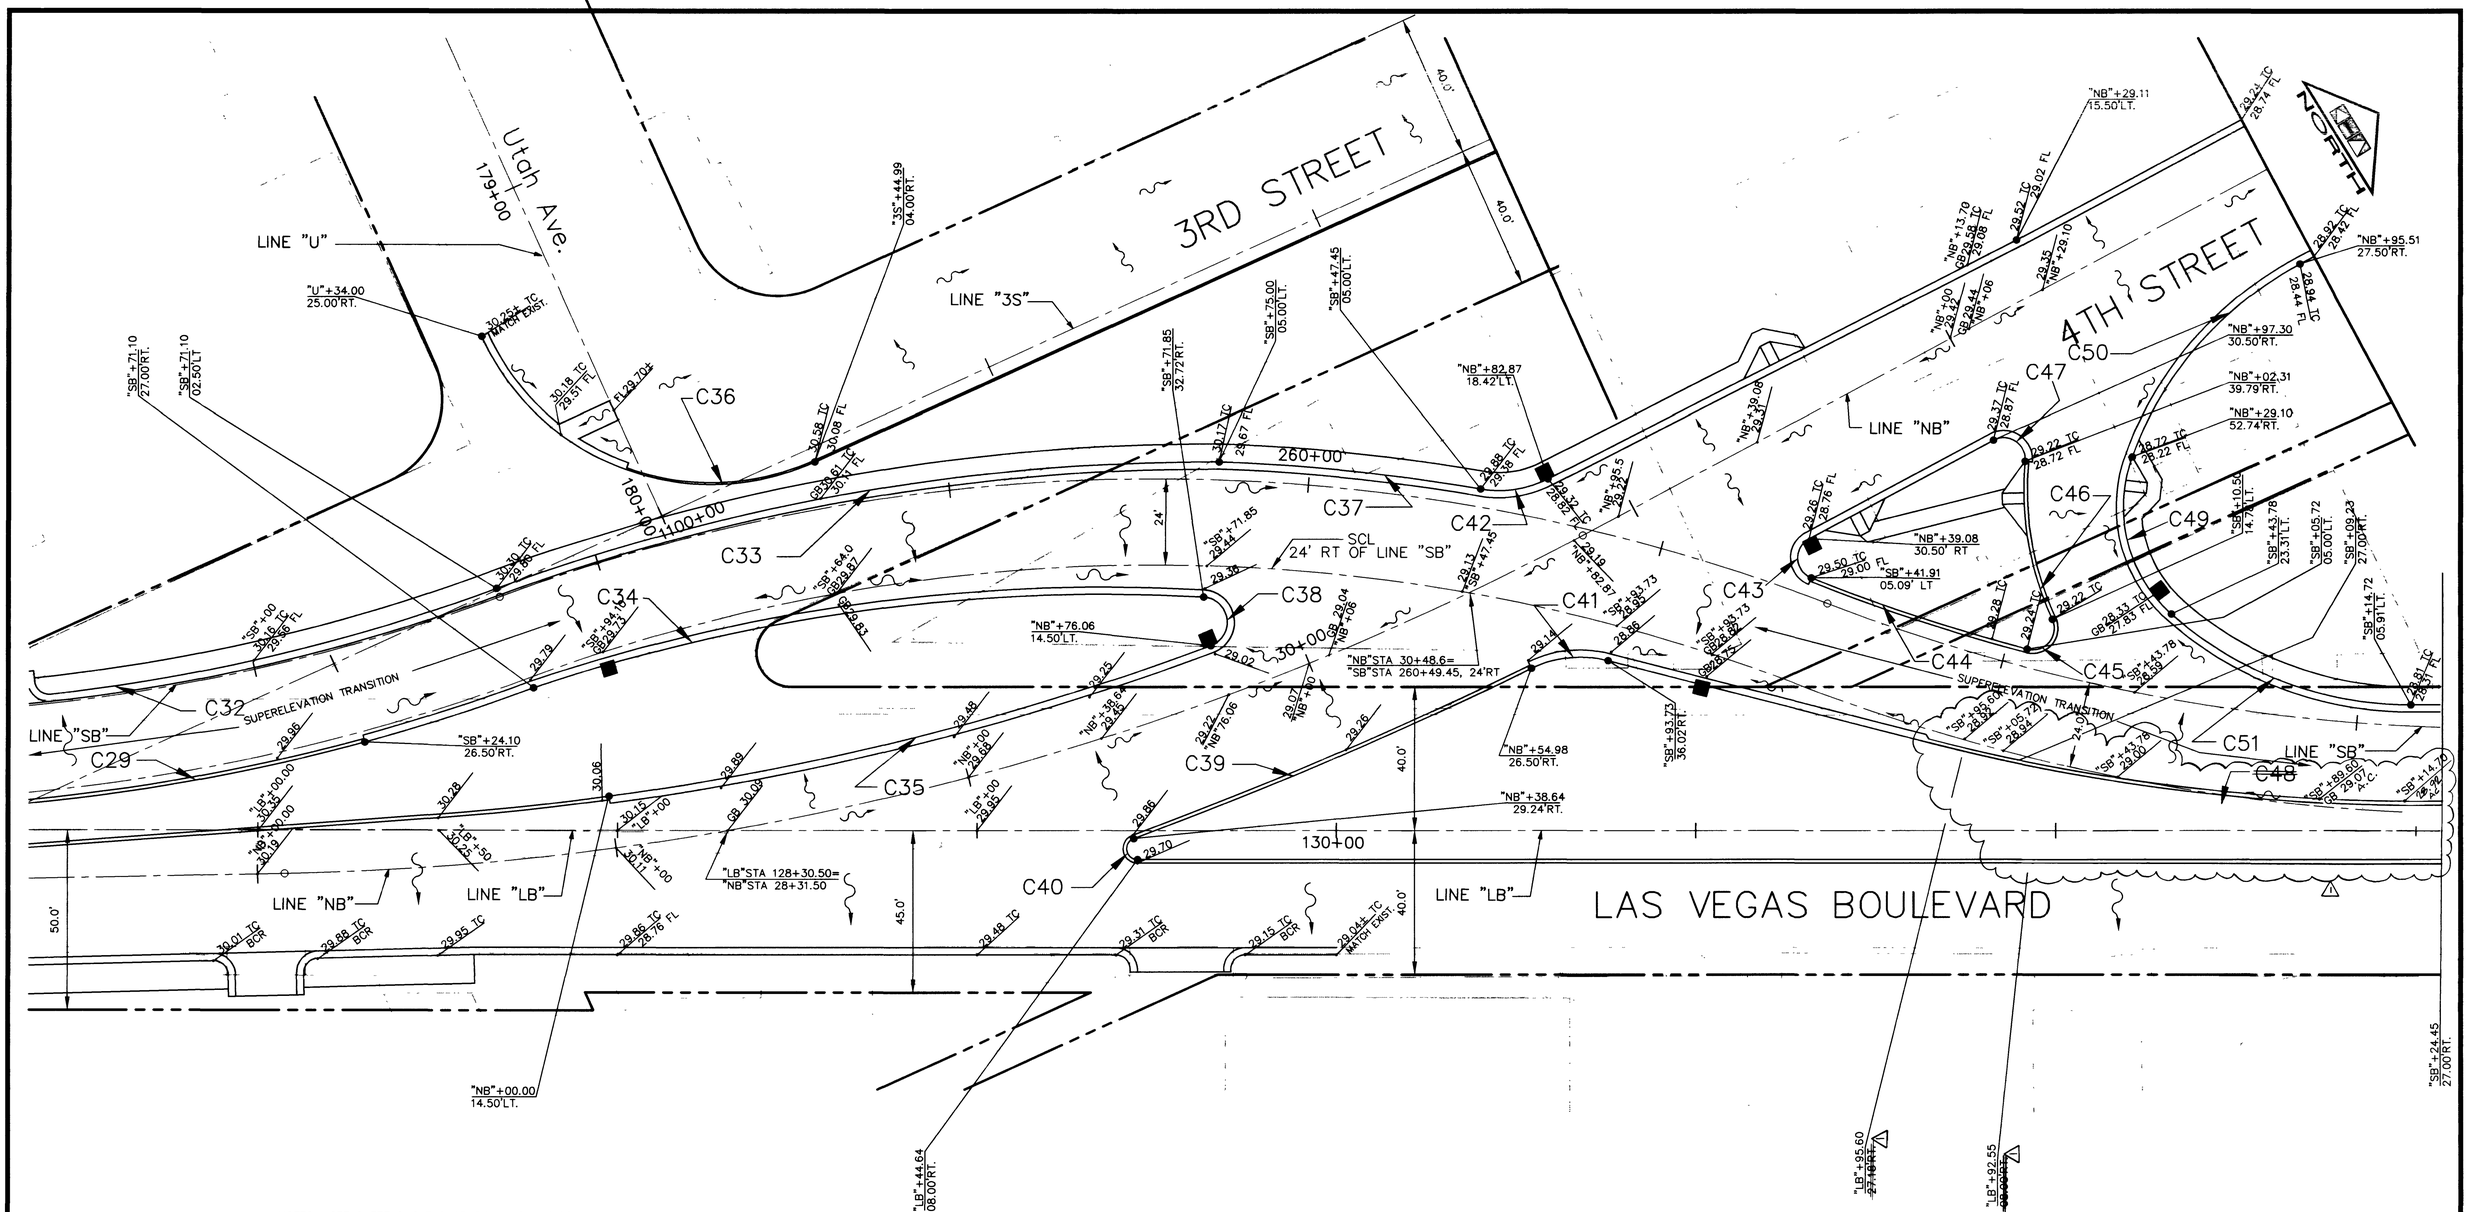

NOTES: SEE SHEET C-2 FOR STATION AND OFFSETS AND PROFILE GRADES.
ALL SPOT ELEVATIONS ARE PAVEMENT ELEVATIONS UNLESS OTHERWISE NOTED.
ADD 2000 FEET TO ALL ELEVATIONS SHOWN
SEE SHEET C-2 FOR CURVE DATA

■ DROP INLET LOCATIONS

PAVEMENT SURFACE FLOW DIRECTION

NDOT CONTROLLED RIGHT OF WAY EXTENDS FROM BACK OF CURB TO BACK OF CURB ON LAS VEGAS BLVD. ALL WORKED PERFORMED IN THIS AREA SHALL BE IN CONFORMANCE WITH THE NDOT ENCROACHMENT PERMIT.

4TH STREET/LAS VEGAS BOULEVARD INTERSECTION

Time: 13:00:00
Date: 4/18/1996
File: K:\990302\PH2\D-3

NO.	REVISIONS	DATE	BY
1	MEDIAN ISLAND GEOMETRICS REVISED	12-26-96	DLA

CARSON P. TURNER — No. 11759 — PROFESSIONAL ENGINEER STATE OF NEVADA — CIVIL

Kimley-Horn and Associates, Inc.
Las Vegas, Nevada
© 1996

DESIGNED BY	CDR
DRAWN BY	CDR
CHECKED BY	CPT
NOTE BOOK NO.	

CITY OF LAS VEGAS NEVADA

DOWNTOWN CORRIDOR IMPROVEMENTS
CITY OF LAS VEGAS DEPT. OF PUBLIC WORKS
LAS VEGAS, NEVADA

DATE 6/96
SCALE 1"=20'

4TH ST./LAS VEGAS BLVD. INTERSECTION GRADING DETAIL

DWG. NO. 107-V-2288B
FILE NO. 9903.02
SHEET 10 OF 46
D-3

258

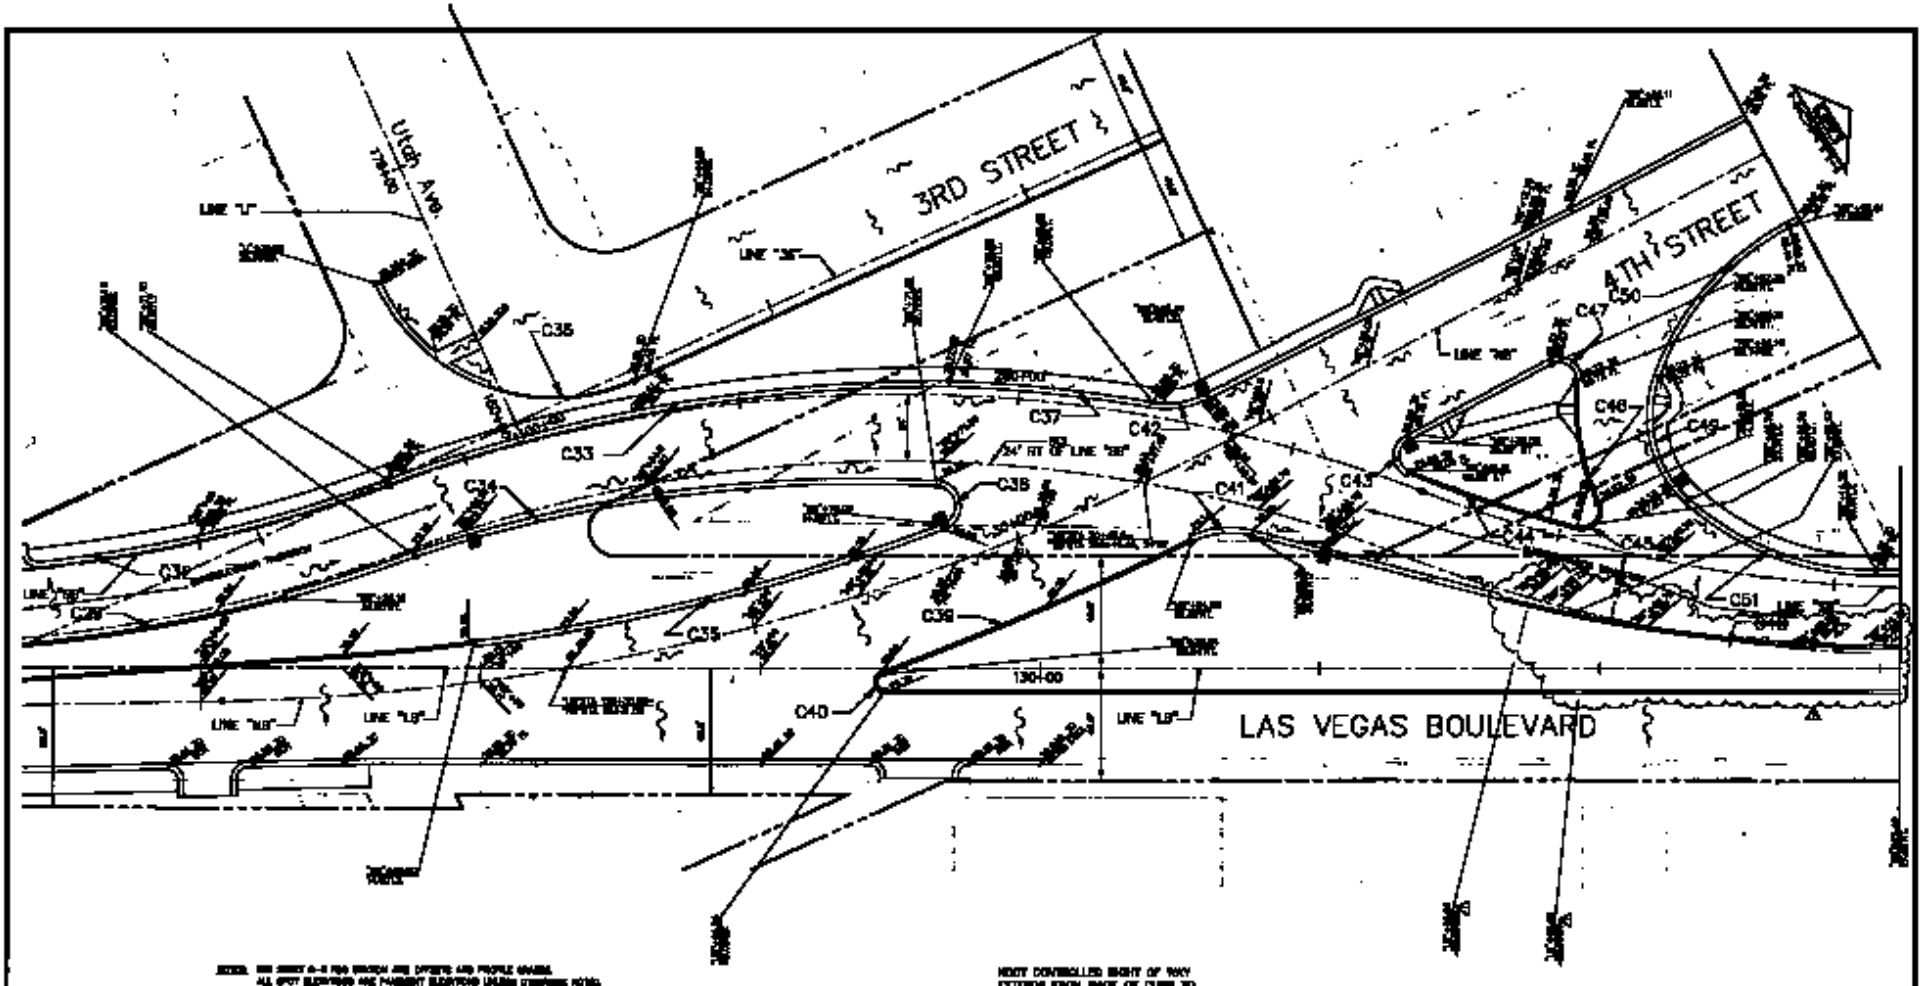

NOTE: SEE SHEET D-2 FOR STATION AND OFFSETS AND PROFILE GRADES.
ALL SPOT ELEVATIONS ARE PAVEMENT ELEVATIONS UNLESS OTHERWISE NOTED.
SEE SHEET D-2 FOR CURVE DATA

DROP INLET LOCATIONS

PAVEMENT SURFACE FLOW DIRECTION

NDOT CONTROLLED RIGHT OF WAY EXTENDS FROM BACK OF CURB TO BACK OF CURB ON LAS VEGAS BLVD. ALL WORKED PERFORMED IN THIS AREA SHALL BE IN CONFORMANCE WITH THE NDOT ENCROACHMENT PERMIT.

4TH STREET/LAS VEGAS BOULEVARD INTERSECTION

NO.	REVISIONS	DATE	BY

Kimley-Horn and Associates, Inc.
Las Vegas, Nevada

DESIGNED BY CDR
DRAWN BY CDR
CHECKED BY CDR
NOTE BOOK NO.

DOWNTOWN CORRIDOR IMPROVEMENTS
CITY OF LAS VEGAS DEPT. OF PUBLIC WORKS
LAS VEGAS, NEVADA

SCALE 1"=20'

4TH ST./LAS VEGAS BLVD.
INTERSECTION
GRADING DETAIL

DWG. NO. 707-V-22[illegible]
FILE NO. [illegible]
SHEET [illegible] OF [illegible]
D-3