
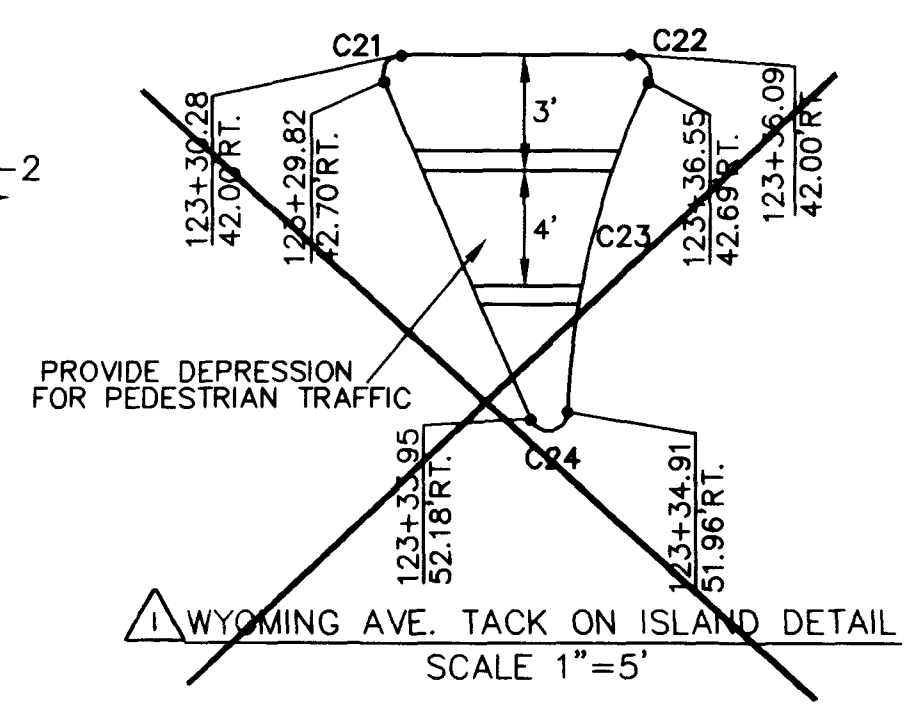


- 3 REMOVE EXIST. DRIVEWAY & S.W. AS NEEDED TO CONSTRUCT MODIFIED CONCRETE DRIVEWAY. (SEE DETAILS SHEET D-1)
- 4 EXISTING CONCRETE SIDEWALK (TO REMAIN)
- 5 REMOVE EXISTING CONCRETE CURB, CURB AND GUTTER OR VALLEY GUTTER.
- 6 REMOVE EXIST. PAVEMENT AND REPLACE WITH TYPICAL 17" PAVEMENT STRUCTURE.
- 7 INSTALL TYPE III MONUMENT PER STD. DWG. #241.
- 8 REMOVE EXIST. CONC. SIDEWALK AND DRIVEWAYS. BACKFILL AS NECESSARY WITH NATIVE BACKFILL MATERIAL. STRUCTURAL SECTION, SIDEWALK OR CURB & GUTTER.
- 9 INSTALL NDOT TYPE 3 MEDIAN CURB. SEE NDOT STD. DWG. R-5.1.1 (613) AND DETAIL SHEET D-2
- 11 REMOVE EXIST. CONC. ISLAND AND BACKFILL IN KIND OR AS DIRECTED BY THE ENGINEER.
- 18 EXIST. MEDIAN ISLAND TO REMAIN
- 19 INSTALL TACK ON ISLAND PER CCA STD. DWG. #221 AND DETAILS PER PLANS.
- 20 CONSTRUCT CONC. S.W. (4" THICK) FROM BACK OF CURB TO RIGHT OF WAY (8' MAX) PER CCA STD. DWG. #234. SEE TYPICAL SECTIONS, SHEET T-1.
- 21 REMOVE AND RELOCATE EXIST. IRON GATE INCLUDING POSTS AND FOUNDATIONS. EXACT LOCATION TO BE DETERMINED BY THE ENGINEER AT THE TIME OF CONSTRUCTION.
- 22 CONSTRUCT NDOT TYPE 5 C&G. SEE NDOT STD. DWG. R-5.1.1 (613).
- 23 REMOVE EXIST. SW AS NECESSARY TO INSTALL SIDEWALK RAMP PER NDOT STD. DWG. R-5.1.1.1 (613) TYPE B AND RAMP TABLE THIS SHEET.
- 24 REMOVE EXIST. PLANTER BOX AND PLANTS. REMOVE EXIST. IRRIGATION BOXES AND HOSE BIBS AND CAP WATER LINES BELOW GRADE AS REQUIRED BY THE ENGINEER.
- 26 REMOVE/REPLACE PRIVATE SIGN OR LIGHT
- 27 INSTALL SIDEWALK DRAIN PER USD No. 236

Call before you Dig.  
1-800-227-2600  
UNDERGROUND SERVICE ALERT (USA)

**RAMP TABLE**

RAMP	A	B	C	D
R1	6.5'	6.5'	6.0'	4 MIN.
R2	6.0'	6.0'	6.0'	4 MIN.
R3	8.0'	8.0'	6.0'	2'

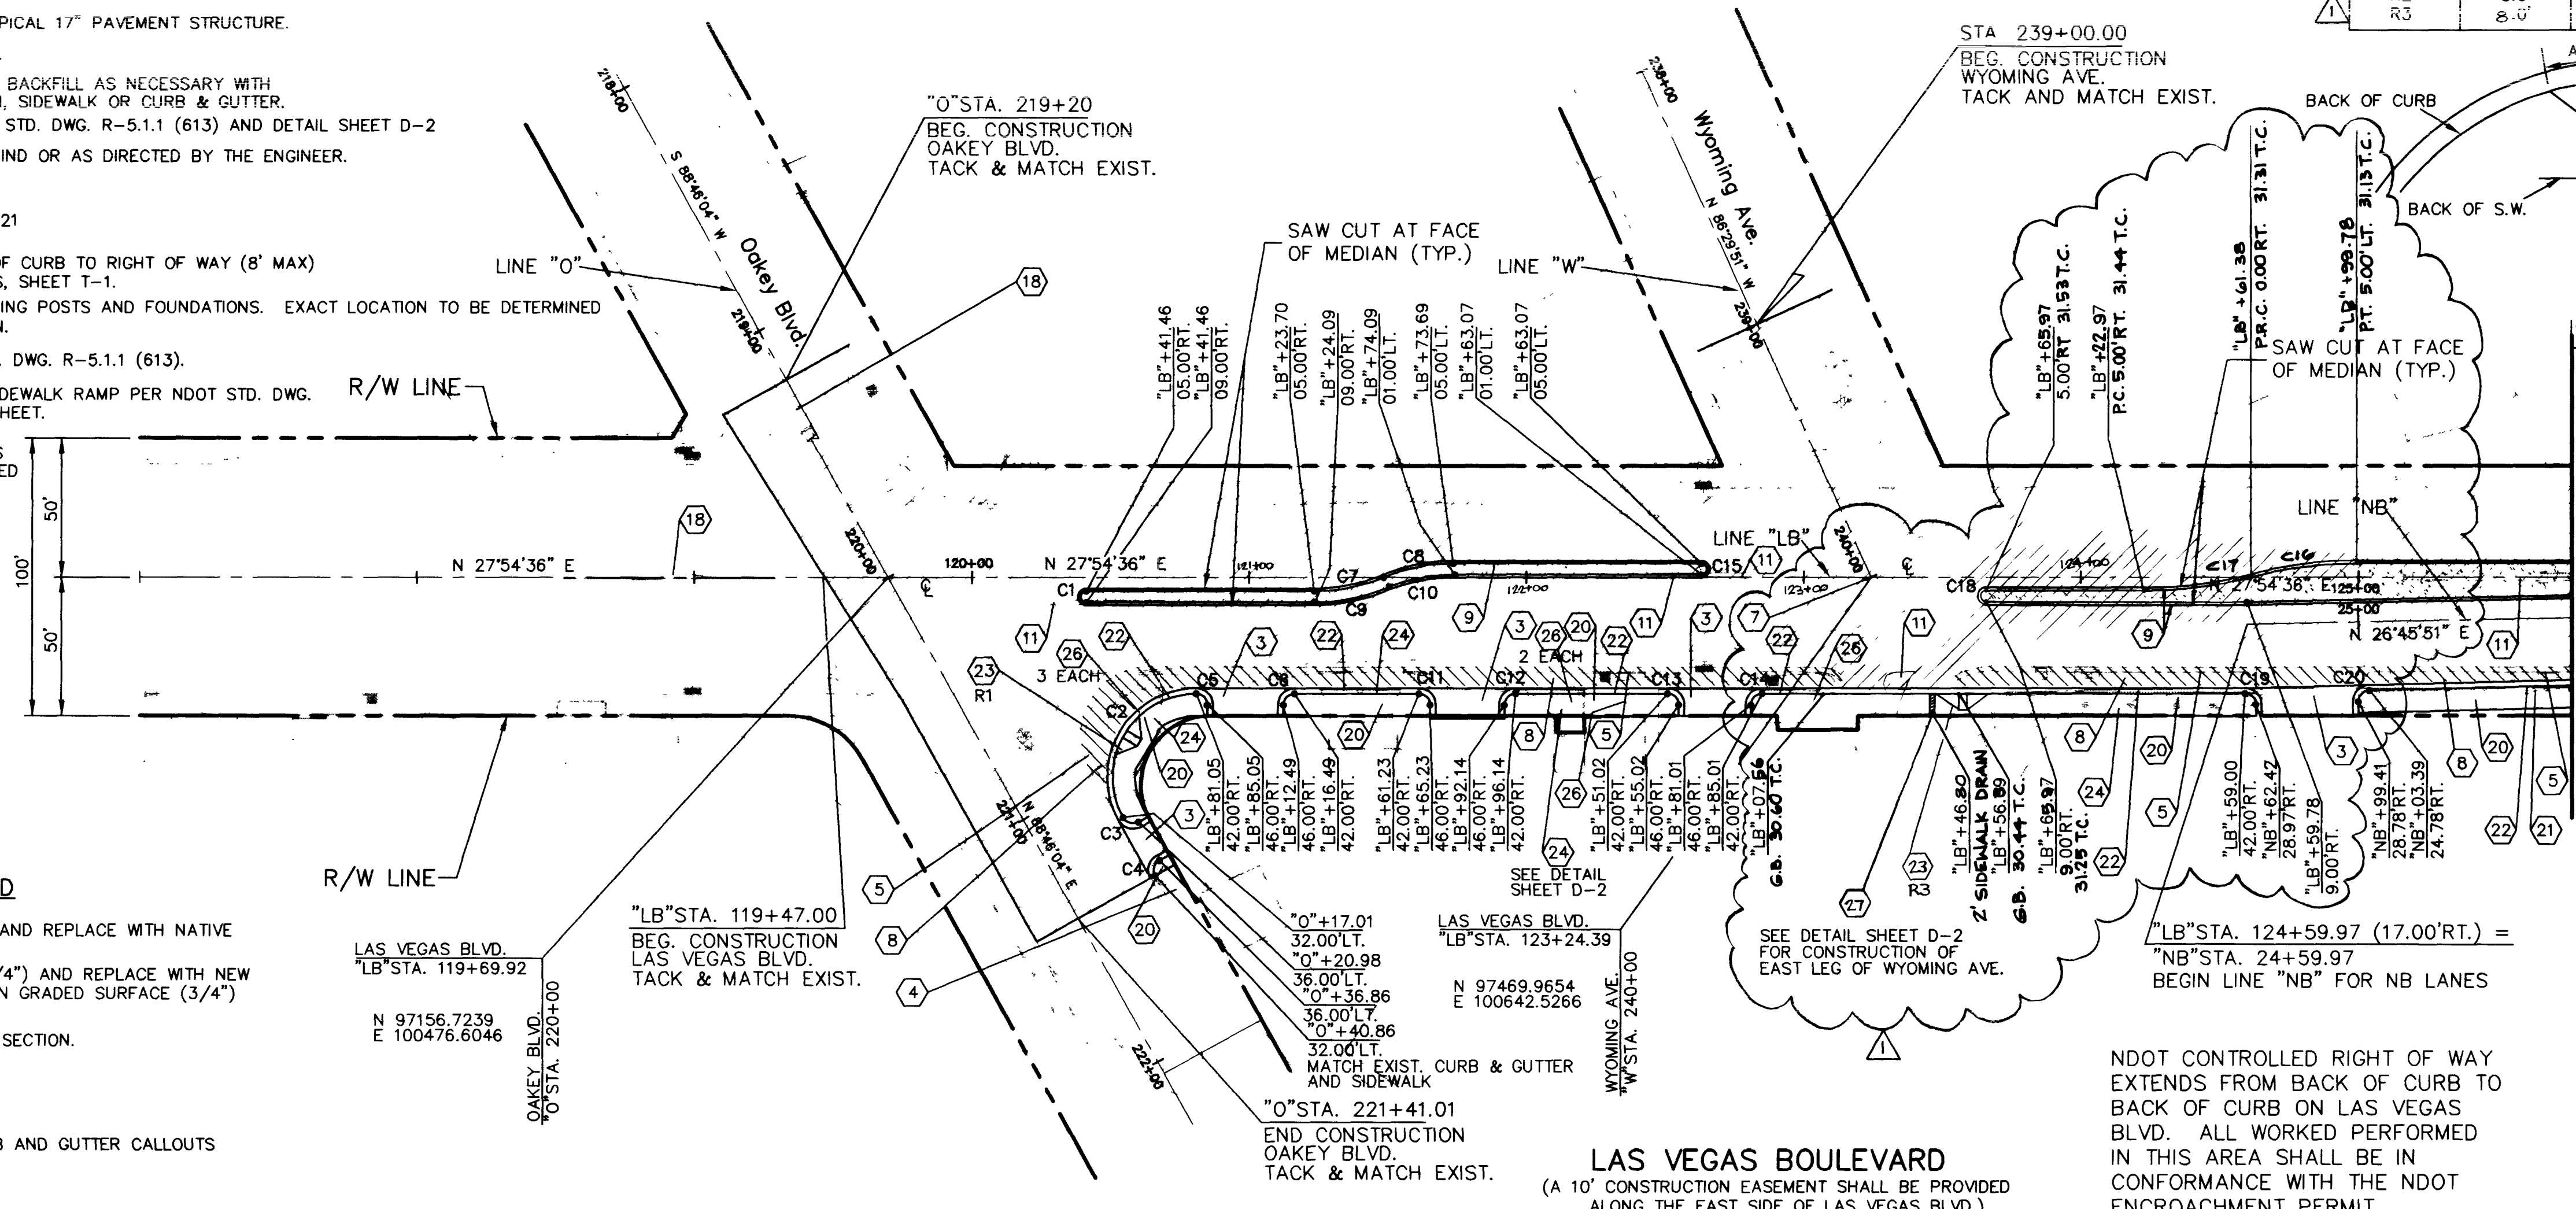

**CURVE DATA**



CURVE	RADIUS	LENGTH	TANGENT	DELTA	NOTES
C1	2.00'	6.28'	<infinite>	180°00'00"	B.C.
C2	30.00'	62.35'	51.013'	119°04'53"	B.C.
C3	4.00'	6.28'	4.000'	90°00'00"	B.C.
C4	4.00'	6.28'	4.000'	90°00'00"	B.C.
C5	4.00'	6.28'	4.000'	90°00'00"	B.C.
C6	4.00'	6.28'	4.000'	90°00'00"	B.C.
C7	64.97'	25.65'	12.998'	22°37'27"	B.C.
C8	64.97'	25.65'	12.998'	22°37'27"	B.C.
C9	65.00'	25.66'	13.000'	22°37'12"	B.C.
C10	65.00'	25.66'	13.000'	22°37'12"	B.C.
C11	4.00'	6.28'	4.000'	90°00'00"	B.C.
C12	4.00'	6.28'	4.000'	90°00'00"	B.C.
C13	4.00'	6.28'	4.000'	90°00'00"	B.C.
C14	4.00'	6.28'	4.000'	90°00'00"	B.C.
C15	2.00'	6.28'	<infinite>	180°00'00"	B.C.
C16	150.00'	38.24'	19.53'	14°50'06"	B.C.
C17	150.00'	38.24'	19.53'	14°50'06"	B.C.
C18	2.00'	6.28'	<infinite>	180°00'00"	B.C.
C19	4.00'	6.28'	4.000'	90°00'00"	B.C.
C20	4.00'	6.28'	3.985'	89°47'23"	B.C.
C21	0.50'	0.99'	0.76'	113°02'00"	MED. FACE
C22	0.50'	0.99'	0.76'	112°42'32"	MED. FACE
C23	21.50'	9.49'	4.82'	26°16'36"	MED. FACE
C24	0.50'	1.36'	2.64'	159°34'22"	MED. FACE

**LEGEND**

- REMOVE EXIST. PAVEMENT AND REPLACE WITH NATIVE BACKFILL MATERIAL.
- ROTOMILL OPEN GRADE (3/4") AND REPLACE WITH NEW PLANTMIX BITUMINOUS OPEN GRADED SURFACE (3/4")
- INSTALL NEW STRUCTURAL SECTION. SEE "T" SHEETS

STA / DIST  
STATION AND OFFSET CURB AND GUTTER CALLOUTS

Time: 15:45:00.0  
Date: 4/18/1996  
Drawing File: 990302\PH2\C-1

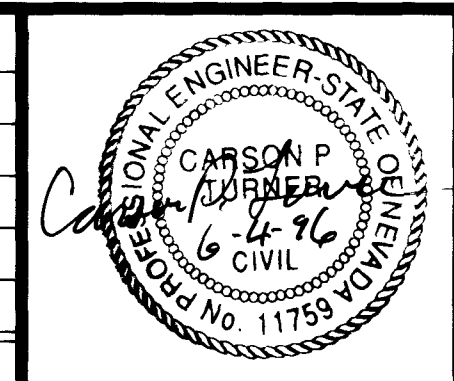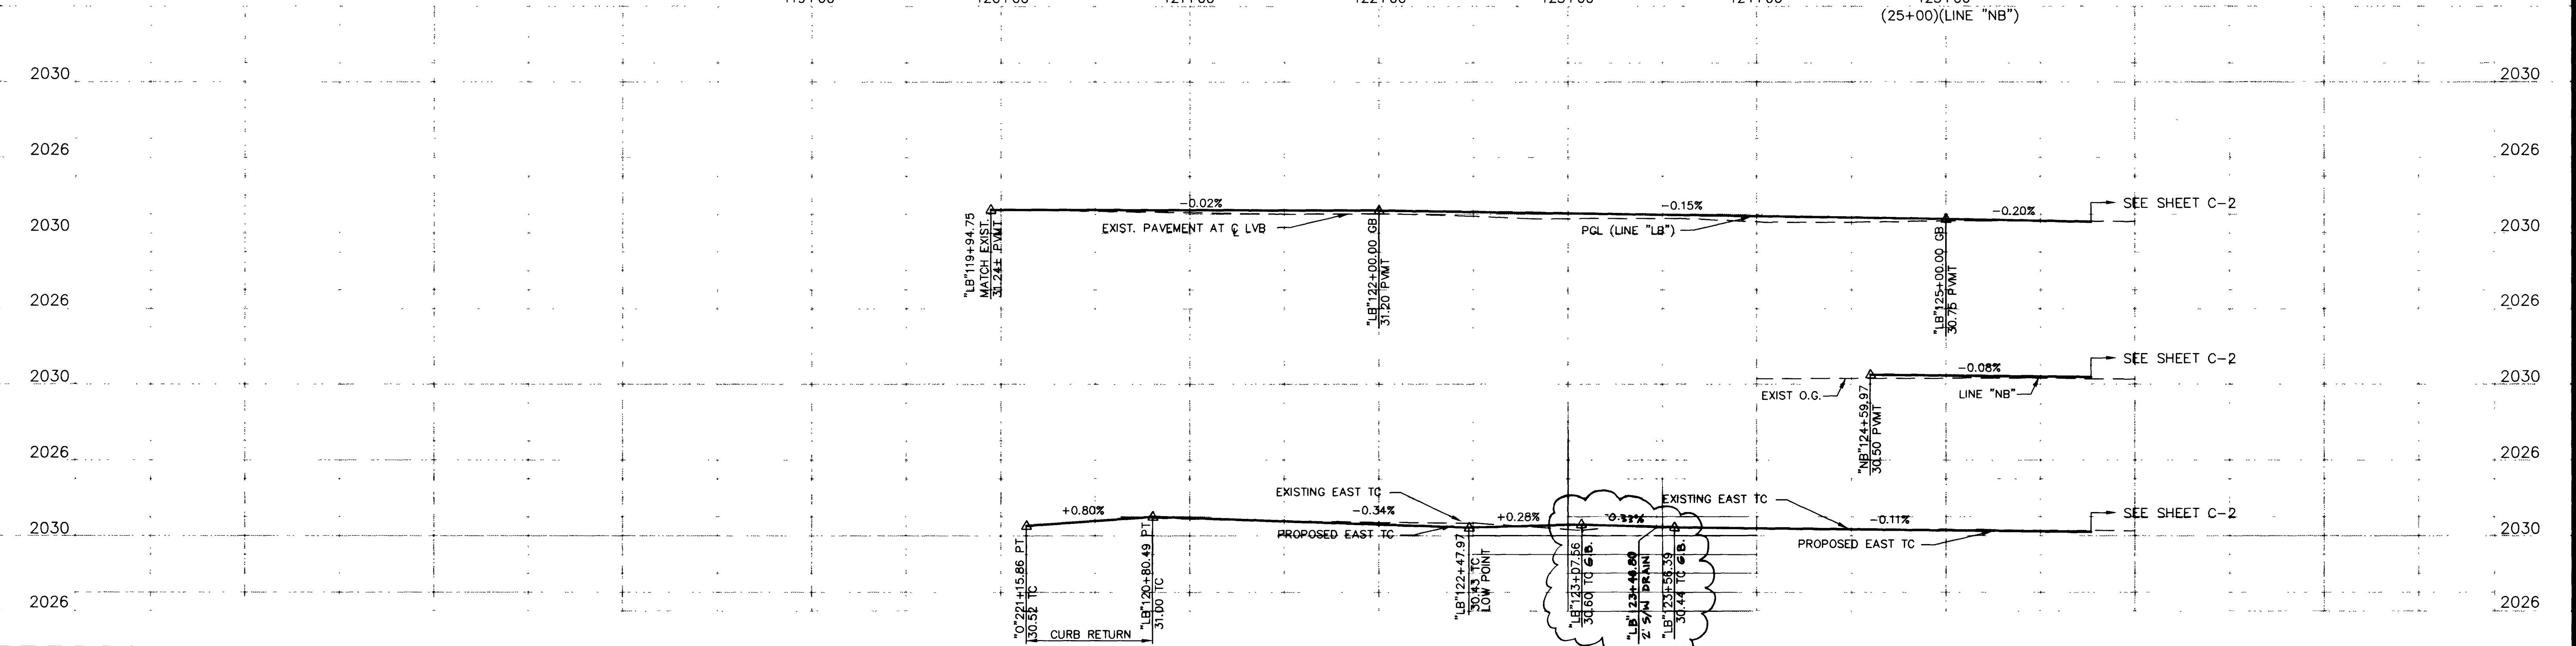

**Kimley-Horn and Associates, Inc.**  
Las Vegas, Nevada © 1996

DESIGNED BY CPT  
DRAWN BY CDR  
CHECKED BY CPT  
NOTE BOOK NO.

**CITY OF LAS VEGAS**  
DOWNTOWN CORRIDOR IMPROVEMENTS  
CITY OF LAS VEGAS DEPT. OF PUBLIC WORKS  
LAS VEGAS, NEVADA

DATE 6/96  
SCALE  
H 1"=40'  
V 1"=4'

**PLAN AND PROFILE**  
"LB" STA. 119+47 TO "LB" STA. 125+77

DWG. NO. 107-V-2288B  
FILE NO. 9903.02  
SHEET 14 OF 46  
**C-1**

NO.	REVISIONS	DATE	BY
1	DRIVEWAY DELETED, MEDIAN ISLAND NARROWED FOR LEFT TURN LANE, SIDEWALK DRAIN ADDED, SIDEWALK RAMP DELETED	4-16-97	DLA



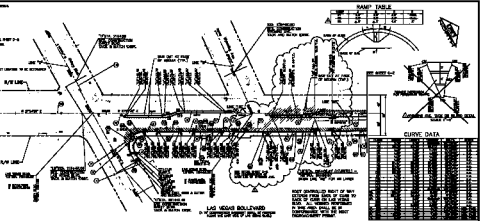








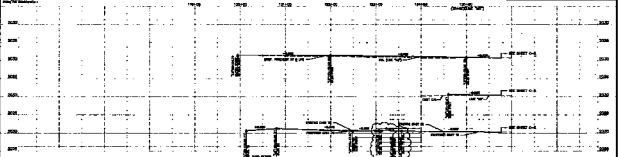

