

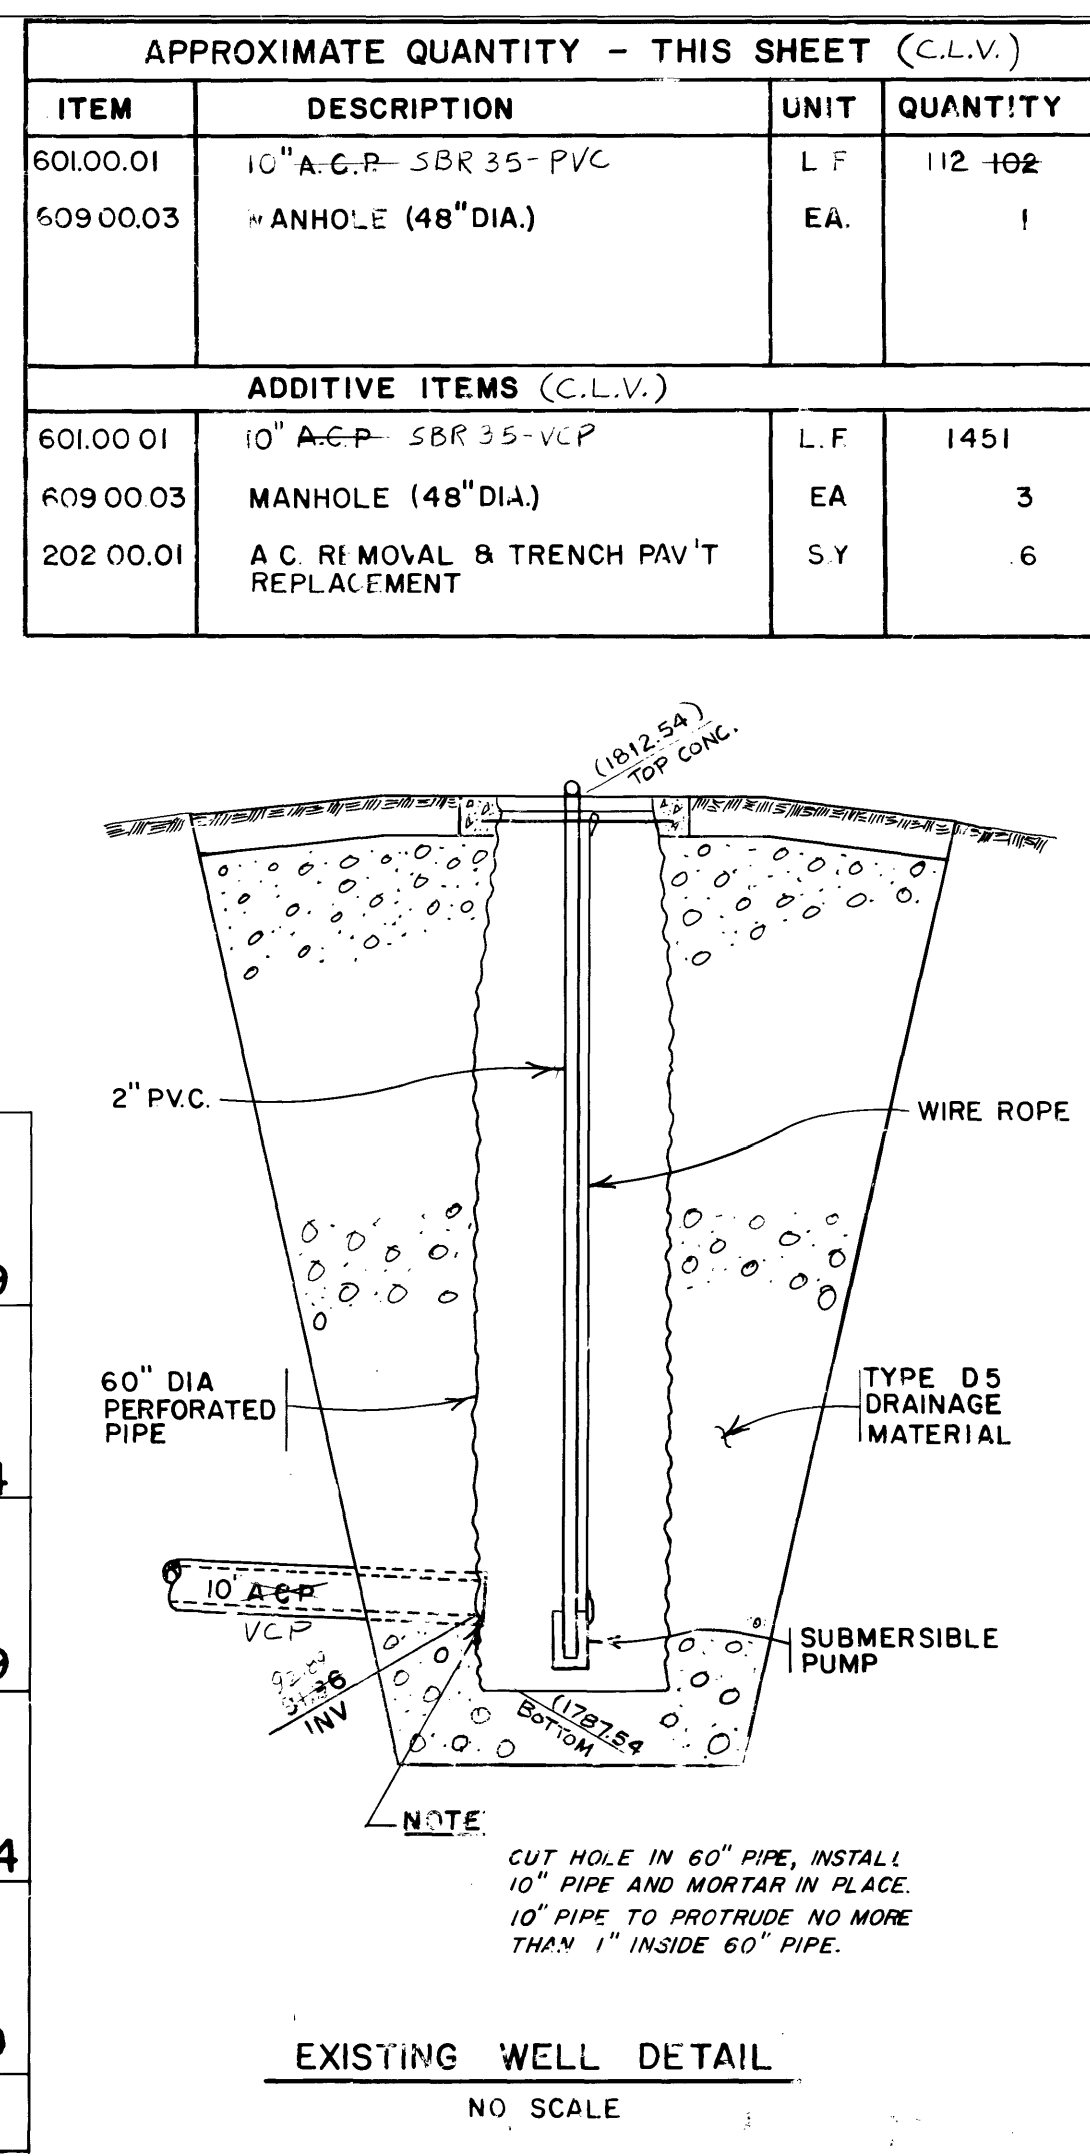


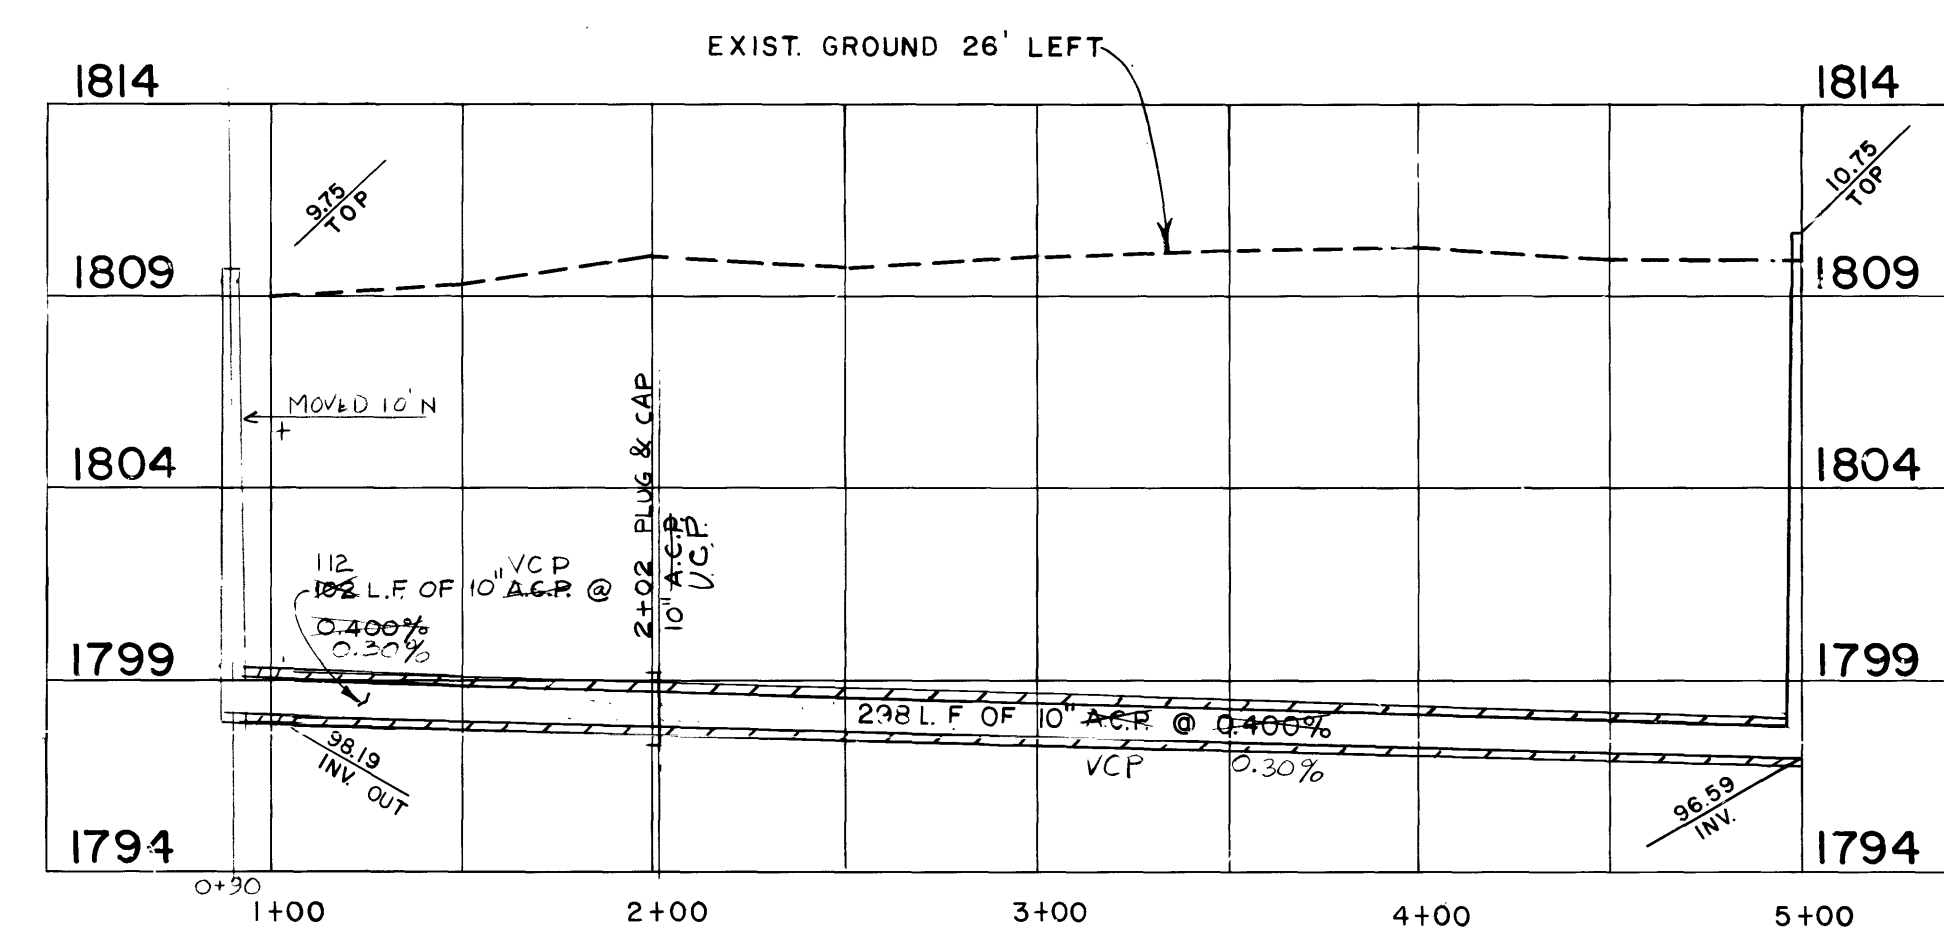

APPROXIMATE QUANTITY - THIS SHEET (C.L.V.)			
ITEM	DESCRIPTION	UNIT	QUANTITY
60100.01	10" A.C.P. SBR 35-PVC	L F	112.102
60900.03	" MANHOLE (48" DIA.)	EA.	1
ADDITIVE ITEMS (C.L.V.)			
60100.01	10" A.C.P. SBR 35-PVC	L F	1451
60900.03	MANHOLE (48" DIA.)	EA	3
20200.01	A C REMOVAL & TRENCH PAV'T REPLACEMENT	S Y	.6

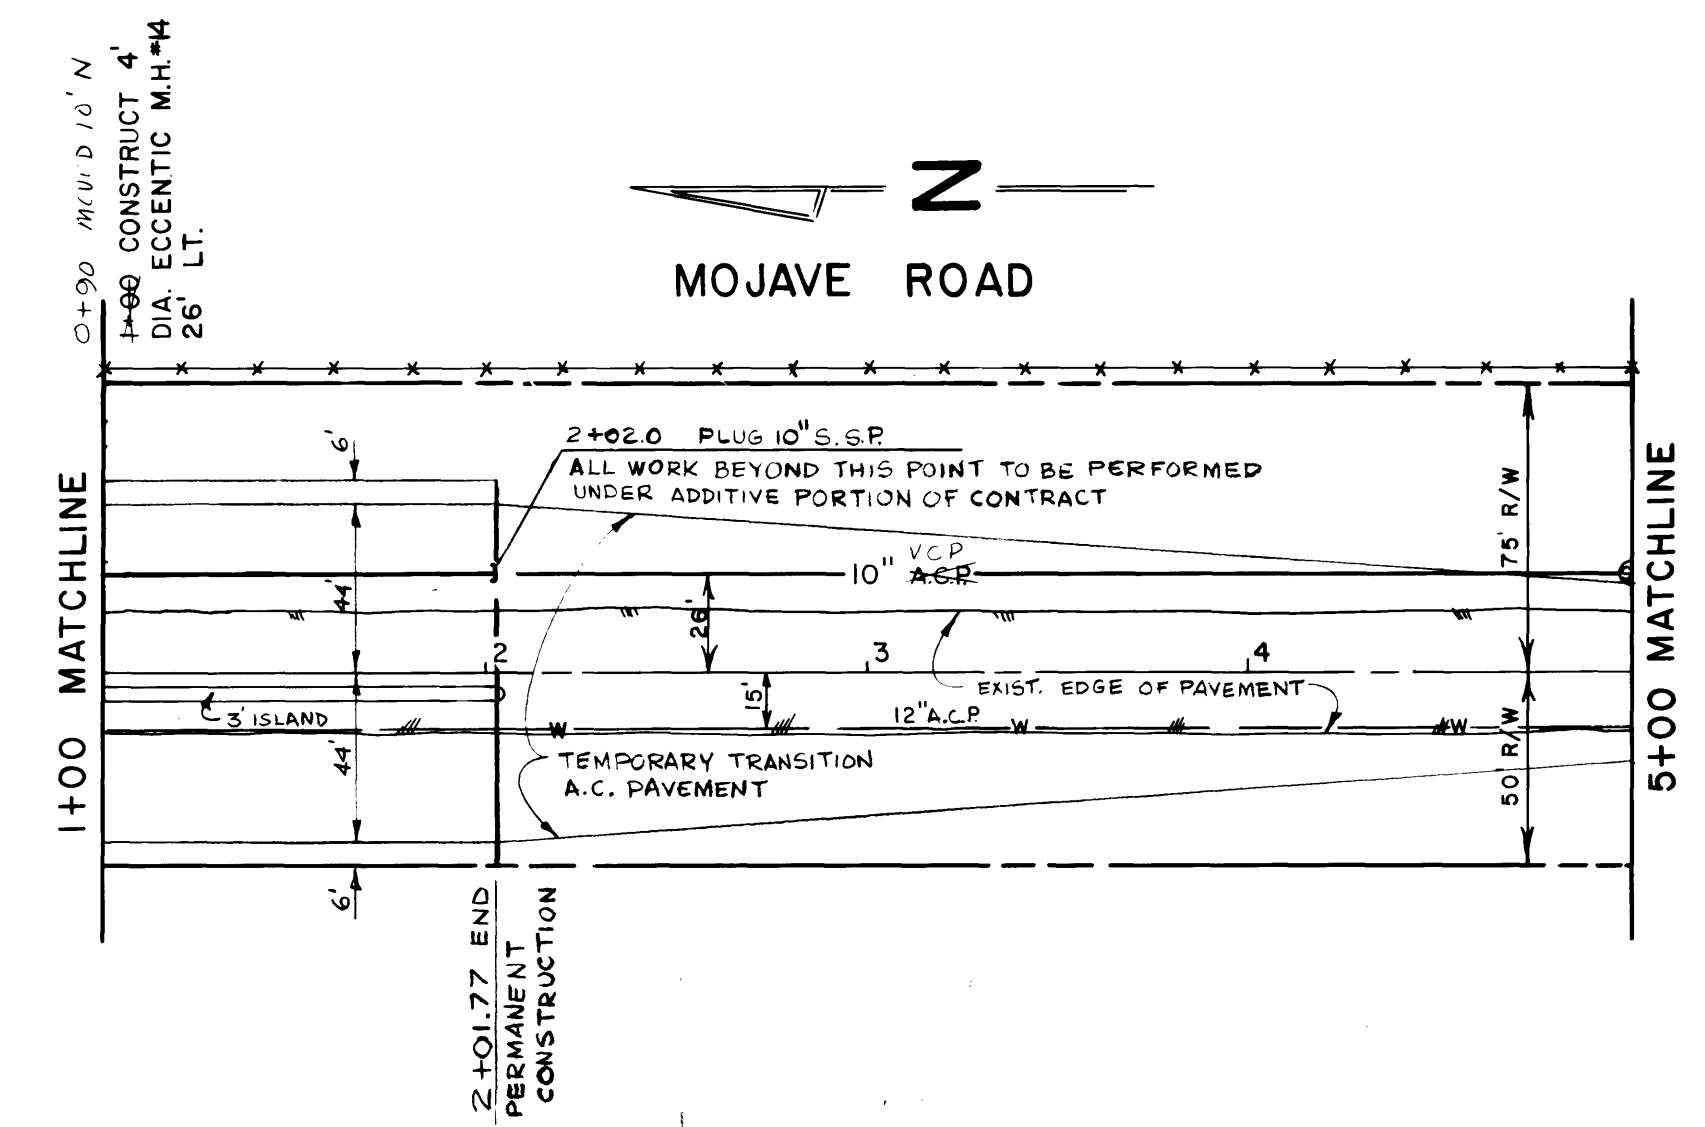