






Found 3/4" Rebar in pavement, Checked from C.L.V. R.P.s. Ref. Book Page 5. Dug and found remains of 3/4" x 1/2" (had been disturbed); Set 6" x 8" x 16" Conc. Mon. with R.E. 290 Tag. For Ref. Pts. See Details.

E 1/16 Corner Neither C-C Found nor set. S3,

Oakey Blvd. N. 88° 29' 21" E - 1333.24 (Computed).

Found 2" I.P. with R.E. 290 Tag. Replaces with 6" x 8" x 16" Conc. Mon. with R.E. 290 Tag. For Ref. Pts. see File 2, Page 35. R.P.E. File.

### DETAILS OF REFERENCE POINTS.

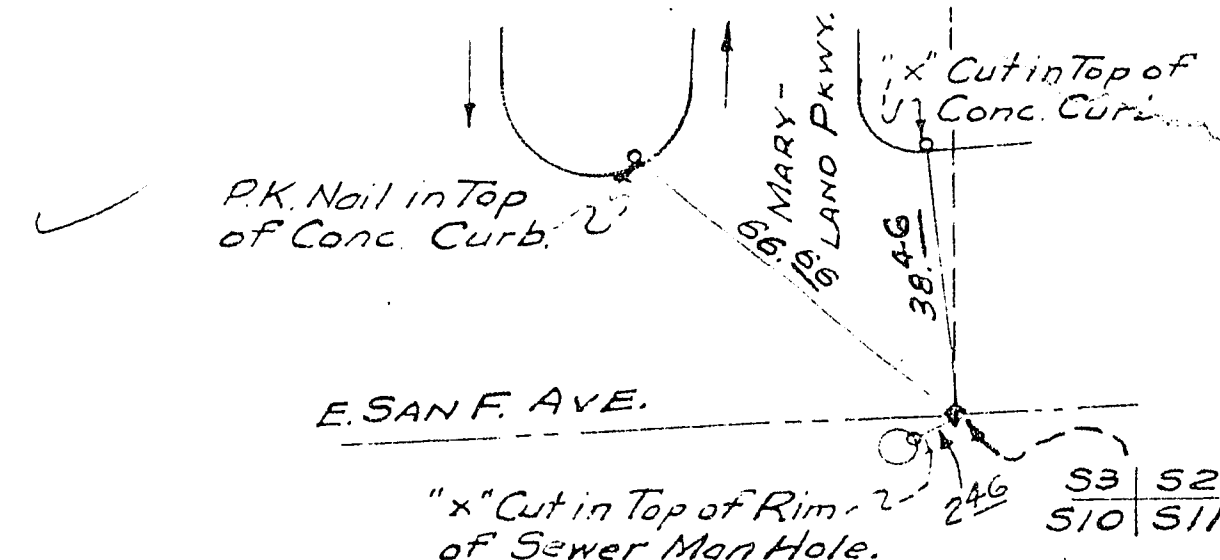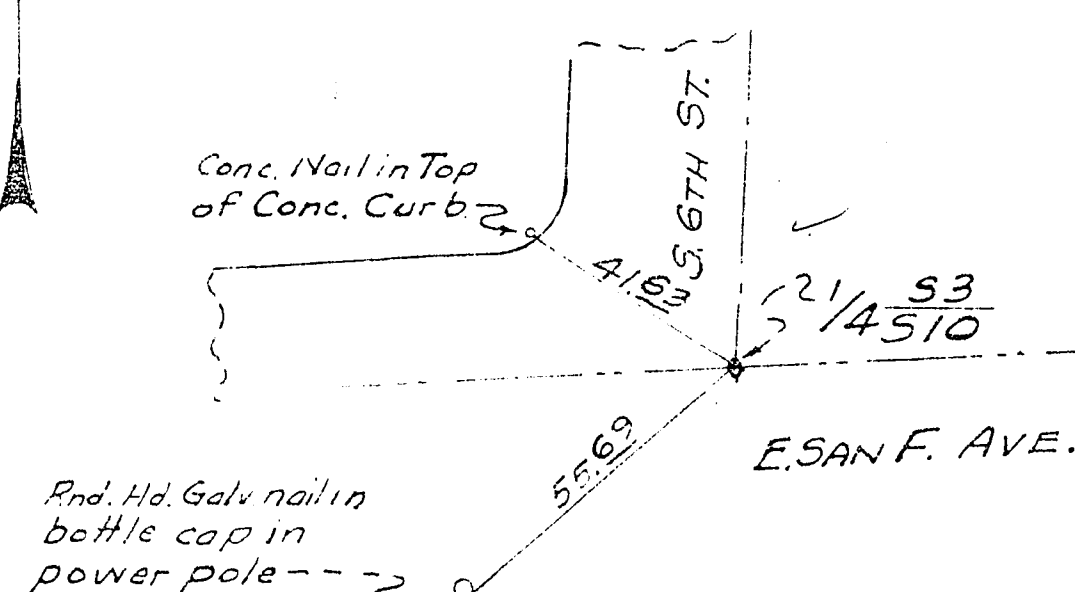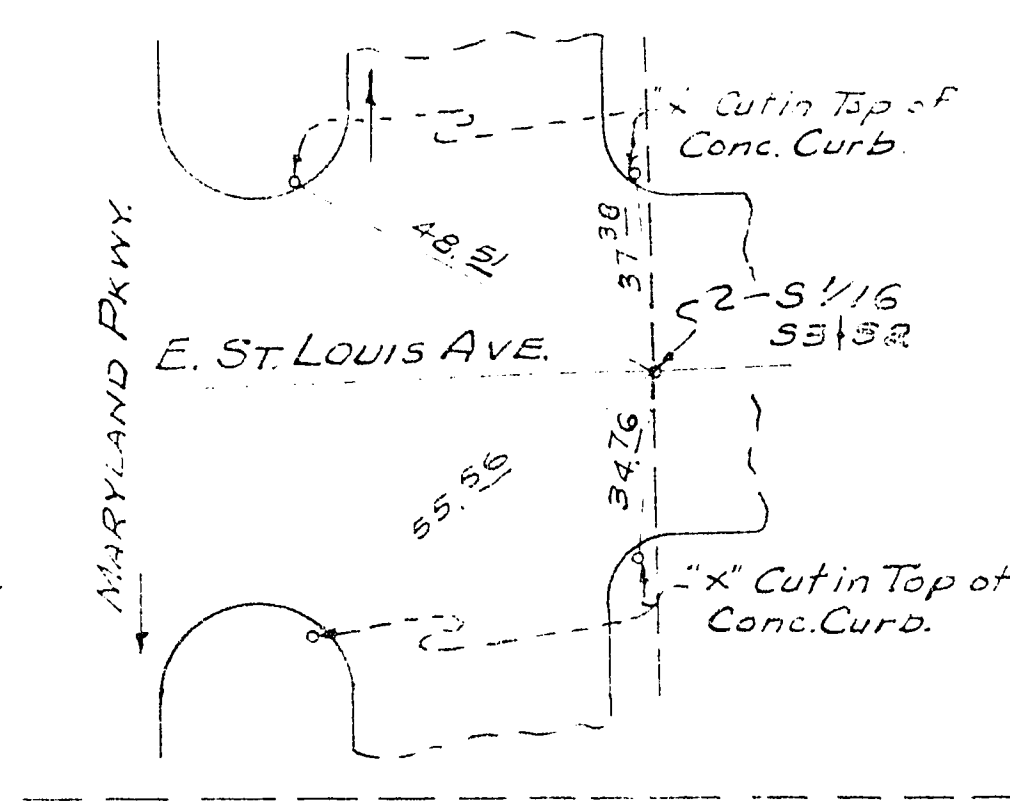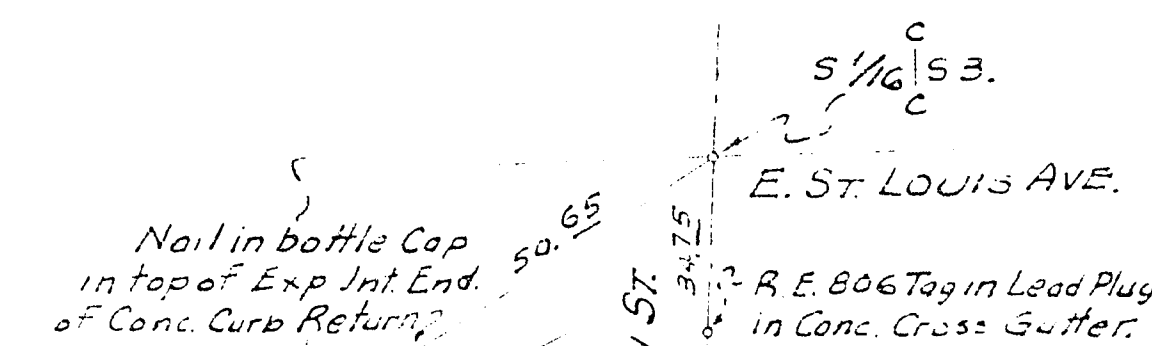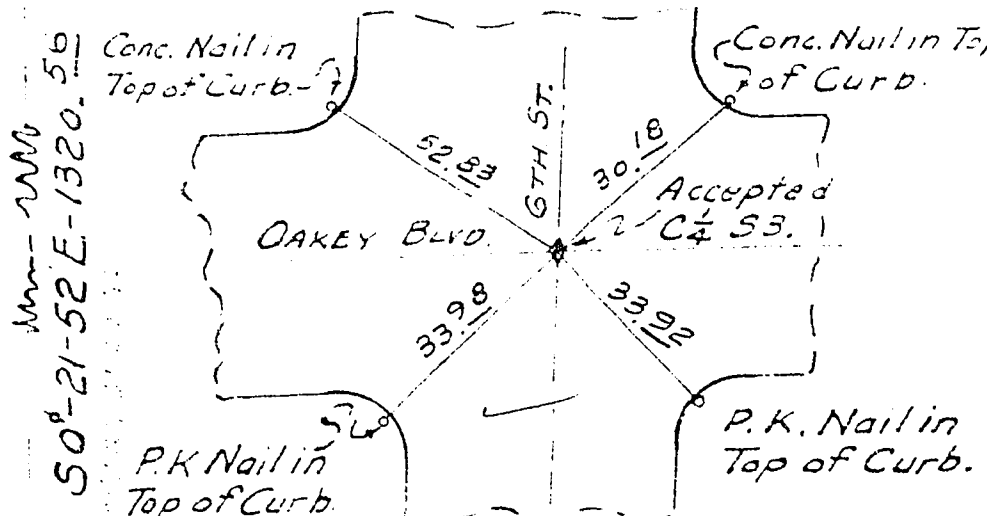

JOHN C. FREMONT SCHOOL.

A PARCEL IN THE S.E. 1/4 OF THE S.E. 1/4 OF SECTION 3, T.21 S., R. 61 E., M.D.B. & M.

**ENGINEER'S CERTIFICATE:** I, Ernest H. Clary, a Registered Professional Civil Engineer, and Land Surveyor of the State of Nevada do hereby certify that I have surveyed the land on this map of the instance of the Clark County School District, and that said map shows correctly the physical conditions portrayed thereon, that the monuments shown thereon actually exist in the positions shown, and said monuments are sufficient to enable this survey to be retraced. That the area surveyed lies wholly within the S.E. 1/4 of the S.E. 1/4 of Section 3, T.21 S., R. 61 E., M.D.B. & M. The boundaries of said parcel, are more particularly described as follows: Commencing at the S.E. Corner of said Section 3, thence N. 0° 31' 52" W. a distance of 1320.55 feet to a point (S 1/16 S3 S2); thence S. 87° 50' 18" W. a distance of 341.21 feet to the TRUE POINT OF BEGINNING; thence S. 0° 07' 43" E. a distance of 640.58 feet to a point; thence S. 87° 50' 18" W. a distance of 1032.92 feet to a point; thence N. 0° 55' 59" E. a distance of 640.58 feet to a point; thence N. 87° 50' 18" E. a distance of 1050.25 feet to the TRUE POINT OF BEGINNING.

SCALE: ONE INCH=100 FEET.

This is not intended to be a subdivision as per Subdivision Act, Section 5063, Nevada Compiled Laws. This survey was completed on May 11, 1957.

Ernest H. Clary, Reg. Prof. Civil Engineer and Land Surveyor. No. 290-Nevada.

MAP FOR RECORD OF SURVEY FOR CLARK COUNTY SCHOOL DISTRICT. A PARCEL IN THE S.E. 1/4 OF THE S.E. 1/4 OF SECTION 3, T.21 S., R. 61 E., M.D.B. & M. IN THE CITY OF LAS VEGAS, CLARK COUNTY, NEVADA. SEE 0087-191 for same survey (copy) 550.8-4 File 7 PAGE 7