

Partial Floor Plan  
Pool House

Municipal Pool at Dula Center  
City of Las Vegas

job no:  
9700400  
date:  
1-26-98  
drawn by:  
SH  
checked by:

issued for  
BID  
SET

sheet no.

**A2.3**

BE#

23 OF 104









GENERAL NOTES  

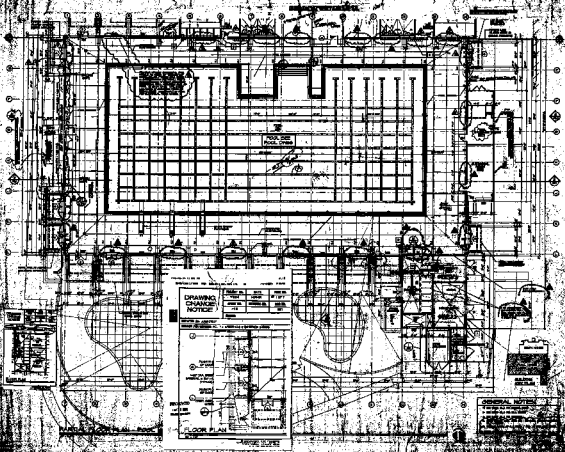

DRAWING CHANGE NOTICE

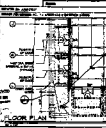

