CEILING LEGEND

SYMBOL	CEILING DESCRIPTION	FLOOR OR ROOF REQ. RATING	LISTED ASSEMBLY *
A ELEV.	EXPOSED STRUCTURE	N/R	—
B ELEV.	5/8" GYP. BOARD CEILING	1 HR.	RC-1
C ELEV.	SPRAYED FIREPROOFING O/ EXPOSED STRUCTURE	1 HR.	RC-1
D ELEV.	2x2 SUSPENDED ACT. CEILING (NON-RATED)	1 HR.	RC-1

A

* SEE SHEET G1.2 FOR LISTED ASSEMBLIES AND FIRE STOP PENETRATIONS

CEILING FIXTURE LEGEND

- SUPPLY AIR - SEE MECHANICAL DWGS
- RETURN AIR - SEE MECHANICAL DWGS
- EXHAUST FAN - SEE MECHANICAL DWGS
- FAN COIL UNIT - SEE MECHANICAL DWGS
- RECESSED LIGHT FIXTURE
- ILLUMINATED EXIT SIGN
- WALL MOUNTED LIGHT FIXTURE
- CEILING MOUNTED PENDANT FIXTURE
- CEILING MOUNTED FLUORESCENT FIXTURE
- CHAIN-HUNG FLUORESCENT FIXTURE
- RECESSED FLUORESCENT FIXTURE
- RECESSED PERIMETER FLUORESCENT FIXTURE
- STRIP PENDANT FLUORESCENT FIXTURE
- METAL STUD WALL TO UNDERSIDE OF ROOF DECK. SEE NOTE #5

GENERAL NOTES:

A. THE GENERAL CONTRACTOR SHALL REVIEW THE CONTRACT DOCUMENTS AND ADVISE THE ARCHITECT OF ANY DISCREPANCIES IN THE DIMENSIONS OR DRAWINGS PRIOR TO CONSTRUCTION.

B. ALL DIMENSIONS ARE TO FACE OF MATERIAL/FINISH U.N.O.

C. CONTRACTOR SHALL COORDINATE FIRE SPRINKLER HEAD LOCATIONS WITH MECHANICAL AND ELECTRICAL ITEMS. CENTER ALL HEADS IN THE TILE WHERE OCCURS.

D. ALL ACOUSTICAL TILE CEILINGS TO BE CENTERED IN ROOM OR AREA. BORDER OR EDGE TILE SHALL NOT BE LESS THAN HALF TILE IF POSSIBLE (U.N.O.)

E. ADD GENERAL NOTE "E: SEE DETAILS 1.2.7 FOR TYPICAL CEILING SUSPENSION / FRAMING DETAILS."

KEY NOTES:

1. ROOF HATCH & ACCESS LADDER
2. SKYLIGHT
3. PROVIDE 3 5/8" METAL STUD WALL WITH 5/8" GYP. BD. EA. SIDE TO UNDER SIDE OF ROOF CEILING ASSEMBLY.
4. ROLL UP SHUTTER 1 HR. RATED. SEE DOOR SCHEDULE
5. EXPOSED BEAM, PAINTED. SEE ROOM FINISH SCHEDULE.
6. EXPOSED BAR JOIST, PAINTED. SEE ROOM FINISH SCHEDULE.
7. POLYCARBONATE ROOF PANEL.
8. POCHE AREA INDICATES 1 5/8" "TYPE X" GYP. BD. CEIL O/ 7/8" HAT CHANNELS @ 24" O.C. O/ 1 1/2" C.R. CHANNELS @ 48" O.C. AT BOTTOM OF TRUSSES

ADD TO KEYNOTE NO. 8 "W/ NON-RATED SUSPEND ACOUSTICAL TILE CEILING BELOW. ADD 1

DRAWING CHANGE NOTICE	PROJECT NO.	DATE	PAGE NO.
	97004	11-10-97	2 of 5
	SHEET NO.	REVISION NO.	DCN NO.
	A3.1	3	
	SIGNED:		

INITIATED BY: ARCHITECT


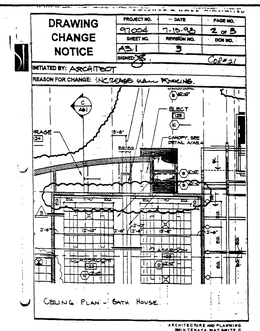

DRAWING CHANGE NOTICE	PROJECT NO.	DATE	PAGE NO.
	97004	8-17-96	1 of 1
	SHEET NO.	REVISION NO.	DCN NO.
	A3.1	4	06
	SIGNED:		

INITIATED BY: Owner Direction ASI #17

REASON FOR CHANGE: Install conduit w/ exit window

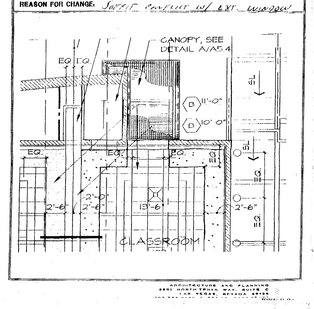

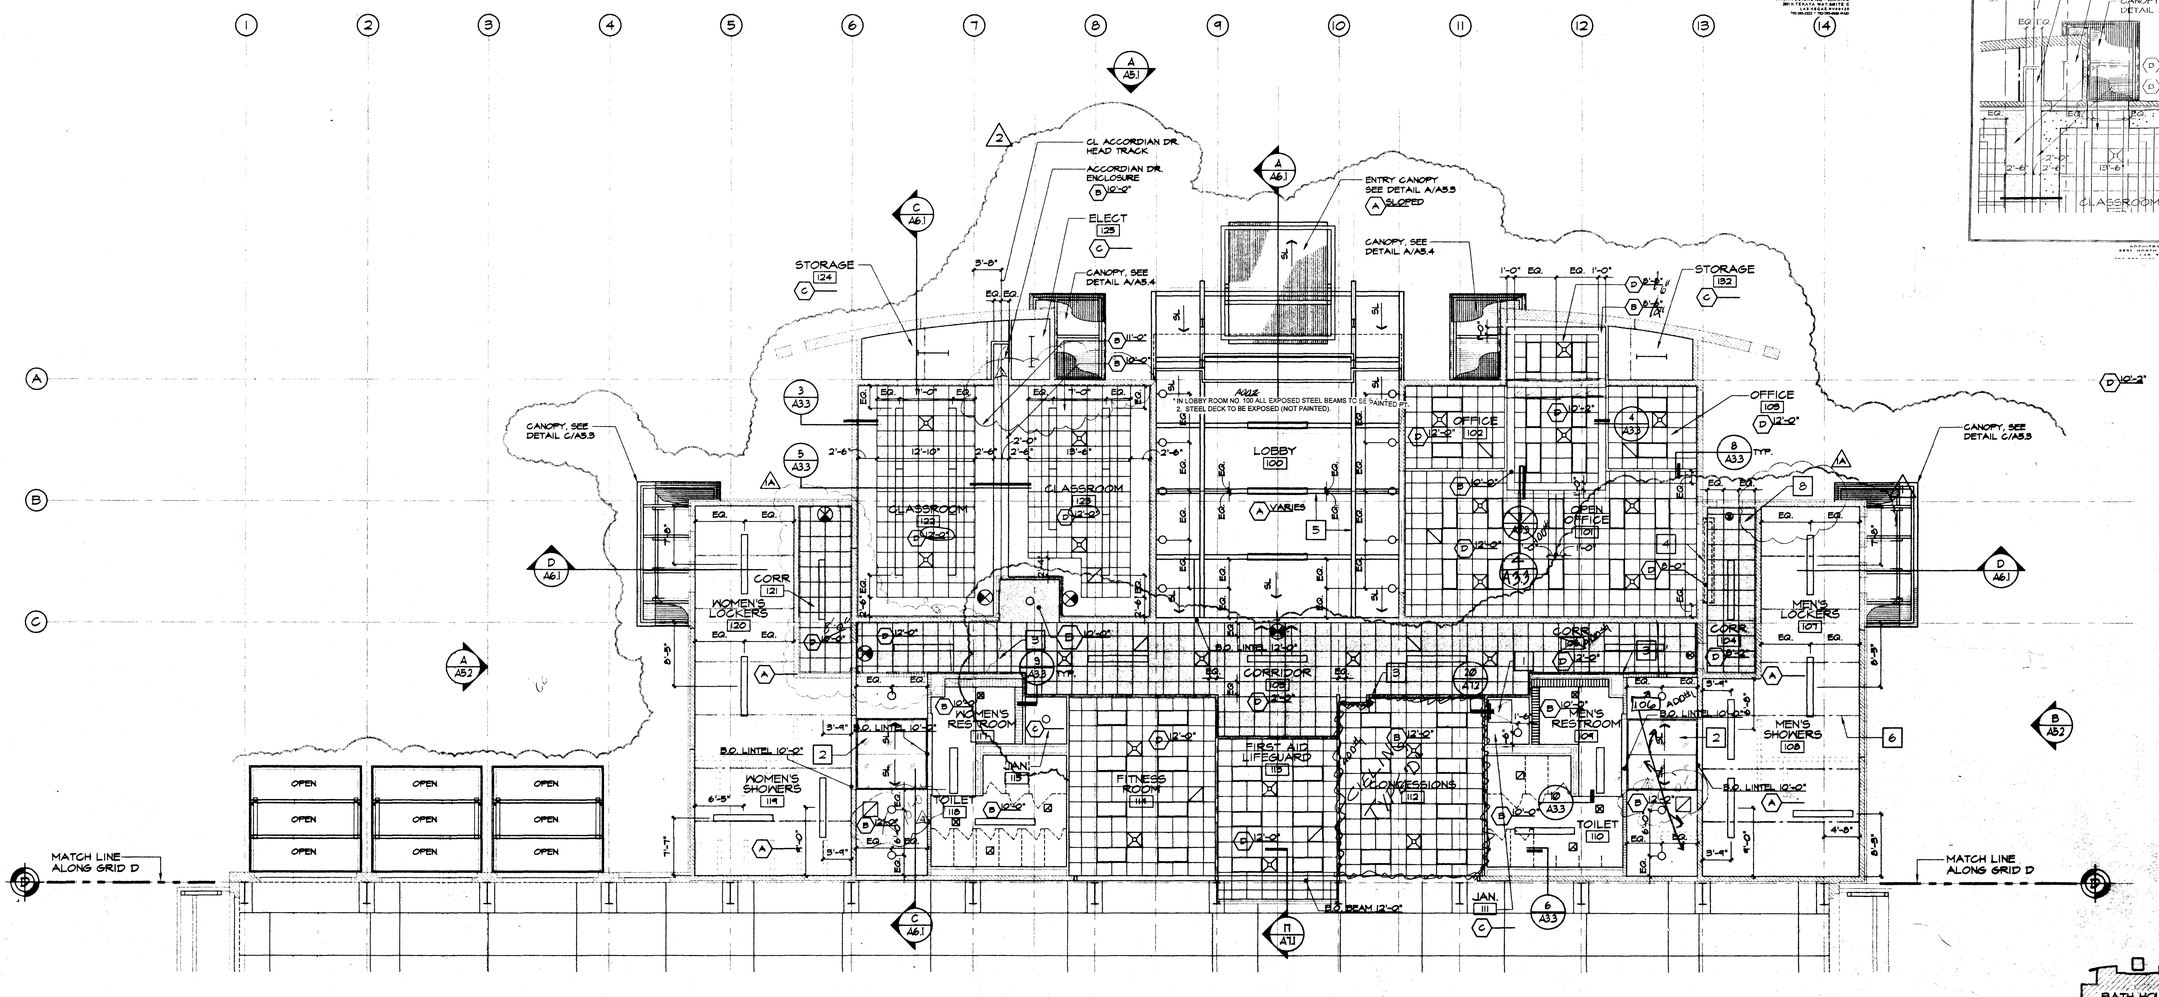

PARTIAL REFLECTED CEILING PLAN - BATH HOUSE

1/8" = 1'-0"

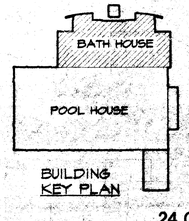

BUILDING KEY PLAN

NORTH

AS BUILT

issued for: BID SET

sheet no. A3.1

revisions
1 PLAN CHECK COMMENTS
2 PLAN CHECK COMMENTS 12-17-97
3 COORDINATION / OWNER COMMENTS 1-26-98

Swisher & Hall Architects Limited Copyright 1996

SWISHER & HALL
AIA, LIMITED
ARCHITECTURE AND PLANNING
2801 NORTH TENAYA WAY, SUITE C
LAS VEGAS, NEVADA 89128
702.363.2222 702.363.6060 (FAX)

project title: PARTIAL REFLECTED CEILING PLAN BATH HOUSE

job title: MUNICIPAL POOL AT DULA CENTER CITY OF LAS VEGAS

job no.: 97004.00
date: 1-26-98
drawn by: SH
checked by:

17616

J:\97004\DWGS\70A4A301.DWG Sat Jan 24 15:07:54 1998

CEILING LEGEND

CEILING FIXTURE LEGEND

GENERAL NOTES

KEY NOTES

DRAWING CHANGE NOTICE

PARTIAL REFLECTED CEILING PLAN - BATH HOUSE

AS BUILT

SWIGNER & HALL
A.I.A. LIMITED

PARTIAL REFLECTED CEILING PLAN
BATH HOUSE