


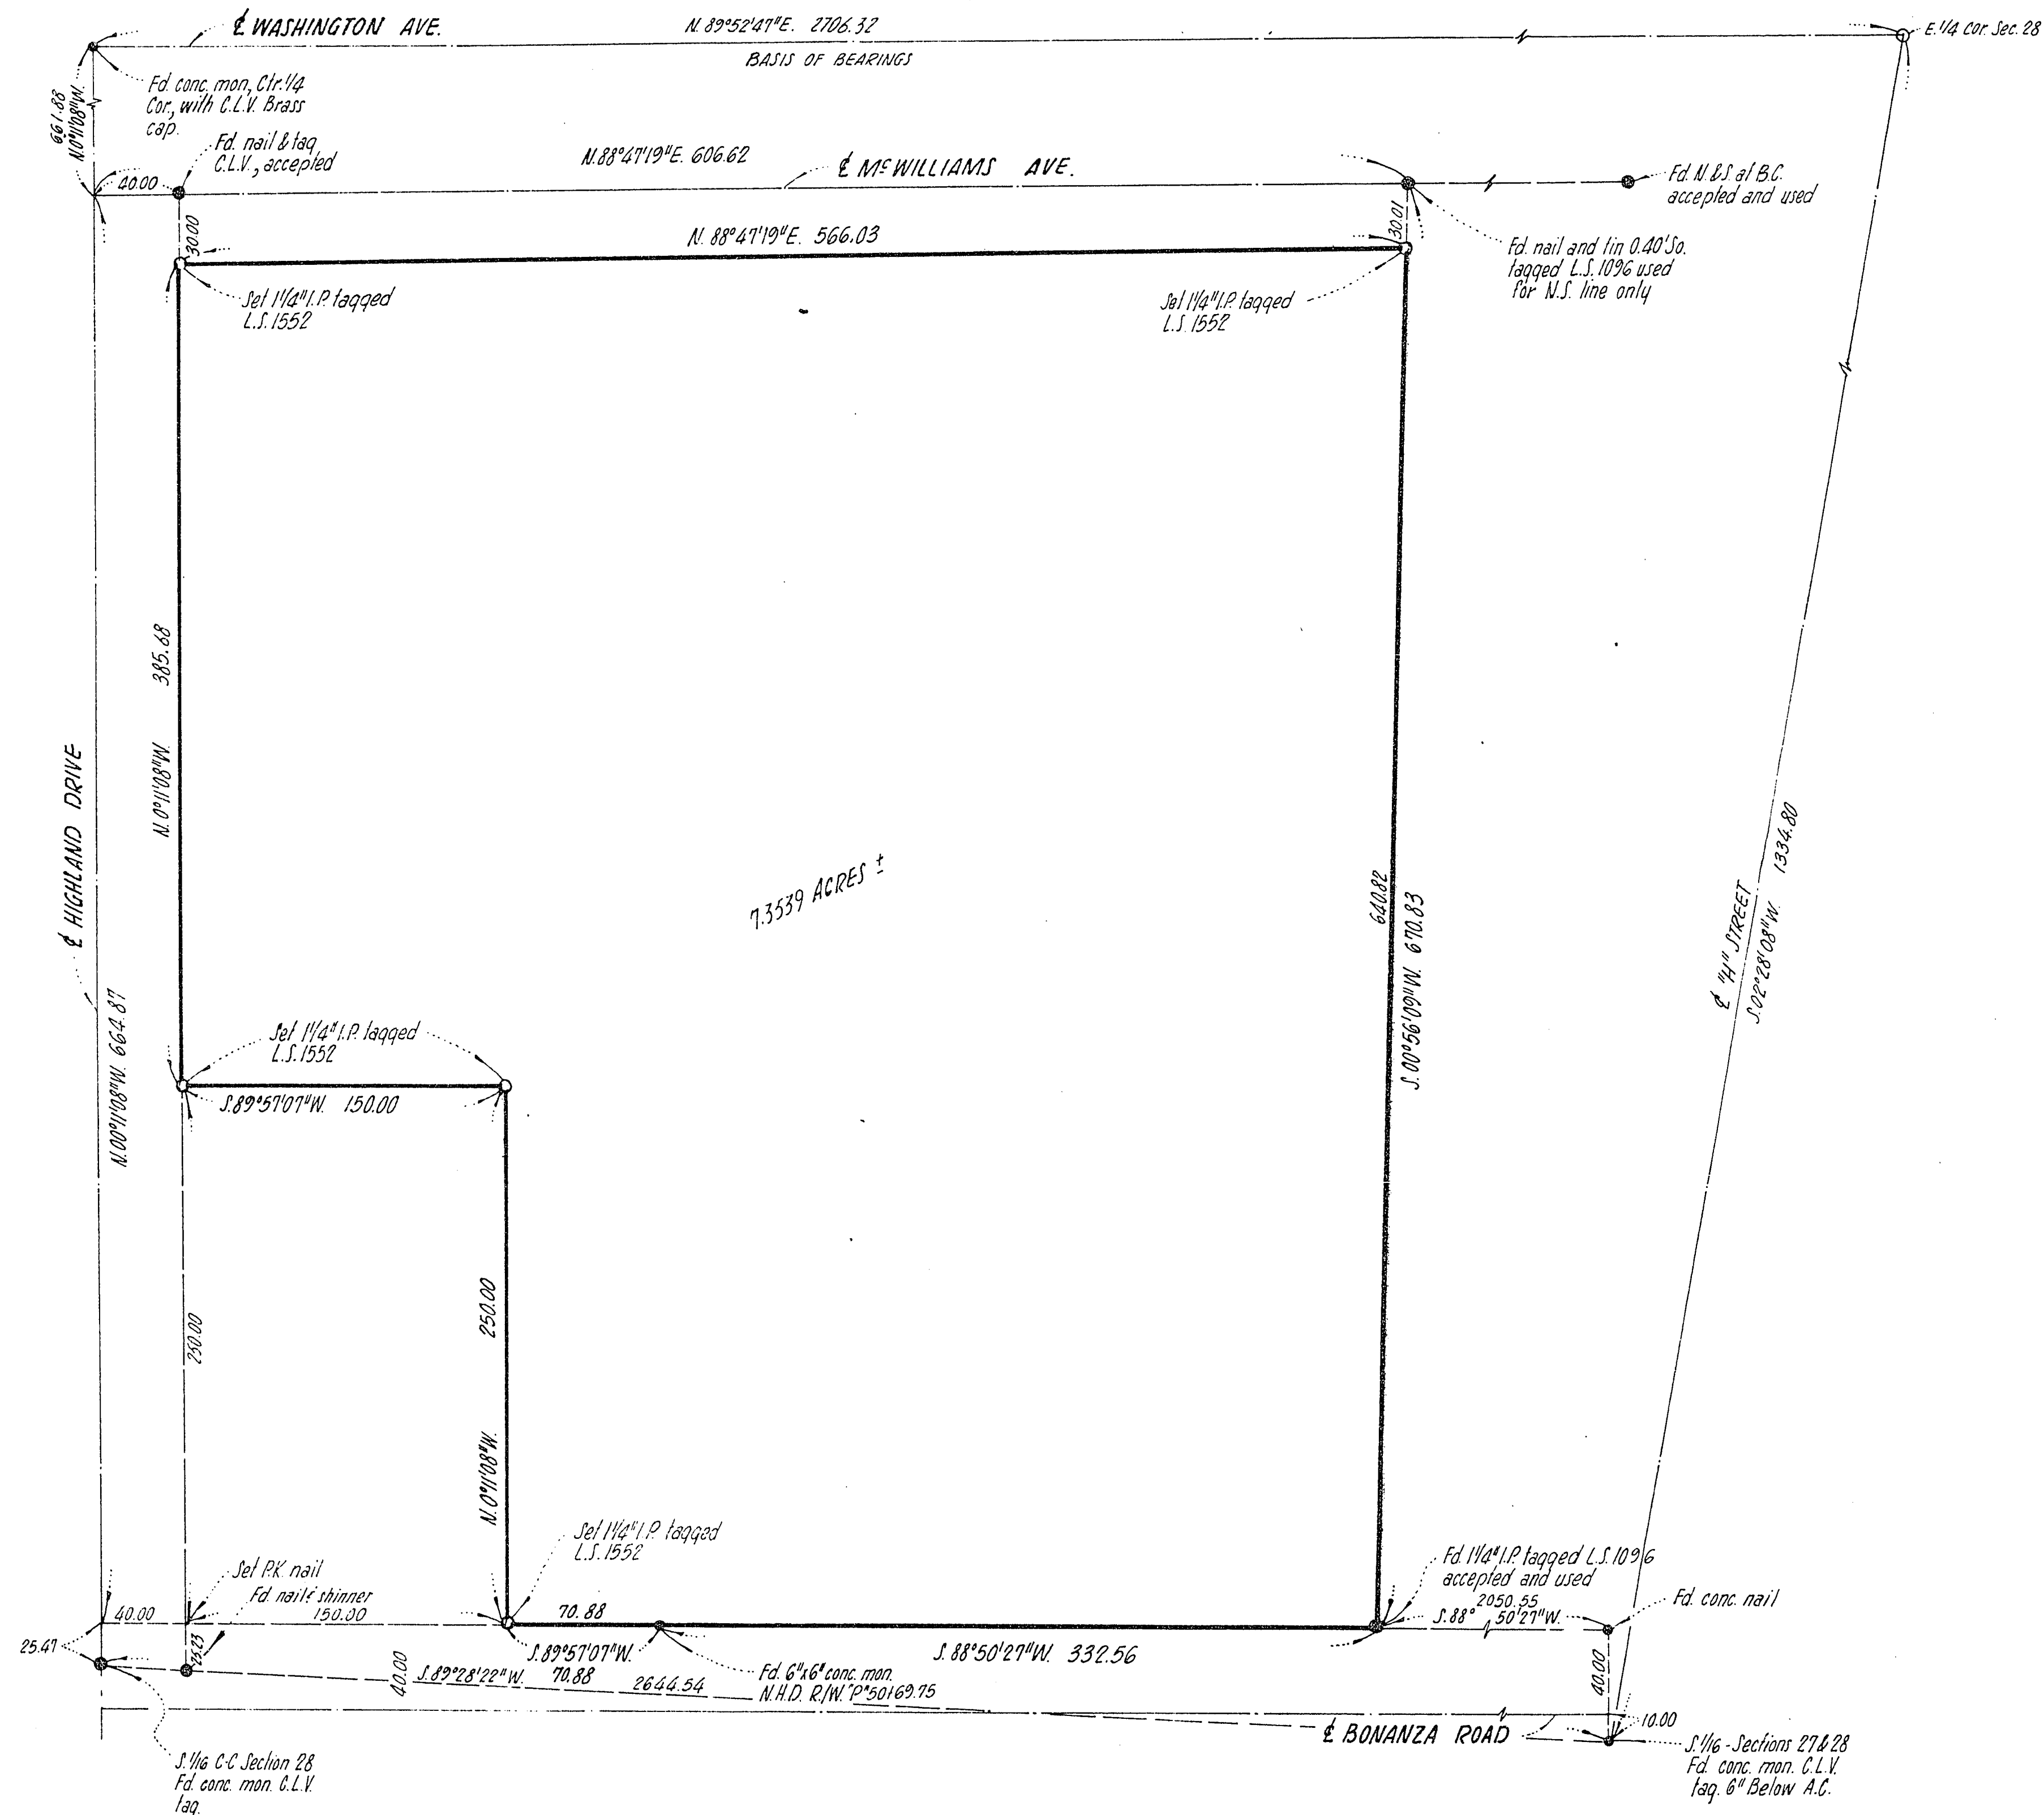

LEGAL DESCRIPTION

That portion of the NW 1/4 of the SE 1/4 of Section 28, Township 20 South, Range 61 East, M.D.M., Nevada, described as follows: COMMENCING at the NW corner of the SE 1/4 of said Section 28; thence S 0°11'08\"/>

BASIS OF BEARINGS

N 89°52'47\"/>

SURVEYOR'S CERTIFICATE

I, James V. Olin, a duly Registered Land Surveyor in the State of Nevada, do hereby certify that the survey of the land shown hereon was made under my direct supervision at the instance of Jesse Ungar, owner of said parcel; the survey was completed on January 2, 1963, and that the points found and set are correctly shown hereon. This plat is not intended to be a subdivision.

James V. Olin
Registered Land Surveyor
Nevada Certificate No. 1552

VOORHEIS-TRINDLE COMPANY OF NEVADA

1128 Fremont Street, Las Vegas, Nevada, EV 53566

SCALE	1\"/>
DRAWN BY	L. Dulward

MAP FOR RECORD OF SURVEY FOR JESSE UNGAR

DATE	January 2, 1963	DRAWING NO.	W.O. 162
------	-----------------	-------------	----------

RECEIVED OF	JAMES V. OLIN
1-15-63	8:09 A.M.
12	23
NO. 243	
ALL	RECEIVED
250	0.15

055-509

FILE 12