




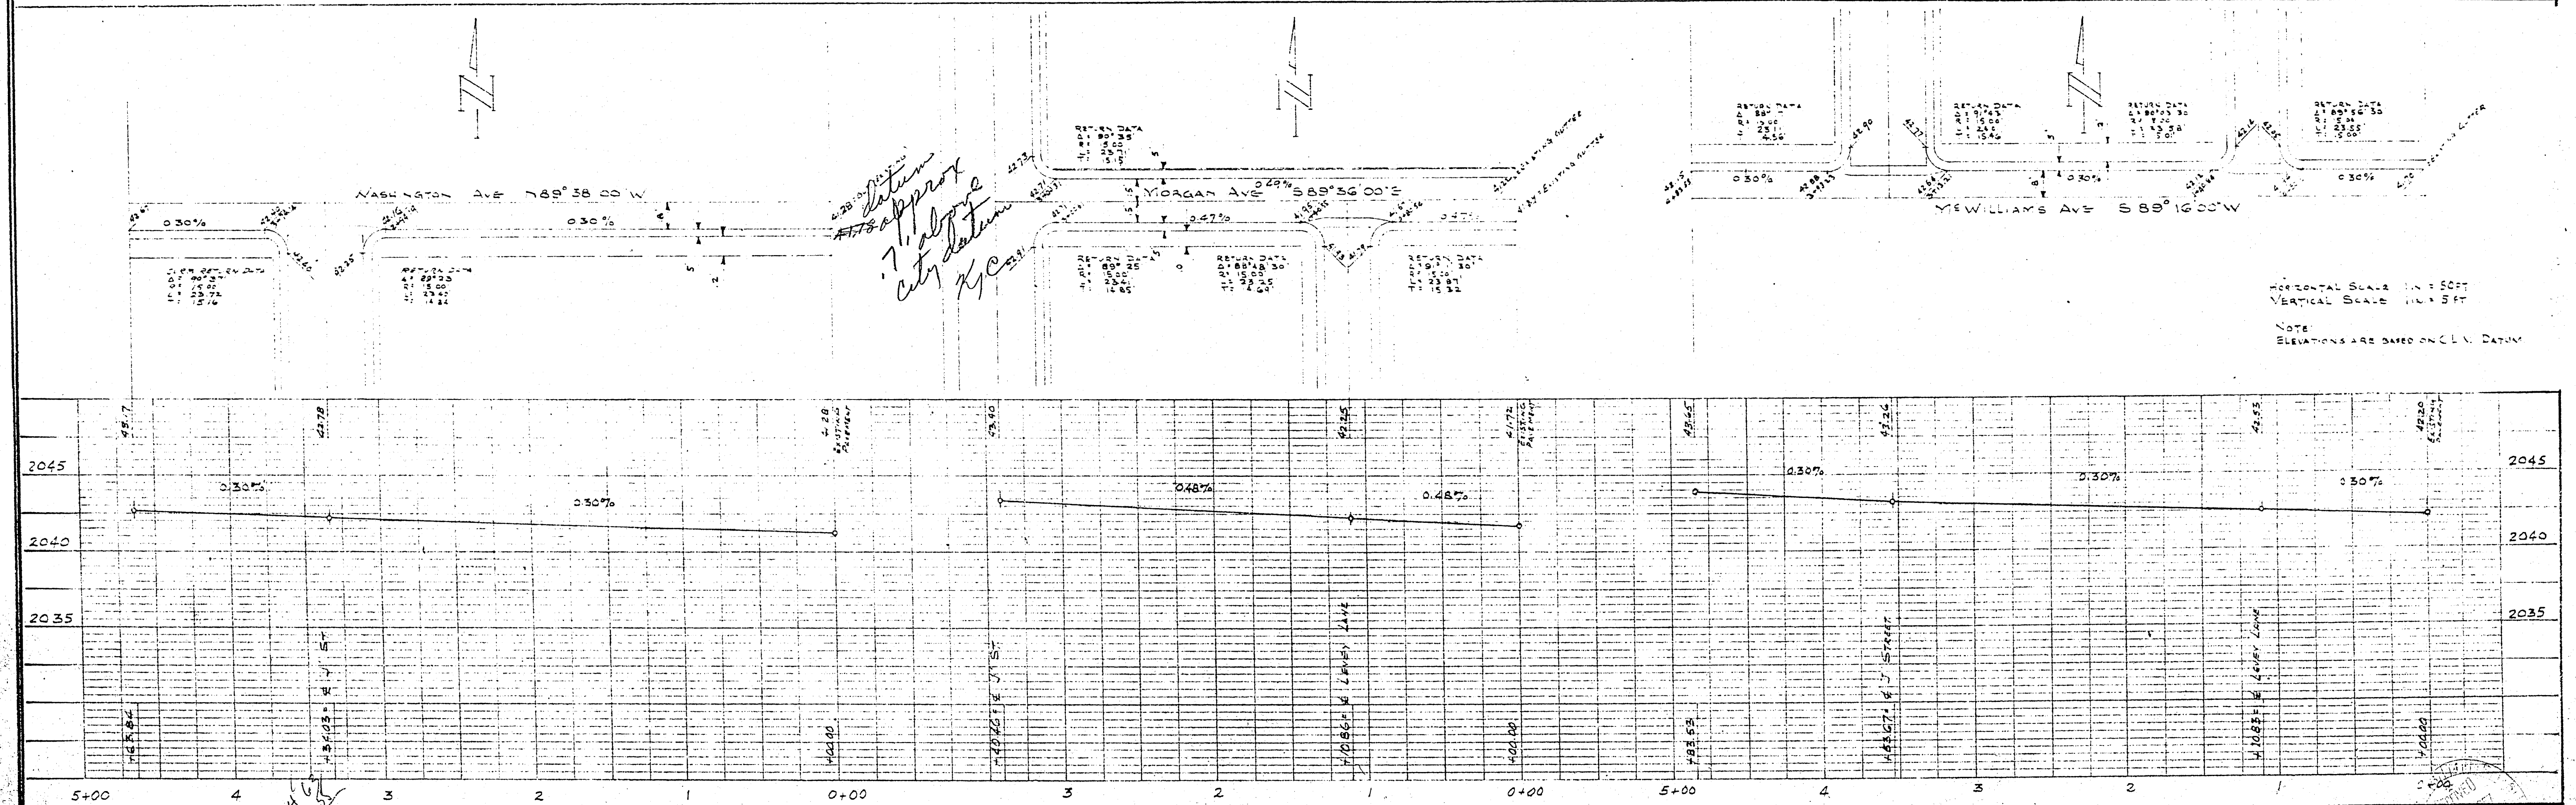

HOUSING PROJECT FOR THE: HOUSING AUTHORITY OF THE CITY OF LAS VEGAS, NEVADA, PROJECT NO. NEV. 2-2	
HOUSING AUTHORITY	ELMO G. BRUNER A.I.A. ARCHITECT
HOUSING AUTHORITY	PHONE 903 N. 5TH ST. LAS VEGAS, NEVADA
HOUSING AUTHORITY	VERIFY ALL DIMENSIONS ON JOB SITE
JOB	DATE
DRAWN	CHECKED
SHEET	OF
7	12

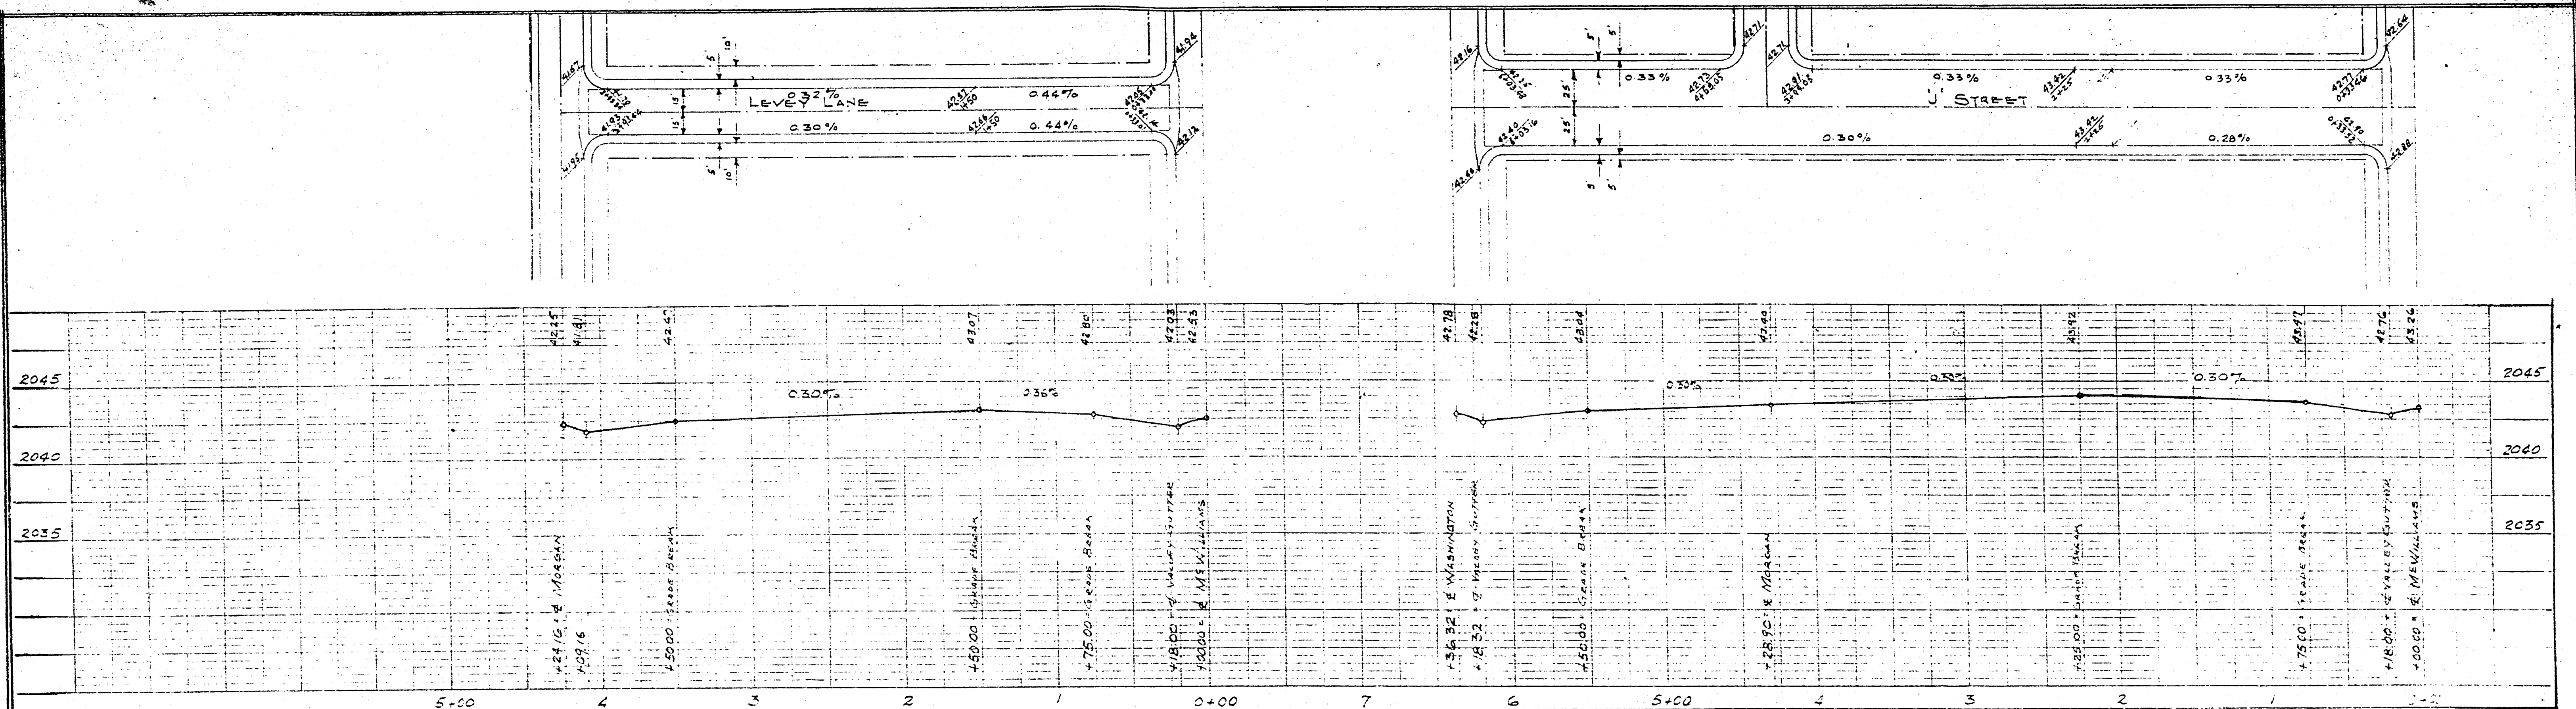


 

