


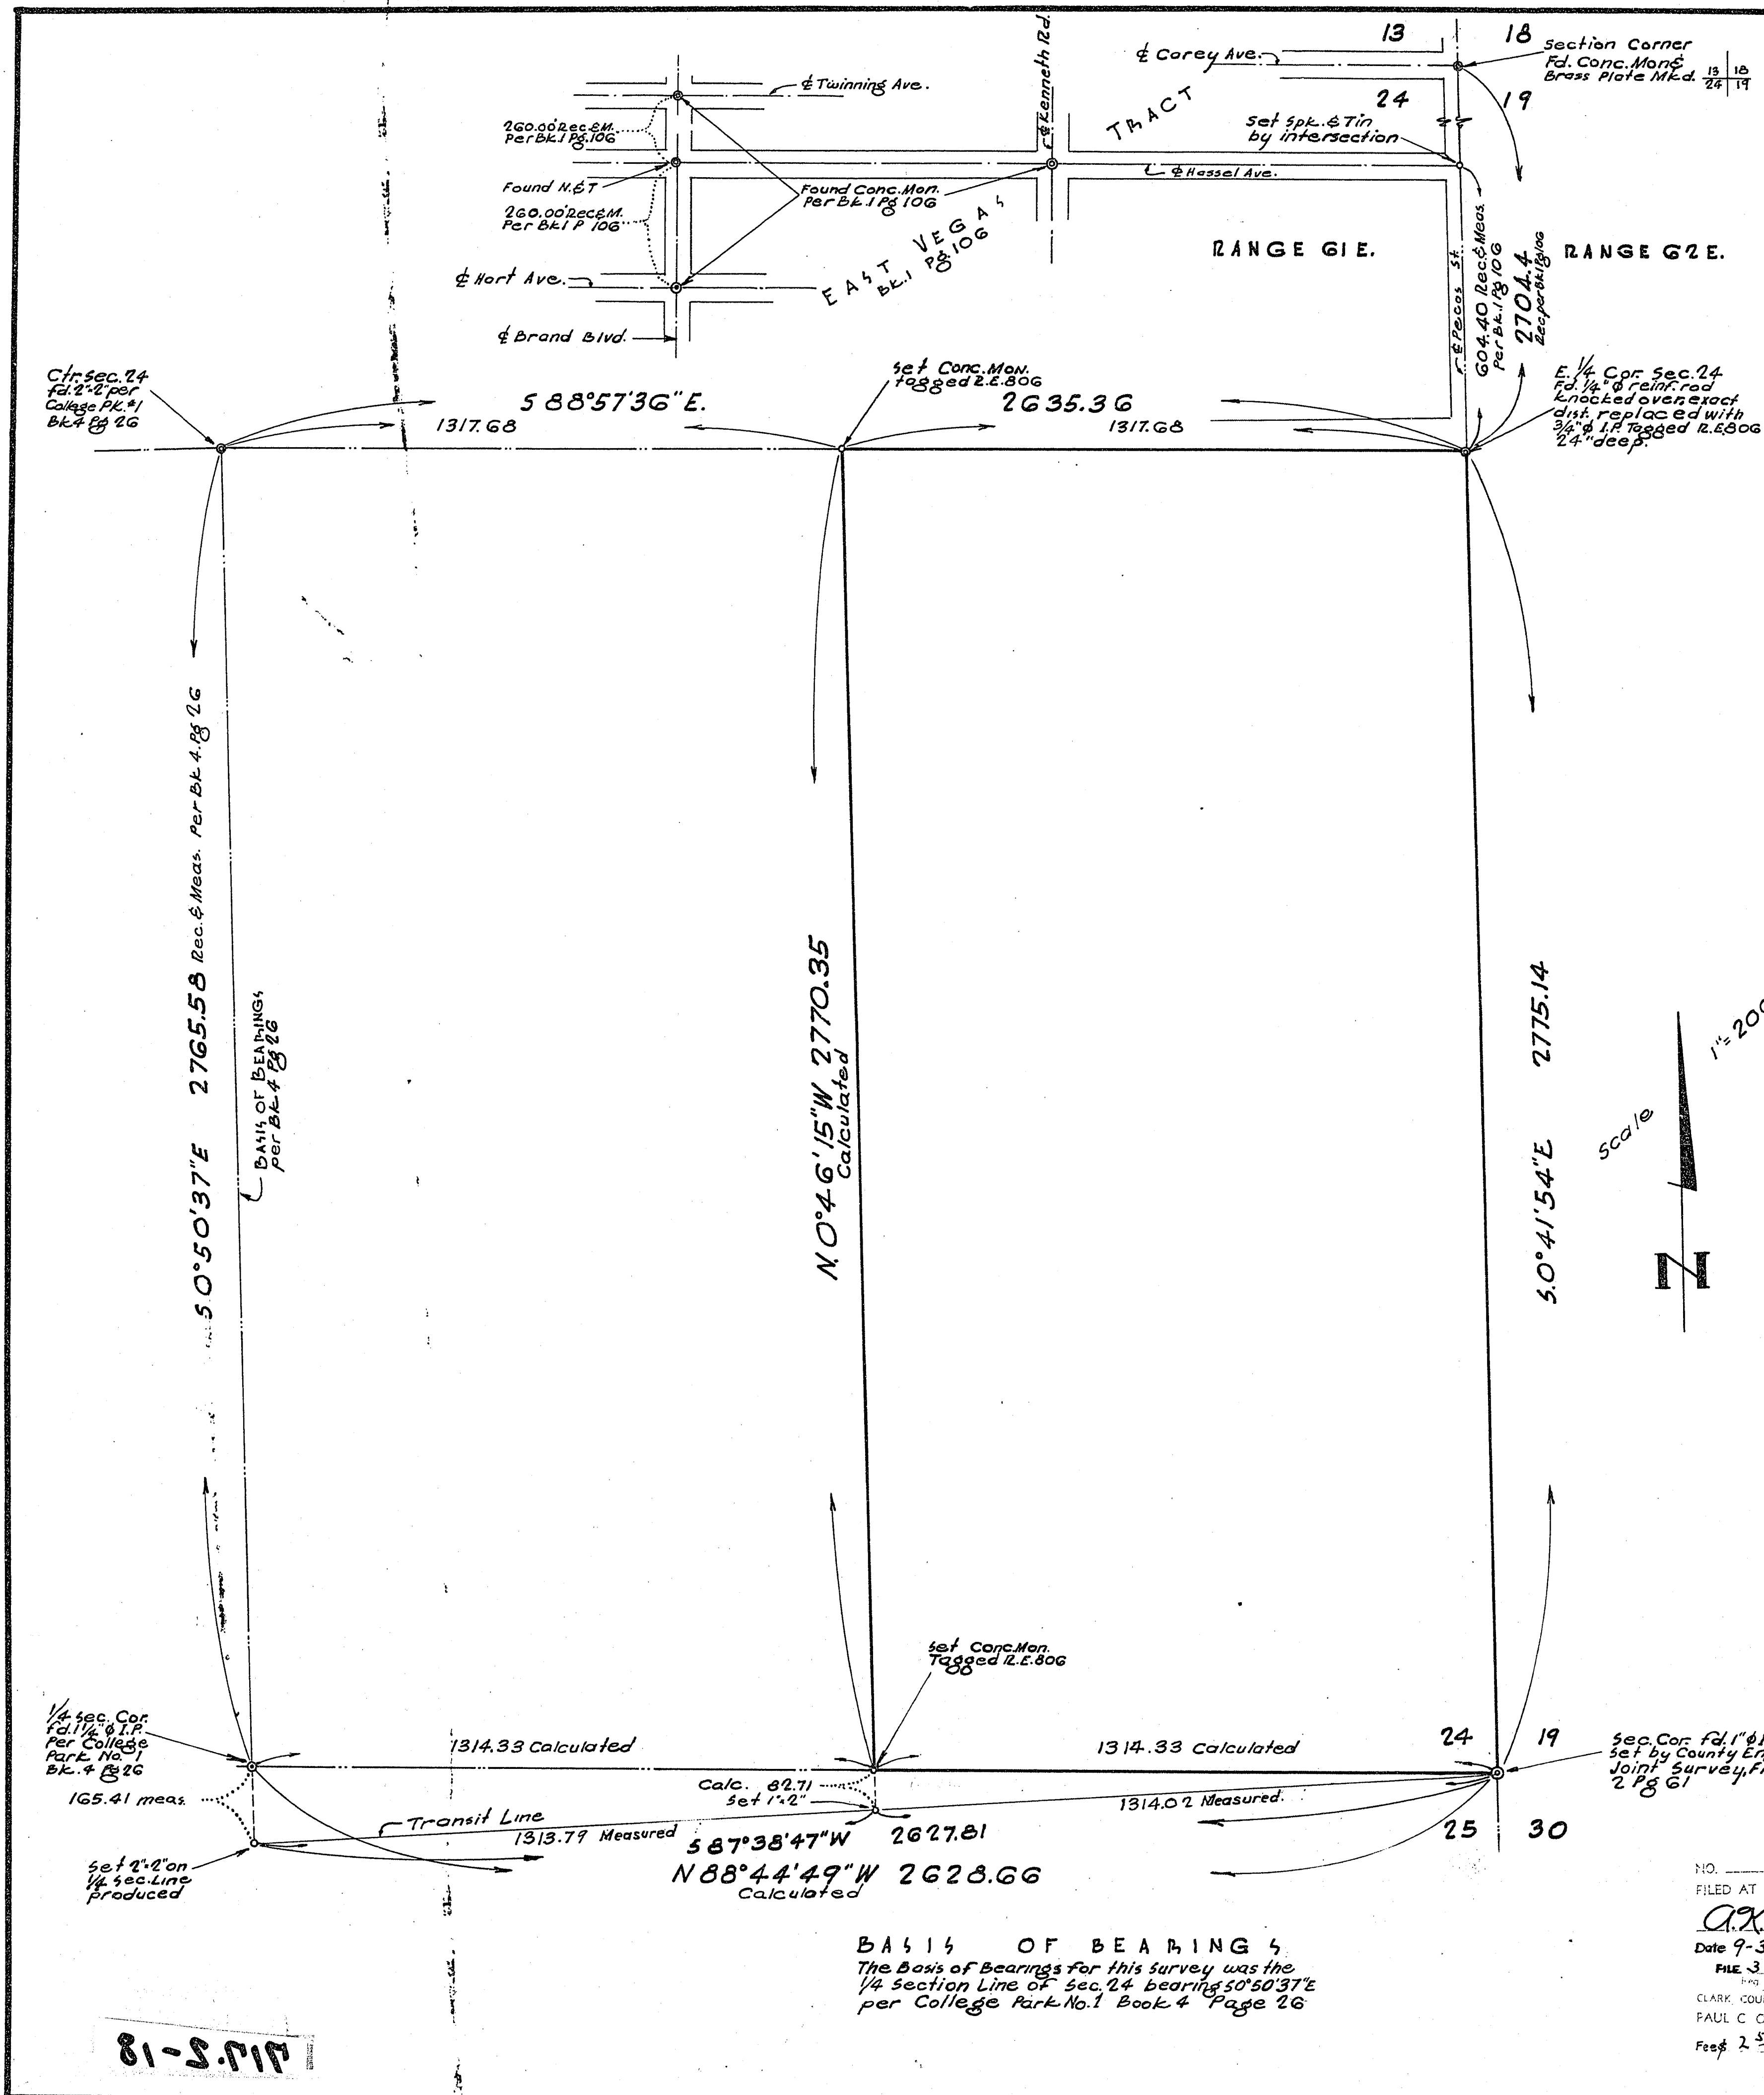

ENGINEER'S CERTIFICATE

I, A. K. Bowman, a duly licensed Land Surveyor of the State of Nevada do hereby certify that I have surveyed the land shown on this map at the instance of The LAS VEGAS INVESTMENT CORPORATION and that said map shows correctly the physical conditions shown hereon. I do further certify that the monuments shown hereon actually exist in the positions shown and said monuments are sufficient to enable this survey to be retraced. That the area surveyed lies wholly within the E 1/2 of the S.E. 1/4 of Sec. 24, T. 20 S., R. 6 E., M. D. B. & M. The boundary of the area being more particularly described as follows: Commencing at the S.E. corner of said section 24 thence N 88° 44' 49" W a distance of 1314.33 feet to a point; thence N 0° 46' 15" W a distance of 2770.35 feet to a point; thence S 88° 57' 36" E a distance of 1317.68 feet to a point; thence S 0° 41' 54" E a distance of 2775.14 feet to the point of beginning.

The area of parcel herein described being 83.72 acres more or less. This survey was completed on May 6, 1954.

A. K. Bowman
 Licensed Land Surveyor
 Nevada License No. 8006

RECORDED FOR ANNEXATION PURPOSES
 to the
 CITY of NORTH LAS VEGAS
 BY RESOLUTION DATED APRIL 5, 1954

MAP FOR RECORD OF SURVEY

FOR
 LAS VEGAS INVESTMENT CORPORATION
 By *Maurice J. Silman* PRESIDENT
 THE E 1/2 OF THE SE 1/4 OF SECTION 24
 T. 20 S. R. 6 E. M. D. B. & M.

CLARK COUNTY NEVADA

NO. 19400
 FILED AT THE REQUEST OF
A. K. Bowman
 Date 9-3-54 at 12:43 P.M.
 FILE 3 PAGE 39
 CLARK COUNTY, NEVADA, RECORDS
 PAUL C. O'MALLEY, RECORDER
 Fee \$ 2.50 Deputy