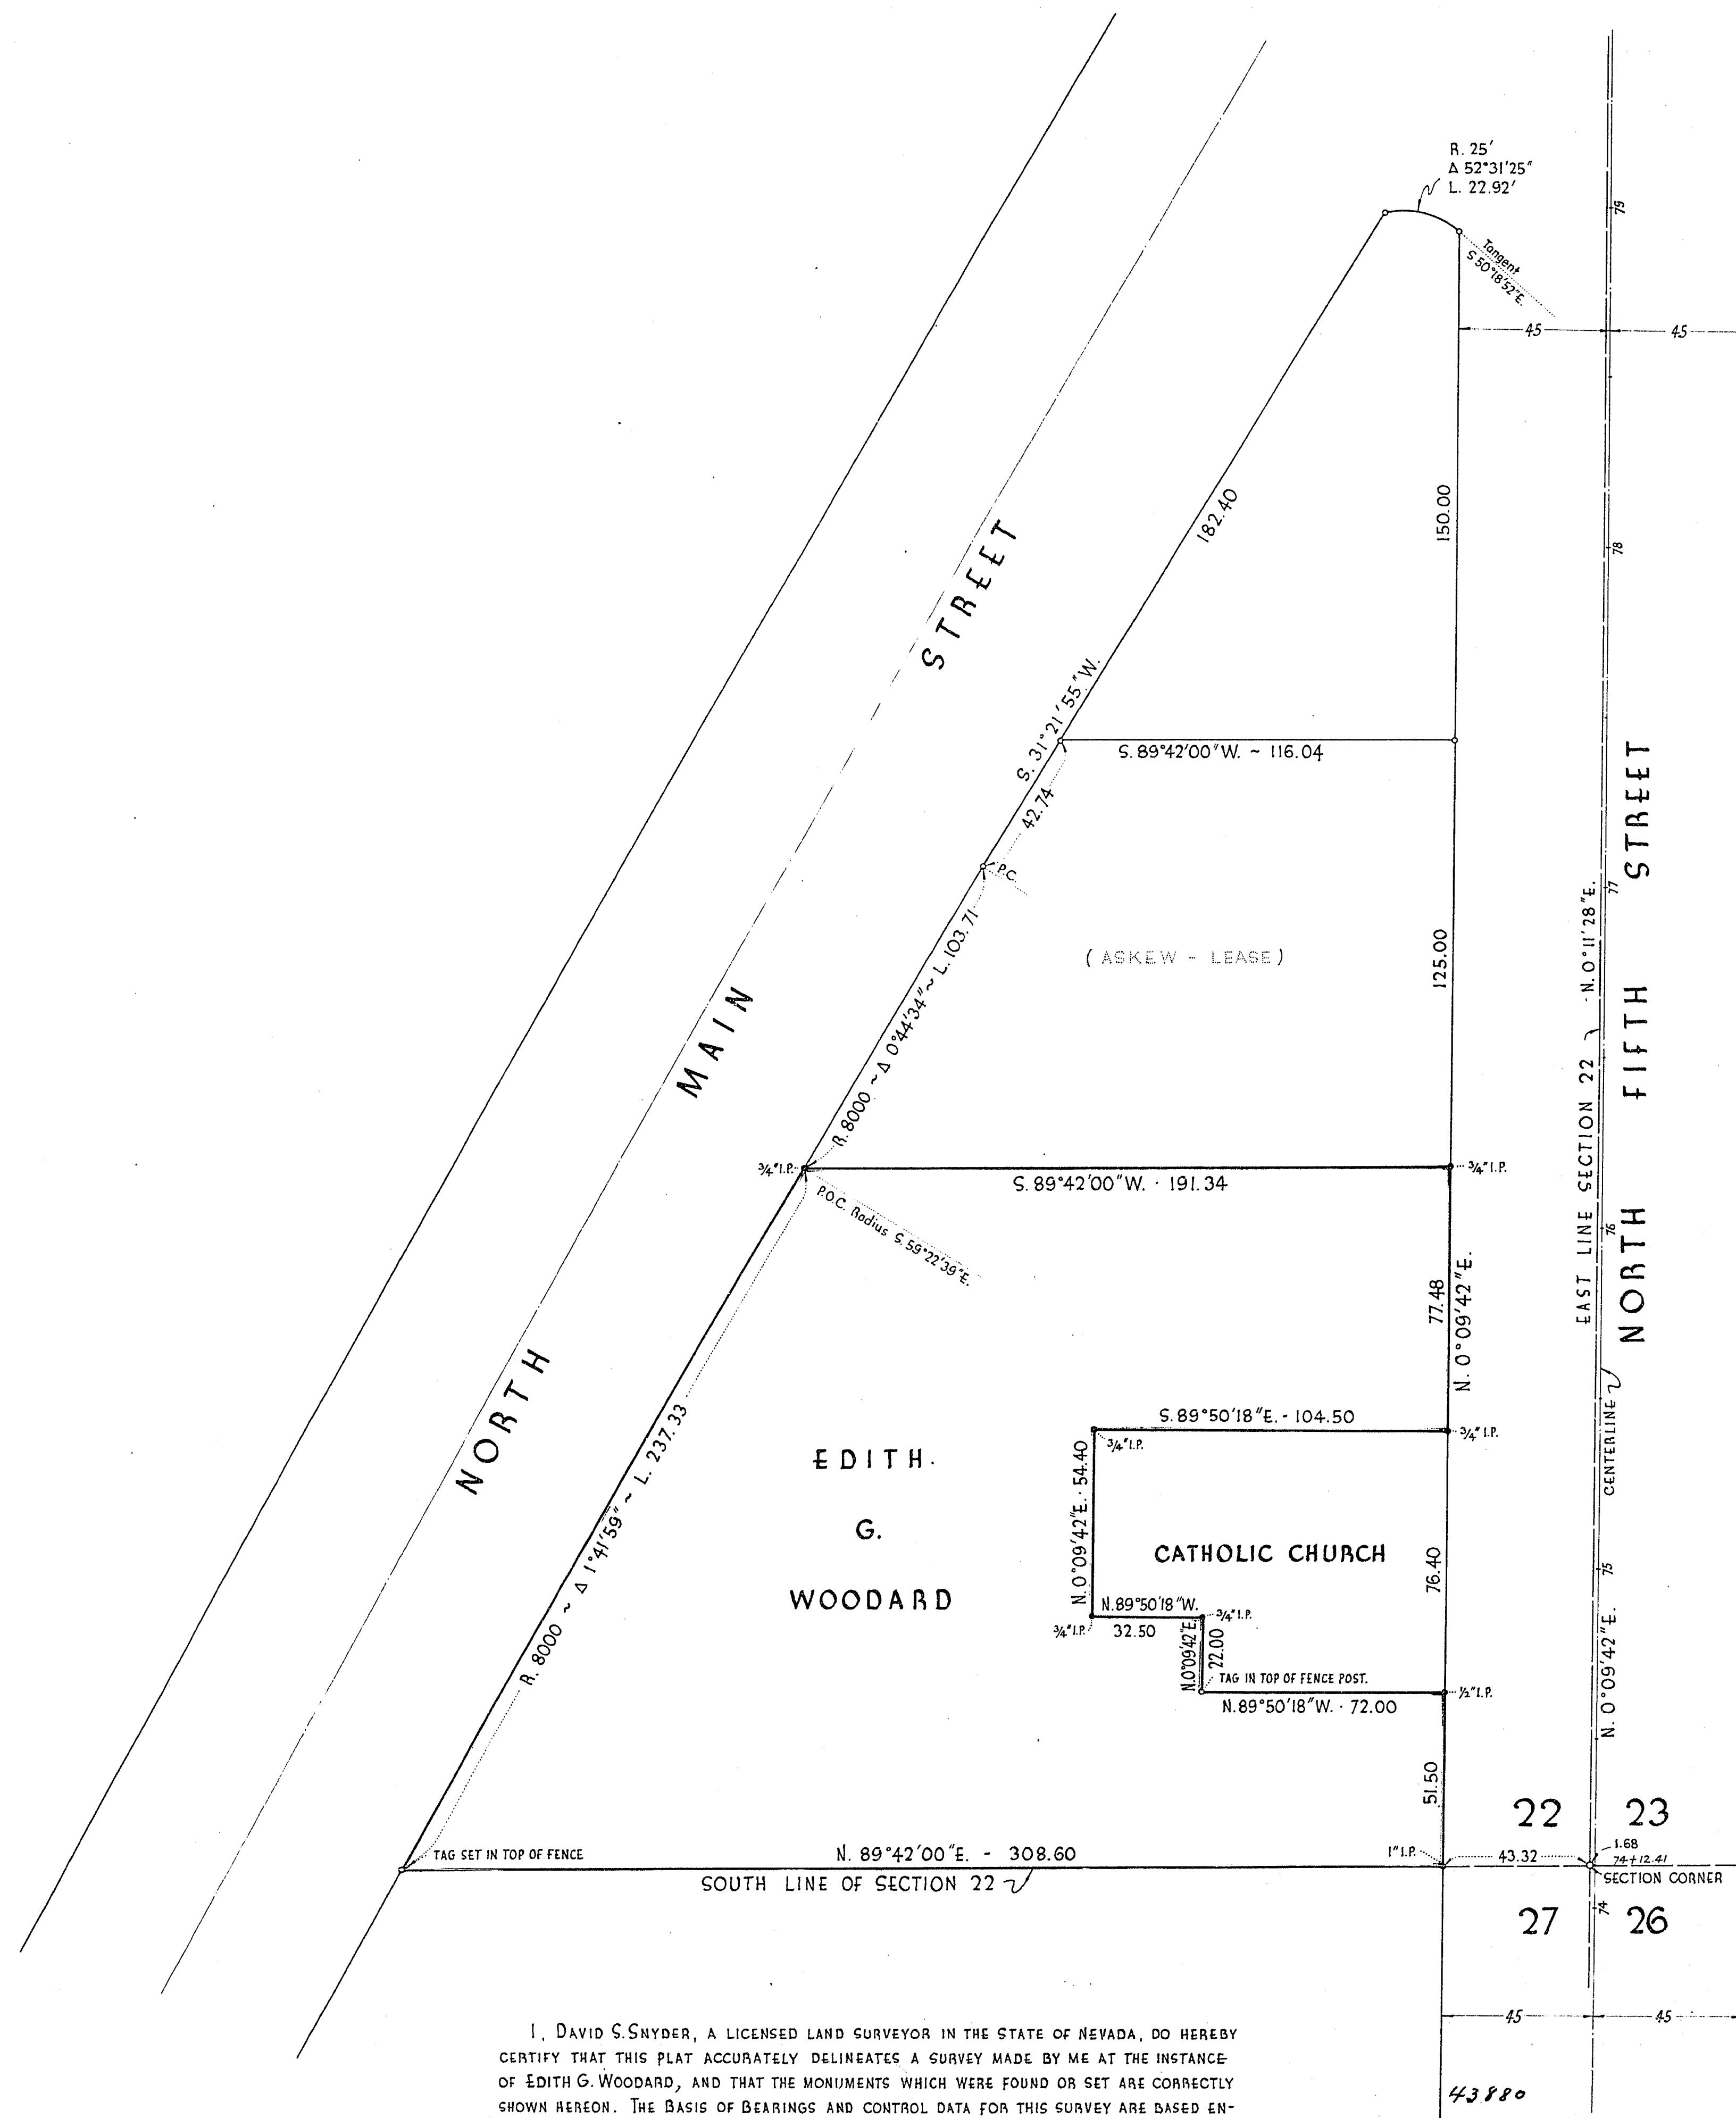


SCALE : 1" = 30'

NOTE: A COMMON NAIL BEARING NO IDENTIFICATION, EXISTS IN AN AREA OF PAVING WHICH HAS BEEN REPEATEDLY PATCHED, AND IS APPROXIMATELY 0.2' NORTH OF THE POSITION INDICATED IN THE FIELD NOTES OF THE NEVADA DIVISION OF HIGHWAYS. THE POSITION OF THE CORNER AS USED IN THIS SURVEY IS IN CONFORMITY WITH STATE HIGHWAY RECORDS.

• PIPES SET, SIZE AS INDICATED, ALL TAGGED R.E. 731.

I, DAVID S. SNYDER, A LICENSED LAND SURVEYOR IN THE STATE OF NEVADA, DO HEREBY CERTIFY THAT THIS PLAT ACCURATELY DELINEATES A SURVEY MADE BY ME AT THE INSTANCE OF EDITH G. WOODARD, AND THAT THE MONUMENTS WHICH WERE FOUND OR SET ARE CORRECTLY SHOWN HEREON. THE BASIS OF BEARINGS AND CONTROL DATA FOR THIS SURVEY ARE BASED ENTIRELY ON NEVADA DEPARTMENT OF HIGHWAYS RECORDS, AND THE SURVEY WAS TIED INTO AND CONTROLLED OFF OF THE MARKED CENTERLINE OF NORTH FIFTH STREET (SHINERS IN PLACE AT EACH STATION AND HALF STATION.) THE SURVEY WAS COMPLETED APRIL 9, 1955.

David S. Snyder
LICENSED LAND SURVEYOR, R.E. 731

David S. Snyder
4-14-55 1:20 P
4 72

David S. Snyder

MAP FOR RECORD OF SURVEY
FOR
EDITH G. WOODARD
A PORTION OF THE SE 1/4 OF THE SE 1/4 OF THE T. 20S. R. 61E.
M. D. B. & M.
CLARK COUNTY NEVADA

8-8-77

27 28

51

27 28

FILE 4 PAGE 72