


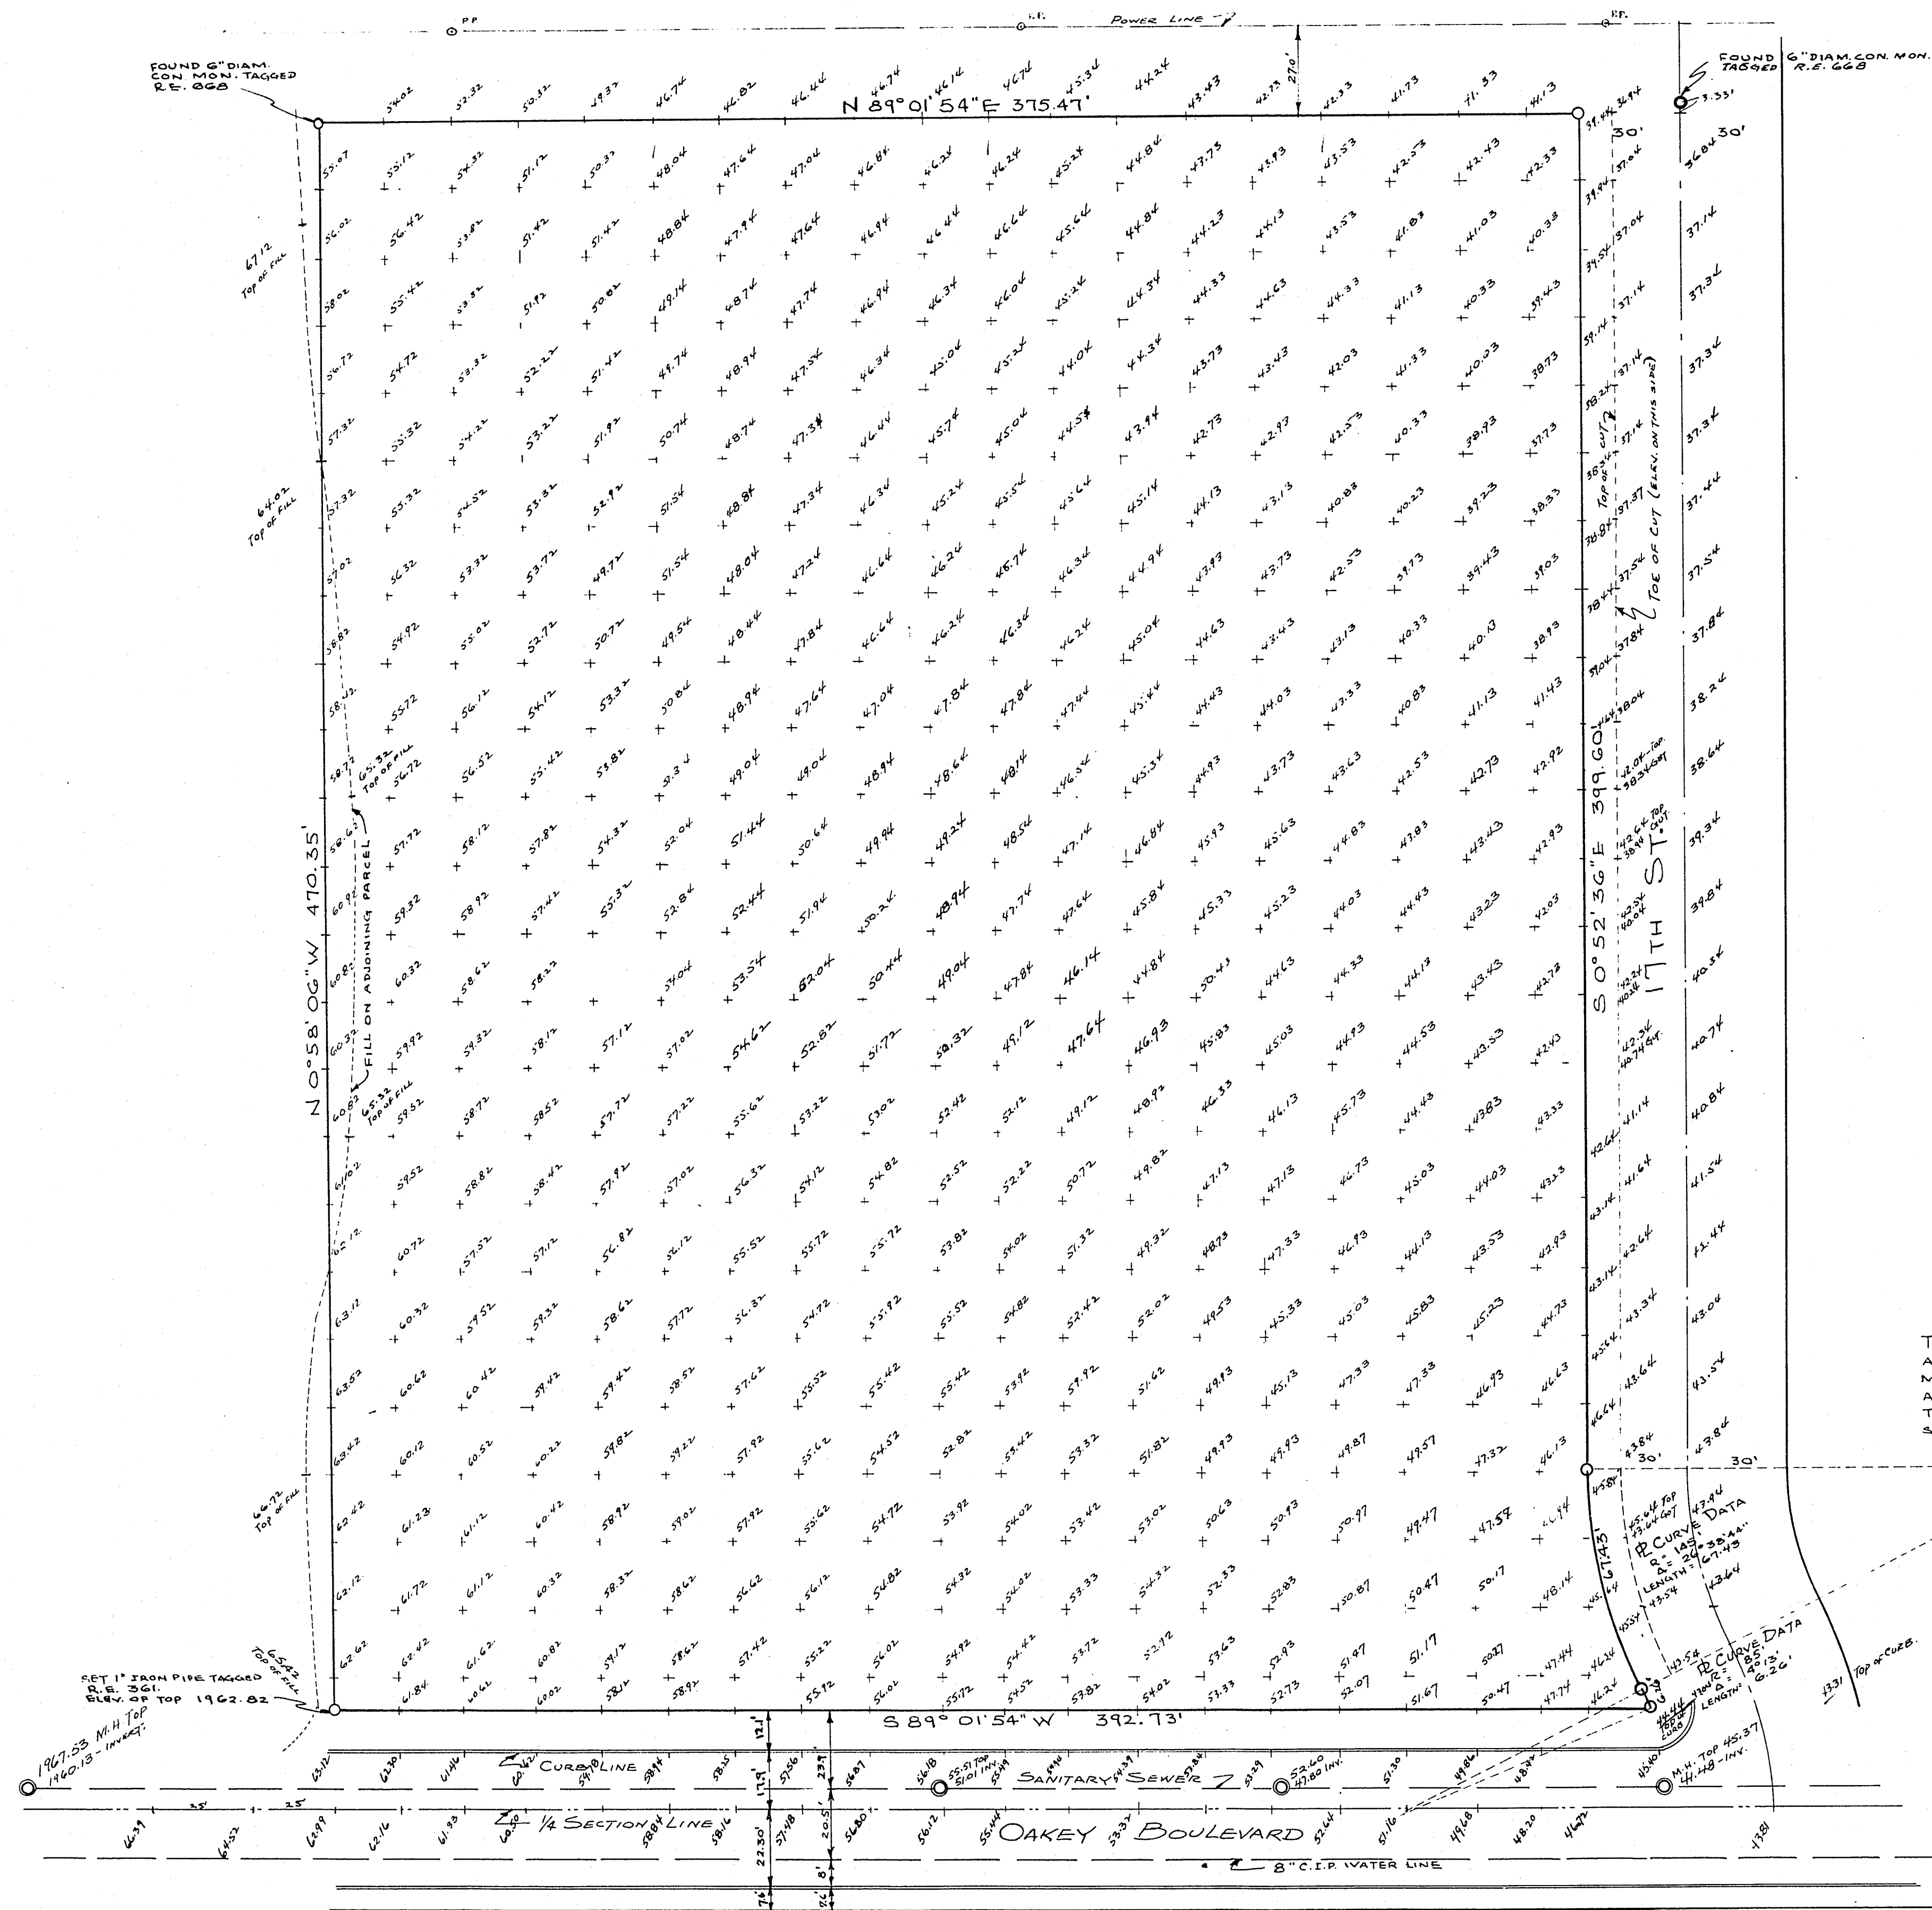

LEGEND

○ = SET 1" IRON PIPE TAGGED R.E. 361


ENGINEER'S CERTIFICATE

THIS IS TO CERTIFY THAT THIS MAP, CONSISTING OF ONE SHEET, ACCURATELY DELINEATES THE RESULTS OF A SURVEY MADE BY ME AT THE INSTANCE OF THE JEWISH COMMUNITY CENTER AND COMPLETED ON THE 22ND DAY OF OCTOBER, 1955; THAT THE POINTS FOUND AND THE POINTS SET ARE CORRECTLY SHOWN HEREON.

Frank D. Kattelman, Jr.
REGISTERED PROFESSIONAL ENGINEER AND
LICENSED LAND SURVEYOR NEV. CERT. NO. 361

BASIS OF BEARINGS

THE BASIS OF BEARING USED IN THIS SURVEY IS THE BEARING OF THE EAST LINE OF THE NW 1/4 OF SECTION 2, T.21S., R.1E., M.D.B. & M., RECORDED AS N 0° 52' 36" W BY R.P.E. NO. 660 IN FILE 2, PAGE 1, R.P.E. SURVEYS IN THE OFFICE OF THE CLARK COUNTY RECORDER, CLARK COUNTY, NEVADA.

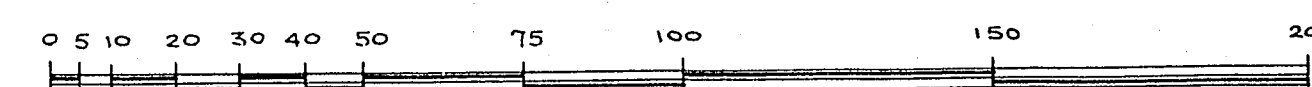

NOTE:
GRID ELEVATIONS ARE TAKEN AT 20' INTERVALS.
ELEVATIONS ARE BASED ON CITY OF LAS VEGAS DATUM
S.E. PROP. COR. 1" I.P. TAGGED R.E. 361 - ELEVATION 1946.31
ELEVATIONS ON CURB LINE ARE TOP OF CURB

MAP OF SURVEY
for
THE JEWISH COMMUNITY CENTER
OF A PORTION OF THE
SE 1/4 OF THE NW 1/4 OF SECTION 2,
T.21S., R.1E., M.D.B. & M.
LAS VEGAS, NEVADA.