
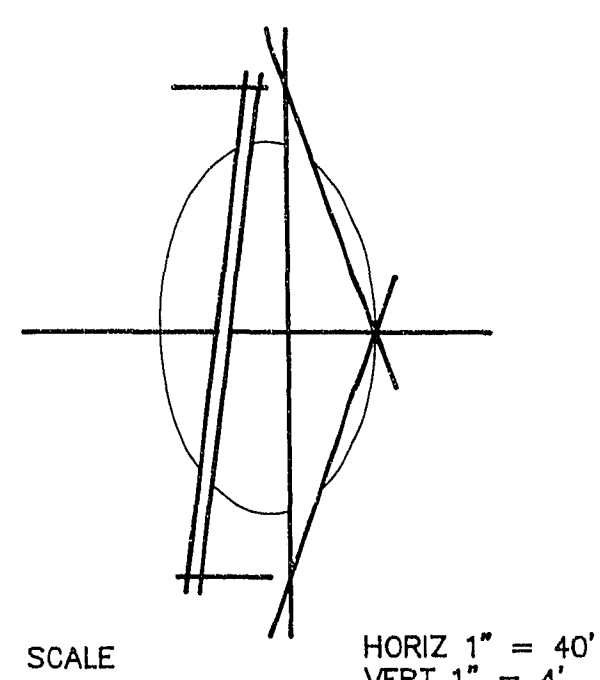


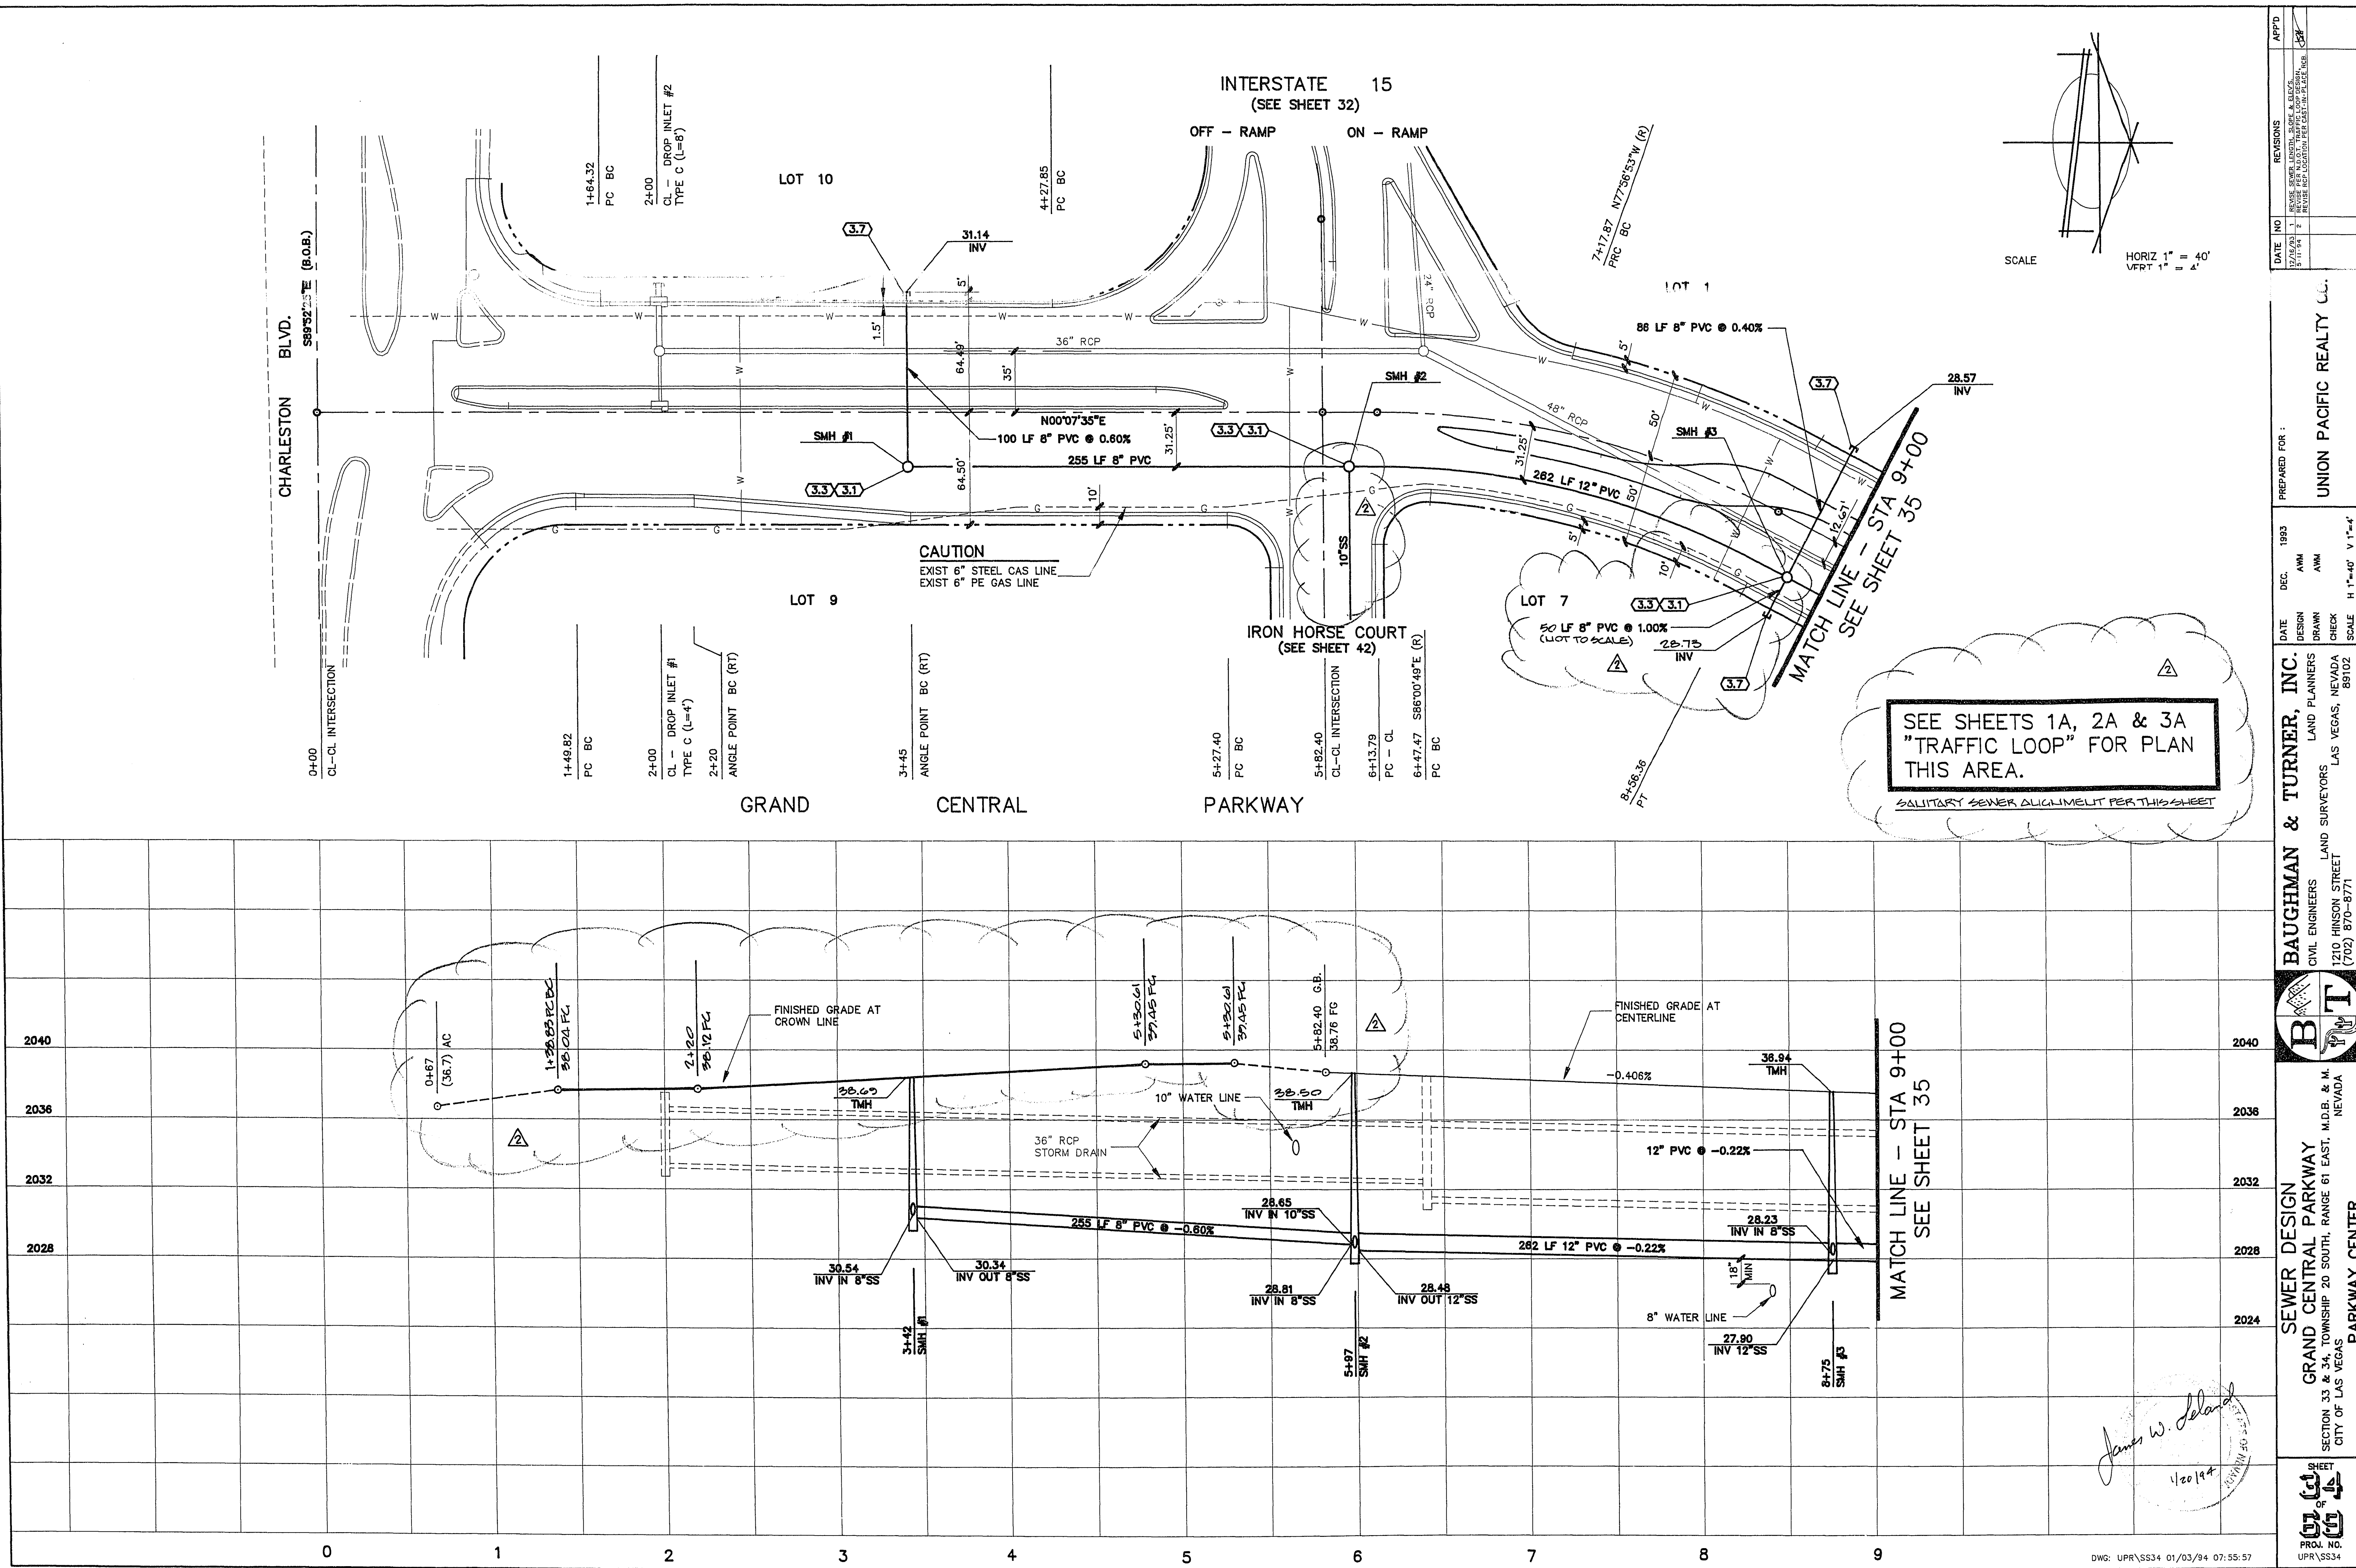

SEE SHEETS 1A, 2A & 3A
"TRAFFIC LOOP" FOR PLAN
THIS AREA.

SALUTARY SEWER ALIGNMENT PER THIS SHEET

James W. Deland
1/20/94

REVISIONS				DATE			


PREPARED FOR :	UNION PACIFIC REALTY CO.
BAUGHMAN & TURNER, INC.	LAND PLANNERS
CIVIL ENGINEERS	LAND SURVEYORS
1210 HINSON STREET	LAS VEGAS, NEVADA
(702) 870-8771	89102

SEWER DESIGN	SECTION 33 & 34, TOWNSHIP 20 SOUTH, RANGE 61 EAST, M.D.B. & M. NEVADA
GRAND CENTRAL PARKWAY	CITY OF LAS VEGAS
PARKWAY CENTER	

PROJ. NO.	UPR\SS34
DATE	1/20/94
SCALE	H 1"=40'
VERT	1"=4'

DWG: UPR\SS34 01/03/94 07:55:57

10-24-3P 3094-4229