

DATE	NO.	DESCRIPTION
12/17/24	1	REVISE SEWER LOCATIONS, SLOPE & DEPTHS
04/13/24	2	REVISE SS LATERAL AT STA 19+10, 19+25 & 19+40

DATE	DESIGN	DRAWN	CHECK
2022	ANN	ANN	ANN

DATE	NO.	DESCRIPTION
2022	1	PREPARED FOR: UNION PACIFIC REALTY CO.

BAUGHMAN & TURNER, INC.
 CIVIL ENGINEERS LAND SURVEYORS
 1210 HINSON STREET
 LAS VEGAS, NEVADA 89102
 (702) 870-8771

SEWER DESIGN
 BONNEVILLE AVENUE
 SECTION 33 & 34, TOWNSHIP 20 SOUTH, RANGE 61 EAST, M.D.B. & M.
 CITY OF LAS VEGAS


PARKWAY CENTER

DWG: UPR/SS41 01/03/84 09:55:39

PROJ. NO. UPR/SS41

SHEET 41

10-24-45 3074-4229

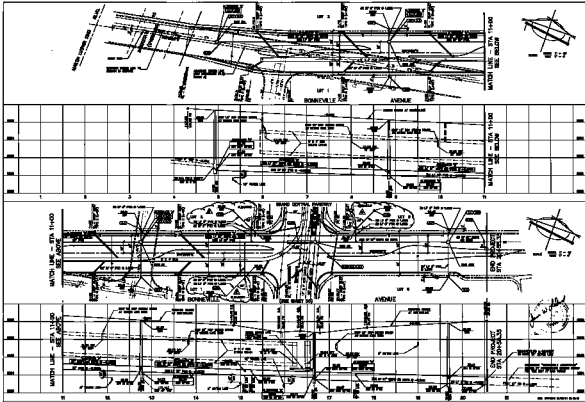

