
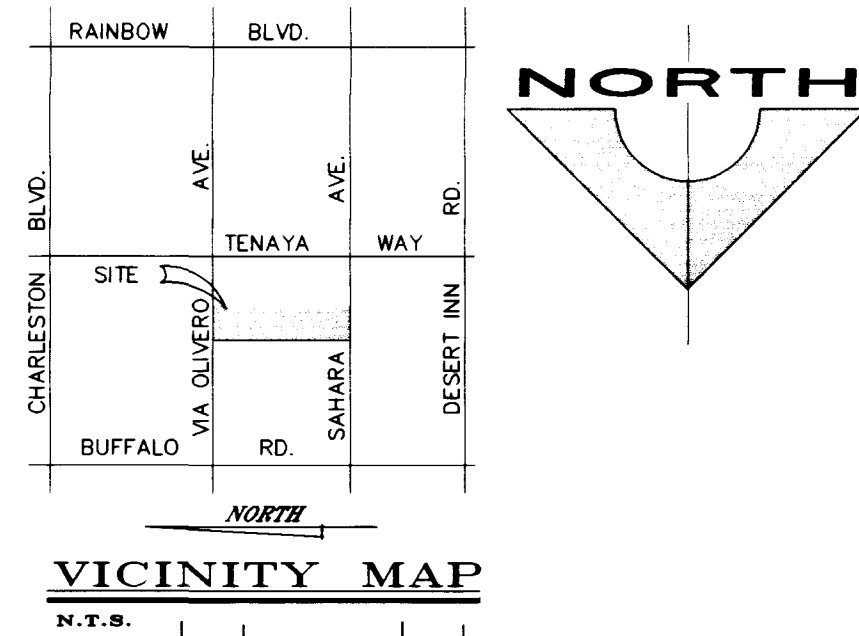


TENAYA WAY

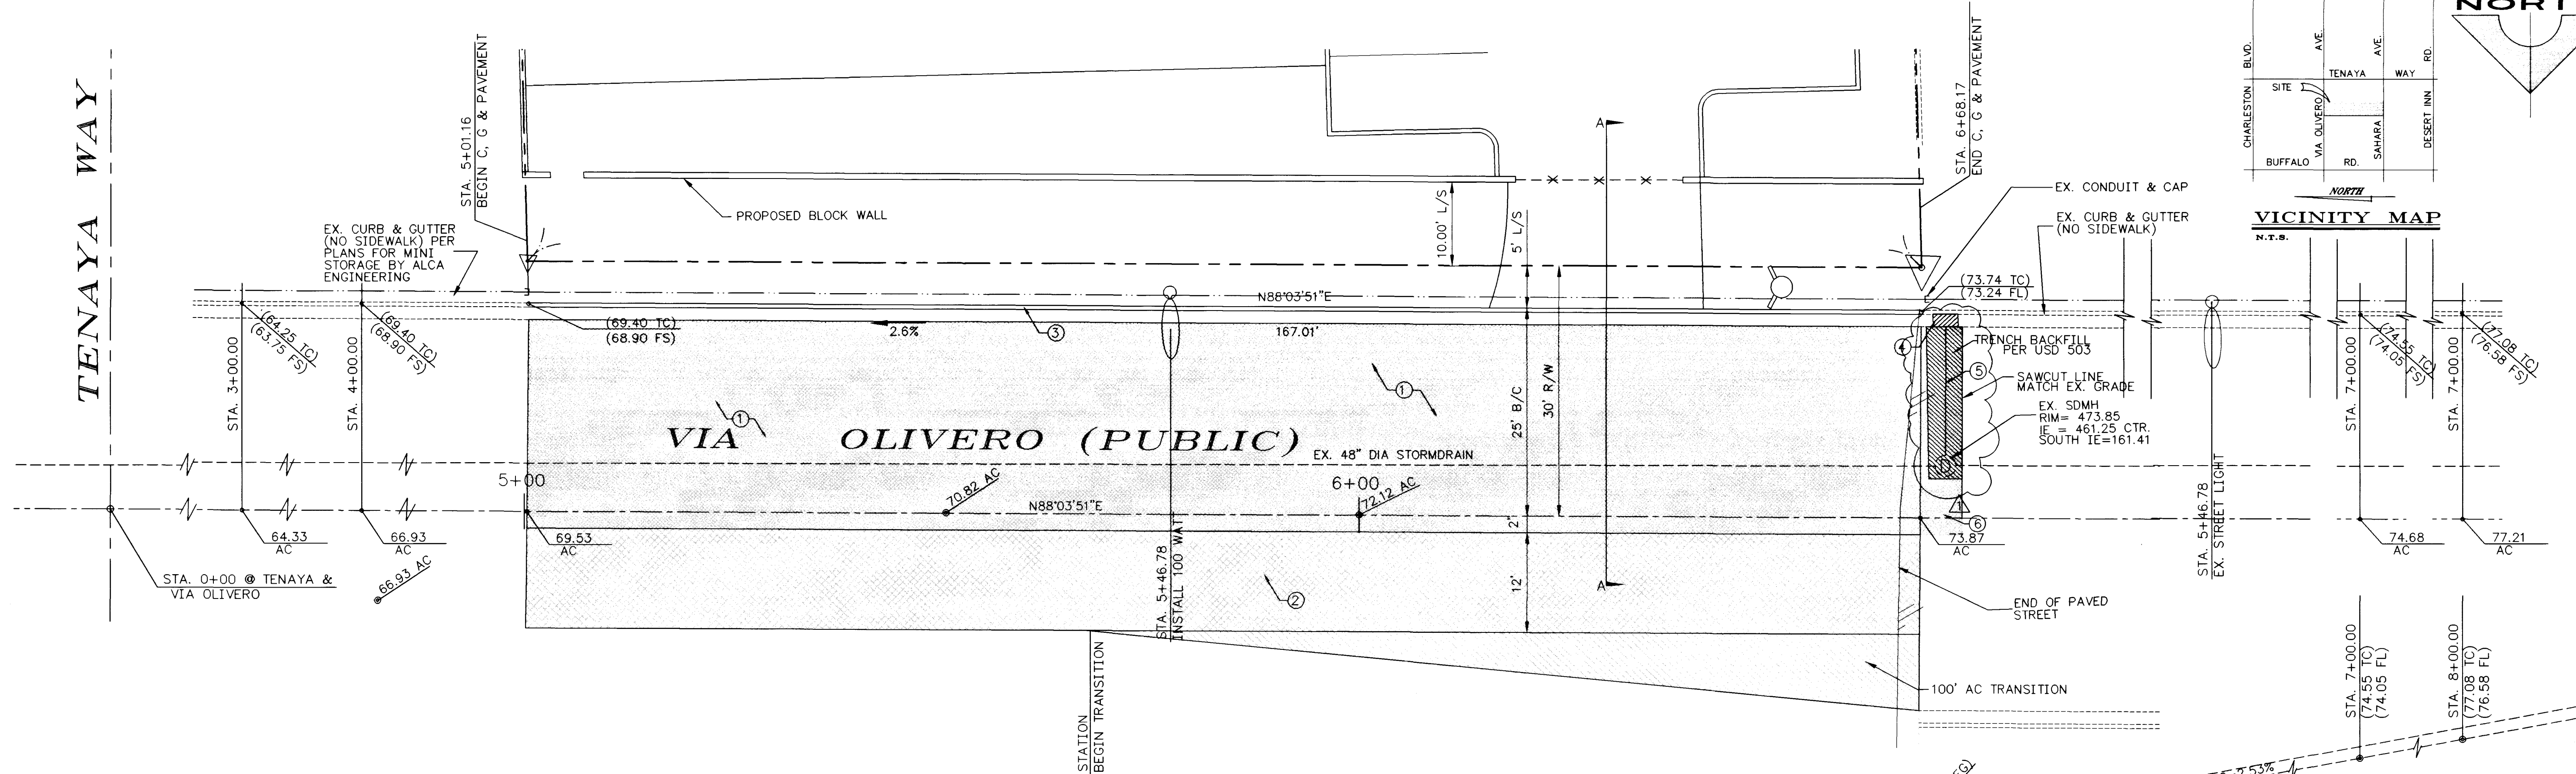


REVISIONS:

1	CHANGES LOCATION OF LATERAL & DRAINAGE DELETION OF SDMH AND REPAIRING.	12/15/78
---	--	----------

ACE ENGINEERING
5601 N. TENAYA WAY,
SUITE 105, LAS VEGAS, NV 89130
PHONE: (702) 396-5115, FAX (702) 396-7992

VIA OLIVERO AVE. (PUBLIC)

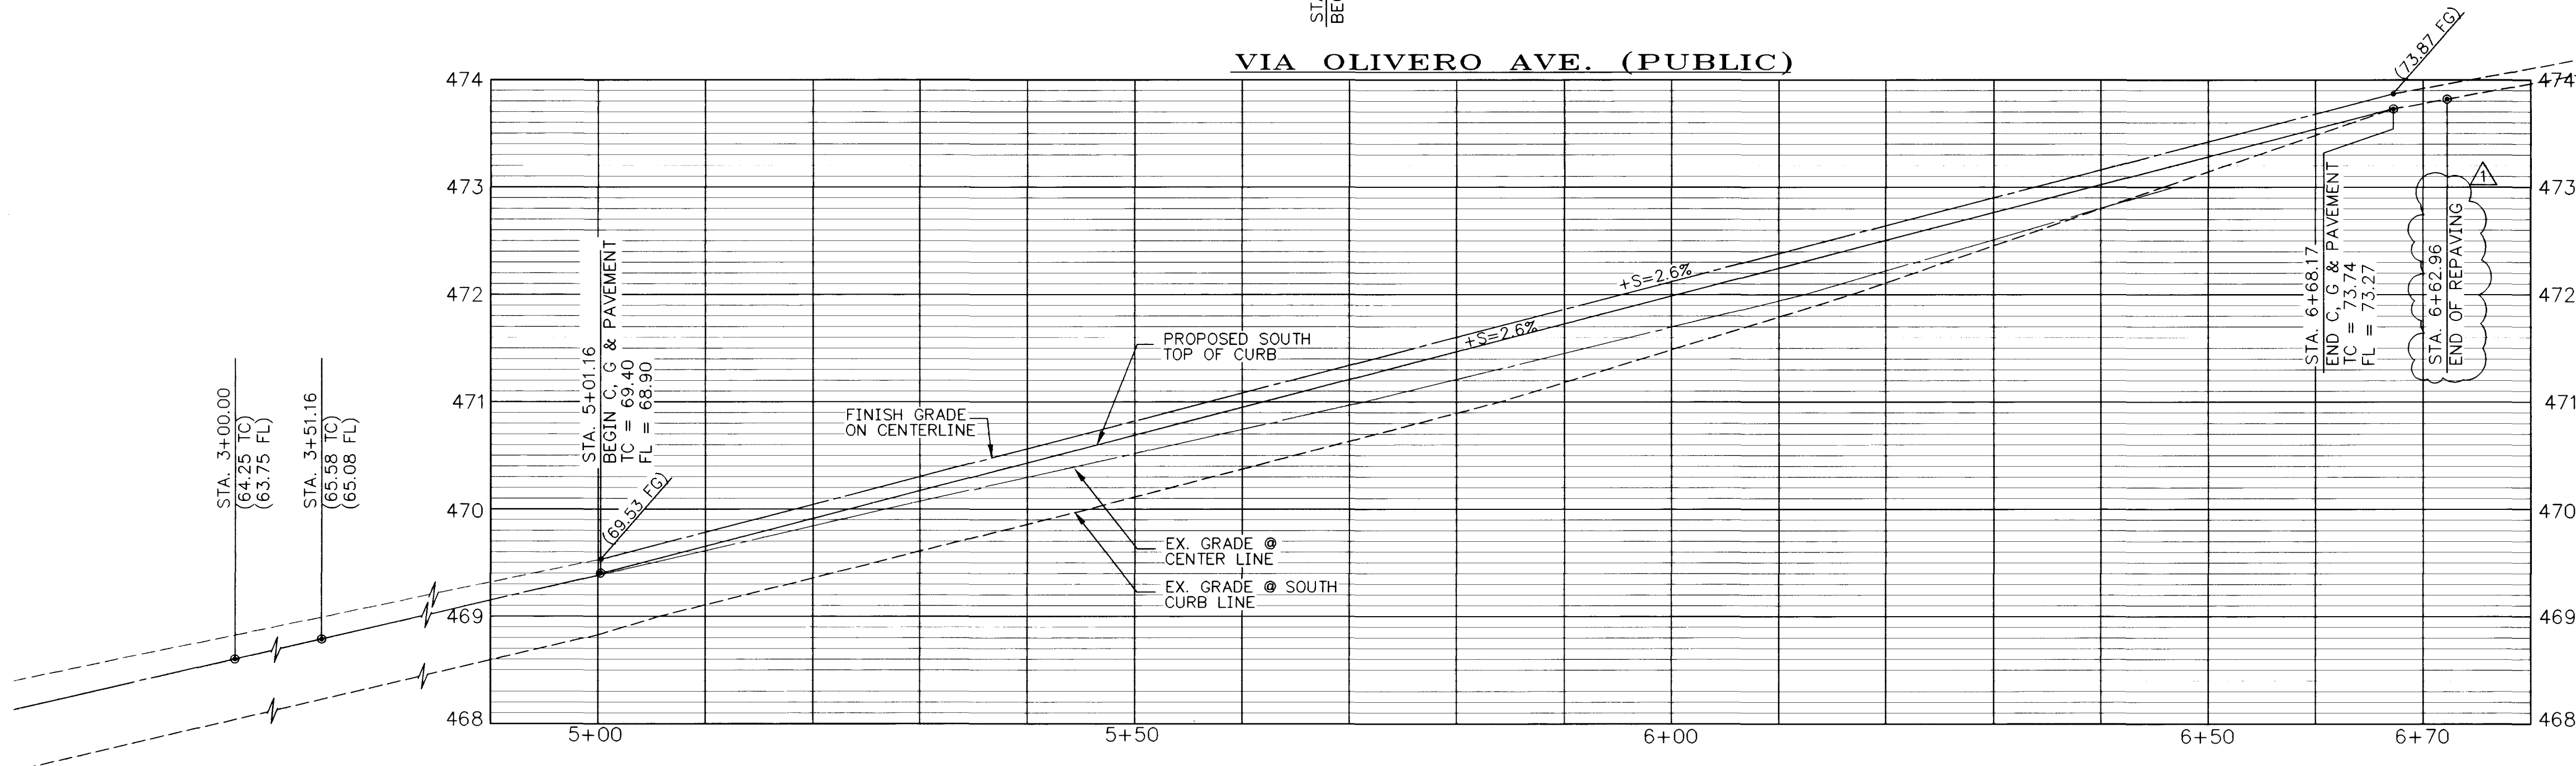

BENCHMARK:
CITY OF LAS VEGAS BENCHMARK ID# 7C1010N4 RIVET AND SQUARE ALUMINUM PLATE NORTHEAST CORNER OF FIRE HYDRANT BASE, 400 FT. SOUTH OF SAHARA AVE. WEST SIDE OF TENAYA WAY.
ELEV. = 747.919 METERS (NAVD 88)
= 2453.80 FEET (NAVD 88)

BASIS OF BEARING:
BEING THE CENTER LINE OF SAHARA AVE. AS SHOWN IN FILE 83 PAGE 94 OF SURVEY'S OFFICIAL RECORDS CLARK COUNTY RECORDER BEING S87°52'17"W
REFERENCE: RECORD OF SURVEY FILE 83 PAGE 94

LEGAL DESCRIPTION
BEING A PORTION OF THE SOUTHEAST QUARTER (SE 1/4) OF THE SOUTHWEST QUARTER (SW 1/4) OF SECTION 3, TOWNSHIP 21S, RANGE 61E, M.D.M., CITY OF LAS VEGAS, NEVADA

1"=10' HOR.
1"=1' VERT.

NOTES:
EXISTING UTILITIES ARE LOCATED ON THE PLANS FOR THE CONVENIENCE OF THE CONTRACTOR ONLY. THE ENGINEER BEARS NO RESPONSIBILITY FOR THE LOCATION OF UTILITIES SHOWN OR NOT SHOWN ON THE PLANS. THE CONTRACTOR SHALL NOTIFY ALL UTILITY COMPANIES BEFORE STARTING CONSTRUCTION AND IT SHALL BE THE RESPONSIBILITY OF THE CONTRACTOR TO VERIFY THE LOCATION OF ALL UTILITIES WITH THE UTILITY COMPANIES.

CONSTRUCTION NOTES (PUBLIC)



- | | | |
|---|---|--------|
| 1 | CONSTRUCT 3" AC PAVING OVER 4" TYPE II OVER 6" TYPE I | 464 SY |
| 2 | CONSTRUCT TEMPORARY PAVEMENT 2" AC OVER 4" TYPE II | 37 SY |
| 3 | CONSTRUCT 'L' TYPE CURB & GUTTER PER C.C.A. STD. DWG. No.216 | 167 LF |
| 4 | CONSTRUCT 4" WIDE DROP INLET TYPE "A" PER C.C.A. STD. DWG. No.411 | 1 EA |
| 5 | CONSTRUCT 18" RCP STORM DRAIN CLASS III | 17 LF |
| 6 | SAWCUT AND REMOVE PER EX. PAVEMENT | 300 SF |

SOILS REPORT INFO:

FIRM NAME: BUENA ENGINEERING
JOB No. LV-98-321 DOC. No. 02-98-074
DATE: FEBRUARY 27, 1998




Call before you Dig.
1-800-227-2600
UNDERGROUND SERVICE ALERT (USA)

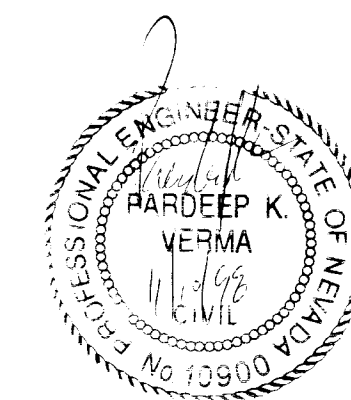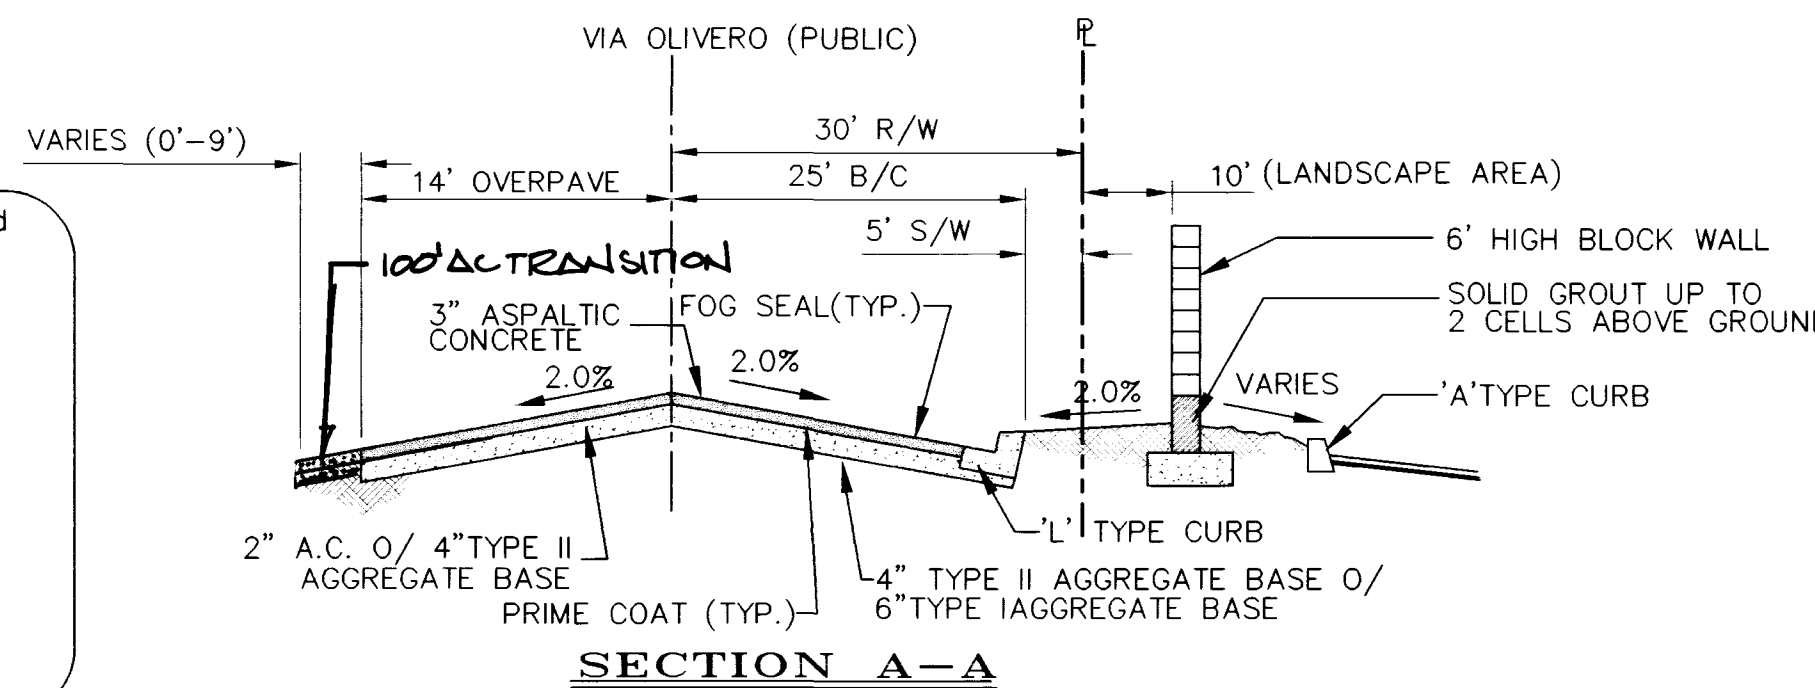

LEGEND:

- | |
|---------------------|
| EX. FIRE HYDRANT |
| EX. WATER VALVE |
| EX. POWER POLE |
| EX. GUY WIRE |
| PROPERTY LINE |
| CENTERLINE |
| EXISTING WATER LINE |
| EXISTING SEWER LINE |

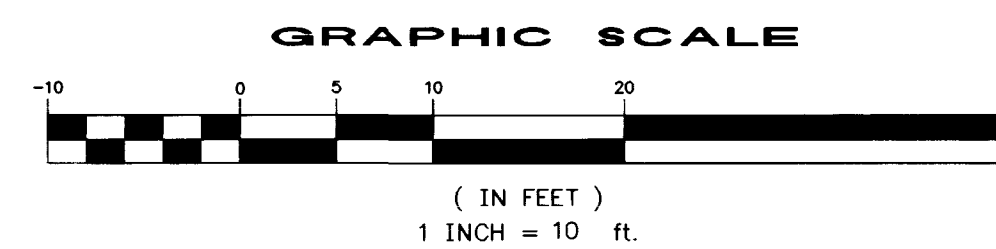

STREET IMPORVEMENT PLAN
FOR VIA OLIVERO AVE
FIELDS OFFICE BLDG.

DATE: 9/4/98
JOB # 96-182
DWG. BY: C.C.

C4

SHEET
4 OF 4

107-V2902

