

MATCHLINE SEE SHEET H1

GRAPHIC SCALE




(IN FEET)
1 inch = 30 ft.

BACK OF CURB CURVE DATA TABLE:


Table with columns: CURVE, RADIUS, LENGTH, TANGENT, DELTA. Lists curve data for various points from C1 to C510.

BACK OF CURB TANGENT DATA TABLE:


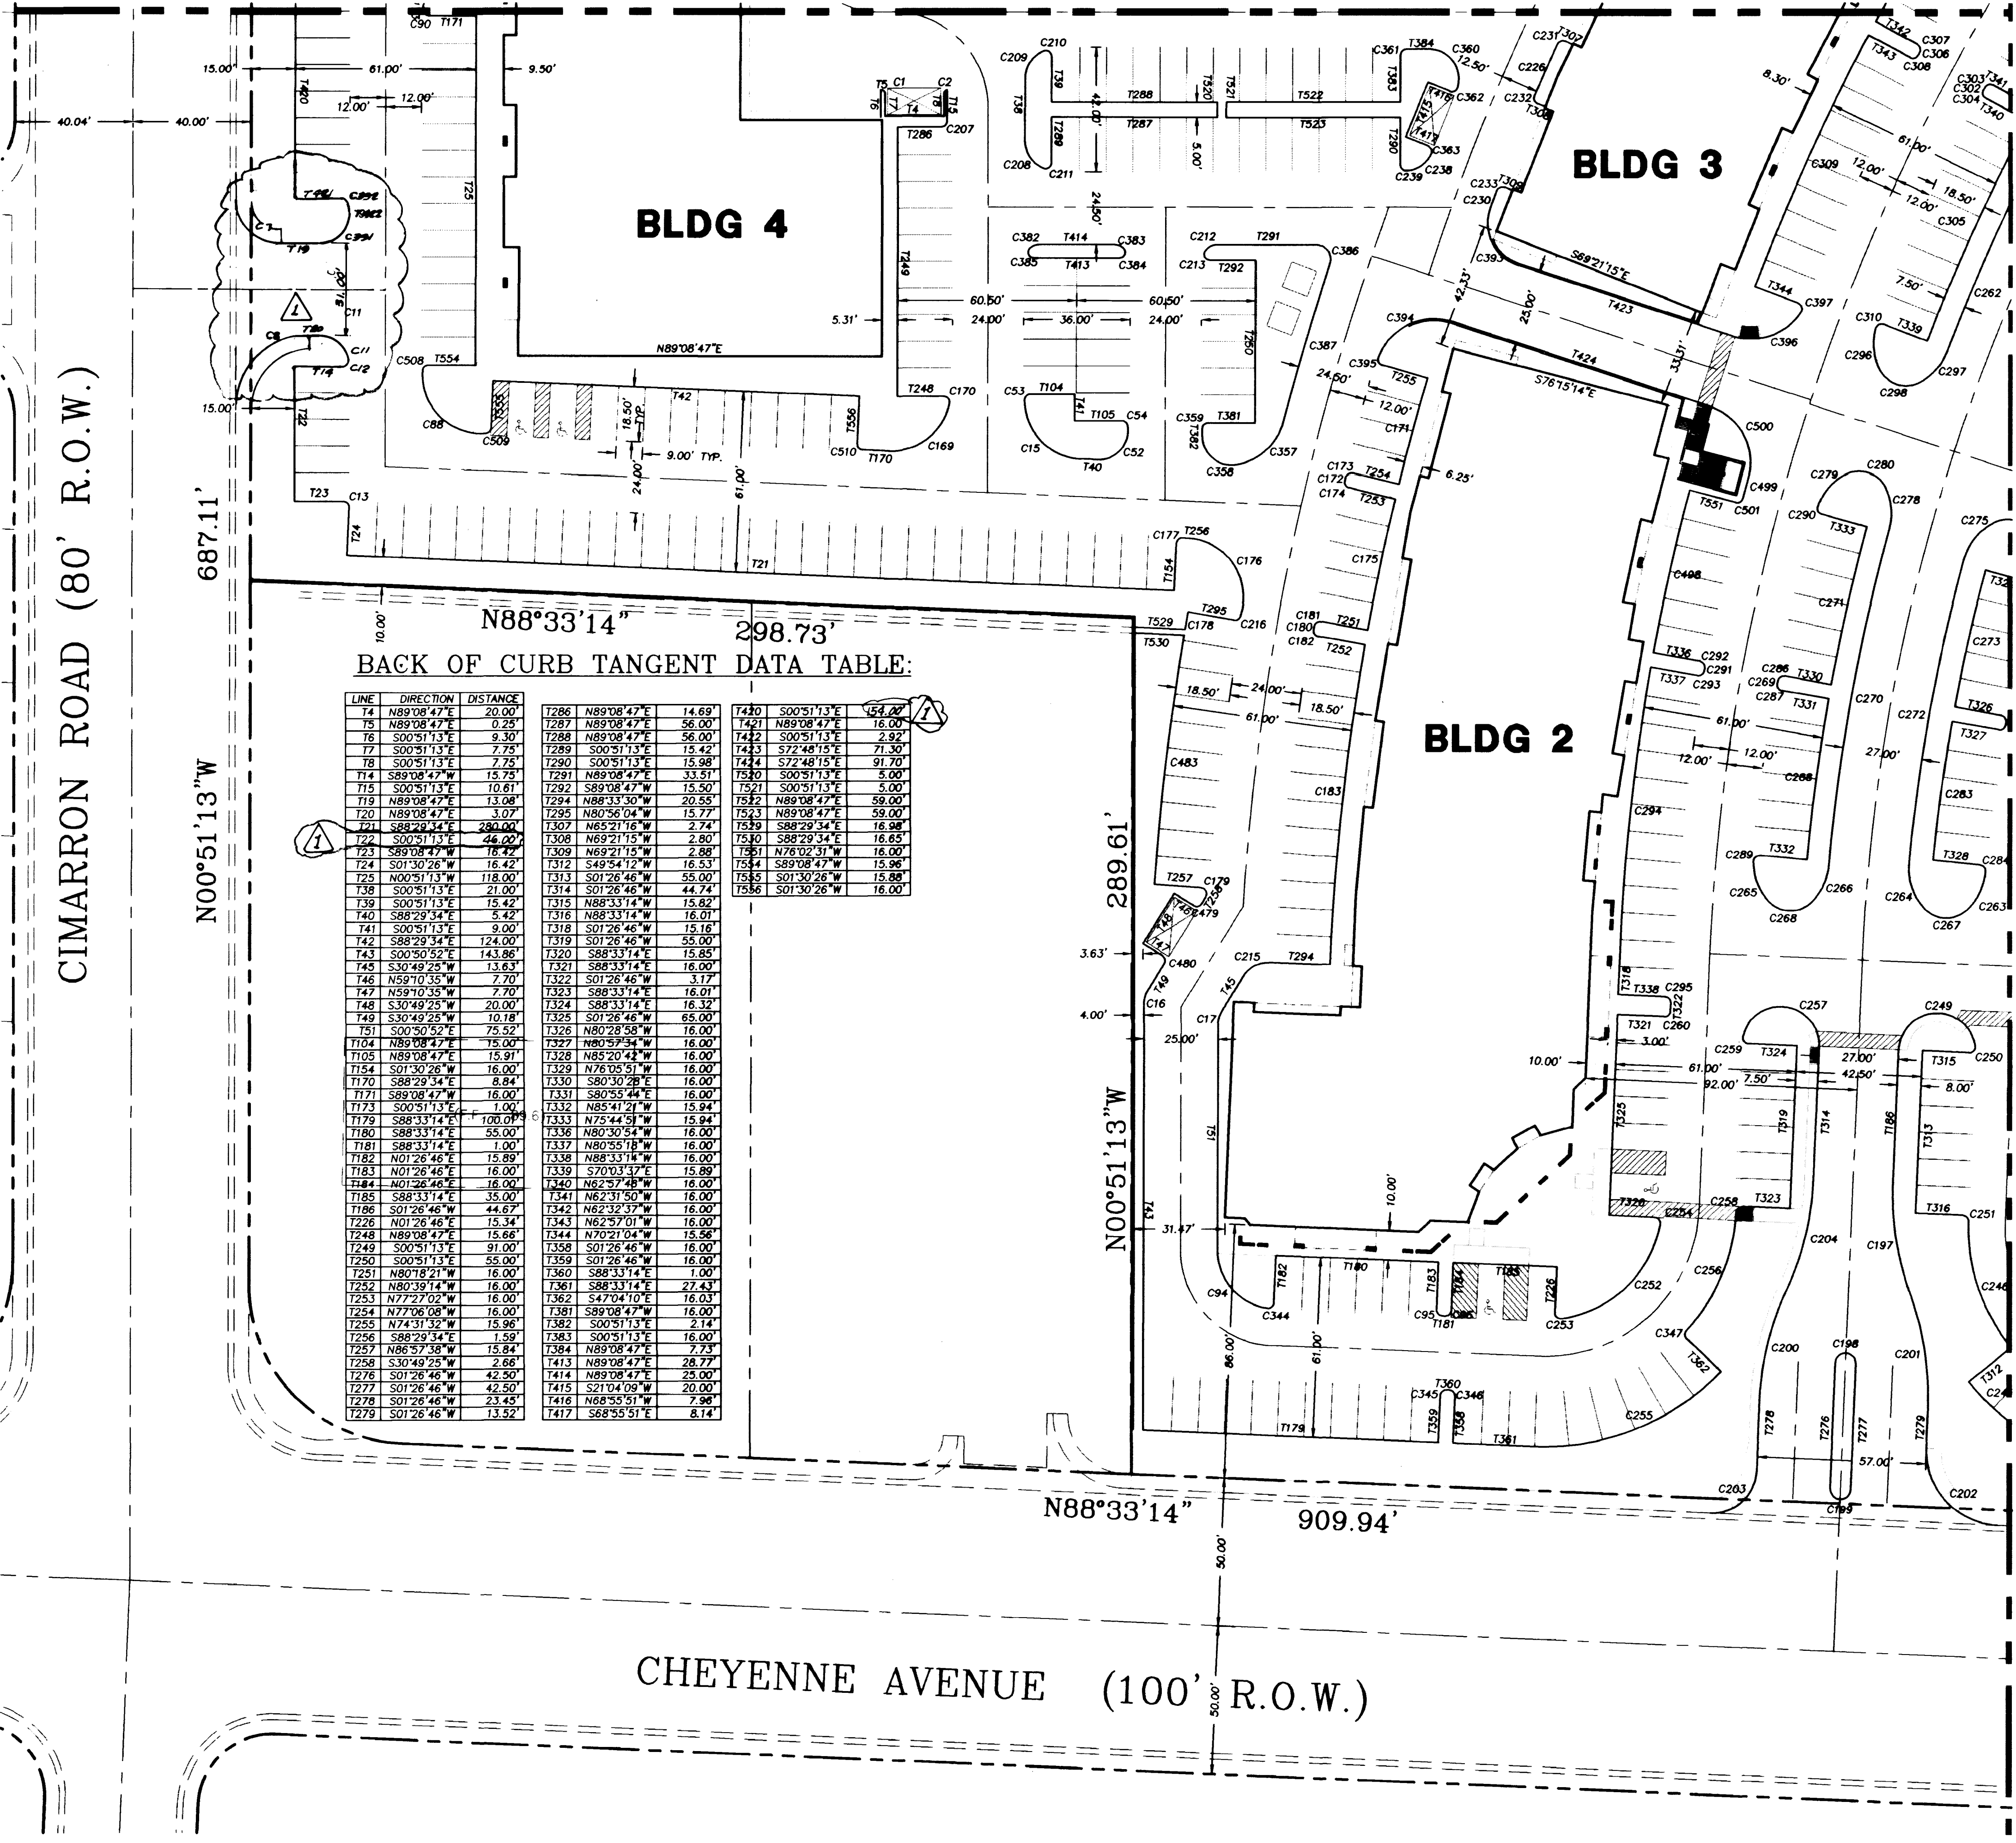

MATCHLINE SEE SHEET H4

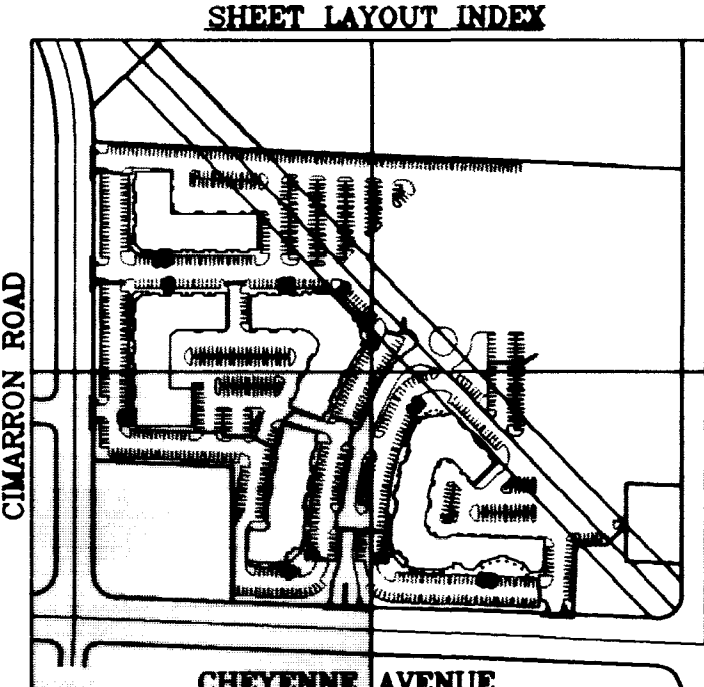

Project information including: NORTHWEST PROPERTIES, L.L.C.; Agra Infrastructure, Inc.; HORIZONTAL CONTROL PLAN; FLYNN GALLAGHER CORP. CENTER; DRAWN BY, DESIGNED BY, CHECKED BY; PROJECT NO.; SCALE; SHEET NO. 14 OF 15 SHEETS; DRAWING NO. 107-V2965.

NOTE: ALL DIMENSIONS ARE TO BACK OF CURB, FACE OF BUILDING, OR EDGE OF PROPERTY LINE, UNLESS OTHERWISE NOTED.

BASIS OF BEARING: THE SOUTH LINE OF SECTION 9, T20S, R60E, M.D.M. OF "AMENDED PLAT OF NORTH SHORE, PHASE 1", BOOK 57, PAGE 89, FOUND AS SHOWN HEREON, THE BEARING OF SAID LINE BEING N 88°33'14" W.

13131

