
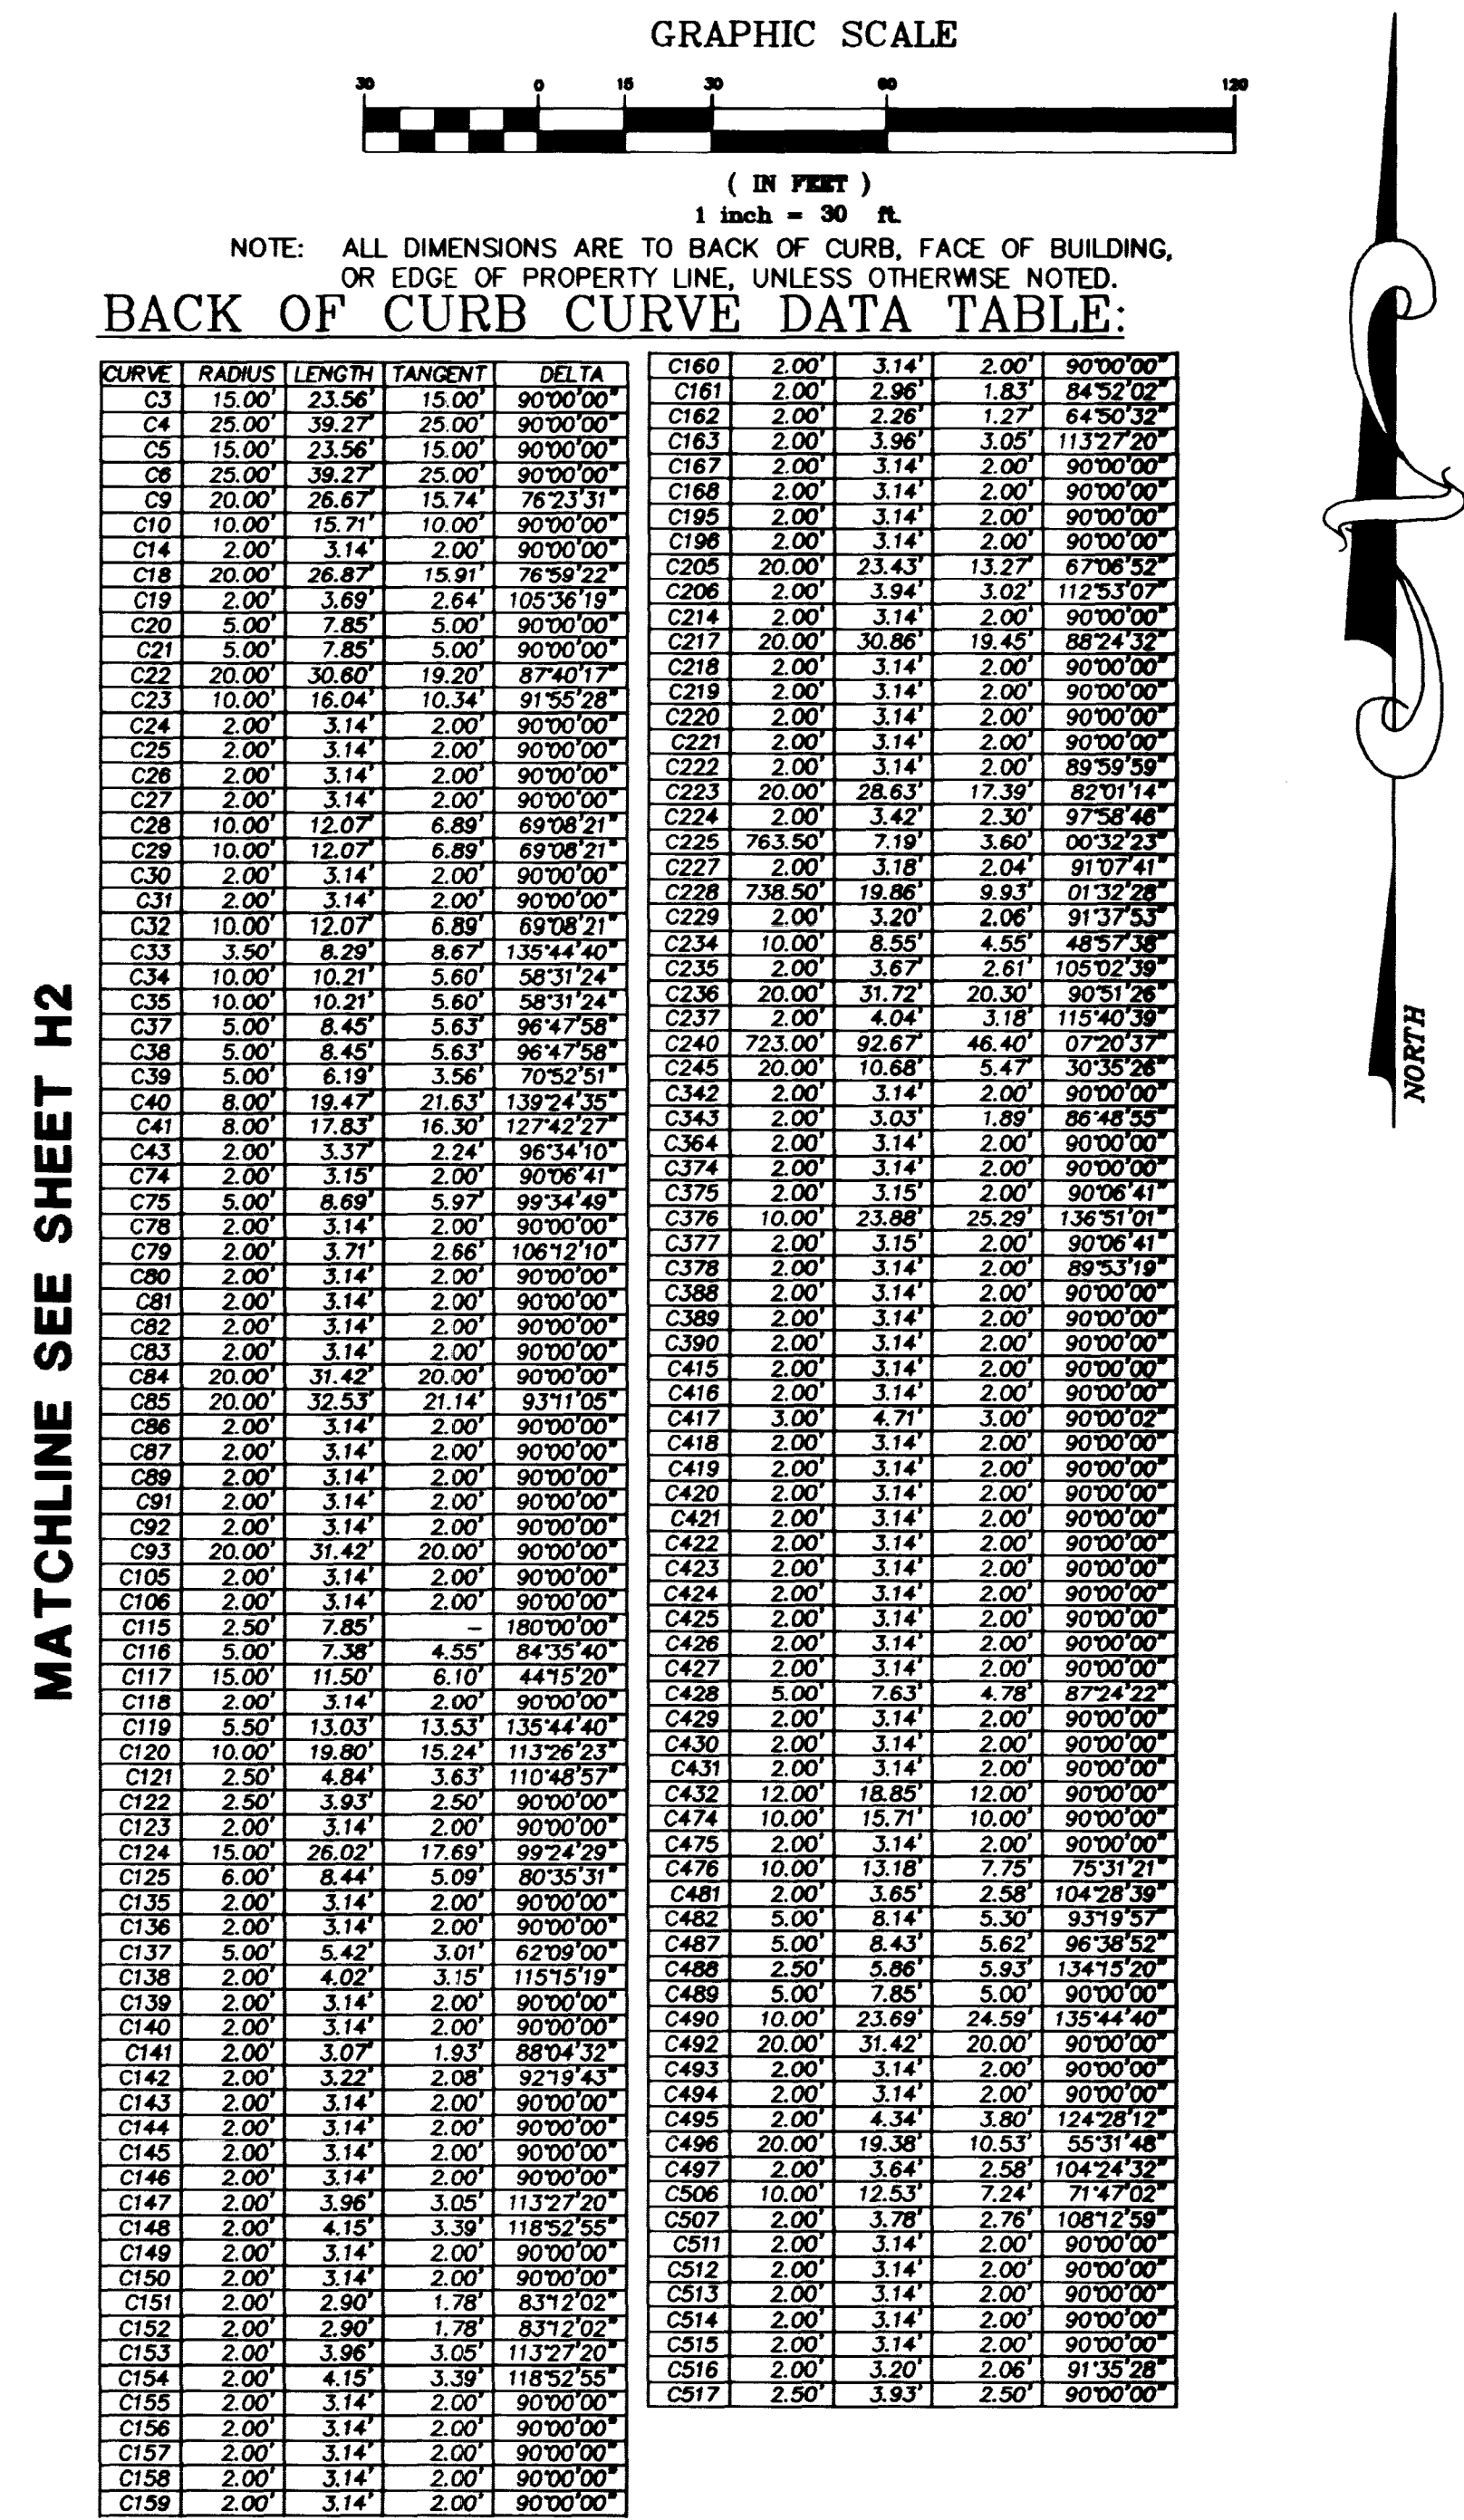


[illegible]

CITY OF LAS VEGAS BM. NO. 0LV0016N4
RIVET & PLATE, TOP OF CURB, ON CHEYENNE AVE., 1250' WEST OF
SOFT BREEZES DRIVE, SOUTH CURB LINE
ELEV: 2407.70' (733.8685M) (NAVD 88)

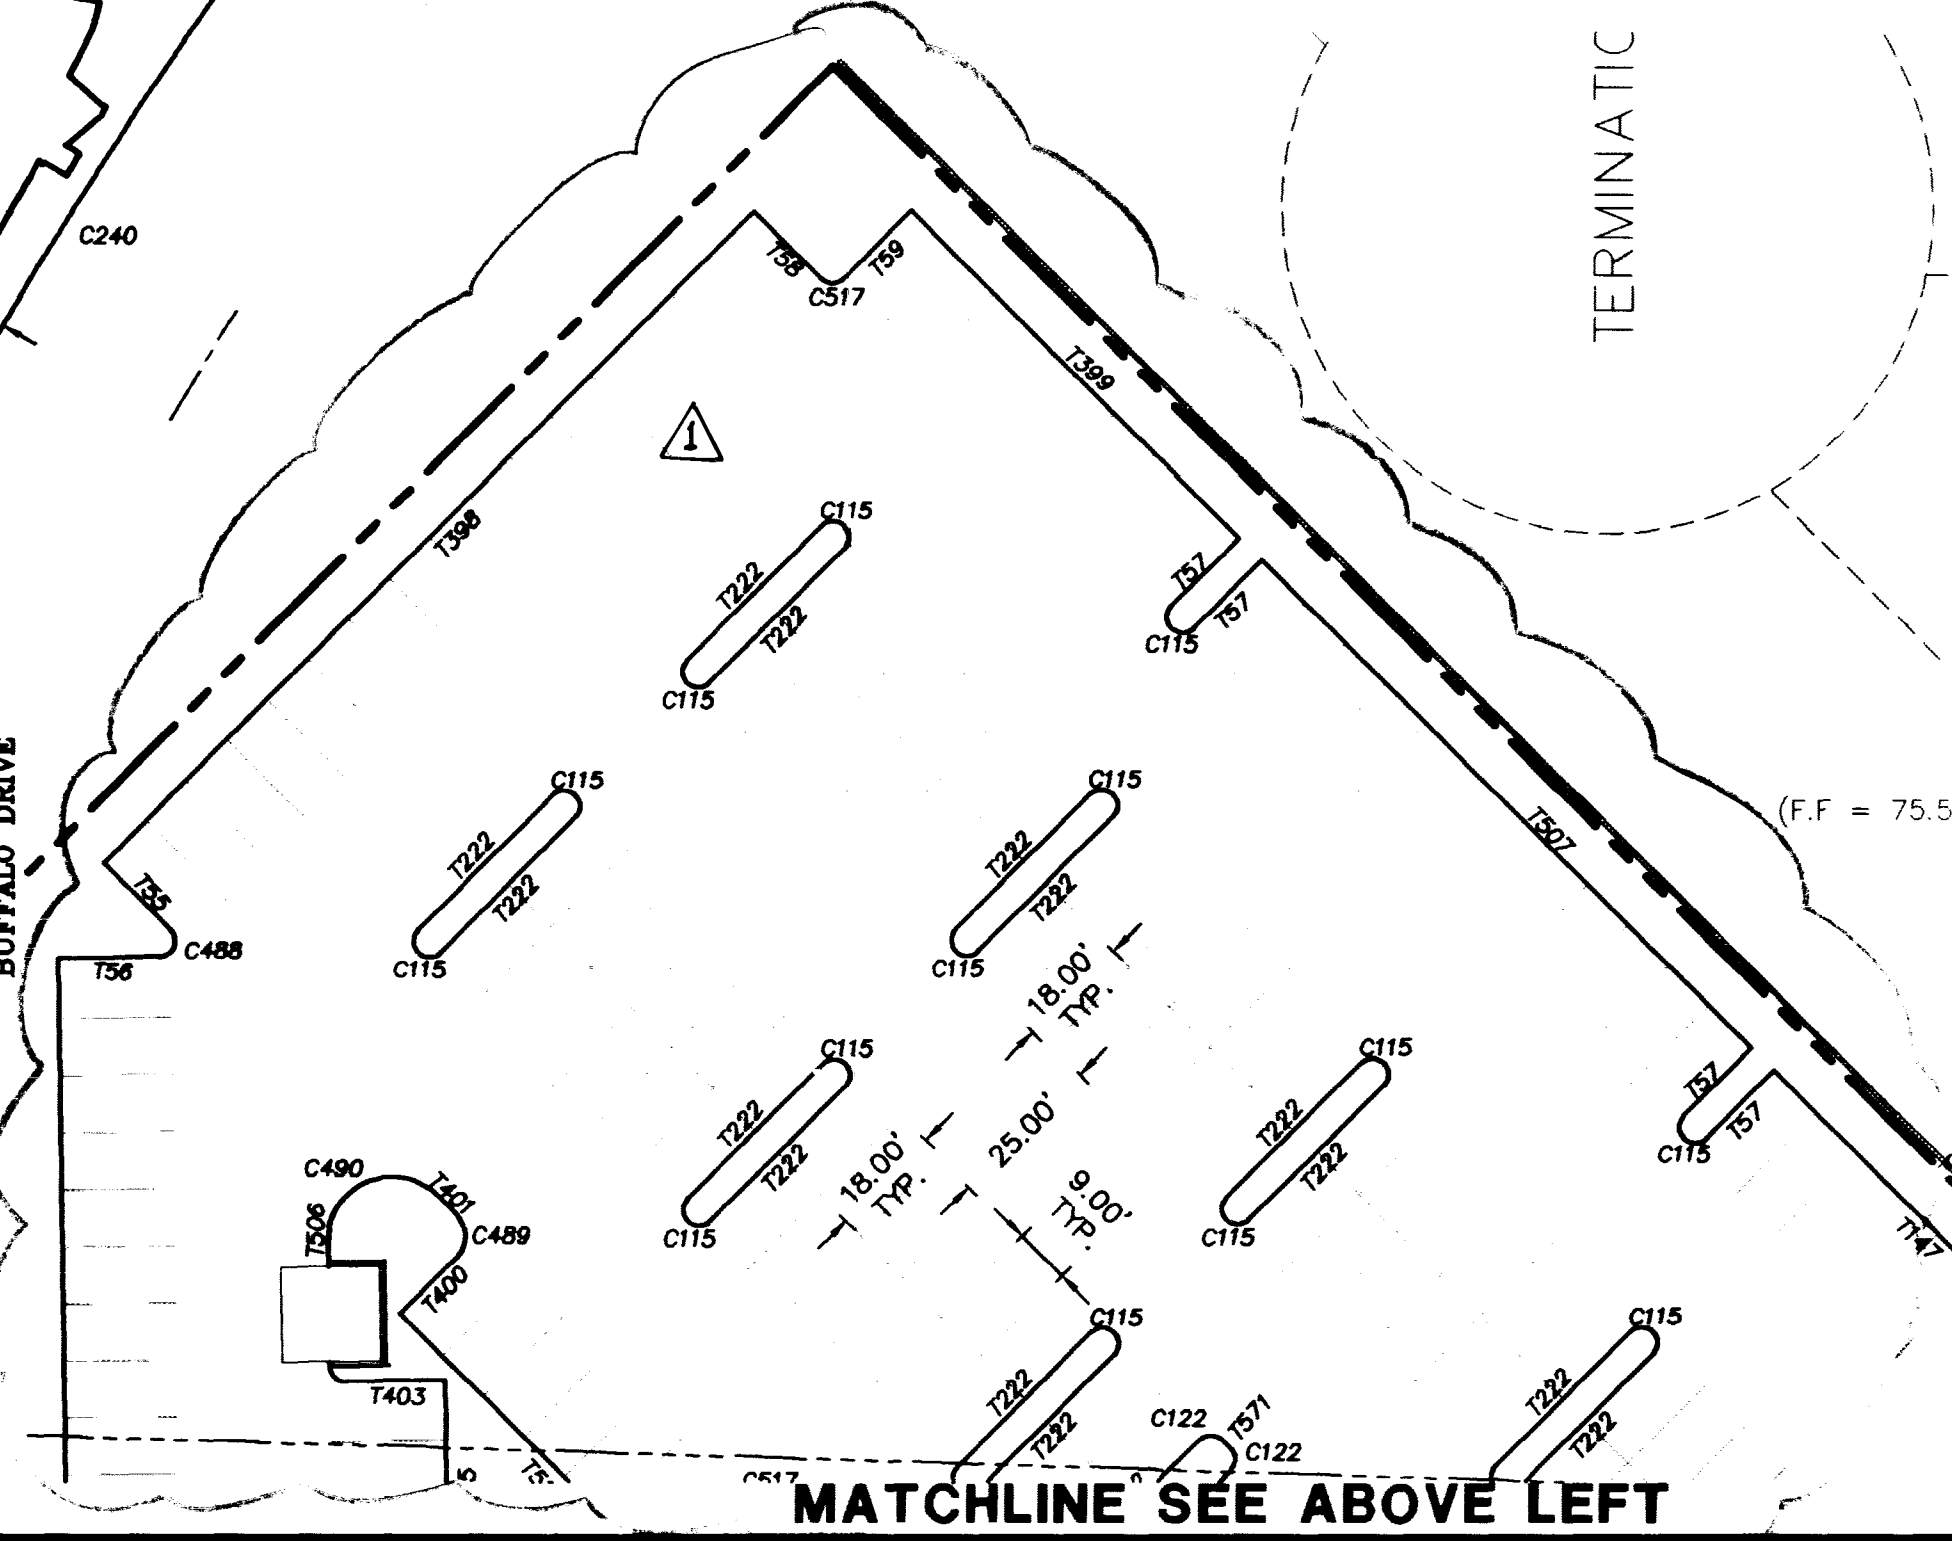

CUMMARRON ROAD (80' R.O.W.)




26

BLDG 5

BLDG 4

BLDG 3


BACK OF CURB TANGENT DATA TABLE:







TERMINATING





F

100