


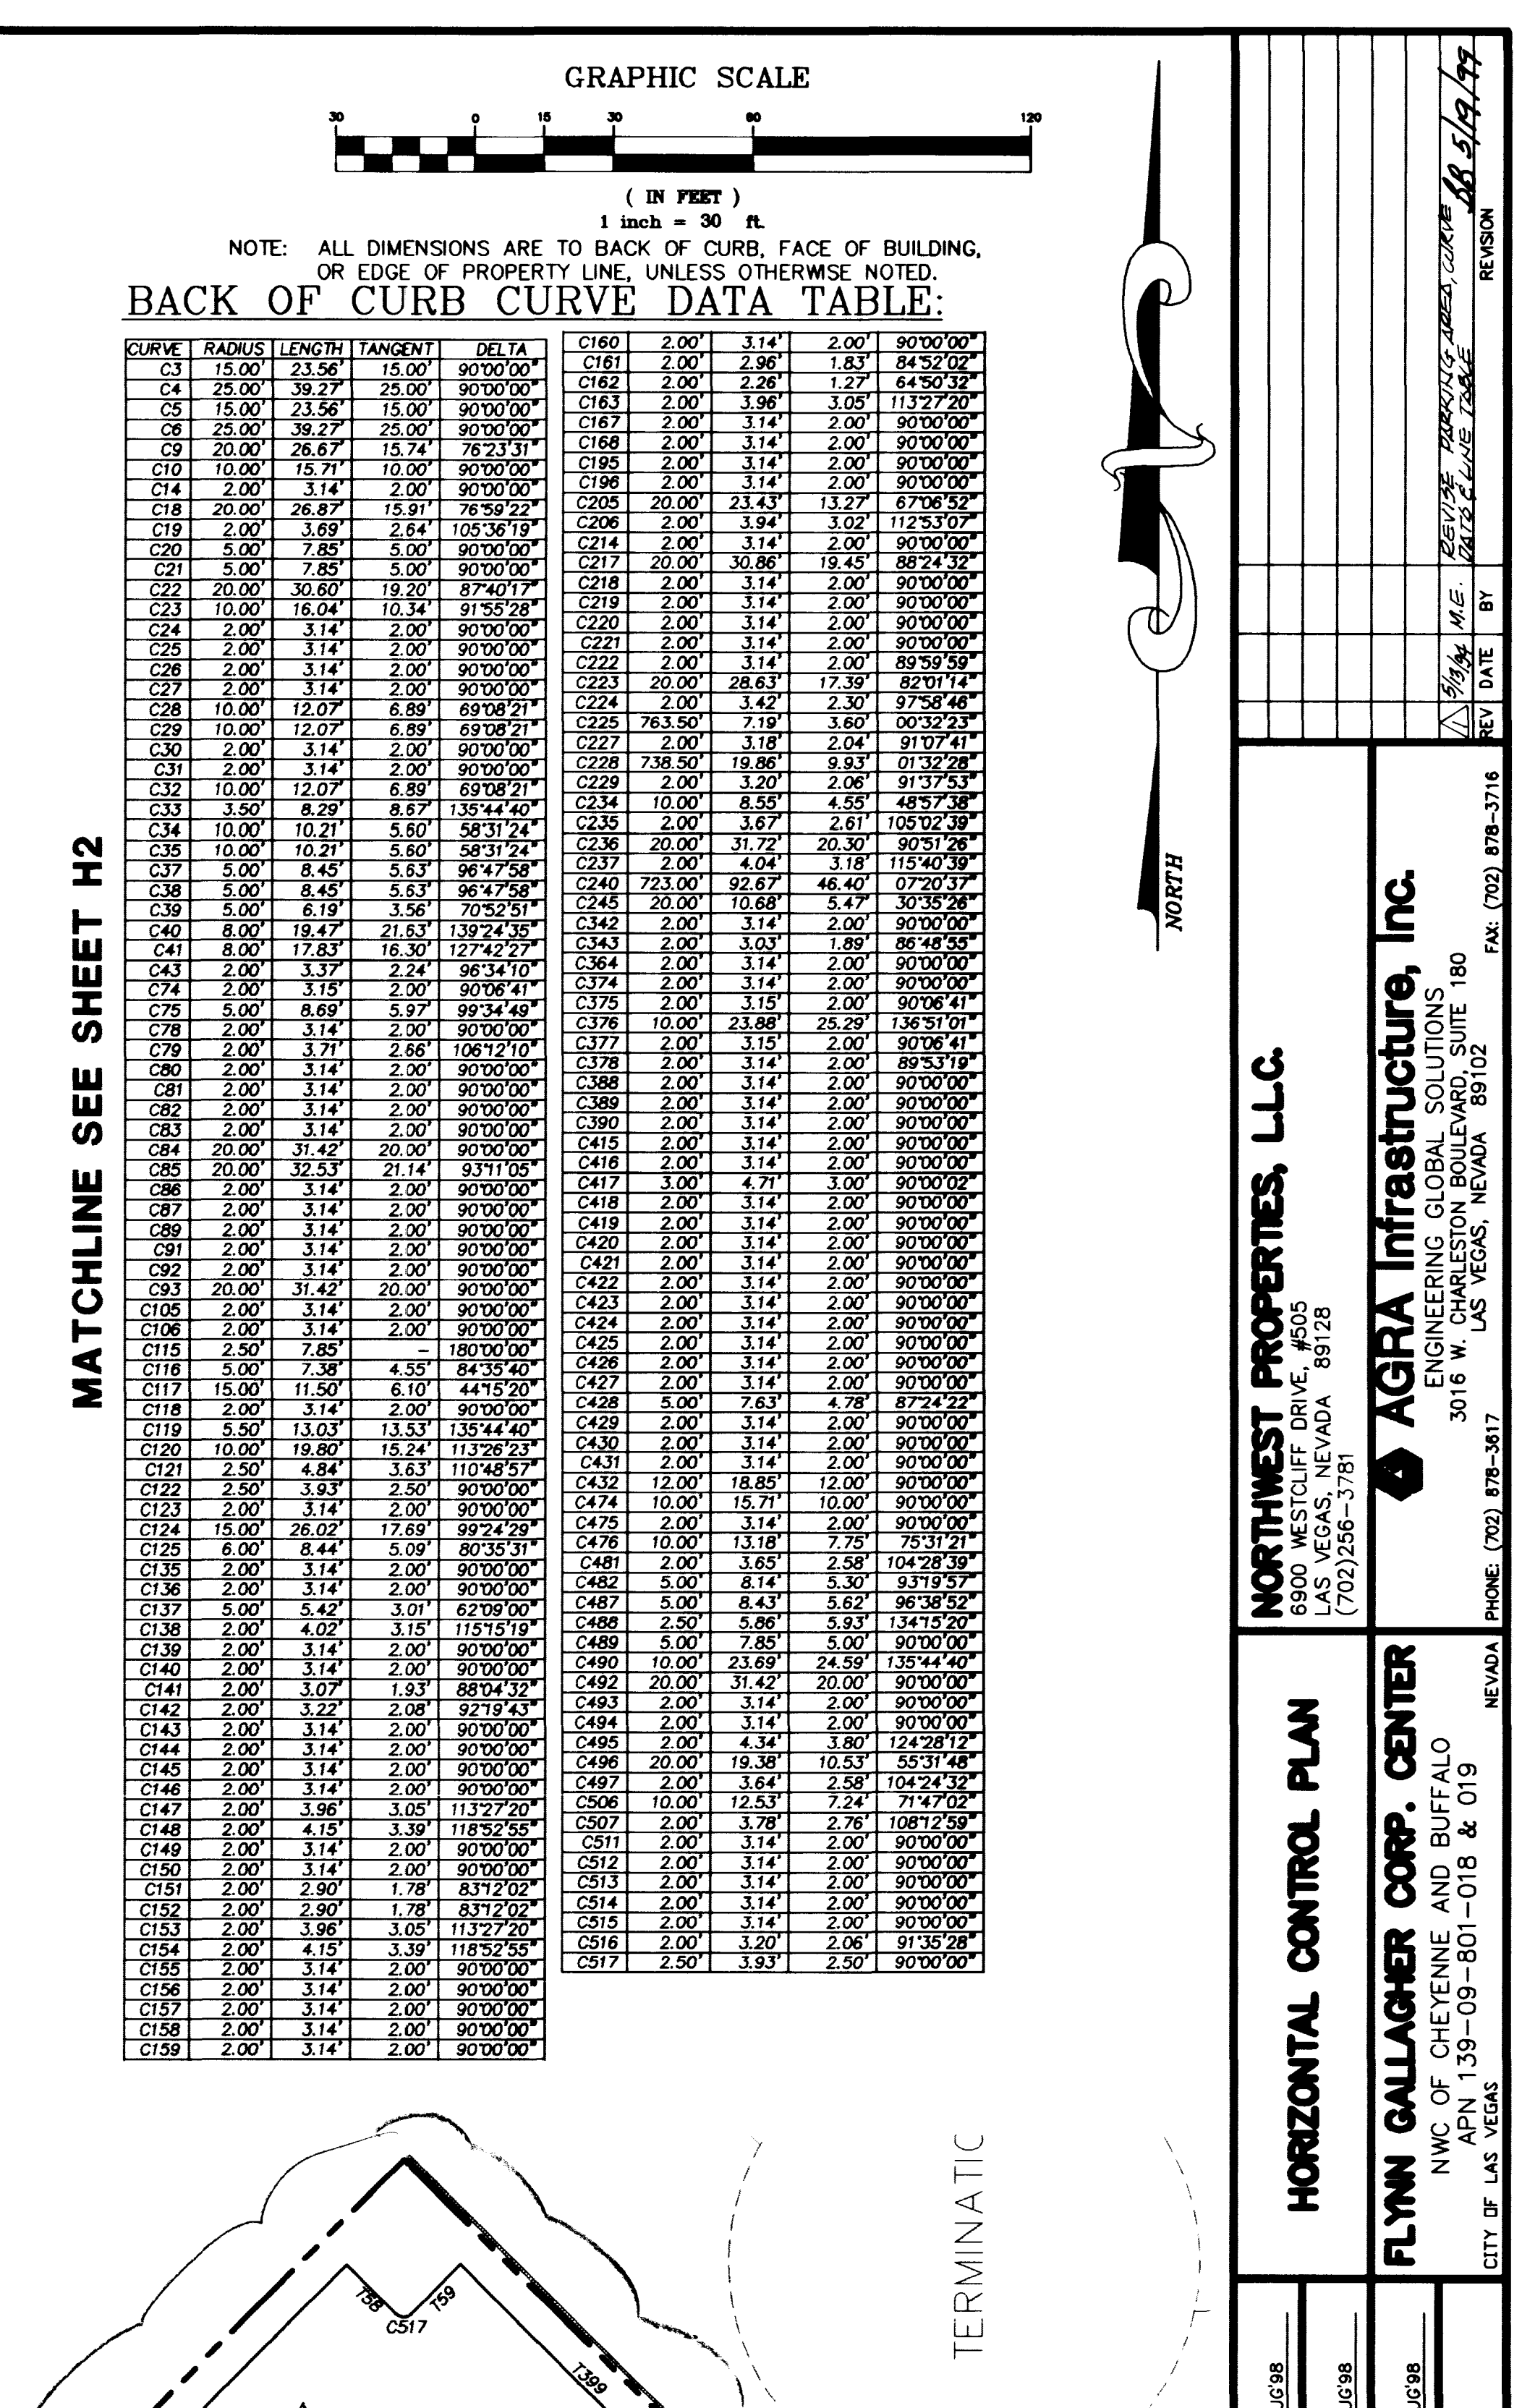

MATCHLINE SEE SHEET H3

SHEET LAYOUT INDEX

CIMARRON ROAD

CHEYENNE AVENUE

SHEET 1

SHEET 2

[illegible]

