


**TRASH ENCLOSURE DETAIL**  
NOT TO SCALE

NOTE:  
DETAIL SHOWN FOR REFERENCE ONLY, CONSTRUCTED PER ARCHITECT'S SPECIFICATION.

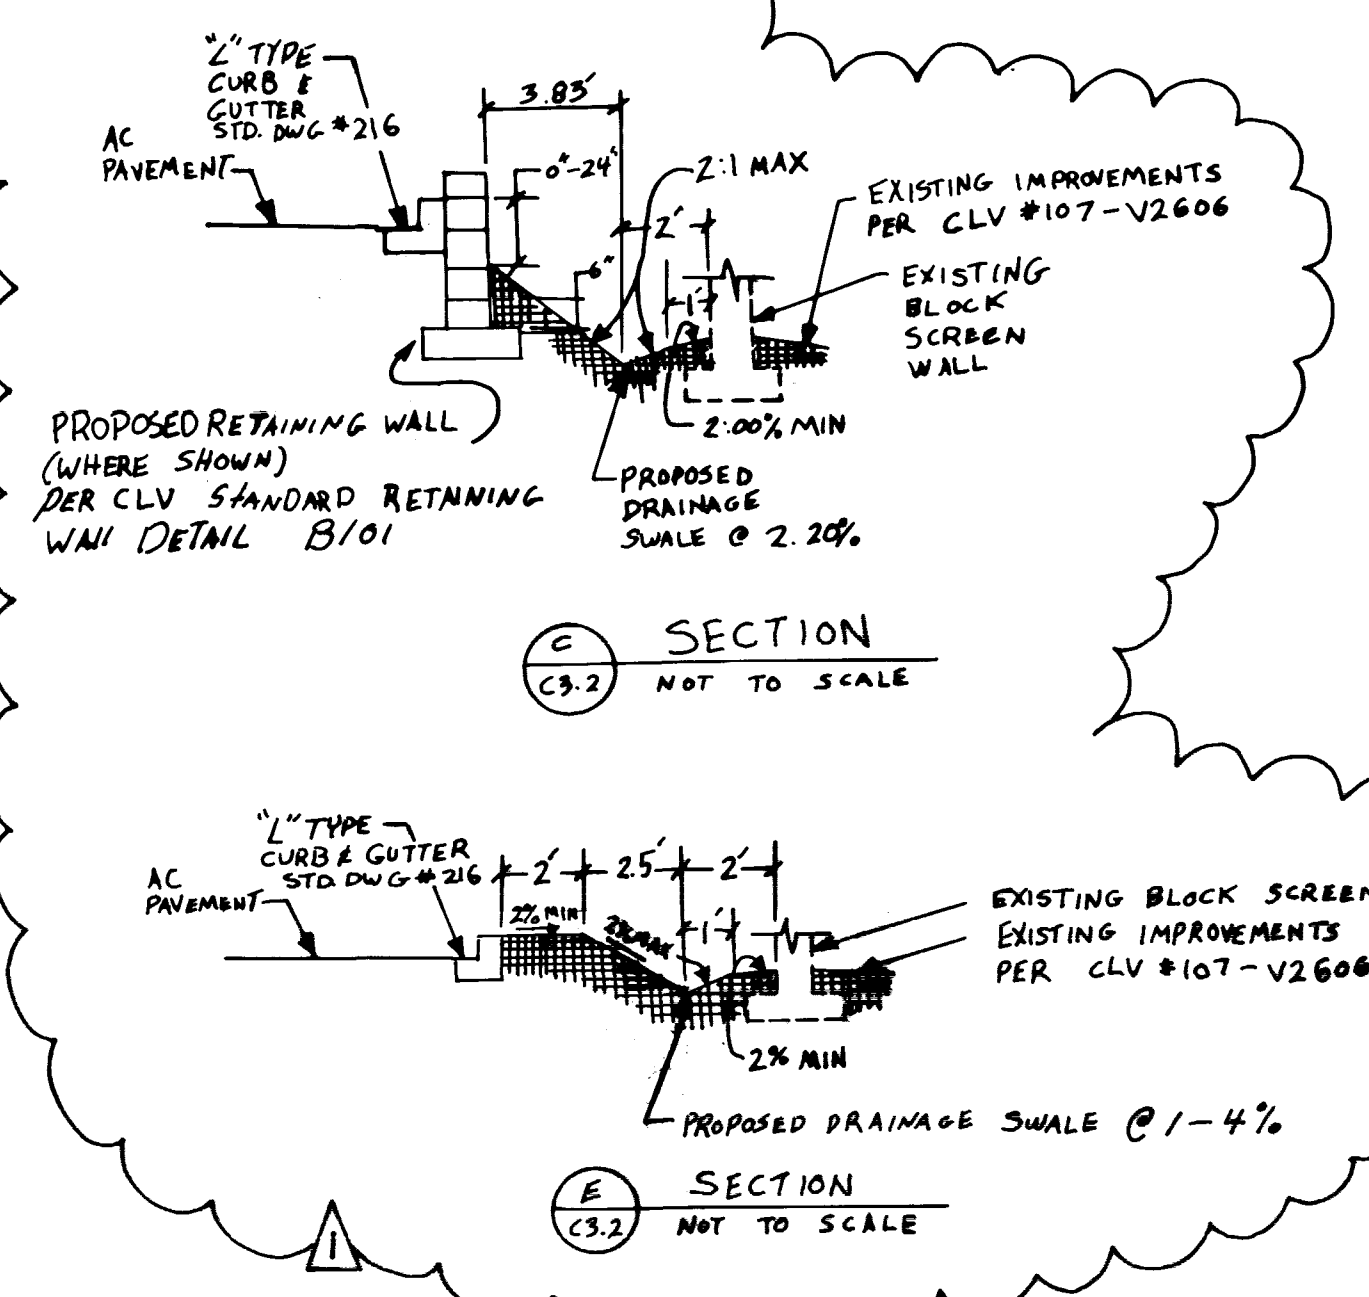

REV 1 ONLY

PROFESSIONAL ENGINEER - STATE OF NEVADA  
**EBRAHIM K. NAKHJAVANI**  
 CIVIL  
 LICENSE NO. 11077

Call before you OVERHEAD  
 1-702-593-6111

Call before you Dig.  
 1-800-227-2600

3608 N. KULLIVAN RD. BLDG. #34 SPOKANE, WA 99208 (509) 928-0736	Engineers/Planners/Surveyors 205 East Warm Springs Road, Suite 108 LAS VEGAS, NV 89115 (702) 886-8804
<b>HOSPITALITY ASSOCIATES</b>	<b>EKN ENGINEERING</b>
<b>GRADING DETAILS</b>	<b>HAWTHORN SUITES LTD</b> -SAHARA AVE. and FORT APACHE ROAD- CITY OF LAS VEGAS NEVADA
SHEET 7 OF 10 SHEETS	SCALE: NOT TO SCALE
DRAWN BY: J.W. RIPLEY 2/1/99	DESIGNED BY: J.W. RIPLEY 2/1/99
CHECKED BY: D.E. PETERS 2/1/99	PROJECT NO: 99-503
SEAL	SEAL
PROFESSIONAL ENGINEER - STATE OF NEVADA <b>DENTON E. PEETERS</b> CIVIL LICENSE NO. 10008	PROFESSIONAL ENGINEER - STATE OF NEVADA <b>EBRAHIM K. NAKHJAVANI</b> CIVIL LICENSE NO. 11077
8/4/99	4/4/99
107-V3073	107-V3073

