




Book: 870616

FOOTHILLS COUNTRY CLUB UNIT NO. 1

00822

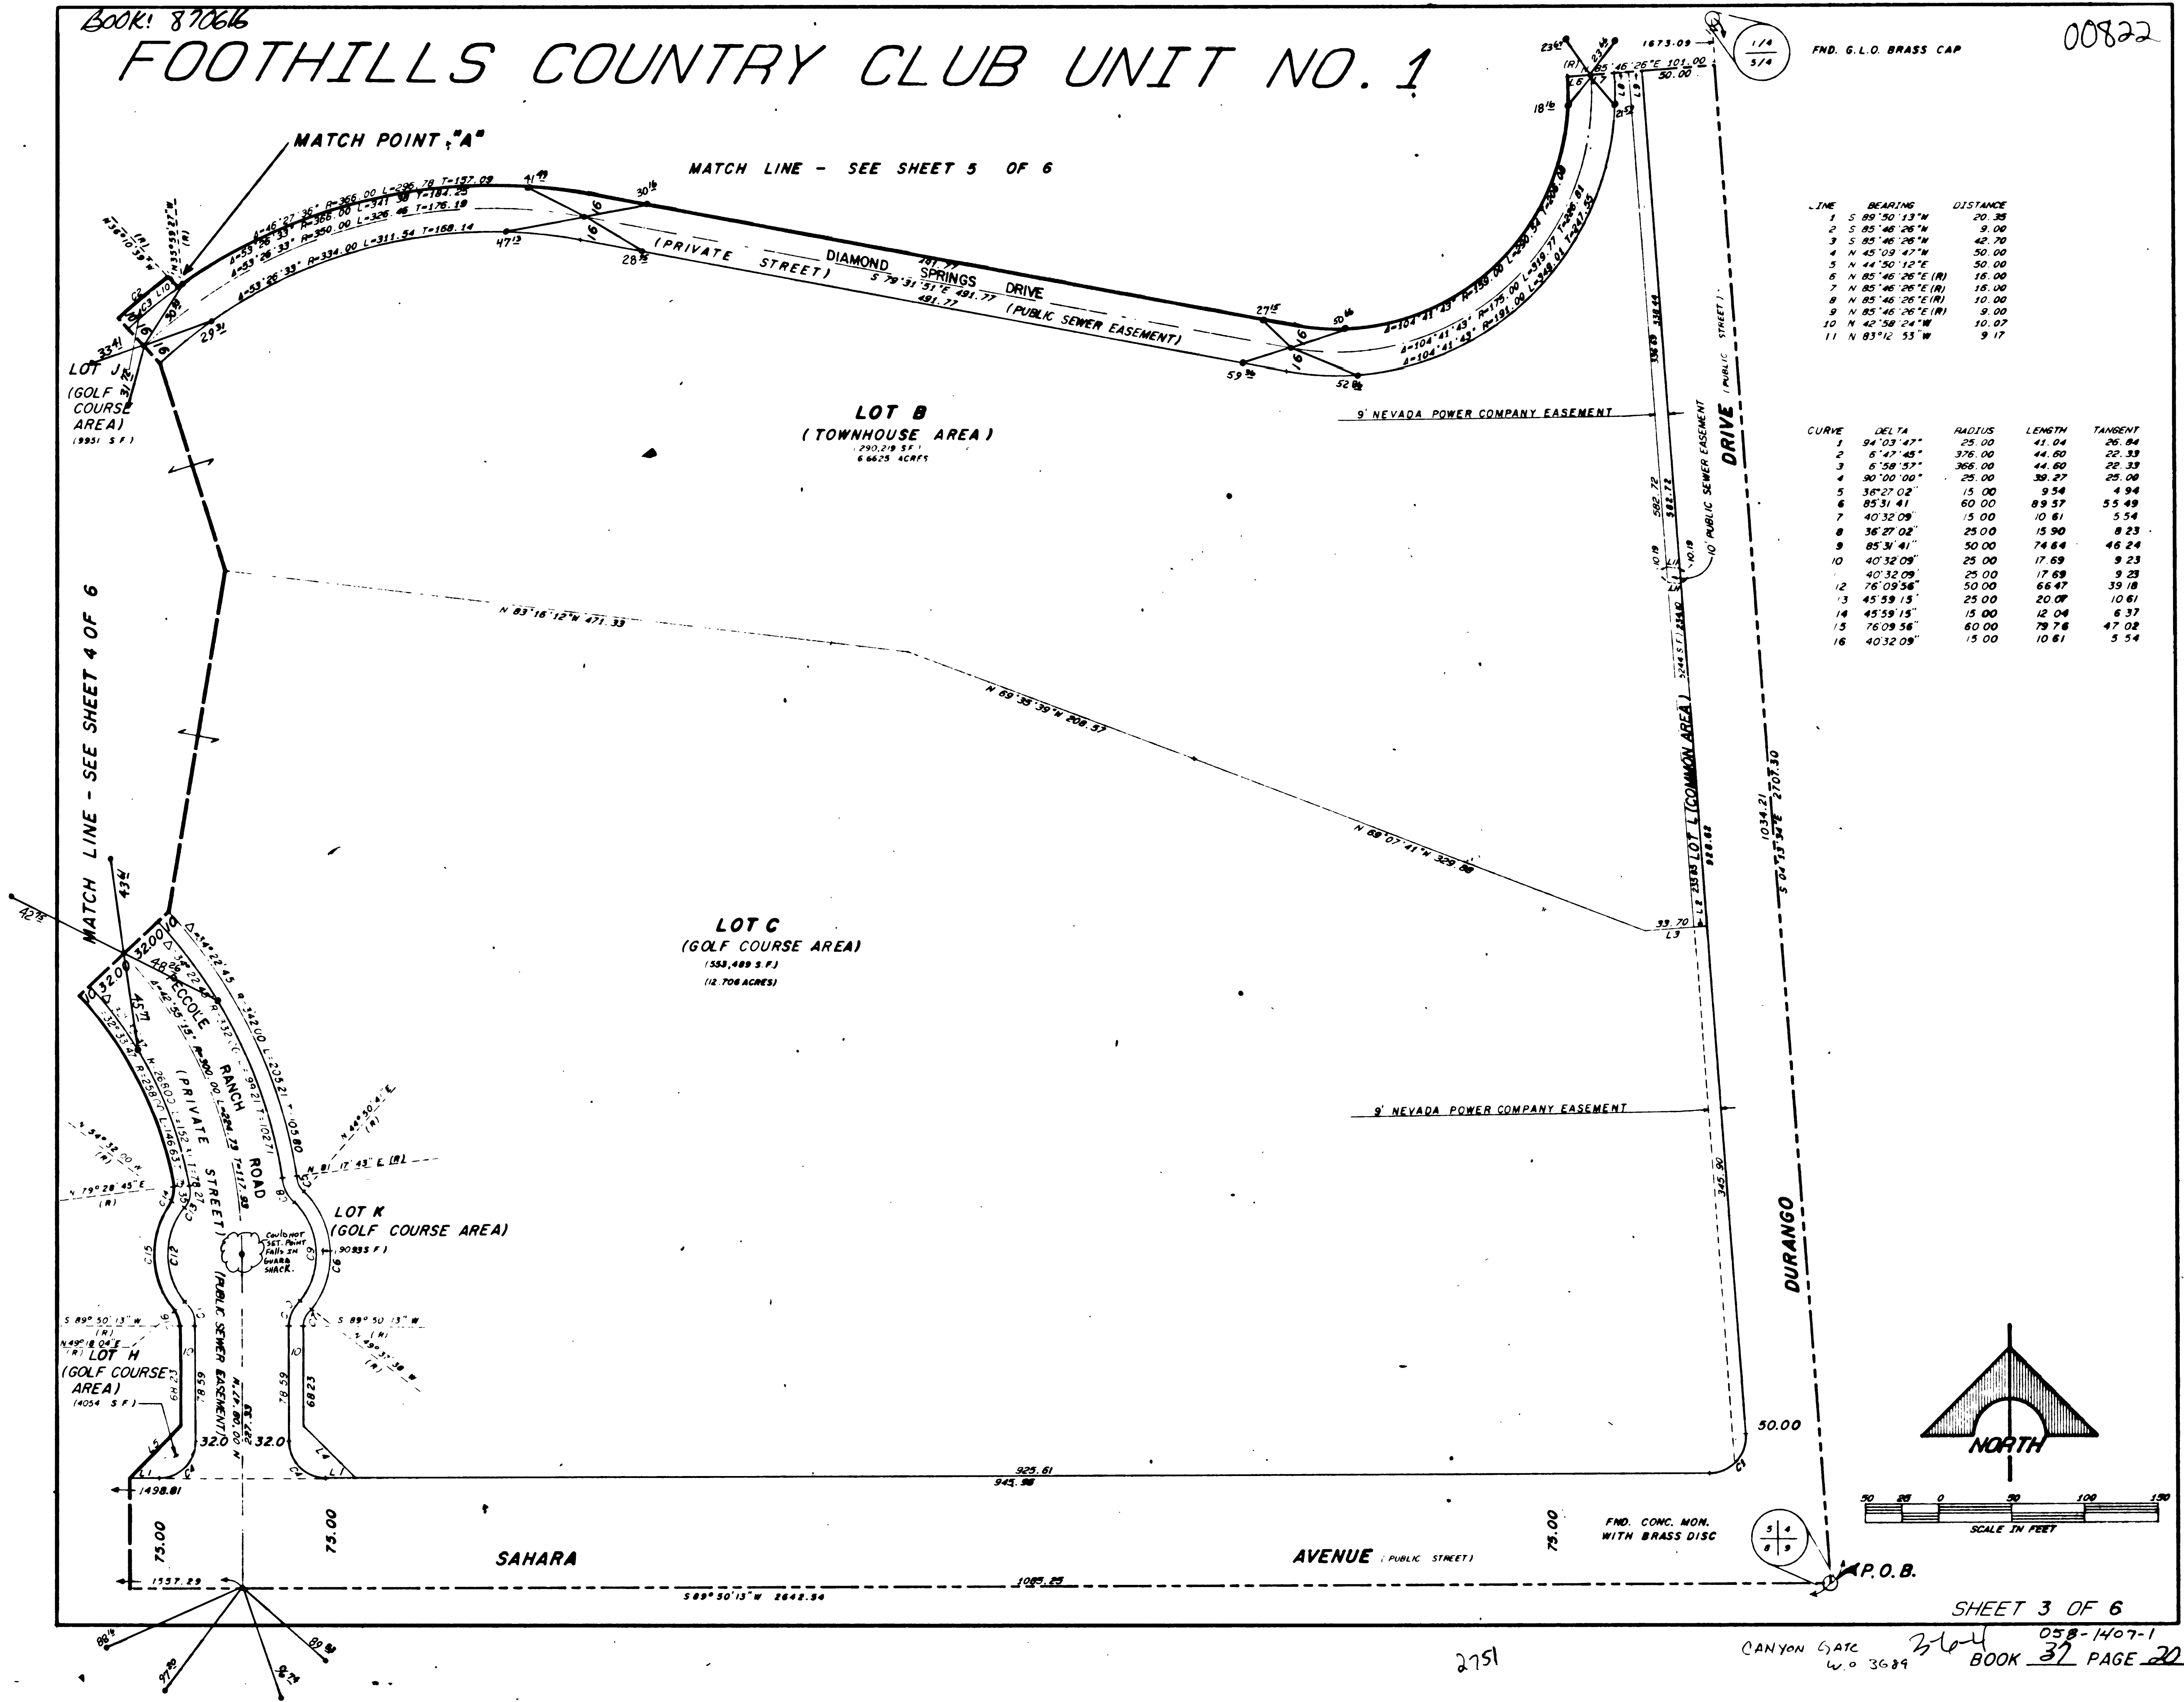

CURVE	DELTA	RADIUS	LENGTH	TANGENT
1	94°03'47"	25.00	41.04	25.84
2	6°47'45"	376.00	44.60	22.33
3	6°58'57"	366.00	44.60	22.33
4	90°00'00"	25.00	39.27	25.00
5	38°27'02"	15.00	9.54	4.94
6	85°31'41"	60.00	89.57	55.48
7	40°32'09"	15.00	10.61	5.54
8	36°27'02"	25.00	15.90	8.23
9	85°31'41"	50.00	74.64	46.24
10	40°32'09"	25.00	17.69	9.23
11	40°32'09"	25.00	17.69	9.23
12	76°09'56"	50.00	66.47	39.18
13	45°39'15"	25.00	20.07	10.61
14	45°39'15"	15.00	12.04	6.37
15	76°09'56"	60.00	79.74	47.02
16	40°32'09"	15.00	10.61	5.54

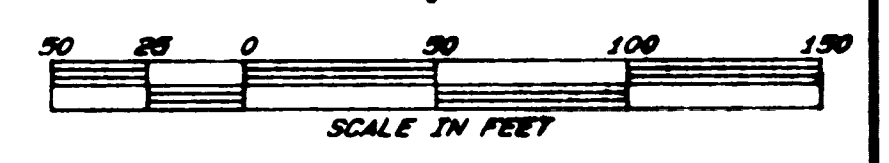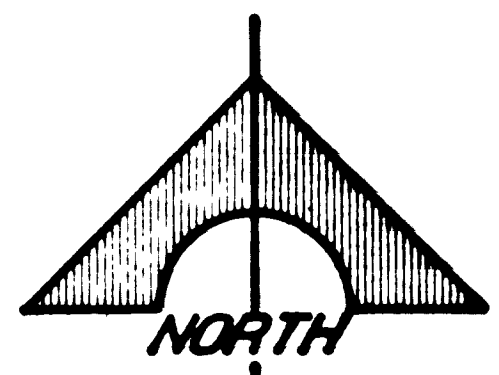

SHEET 3 OF 6

2751

CANYON GATE 3/20 058-1407-1
 W.O. 3689 BOOK 37 PAGE 22

