


BOOK 890313

AMENDED PLAT OF FOOTHILLS COUNTRY CLUB UNIT NO. 2 MONUMENTATION TIE MAP

0.0525

UNDEVELOPED

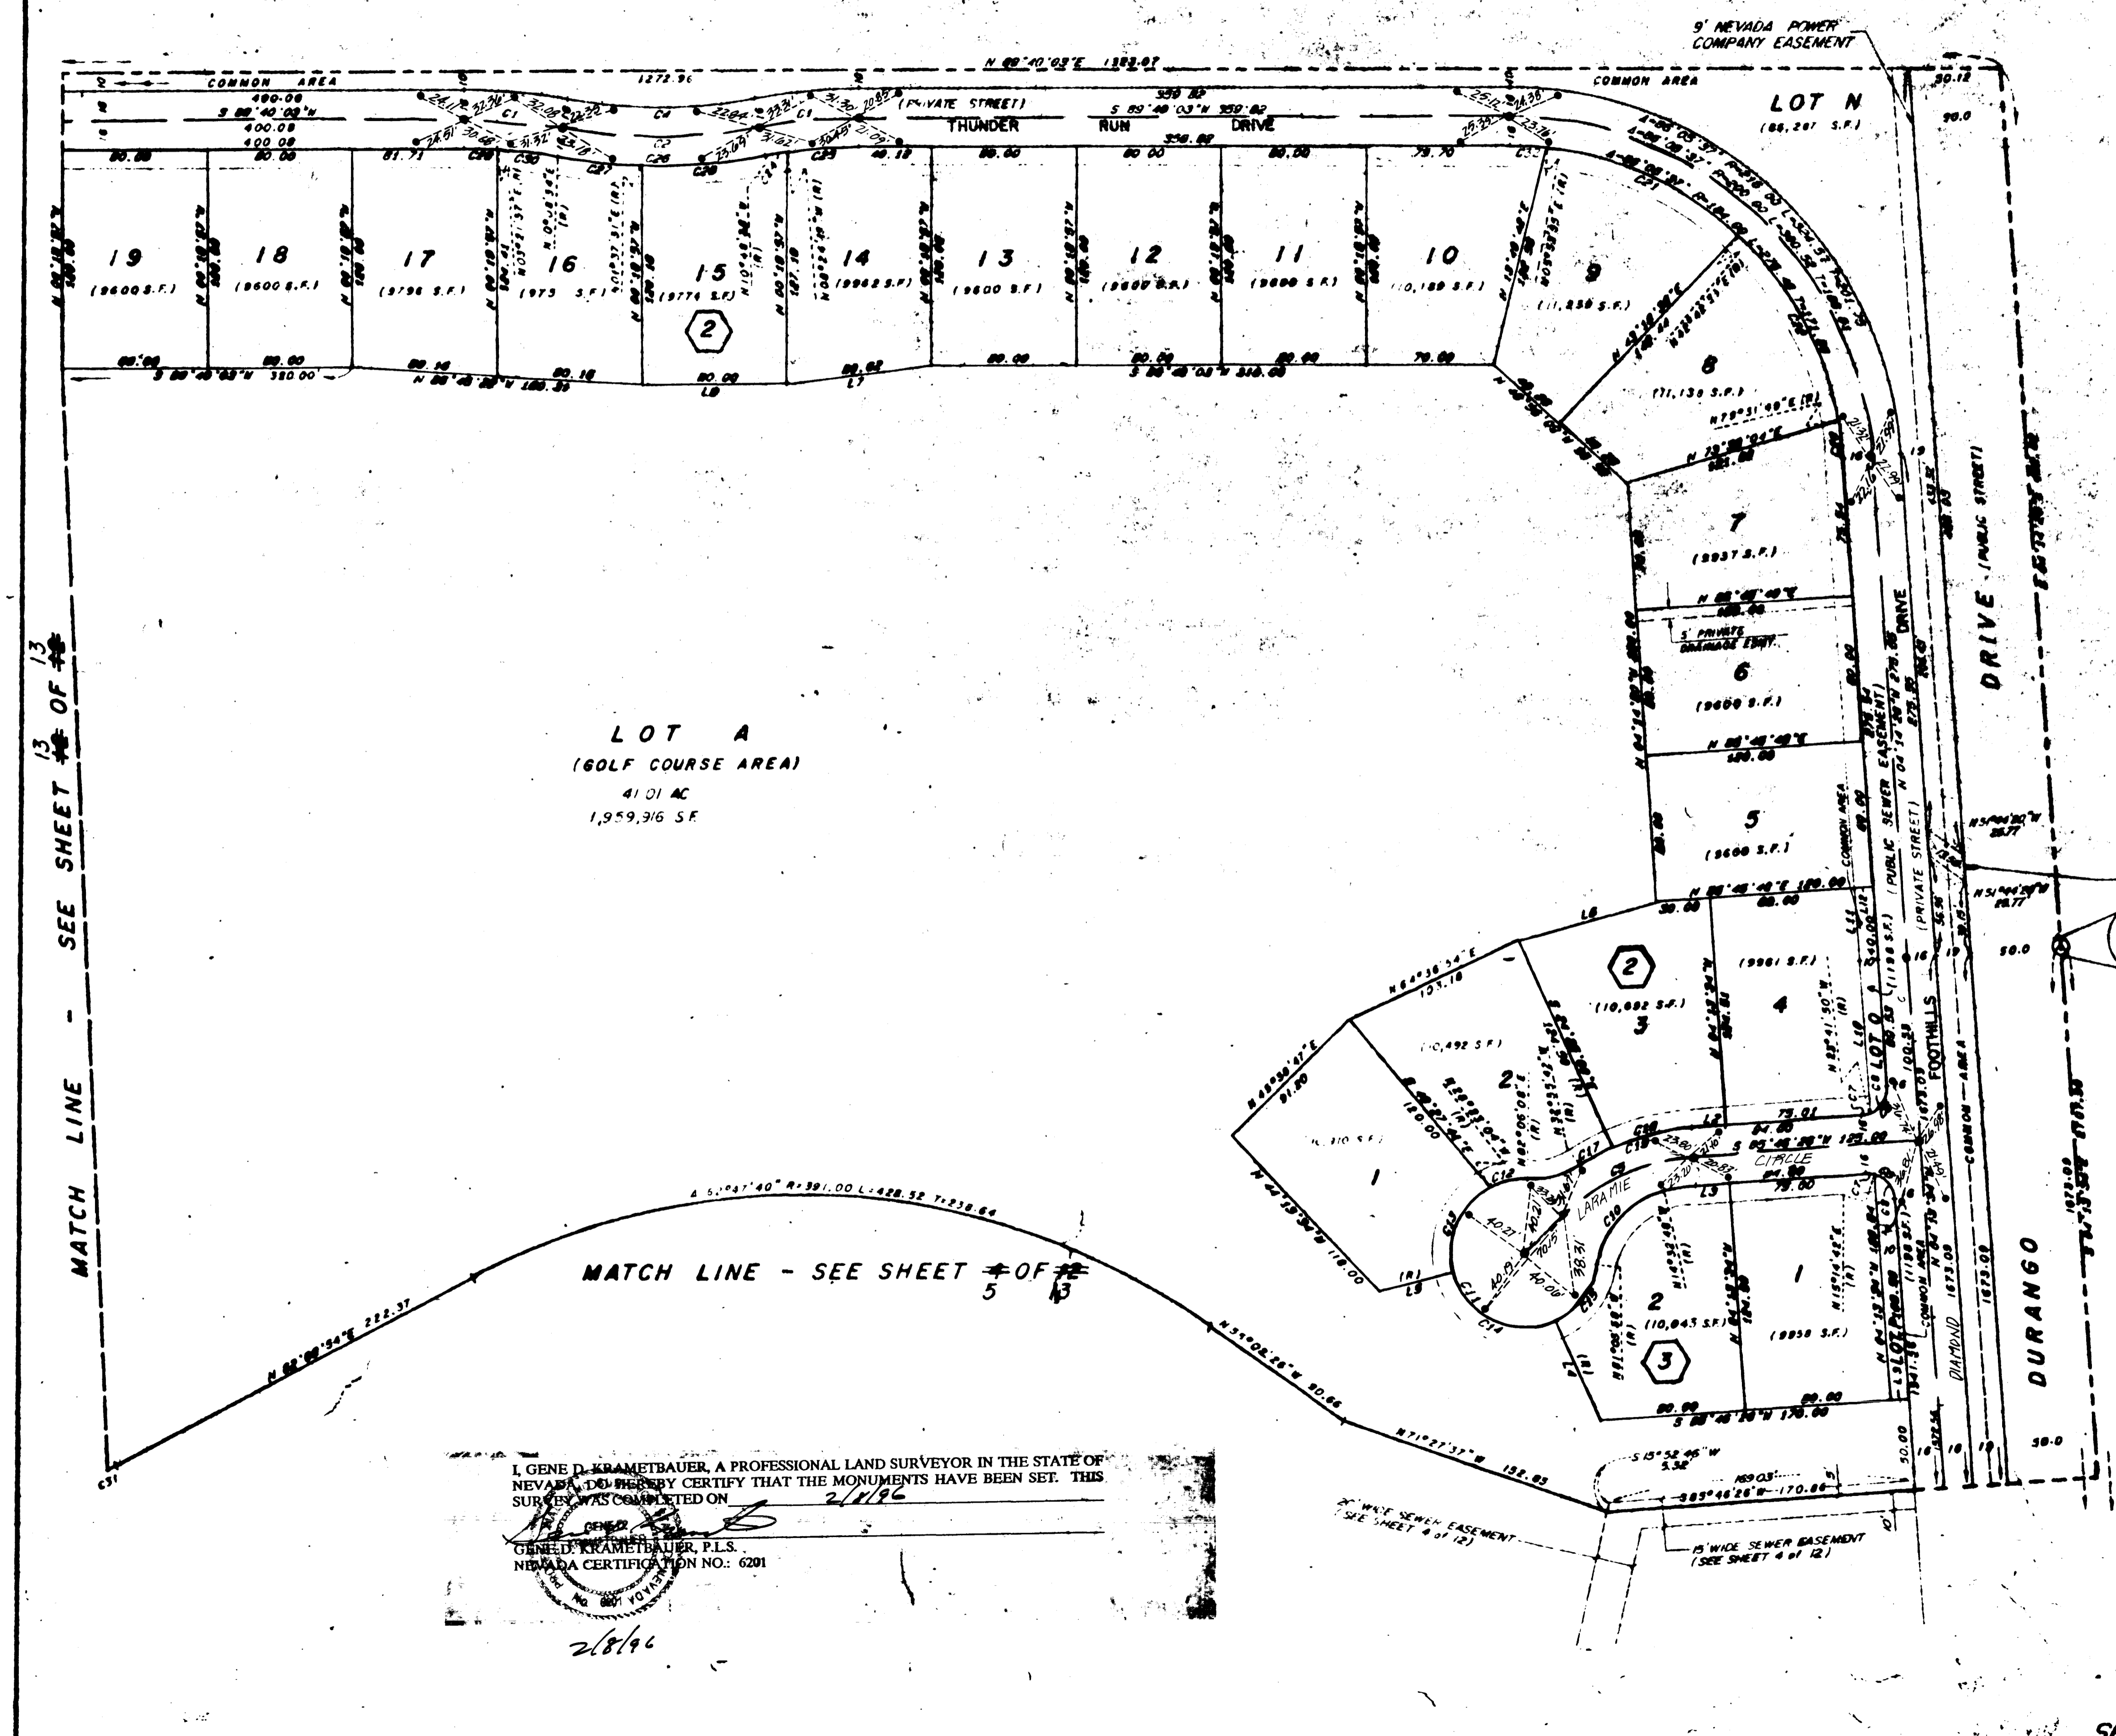

LINE	BEARING	DISTANCE
1	S 45° 46' 28" W	30.00
2	S 85° 46' 28" W	18.00
3	N 05° 46' 28" E	18.00
4	N 25° 04' 00" W (181)	80.43
5	S 75° 02' 33" W (181)	42.34
6	N 74° 18' 28" E	78.78
7	S 82° 32' 53" W	80.00
8	S 88° 40' 03" W	80.00
9	N 88° 48' 26" E	10.00
10	N 84° 13' 34" W	83.87
11	N 04° 14' 28" W	40.00
12	S 85° 48' 40" W	10.00
13	S 62° 54' 17" E	47.81


LOT A
(GOLF COURSE AREA)
41.01 AC
1,959,316 SF



MATCH LINE - SEE SHEET 13 OF 13

MATCH LINE - SEE SHEET 5 OF 13

I, GENE D. KRAMETBAUER, A PROFESSIONAL LAND SURVEYOR IN THE STATE OF NEVADA, DO HEREBY CERTIFY THAT THE MONUMENTS HAVE BEEN SET. THIS SURVEY WAS COMPLETED ON 2/18/96

GENE D. KRAMETBAUER, P.L.S.
NEVADA CERTIFICATION NO. 6201


2/8/96

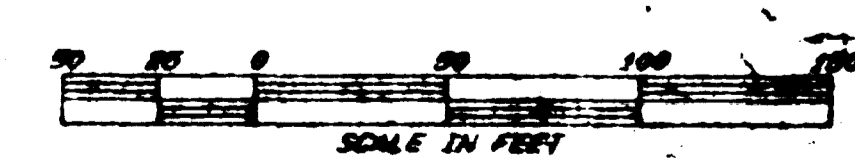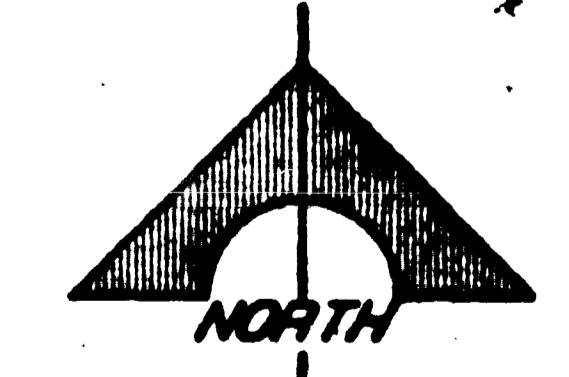

AMENDED PLAT OF
FOOTHILLS COUNTRY CLUB UNIT NO. 2
 MONUMENTATION TO MAP

08825

subdivisions

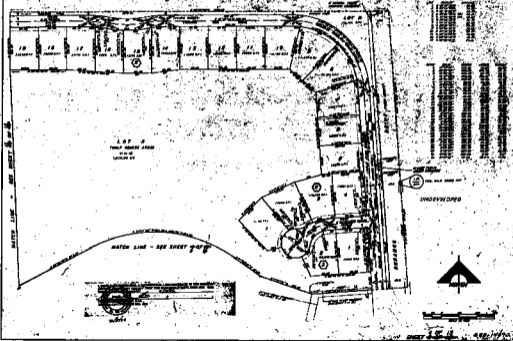

