


BOOK 190313
**AMENDED PLAT OF
 FOOTHILLS COUNTRY CLUB UNIT NO. 2**
 MONUMENTATION TIE MAP

00525


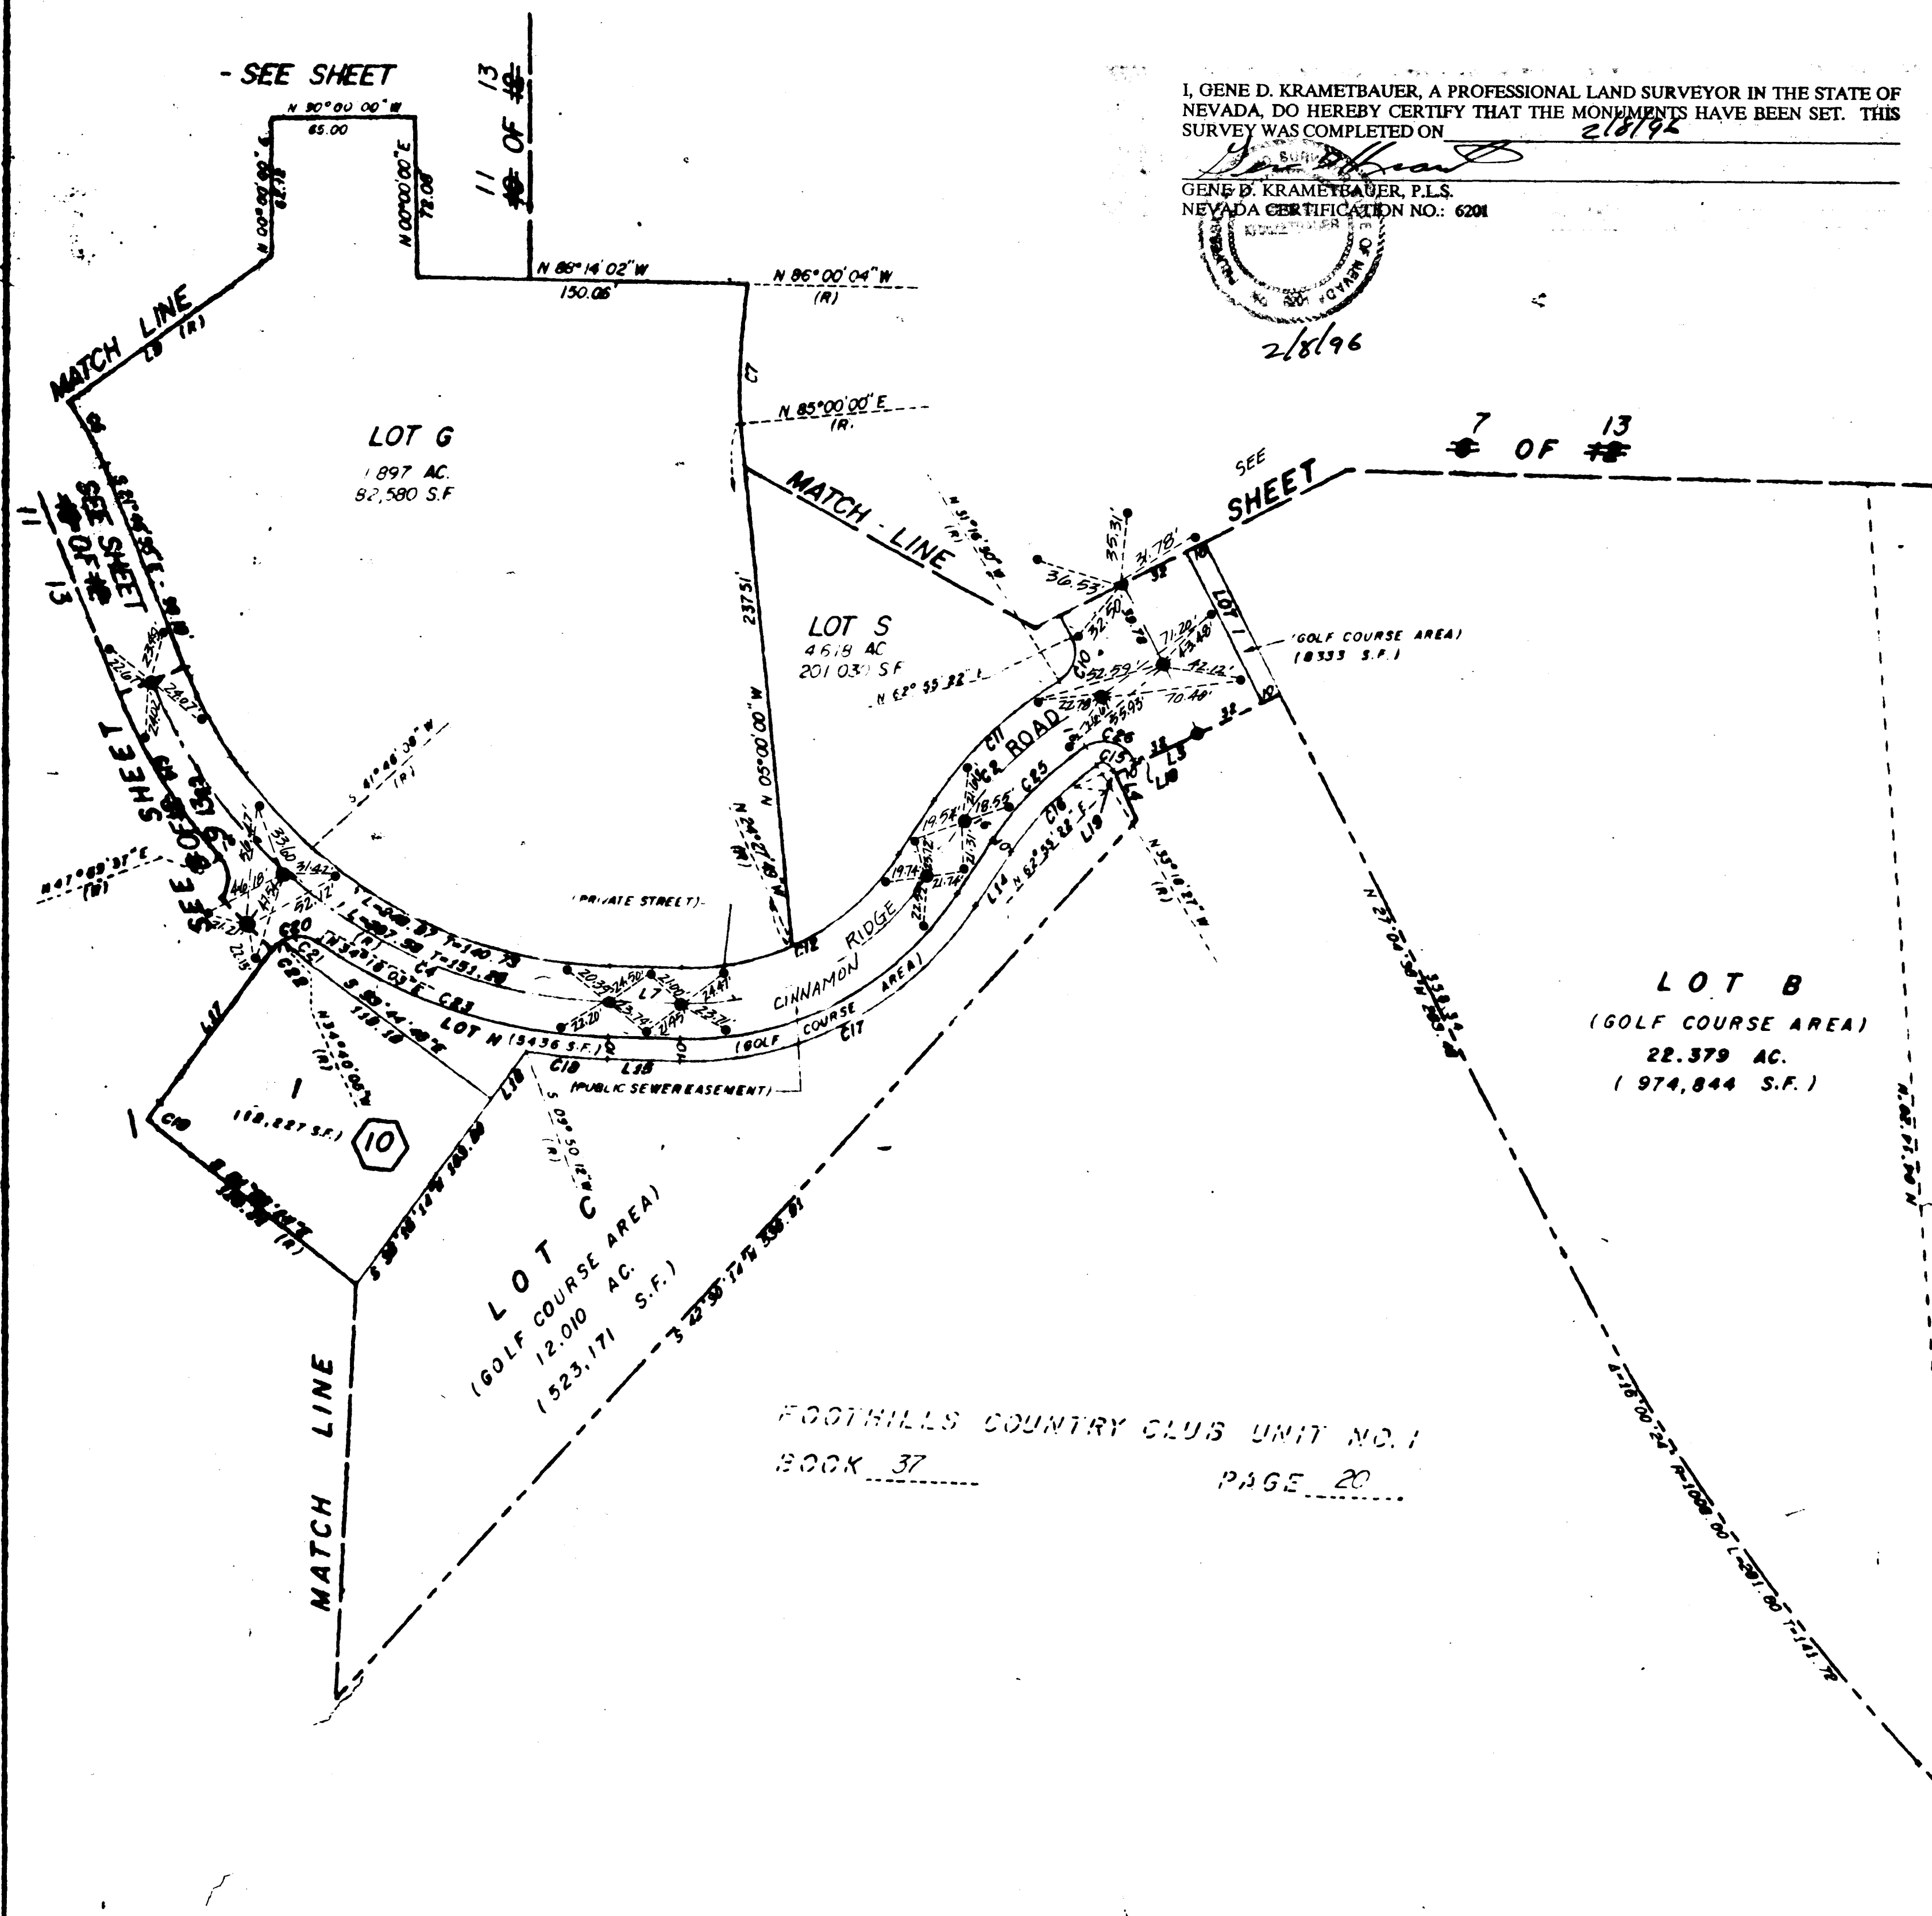


I, GENE D. KRAMETBAUER, A PROFESSIONAL LAND SURVEYOR IN THE STATE OF NEVADA, DO HEREBY CERTIFY THAT THE MONUMENTS HAVE BEEN SET. THIS SURVEY WAS COMPLETED ON 2/8/96

GENE D. KRAMETBAUER, P.L.S.
 NEVADA CERTIFICATION NO.: 6201

LINE	BEARING	DISTANCE
1	N 88° 01' 42" W	30.00
2	N 43° 05' 02" W	84.00
3	S 62° 55' 32" W	84.00
4	S 27° 04' 38" E	21.00
5	N 68° 00' 00" E	33.00
6	S 53° 29' 10" W	28.07
7	N 08° 28' 24" W	38.08
8	S 38° 15' 14" W	28.78
9	S 54° 16' 25" W (R)	113.48

CURVE	DELTA	RADIUS	LENGTH	TANGENT
1	6° 47' 48"	376.00	44.00	22.33
2	28° 28' 12"	140.00	48.00	12.00
3	58° 04' 00"	130.00	131.77	72.17
4	40° 12' 38"	250.00	181.41	64.10
5	28° 28' 57"	250.00	100.17	64.08
6	15° 56' 40"	136.00	33.10	16.63
7	08° 28' 38"	383.00	62.07	30.30
8	04° 47' 48"	15.00	88.40	13.04
9	05° 14' 00"	178.00	77.81	39.30
10	58° 04' 28"	114.00	118.88	63.88

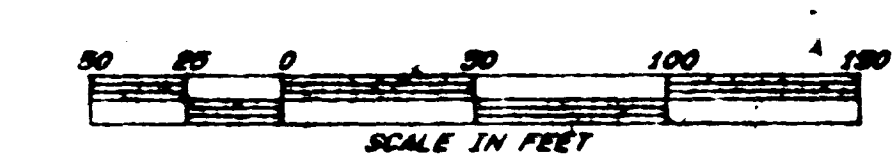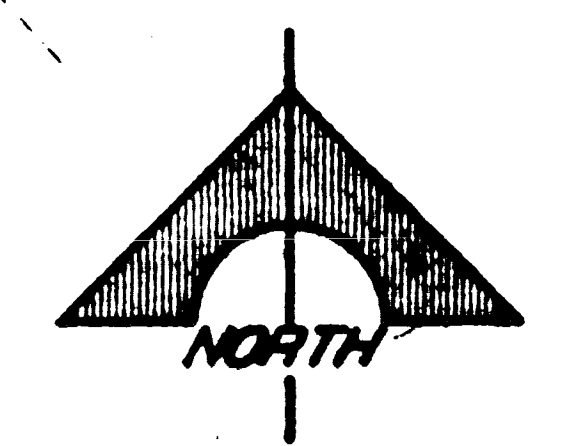

2nd 1935

AMENDED PLAT OF FOOTHILLS COUNTRY CLUB UNIT NO. 2 MONUMENTATION THE MAP

00585

