


Book P90313

AMENDED PLAT OF FOOTHILLS COUNTRY CLUB UNIT NO. 2

00525

MONUMENTATION TIE MAP

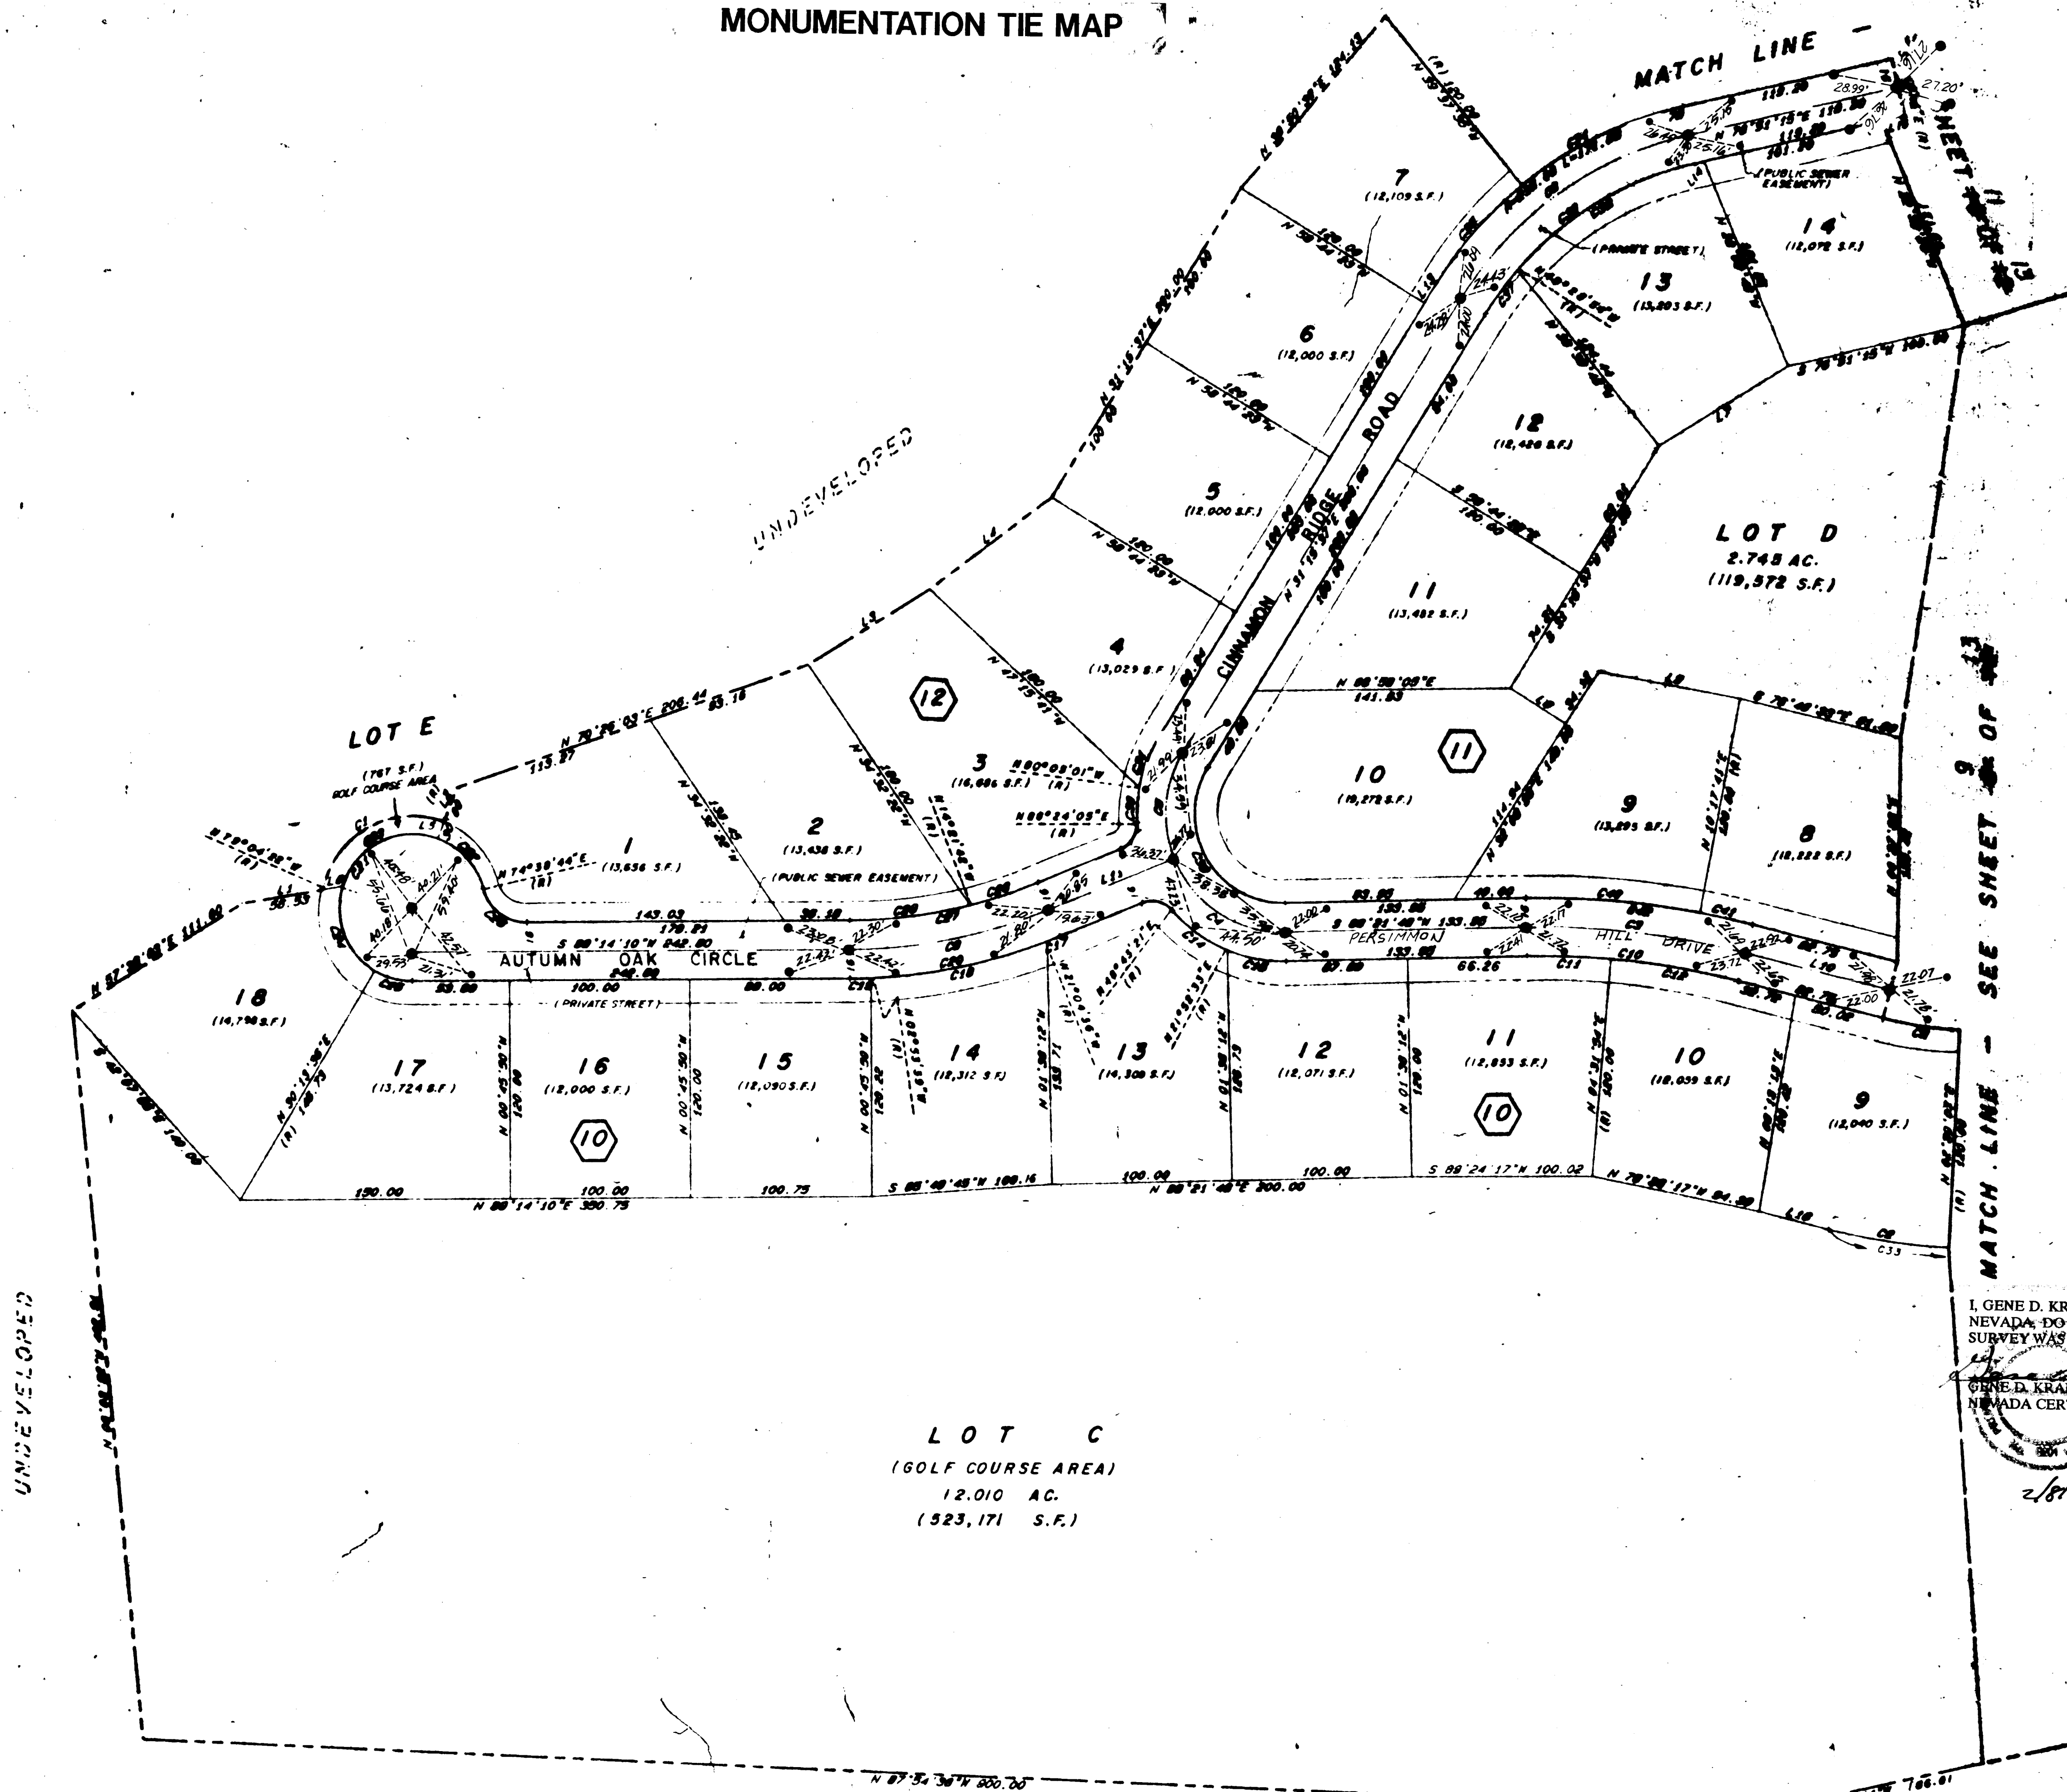


LINE	BEARING	DISTANCE
1	N 79° 50' 53" E	48.00
2	N 20° 00' 00" E	20.00
3	N 87° 50' 00" E	70.00
4	N 52° 50' 30" E	64.00
5	N 20° 00' 00" E (R)	10.00
6	N 79° 50' 53" E	10.00
7	S 89° 03' 00" W	84.00
8	S 57° 30' 30" E	50.00
9	S 79° 48' 18" W	70.00
10	N 79° 50' 53" W	60.00
11	S 67° 55' 43" W (R)	70.00
12	N 60° 45' 50" W	84.00
13	S 31° 15' 37" W	10.00
14	N 79° 51' 18" E	0.00
15	N 79° 51' 18" W	30.00
16	N 79° 50' 53" W	30.00


I, GENE D. KRAMETBAUER, A PROFESSIONAL LAND SURVEYOR IN THE STATE OF NEVADA, DO HEREBY CERTIFY THAT THE MONUMENTS HAVE BEEN SET. THIS SURVEY WAS COMPLETED ON 2/8/96

GENE D. KRAMETBAUER, P.L.S.
NEVADA CERTIFICATION NO. 6201

2/8/96

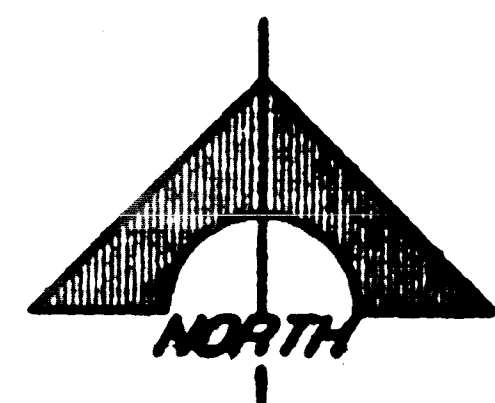

LOT C
(GOLF COURSE AREA)
12.010 AC.
(523,171 S.F.)

