

2007 11 30

AMENDED PLAT OF FOOTHILLS COUNTRY CLUB UNIT NO. 2 MONUMENTATION TIE MAP


00525

I, GENE D. KRAMETBAUER, A PROFESSIONAL LAND SURVEYOR IN THE STATE OF NEVADA, DO HEREBY CERTIFY THAT THE MONUMENTS HAVE BEEN SET. THE SURVEY WAS COMPLETED ON 2/1/94.
GENE D. KRAMETBAUER, P.L.S.
NEVADA CERTIFICATION NO. 6201



2/1/94

LINE	BEARING	DISTANCE
1	N 81° 20' 32" E	87.00
2	N 81° 20' 32" E	80.00
3	S 20° 30' 07" E	18.00
4	S 20° 30' 07" E	18.00
5	S 20° 30' 07" E	18.00

CURVE	BEARING	RADIUS	LENGTH	TANGENT
1	14° 20' 08"	300.00	77.00	39.06
2	20° 40' 12"	300.00	100.35	79.48
3	14° 20' 08"	318.00	81.88	41.14
4	20° 40' 12"	288.00	147.07	75.26
5	14° 20' 08"	288.00	73.57	38.87
6	0° 00' 00"	284.00	38.54	20.00
7	6° 46' 38"	294.00	33.59	15.81
8	20° 40' 12"	318.00	163.64	83.70
9	7° 24' 30"	318.00	41.82	20.44
10	14° 20' 08"	318.00	80.82	40.32
11	7° 24' 30"	318.00	41.80	20.83
12	0° 00' 00"	284.00	33.51	18.88
13	0° 00' 00"	284.00	33.72	19.88

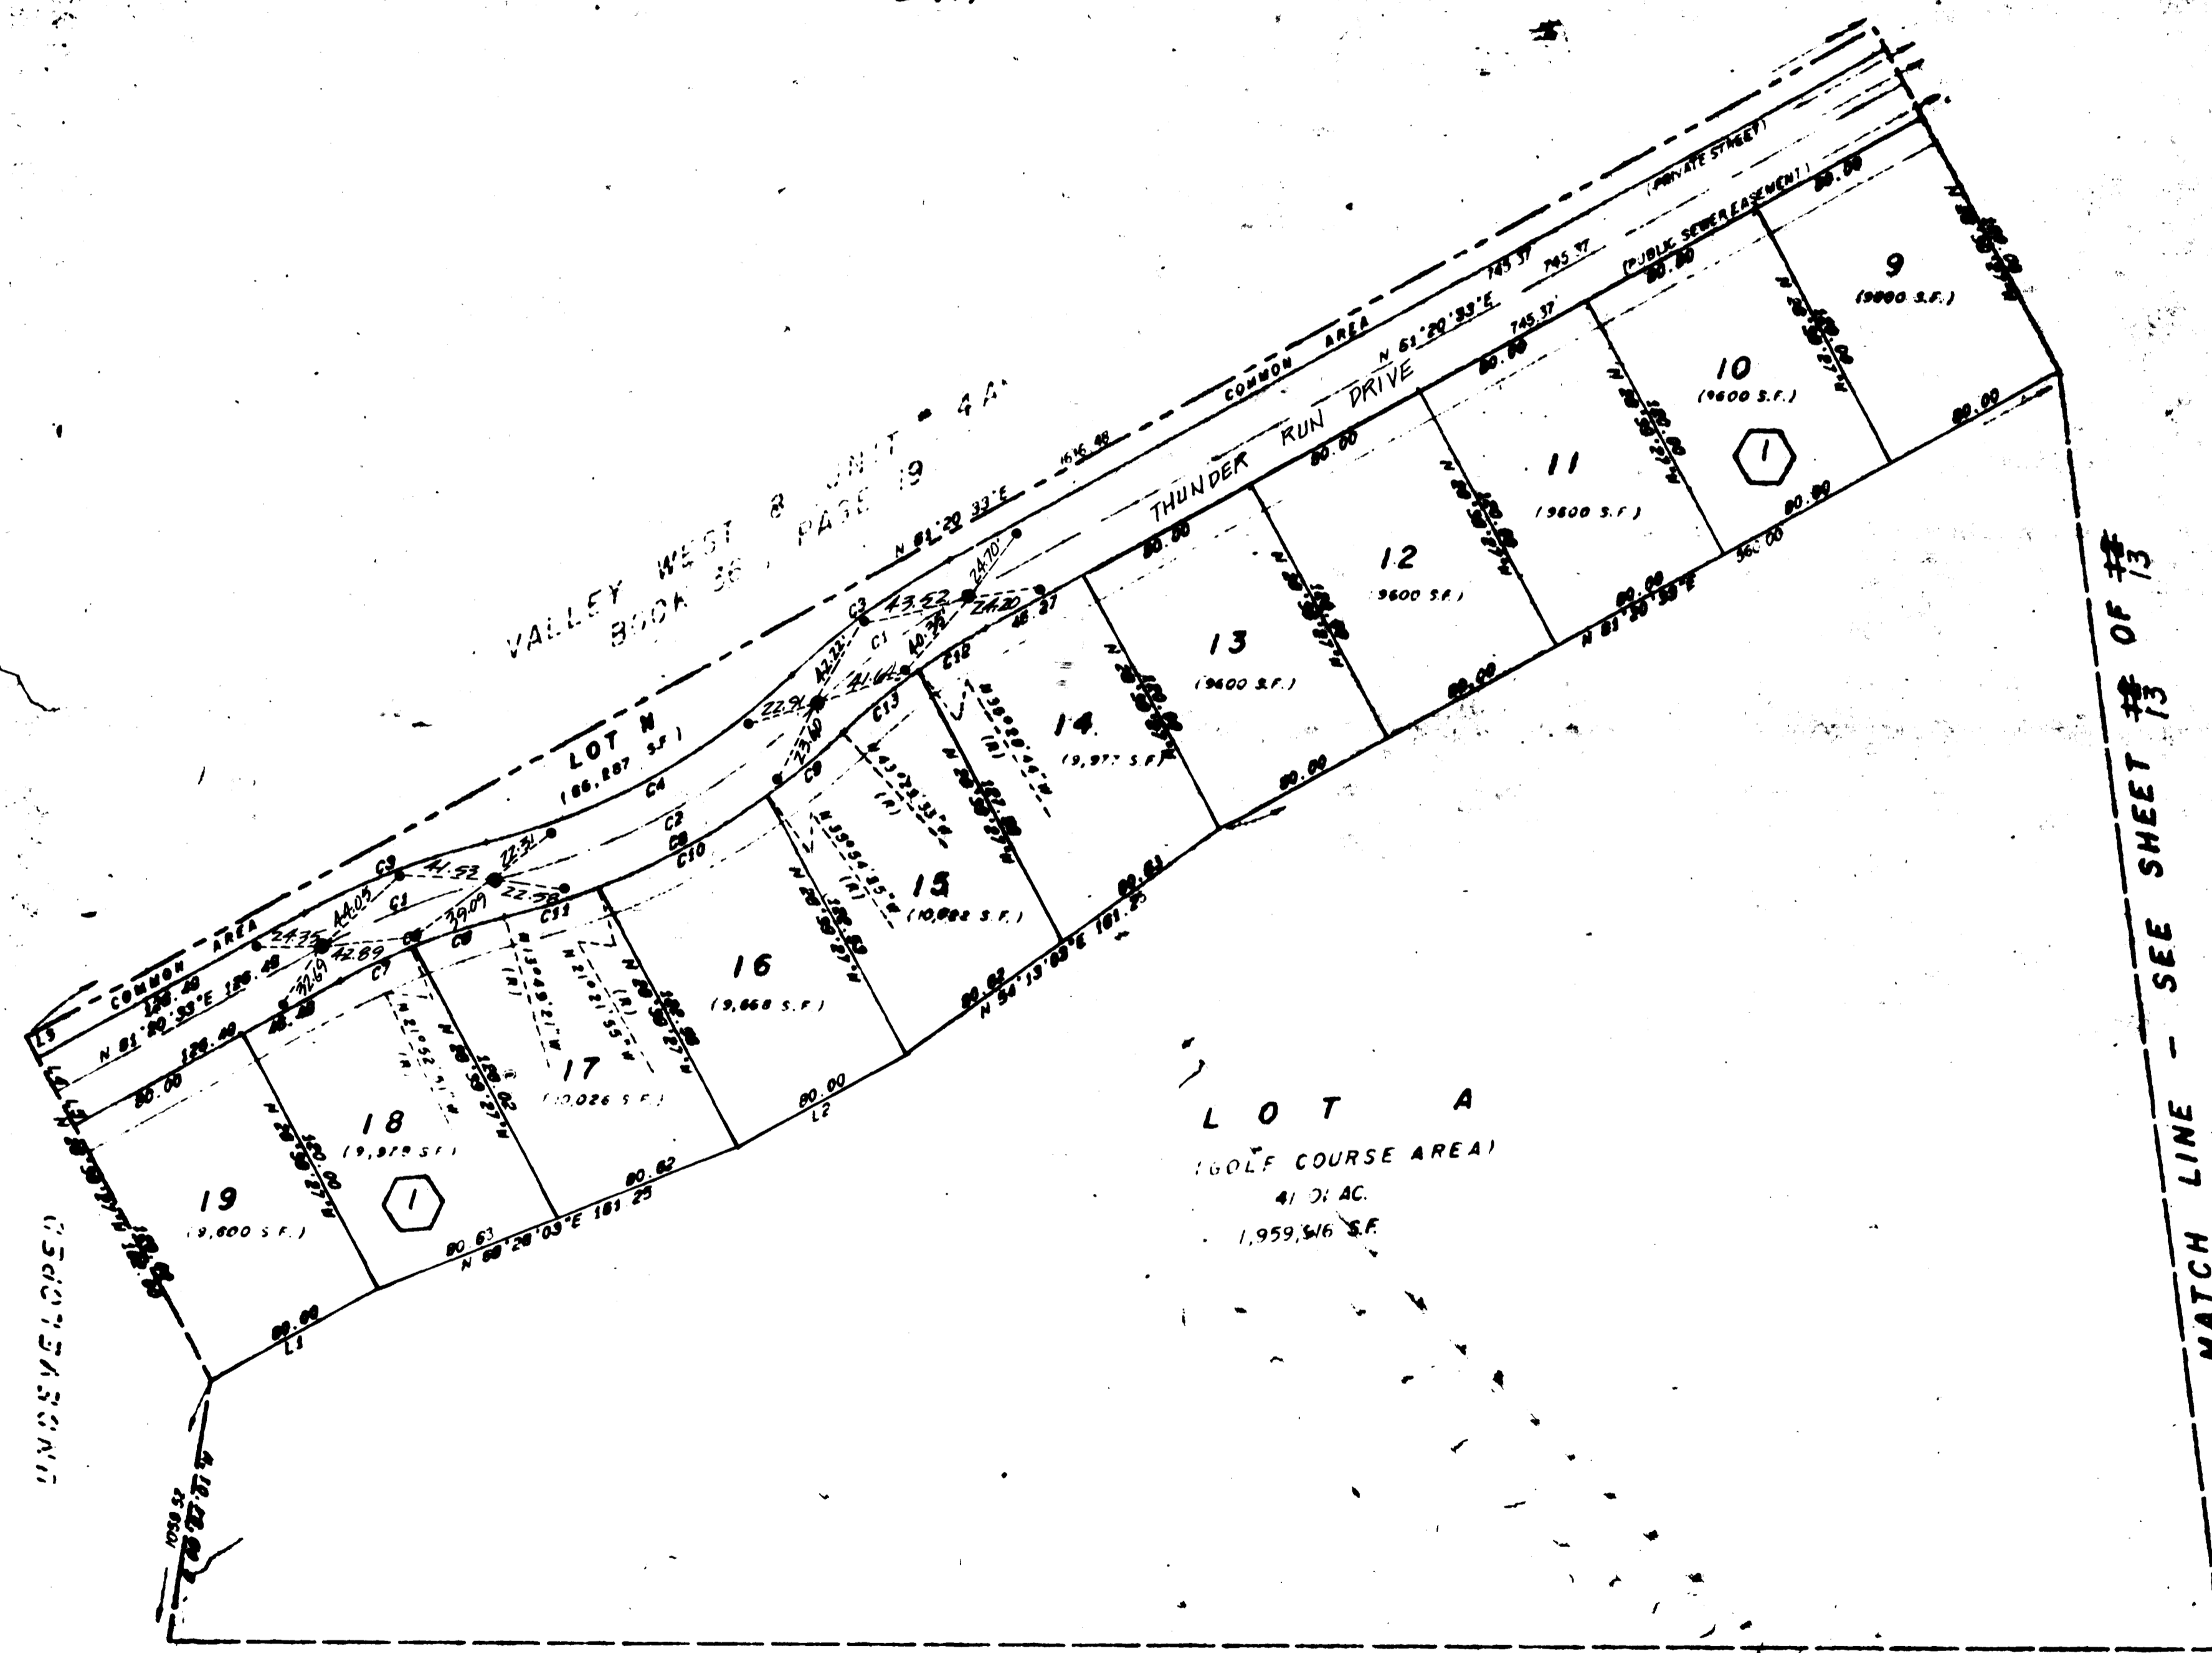


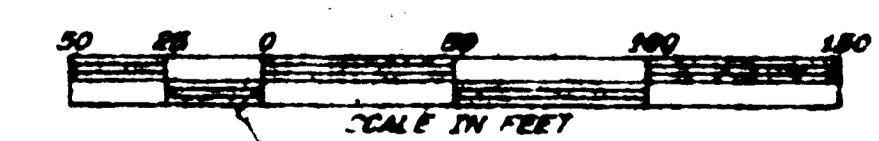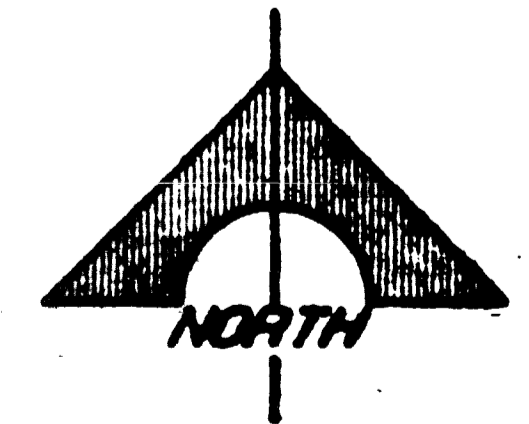

12 OF 13
SHEET #1 OF #13

2599

Book 43 Page 4

Book 37 Page 37
058-1407-2

