


8005 870313

# AMENDED PLAT OF FOOTHILLS COUNTRY CLUB UNIT NO. 2 MONUMENTATION TIE MAP

00525

MATCH LINE - SEE SHEET 4 OF 13

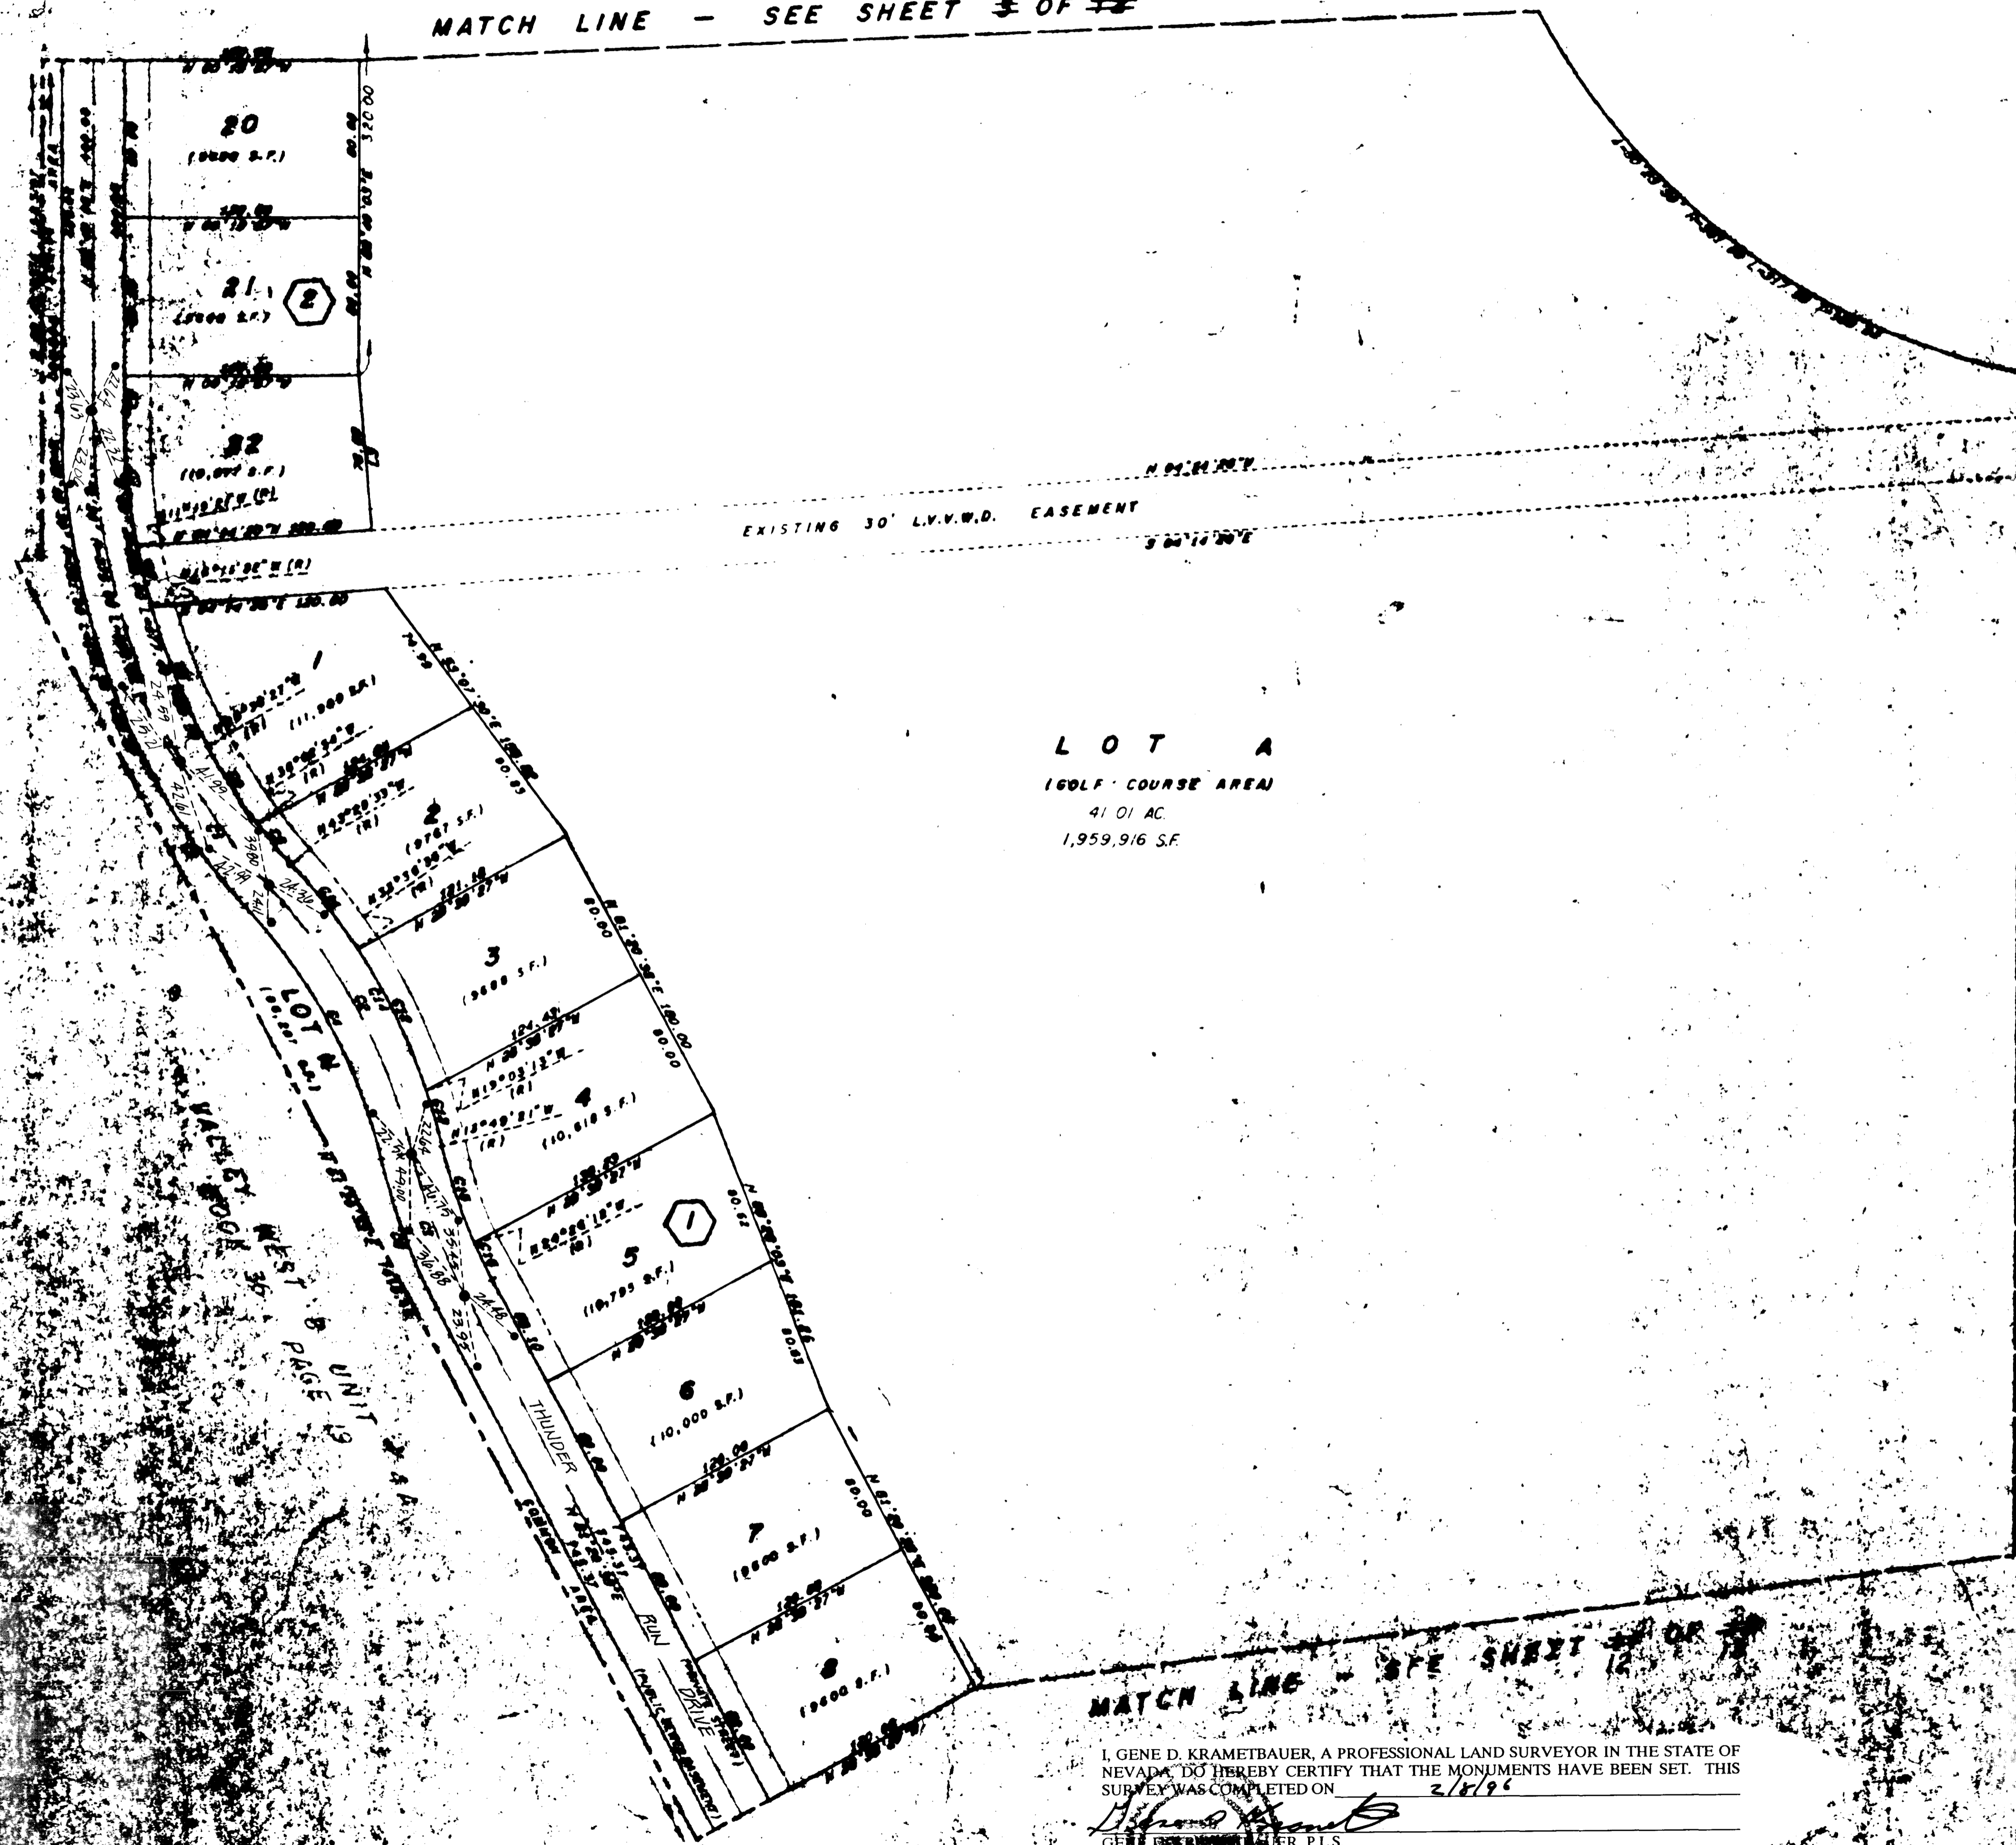

LINE	BEARING	DISTANCE
1	S 04°14'30"W	13.77
2	N 89°40'00"E	18.37
3	N 89°08'00"E	79.89

**LOT A**  
 (GOLF COURSE AREA)  
 41.01 AC  
 1,959,916 S.F.

MATCH LINE - SEE SHEET 12 OF 13


I, GENE D. KRAMETBAUER, A PROFESSIONAL LAND SURVEYOR IN THE STATE OF NEVADA, DO HEREBY CERTIFY THAT THE MONUMENTS HAVE BEEN SET. THIS SURVEY WAS COMPLETED ON 2/1/96

*Gene D. Krametbauer*  
 GENE D. KRAMETBAUER, P.L.S.  
 NEVADA CERTIFICATION NO. 6201

Sheet 13 of 13  
 056-1407

AMENDED PLAT OF  
**FOOTHILLS COUNTRY CLUB UNIT NO. 2**  
MONUMENTATION THE MAP


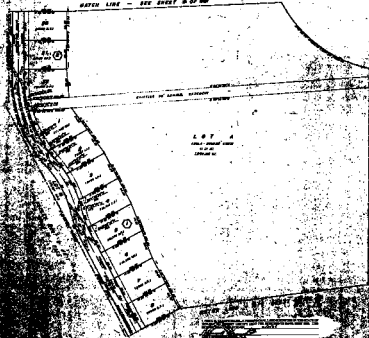


