

BOOK 891025
 Book 891025

009
 009

AMENDED PLAT OF FOOTHILLS COUNTRY CLUB UNIT NO. 3

A PORTION OF SECTION 5, T 21 N, R 60 E, M 8 W
 CITY OF LAS VEGAS, CLARK COUNTY, NEVADA

LEGEND

- ⊙ BLOCK NUMBER
- C# CURVE NUMBER
- Ⓛ LOT NUMBER
- SUBDIVISION BOUNDARY
- FND. MON. AS SHOWN
- SET TYPE III MONUMENT - AL CAP
 P.L.S. 6201" W/ BRASS CAP
 REF TIES SET IN T.O.C. UNLESS
 OTHERWISE NOTED.


MONUMENTATION TIE MAP

I, GENE D. KRAMETBAUER, A PROFESSIONAL LAND SURVEYOR IN THE STATE OF NEVADA, DO HEREBY CERTIFY THAT THE MONUMENTS HAVE BEEN SET. THIS SURVEY WAS COMPLETED ON 2/21/96

Gene D. Krametbauer, F.L.S.
 NEVADA CERTIFICATION NO.: 6201

2/21/96 LOT A

721
 848,324 S.F.
 19,400 AC
 484

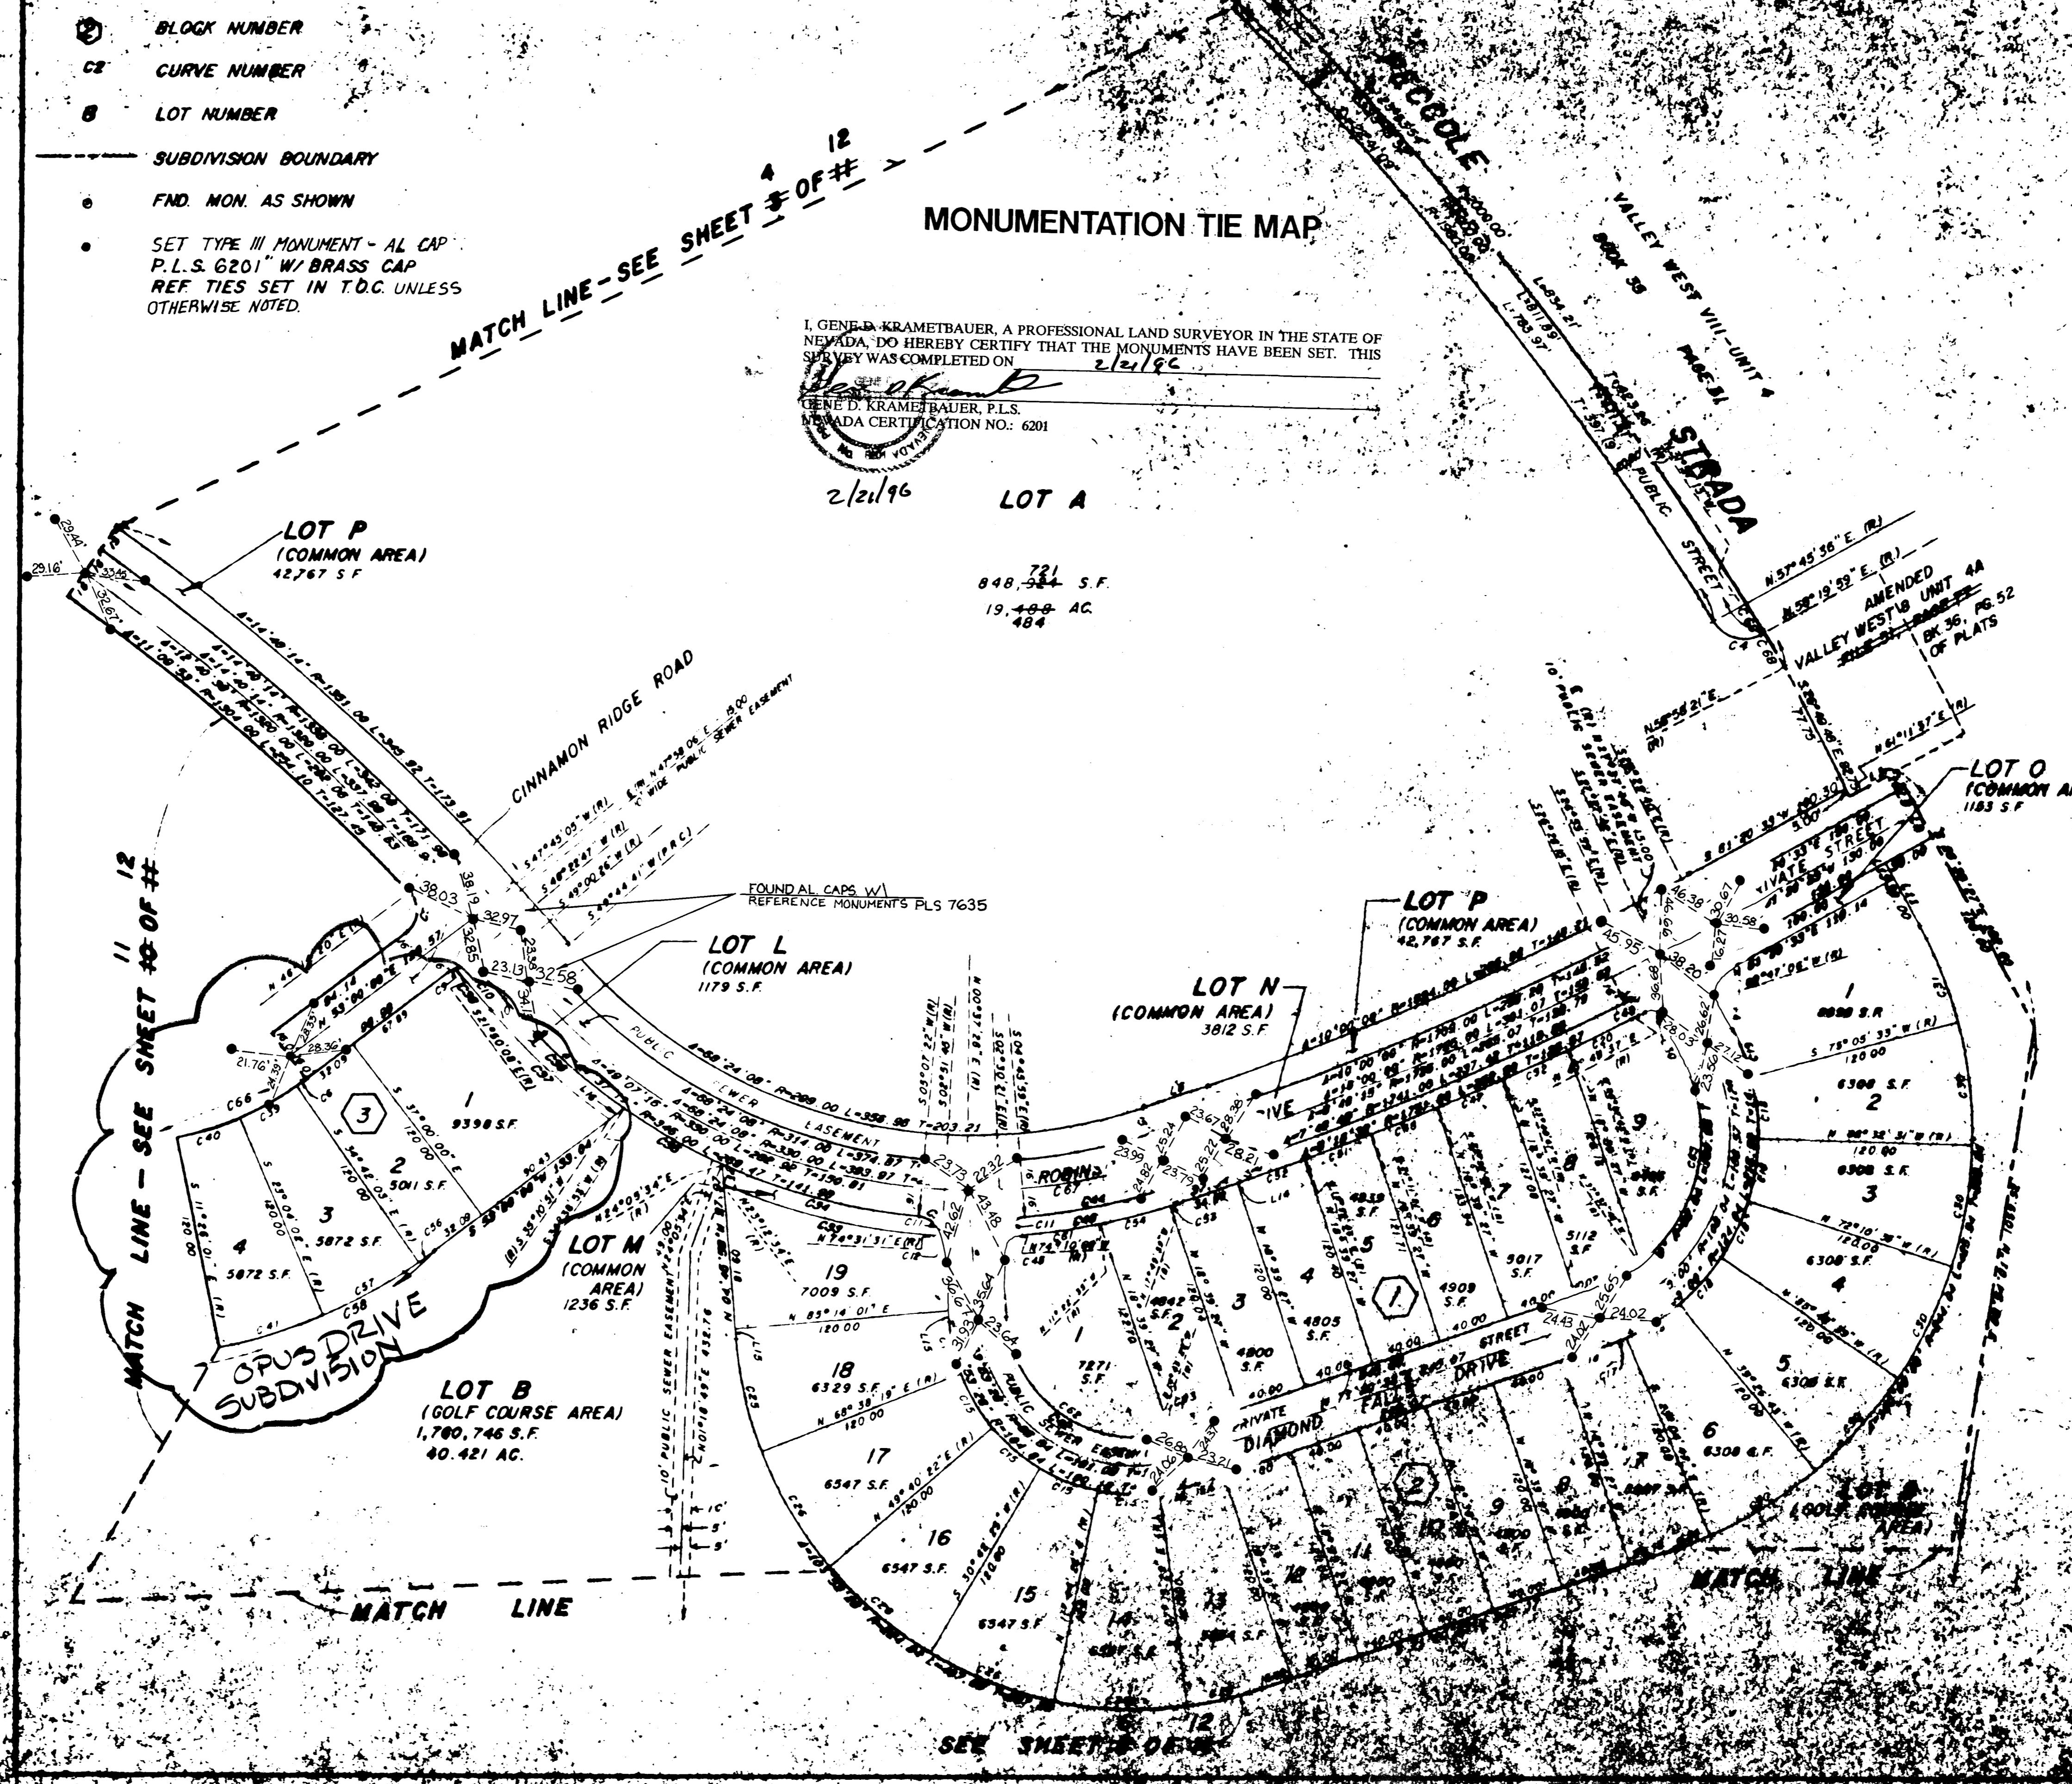

LINE	BEARING	DISTANCE
1	N 81° 28' 28" W	29.87
2	S 73° 28' 28" W	37.80
3	S 04° 45' 00" E	79.48
4	N 24° 30' 28" W	80.38
5	S 71° 20' 50" E	27.54
6	N 71° 20' 50" E	37.54
7	N 20° 30' 27" W	16.00
8	N 20° 30' 27" W	16.00
9	N 20° 30' 27" W	16.00
10	N 20° 30' 27" W	16.00
11	S 04° 45' 00" E	40.88
12	S 04° 45' 00" E	11.27
13	N 20° 30' 27" W	16.00
14	S 71° 20' 50" E	27.54
15	N 24° 30' 28" W	80.38
16	N 81° 28' 28" W	29.87

CURVE	DELTA	CHORDS	LENGTH	TANGENT
1	1° 11' 48"	1725.00	30.00	18.00
2	1° 39' 37"	1360.00	40.00	20.00
3	2° 15' 37"	2020.00	50.00	25.00
4	06° 24' 55"	20.00	30.17	15.75
5	06° 48' 40"	15.00	40.33	18.00
6	2° 17' 57"	181.00	7.26	3.43
7	00° 00' 20"	15.00	20.00	13.00
8	0° 44' 13"	1304.00	30.70	8.30
9	15° 05' 58"	15.00	3.87	2.00
10	70° 50' 34"	15.00	18.25	18.87
11	60° 24' 00"	15.00	18.17	10.30
12	10° 42' 30"	15.00	2.80	1.41
13	80° 00' 30"	15.00	20.87	12.81
14	10° 44' 42"	104.84	30.39	15.23
15	10° 37' 87"	104.84	34.70	17.51
16	11° 25' 58"	104.84	20.82	10.49
17	4° 25' 20"	124.04	8.57	4.78
18	16° 21' 58"	124.04	25.43	17.84
19	13° 45' 00"	124.04	28.77	14.86
20	11° 48' 11"	174.00	25.18	27.57
21	30° 36' 42"	35.00	20.00	15.00
22	07° 08' 42"	1791.00	4.00	2.40
23	70° 45' 18"	15.00	18.51	10.84
24	18° 20' 30"	15.00	8.89	2.57
25	18° 35' 37"	224.84	65.12	32.78
26	01° 57' 57"	224.84	37.84	37.84
27	09° 42' 48"	20.00	31.18	19.90
28	11° 25' 58"	224.84	44.84	22.81
29	4° 25' 20"	224.84	19.84	9.40
30	16° 21' 58"	244.04	48.71	33.00
31	13° 45' 00"	244.04	58.57	39.40
32	11° 48' 11"	174.00	40.20	20.10
33	20° 20' 40"	320.00	126.40	63.00
34	18° 58' 18"	340.00	124.50	67.00
35	10° 30' 18"	340.00	63.74	31.80
36	13° 05' 40"	340.00	81.17	40.00
37	14° 53' 28"	320.00	80.38	40.00
38	1° 21' 54"	1204.00	60.00	42.00
39	11° 38' 01"	181.00	36.75	18.44
40	11° 38' 01"	181.00	36.75	18.44
41	11° 38' 01"	301.00	81.12	30.86
42	103° 50' 00"	72.84	130.00	63.00
43	02° 00' 00"	15.00	25.00	15.00
44	13° 53' 20"	340.00	83.00	42.25
45	20° 35' 51"	15.00	5.30	2.73
46	18° 08' 04"	320.00	100.30	50.31
47	14° 18' 41"	1751.00	40.13	20.06
48	14° 18' 41"	1751.00	40.06	20.06
49	70° 17' 50"	15.00	18.40	14.40
50	17° 30' 50"	15.00	4.30	2.31
51	1° 18' 35"	1751.00	40.03	20.01
52	14° 13' 18"	1751.00	37.34	18.87
53	01° 49' 20"	350.00	9.12	2.56
54	11° 45' 24"	350.00	40.12	20.08
55	07° 40' 40"	18.00	20.00	14.44
56	2° 17' 57"	301.00	12.08	6.04
57	1° 38' 01"	301.00	61.12	30.86
58	64° 00' 00"	301.00	339.22	188.00
59	01° 01' 47"	1709.00	30.71	18.76
60	01° 01' 47"	1694.00	30.44	18.22
61	8° 52' 14"	356.00	53.12	27.61
62	39° 47' 23"	72.84	127.07	64.74
63	3° 36' 03"	72.84	5.00	2.50
64	10° 18' 16"	92.84	30.40	15.38
65	81° 01' 44"	92.84	130.16	70.83
66	84° 00' 00"	181.00	308.00	113.10
67	13° 16' 53"	330.00	111.83	56.08
68	00° 00' 00"	2000.00	22.32	11.16


058-1401-3

2611




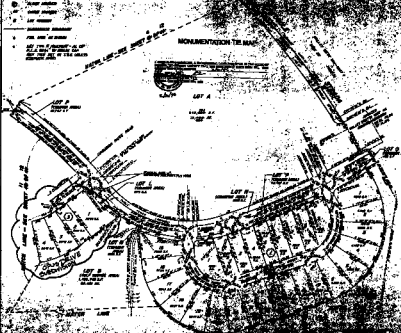

MONUMENTATION TABLE



