

BOOK 891025
 Book 891025

00916
 00916

AMENDED PLAT OF FOOTHILLS COUNTRY CLUB UNIT NO. 3

A PORTION OF SECTION 5, T. 21 S., R. 60 E., M. D. M.,
 CITY OF LAS VEGAS, CLARK COUNTY, NEVADA


MATCH LINE - SEE SHEET 8 OF 12
 MONUMENTATION TIE MAP

I, GENE D. KRAMETBAUER, A PROFESSIONAL LAND SURVEYOR IN THE STATE OF NEVADA, DO HEREBY CERTIFY THAT THE MONUMENTS HAVE BEEN SET. THIS SURVEY WAS COMPLETED ON 2/21/96

Gene D. Krametbauer, P.L.S.
 NEVADA CERTIFICATION NO. 6201



LEGEND

- ⊙ BLOCK NUMBER
- CE CURVE NUMBER
- 6 LOT NUMBER
- SUBDIVISION BOUNDARY
- FND. MON. AS SHOWN
- SET TYPE III MONUMENT - AL. CAP. P.L.S. 6201 W/ BRASS CAP REF. TIES SET IN T.O.C.

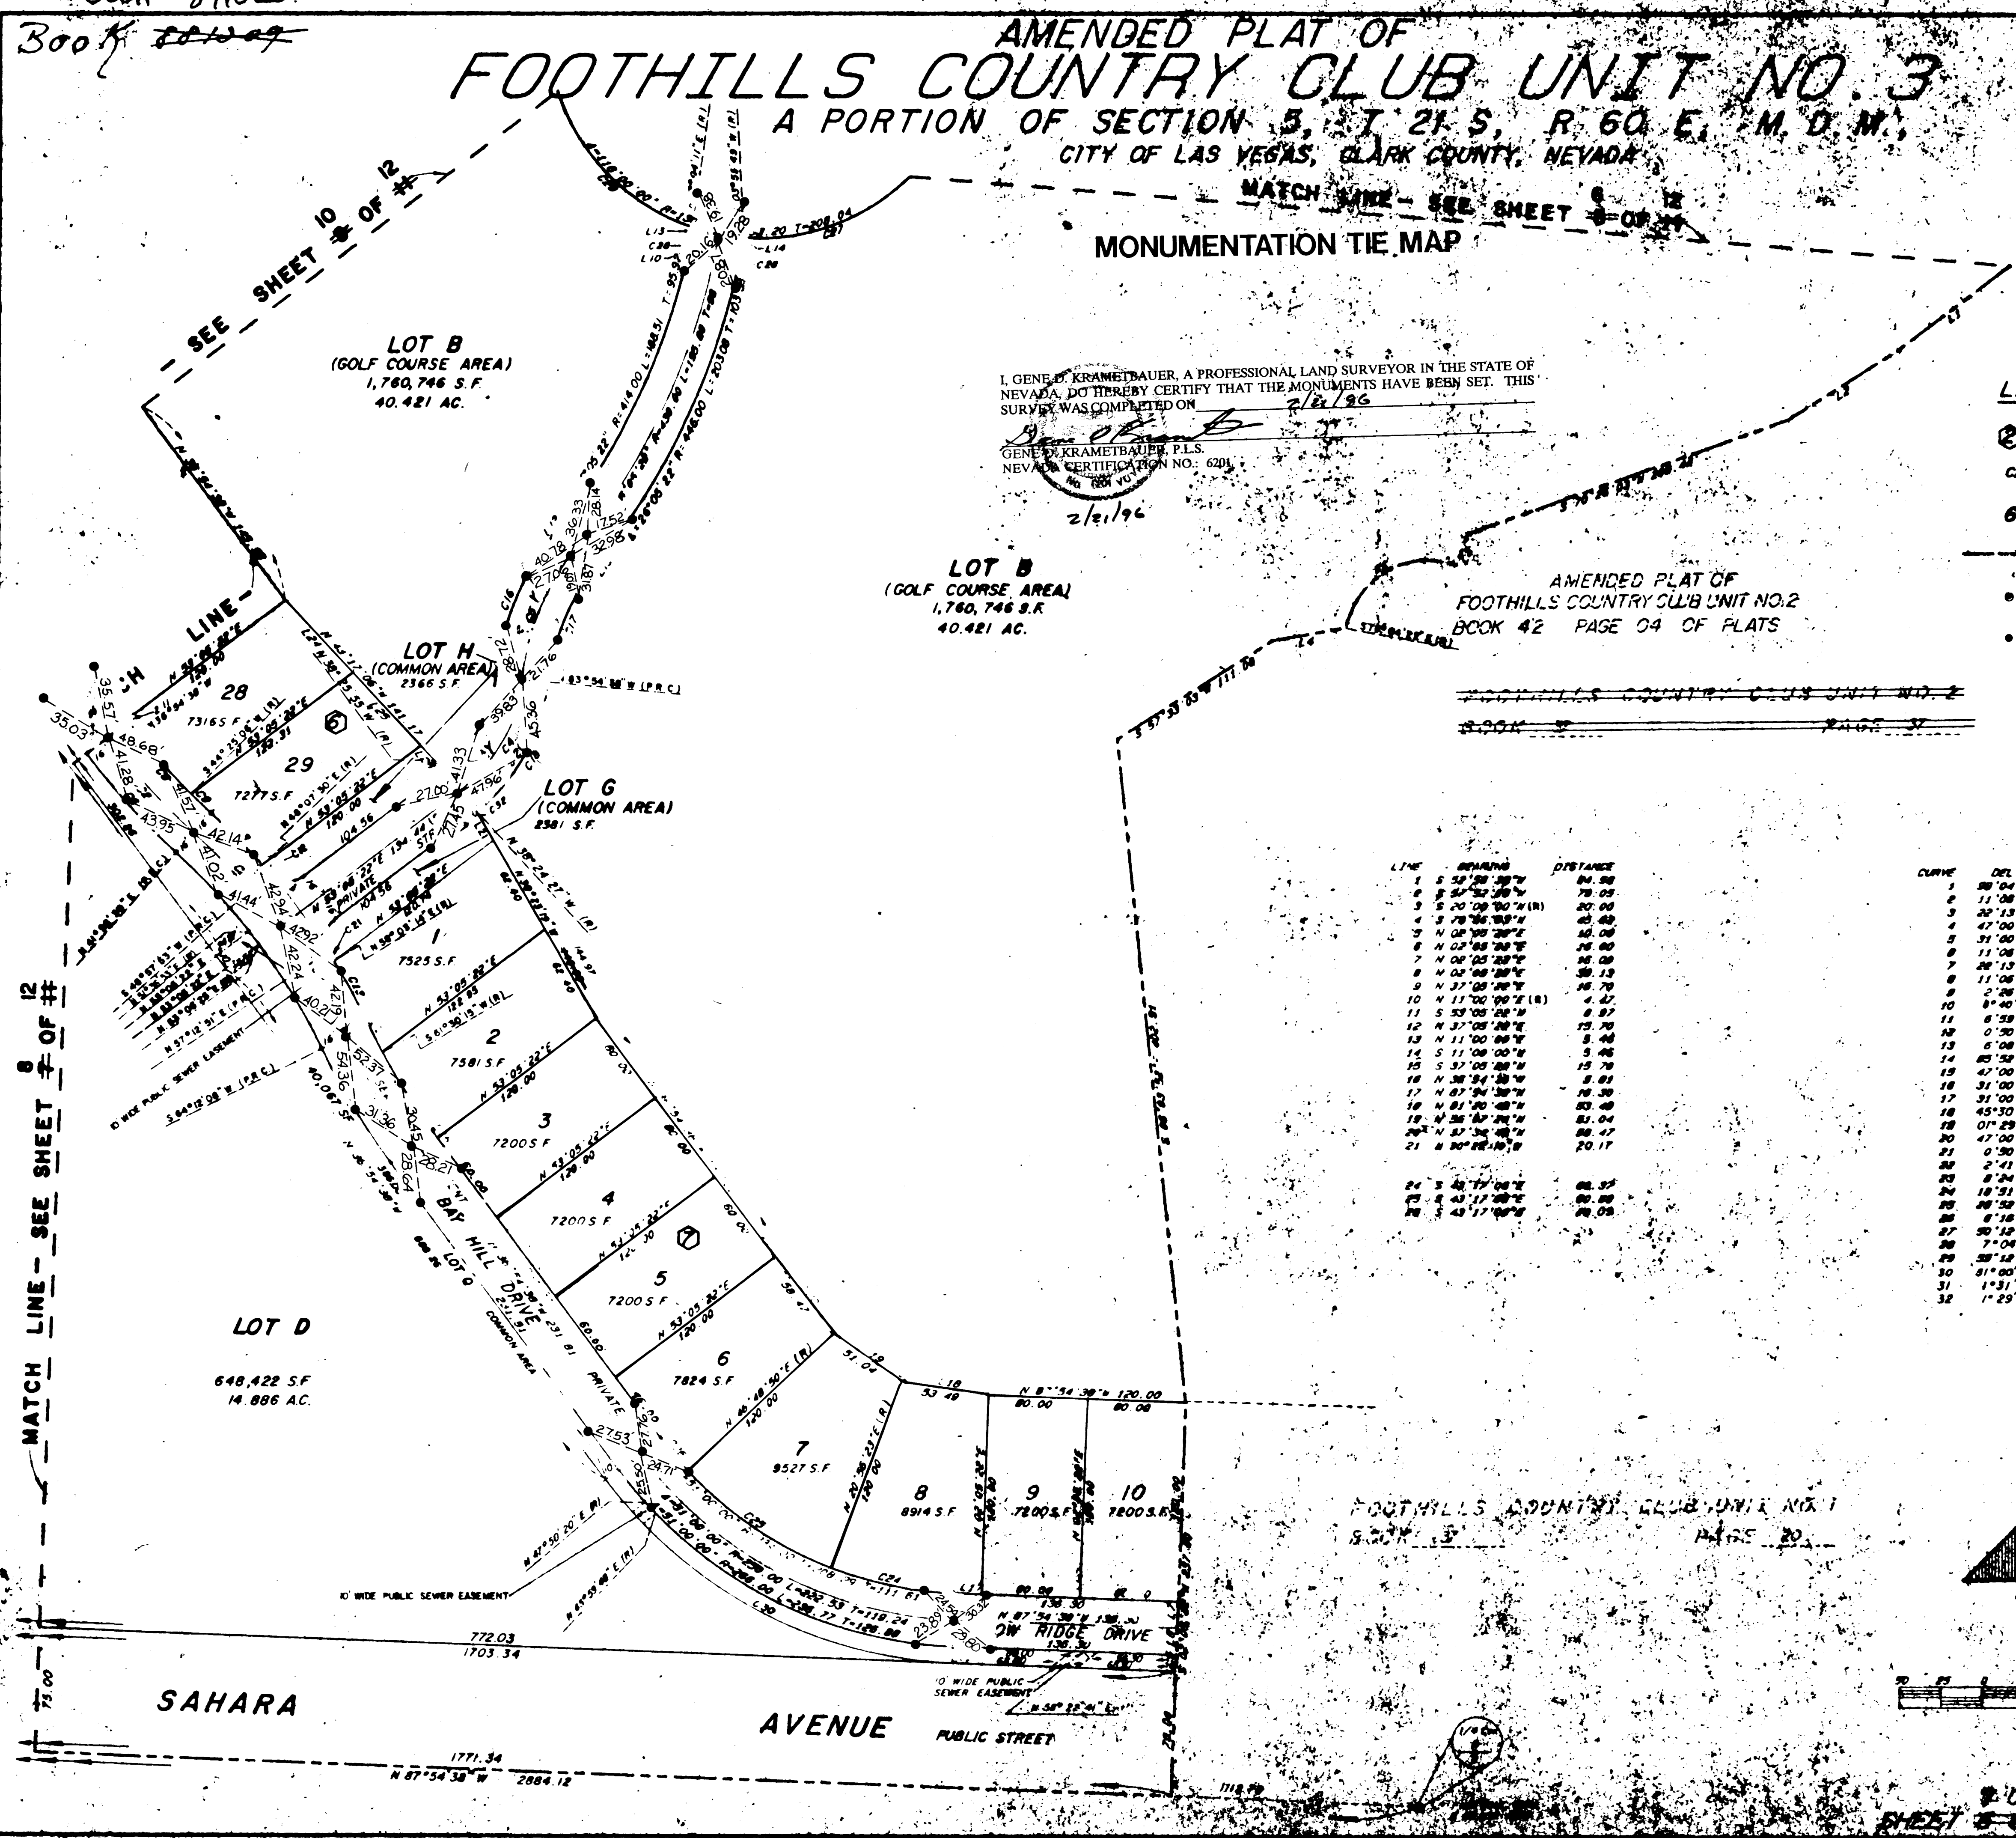

LINE	BEARING	DISTANCE	CURVE	DELTA	RADIUS	LENGTH	TANGENT

FOOTHILLS COUNTRY CLUB UNIT NO. 1
 BOOK 42 PAGE 04 OF PLATS

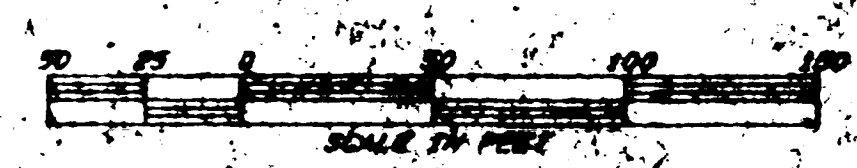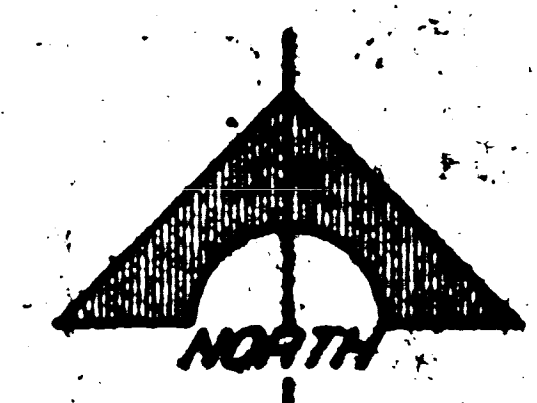

8 OF 12
 SHEET 8 OF 12

E-101-850

26/10

