


BOOK 841023
 3007 ~~6600~~

AMENDED PLAT OF FOOTHILLS COUNTRY CLUB UNIT NO. 3

A PORTION OF SECTION 5, T 21 S, R 60 E, M. D. M.,
 CITY OF LAS VEGAS, CLARK COUNTY, NEVADA
 MONUMENTATION TIE MAP

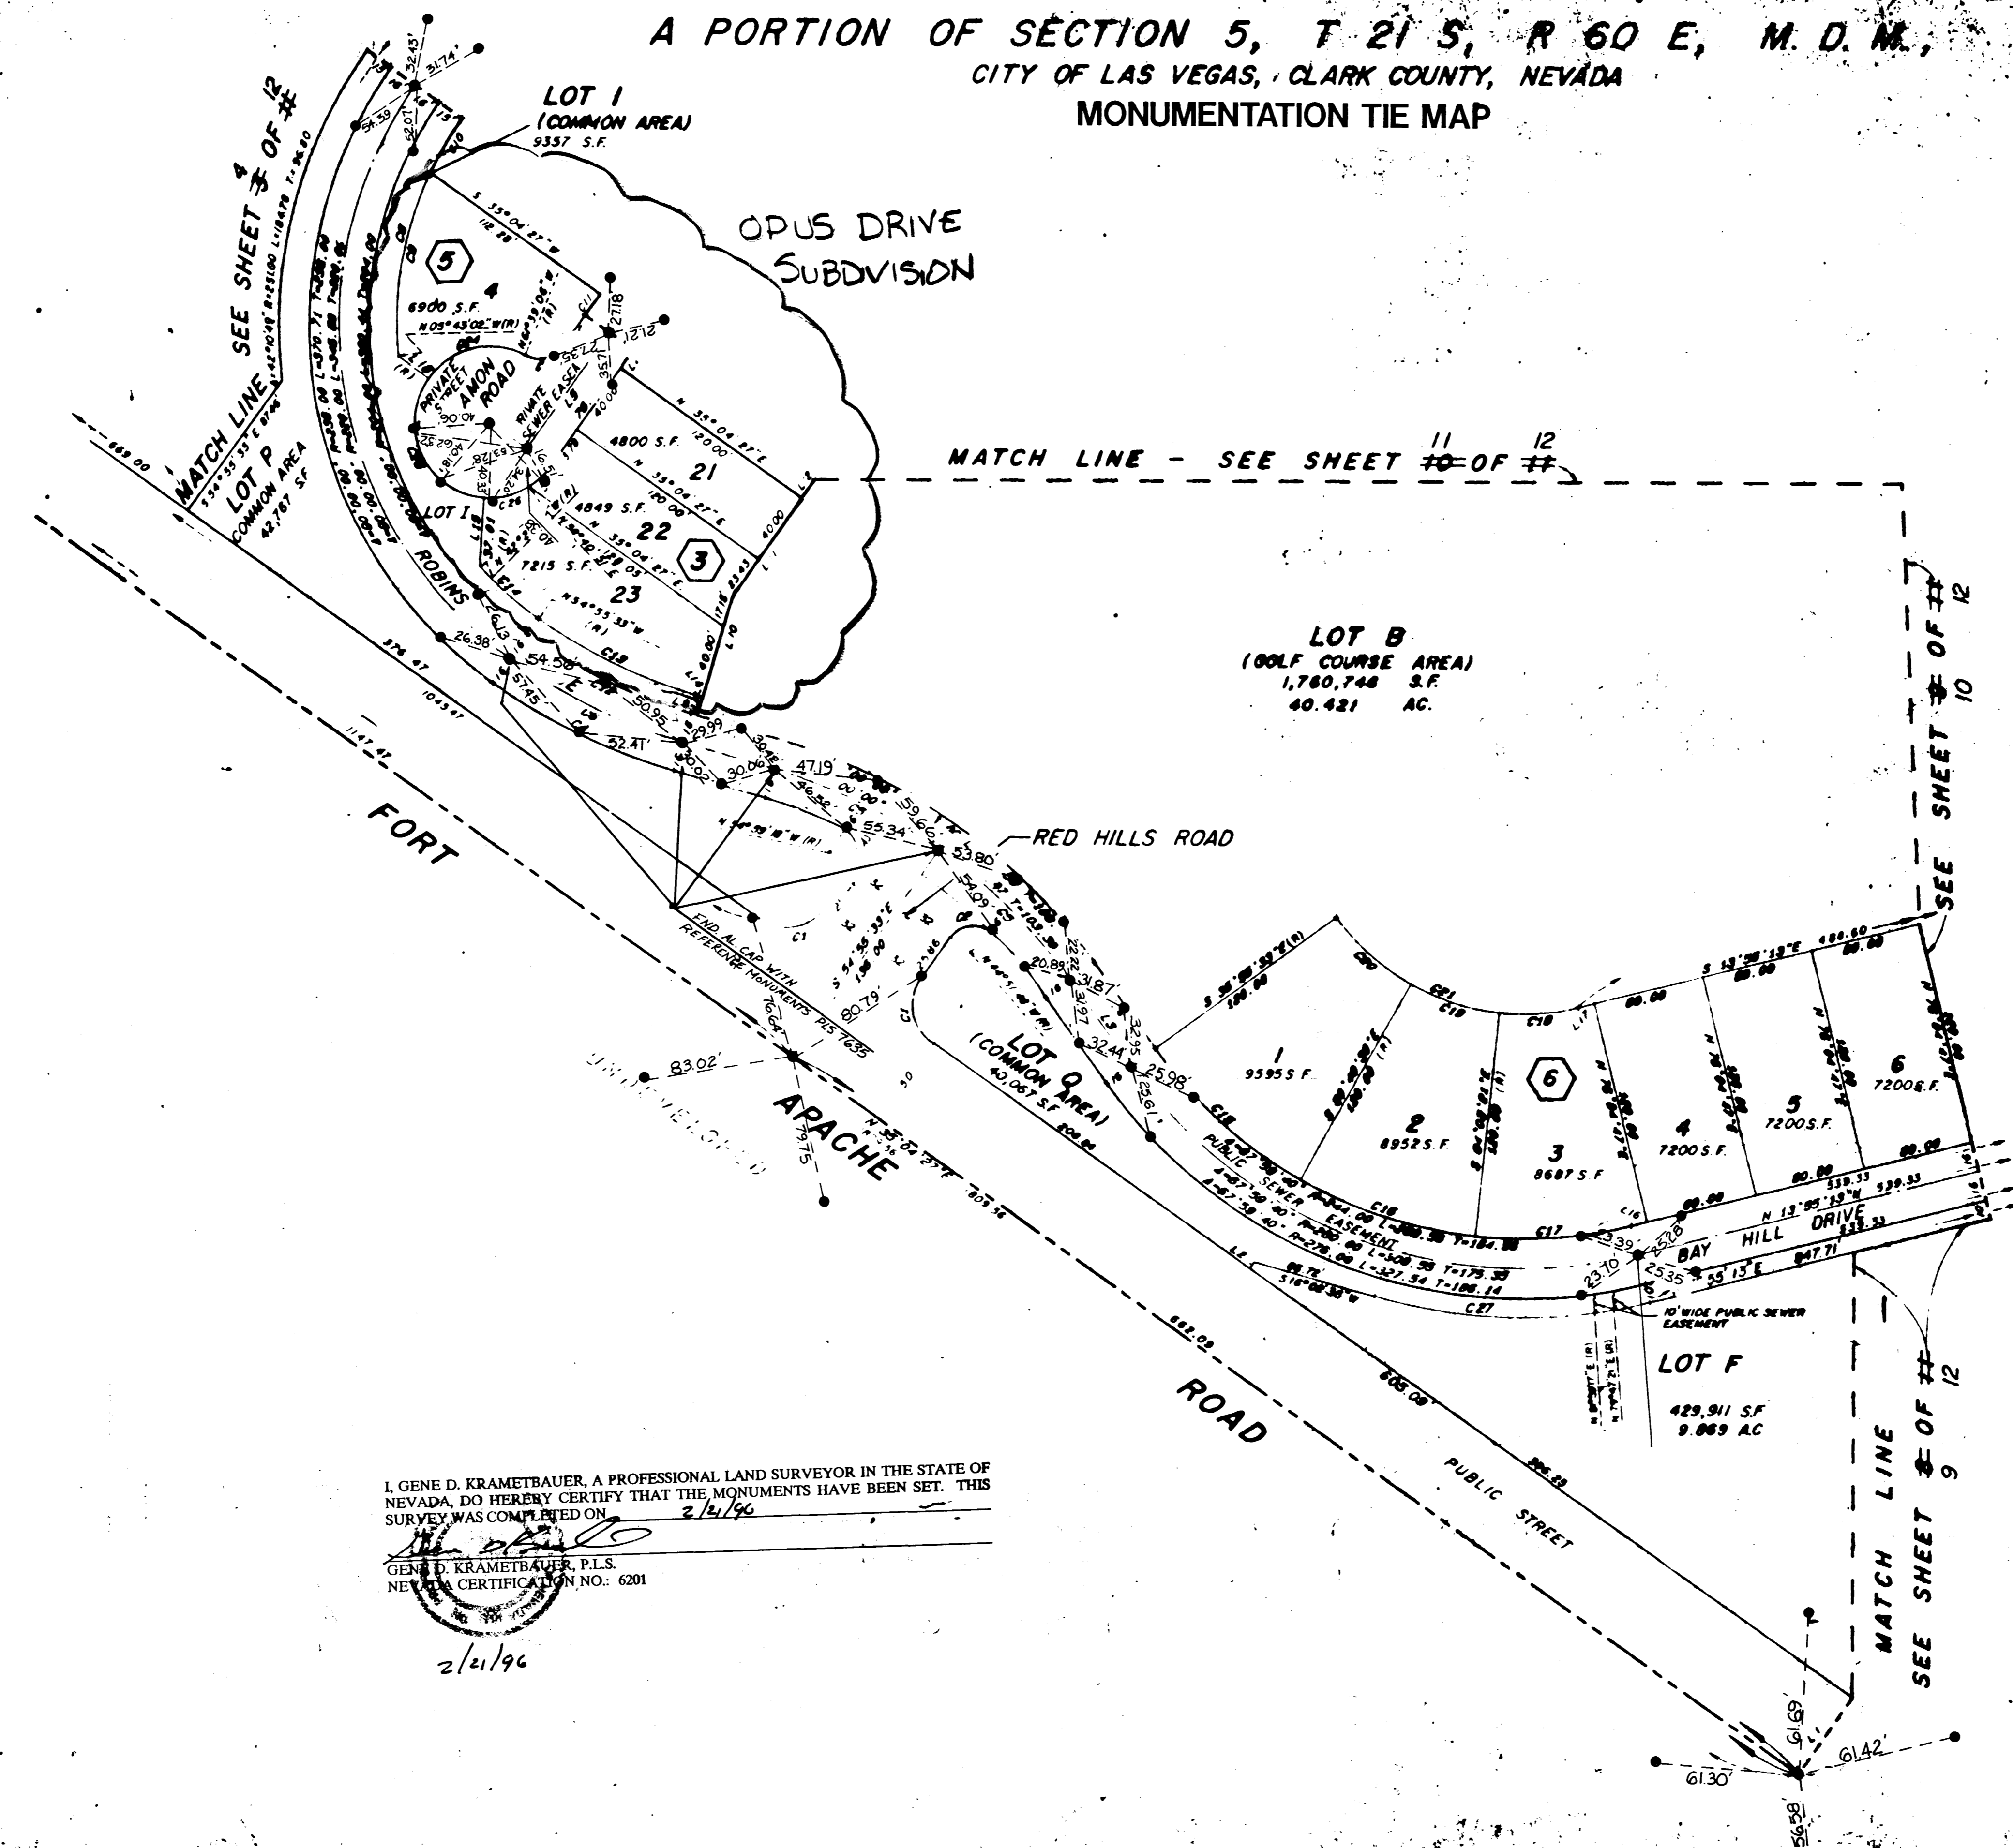






- LEGEND**
- ⊙ BLOCK NUMBER
 - C2 CURVE NUMBER
 - 6 LOT NUMBER
 - SUBDIVISION BOUNDARY
 - FND. MON. AS SHOWN
 - SET TYPE III MONUMENT - AL CAP, P.L.S. 6201 W/BRASS CAP REF. TIES SET IN T.O.C.

I, GENE D. KRAMETBAUER, A PROFESSIONAL LAND SURVEYOR IN THE STATE OF NEVADA, DO HEREBY CERTIFY THAT THE MONUMENTS HAVE BEEN SET. THIS SURVEY WAS COMPLETED ON 2/21/96

GENE D. KRAMETBAUER, P.L.S.
 NEVADA CERTIFICATION NO. 6201

2/21/96

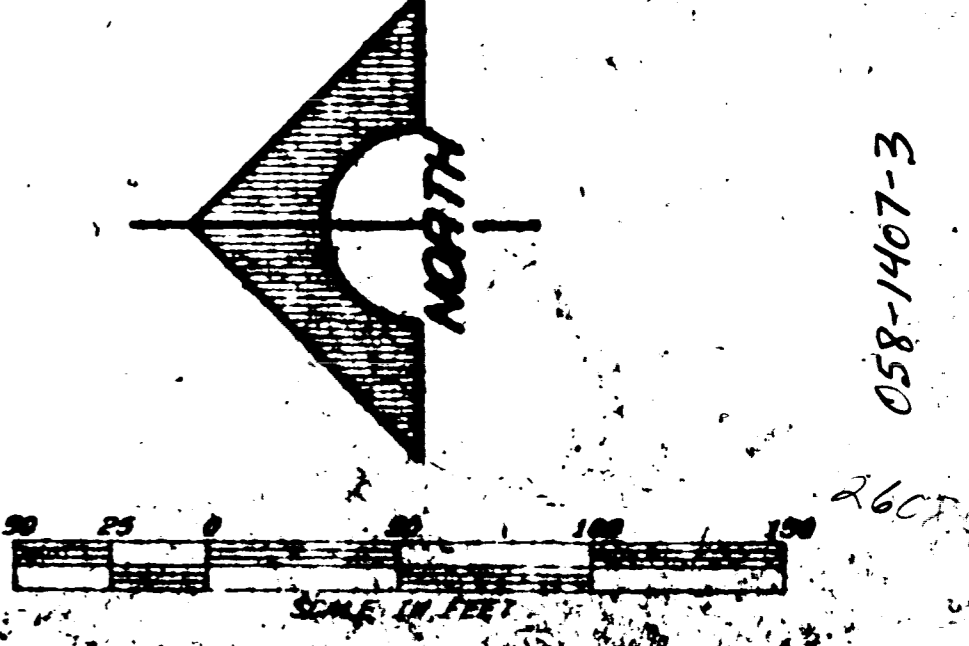

058-1407-3

