


FOOTHILLS COUNTRY CLUB UNIT NO. 4

A PLANNED RESIDENTIAL DEVELOPMENT
 BEING A SUBDIVISION OF LOTS 11 AND 12 OF AMENDED PLAT OF FOOTHILLS COUNTRY CLUB UNIT NO. 3 AS SHOWN BY A MAP THEREOF ON FILE IN BOOK 44, PAGE 12 OF PLATS IN THE CLARK COUNTY RECORDER'S OFFICE, CLARK COUNTY, NEVADA LYING WITHIN SECTION 5, TOWNSHIP 27 SOUTH, RANGE 60 EAST, M.D.M., CITY OF LAS VEGAS, CLARK COUNTY, NEVADA.


MONUMENTATION TIE MAP

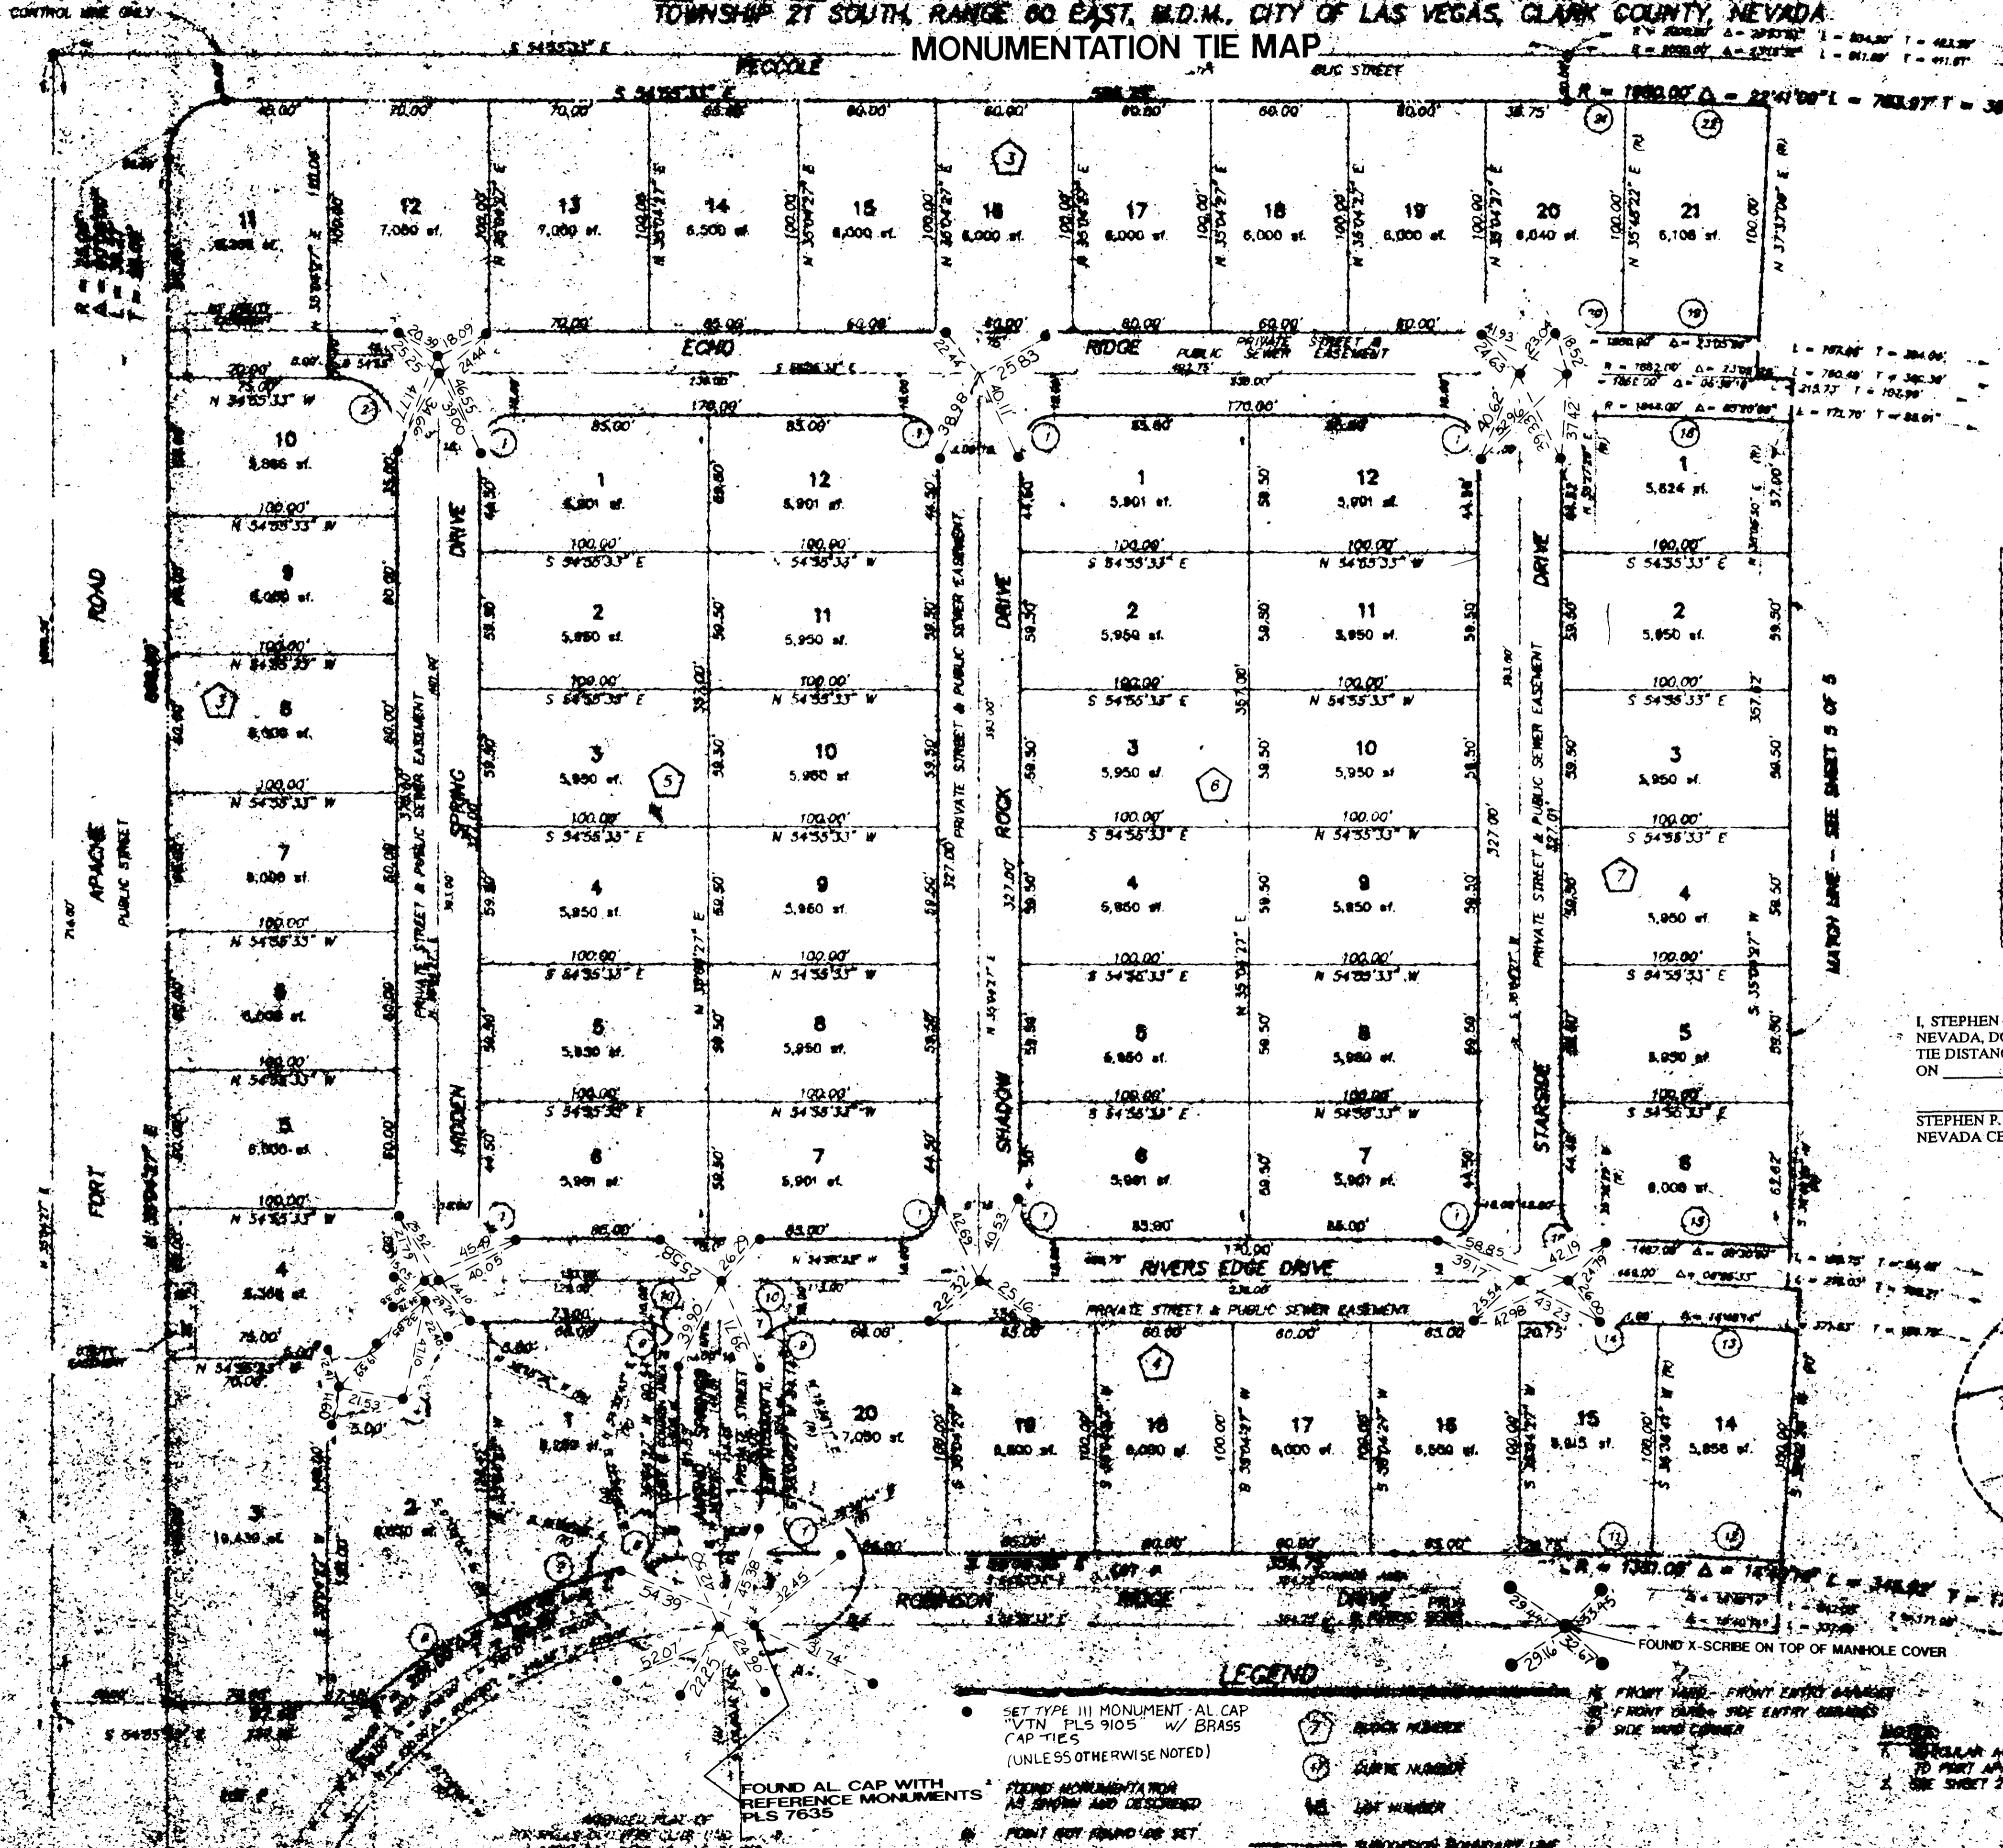

CURVE	DELTA	RADIUS	LENGTH	TANGENT
1				
2				
I, STEPHEN P. GURLIDES, A PROFESSIONAL LAND SURVEYOR IN THE STATE OF NEVADA, DO HEREBY CERTIFY THAT THE MONUMENTS HAVE BEEN SET AND THE DISTANCE ESTABLISHED AS SHOWN HEREON. THIS SURVEY WAS COMPLETED ON 5-16-98.

STEPHEN P. GURLIDES
 NEVADA CERTIFICATION NO. 9105

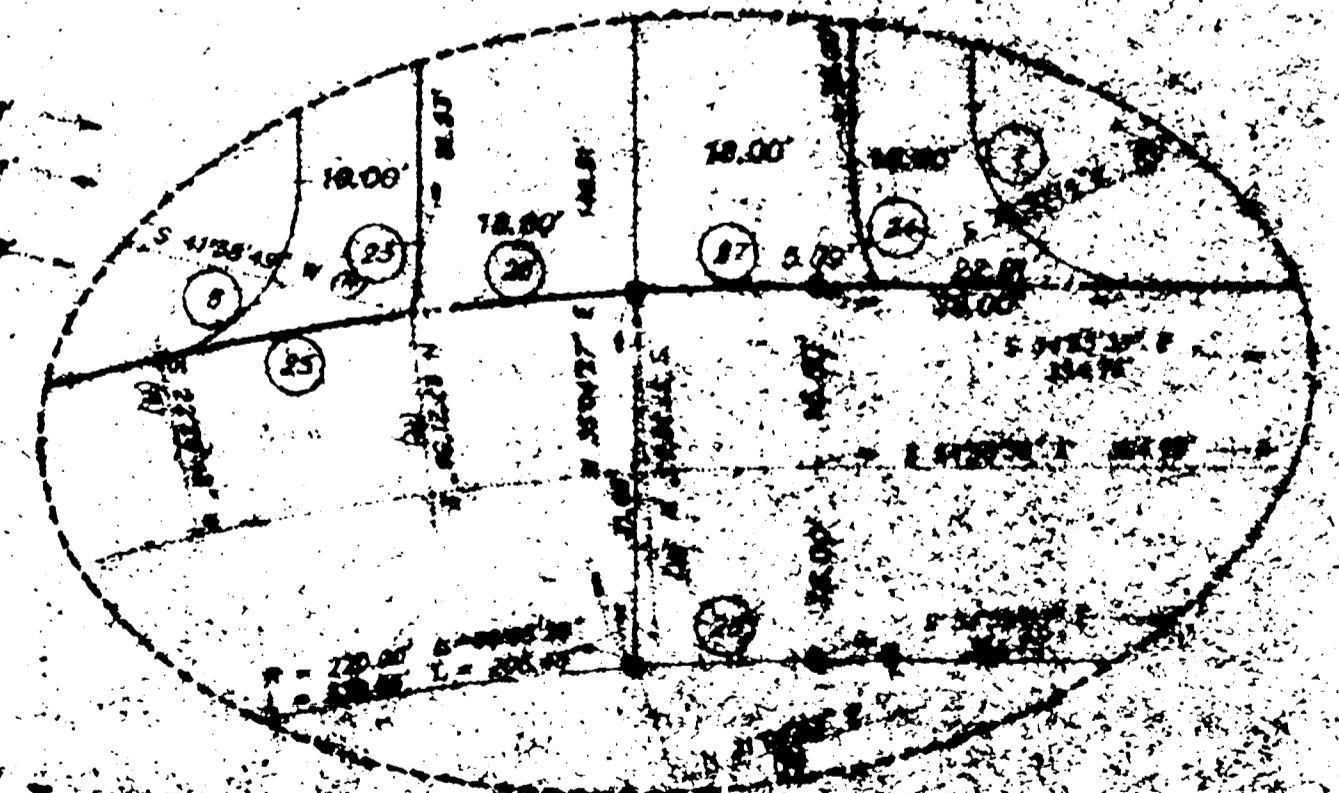

- LEGEND**
- SET TYPE III MONUMENT - AL CAP WITH PLS 9105 W/ BRASS CAP TIES (UNLESS OTHERWISE NOTED)
 - STEEL MONUMENTATION AS SHOWN AND DESCRIBED
 - POINT NOT FOUND OR SET
 - ROCK NUMBER
 - STONE NUMBER
 - LOT NUMBER
 - SUBDIVISION BOUNDARY LINE
 - FRONT YARD - FRONT ENTRY GARAGES
 - FRONT YARD - SIDE ENTRY GARAGES
 - SIDE YARD CORNER
 - FOUND X - SCRIBE ON TOP OF MANHOLE COVER
 - REGULAR ACCESS TO PECCOLE DRIVE FROM LOT 1 TO PART APACHE ROAD LOTS 3 THRU 10 ALONG S. BOUNDARY
 - SEE SHEET 2 FOR BARS OF BEARING AND LOCATION

058-1407-4



MONUMENTATION IN MAP

