



MONUMENTATION LOCATION PLAN Gates Mill Phase I

I, JOHN R. RINALDI JR, A DULY REGISTERED LAND SURVEYOR IN THE STATE OF NEVADA, DO HEREBY CERTIFY THAT THE MONUMENTS HAVE BEEN SET AND THE TIE DISTANCES ESTABLISHED AS SHOWN, HEREON, AND WAS COMPLETED ON APRIL 23, 1987.

A PORTION OF THE NW 1/4, OF THE NE 1/4, OF SEC. 22, T. 20 S., R. 60 E., M.D.M., CITY OF LAS VEGAS, NEVADA.

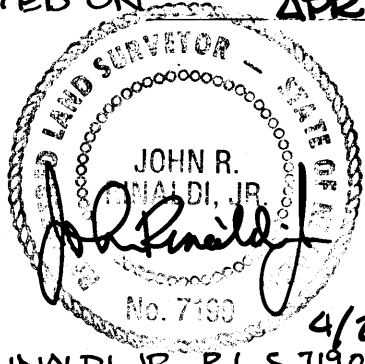


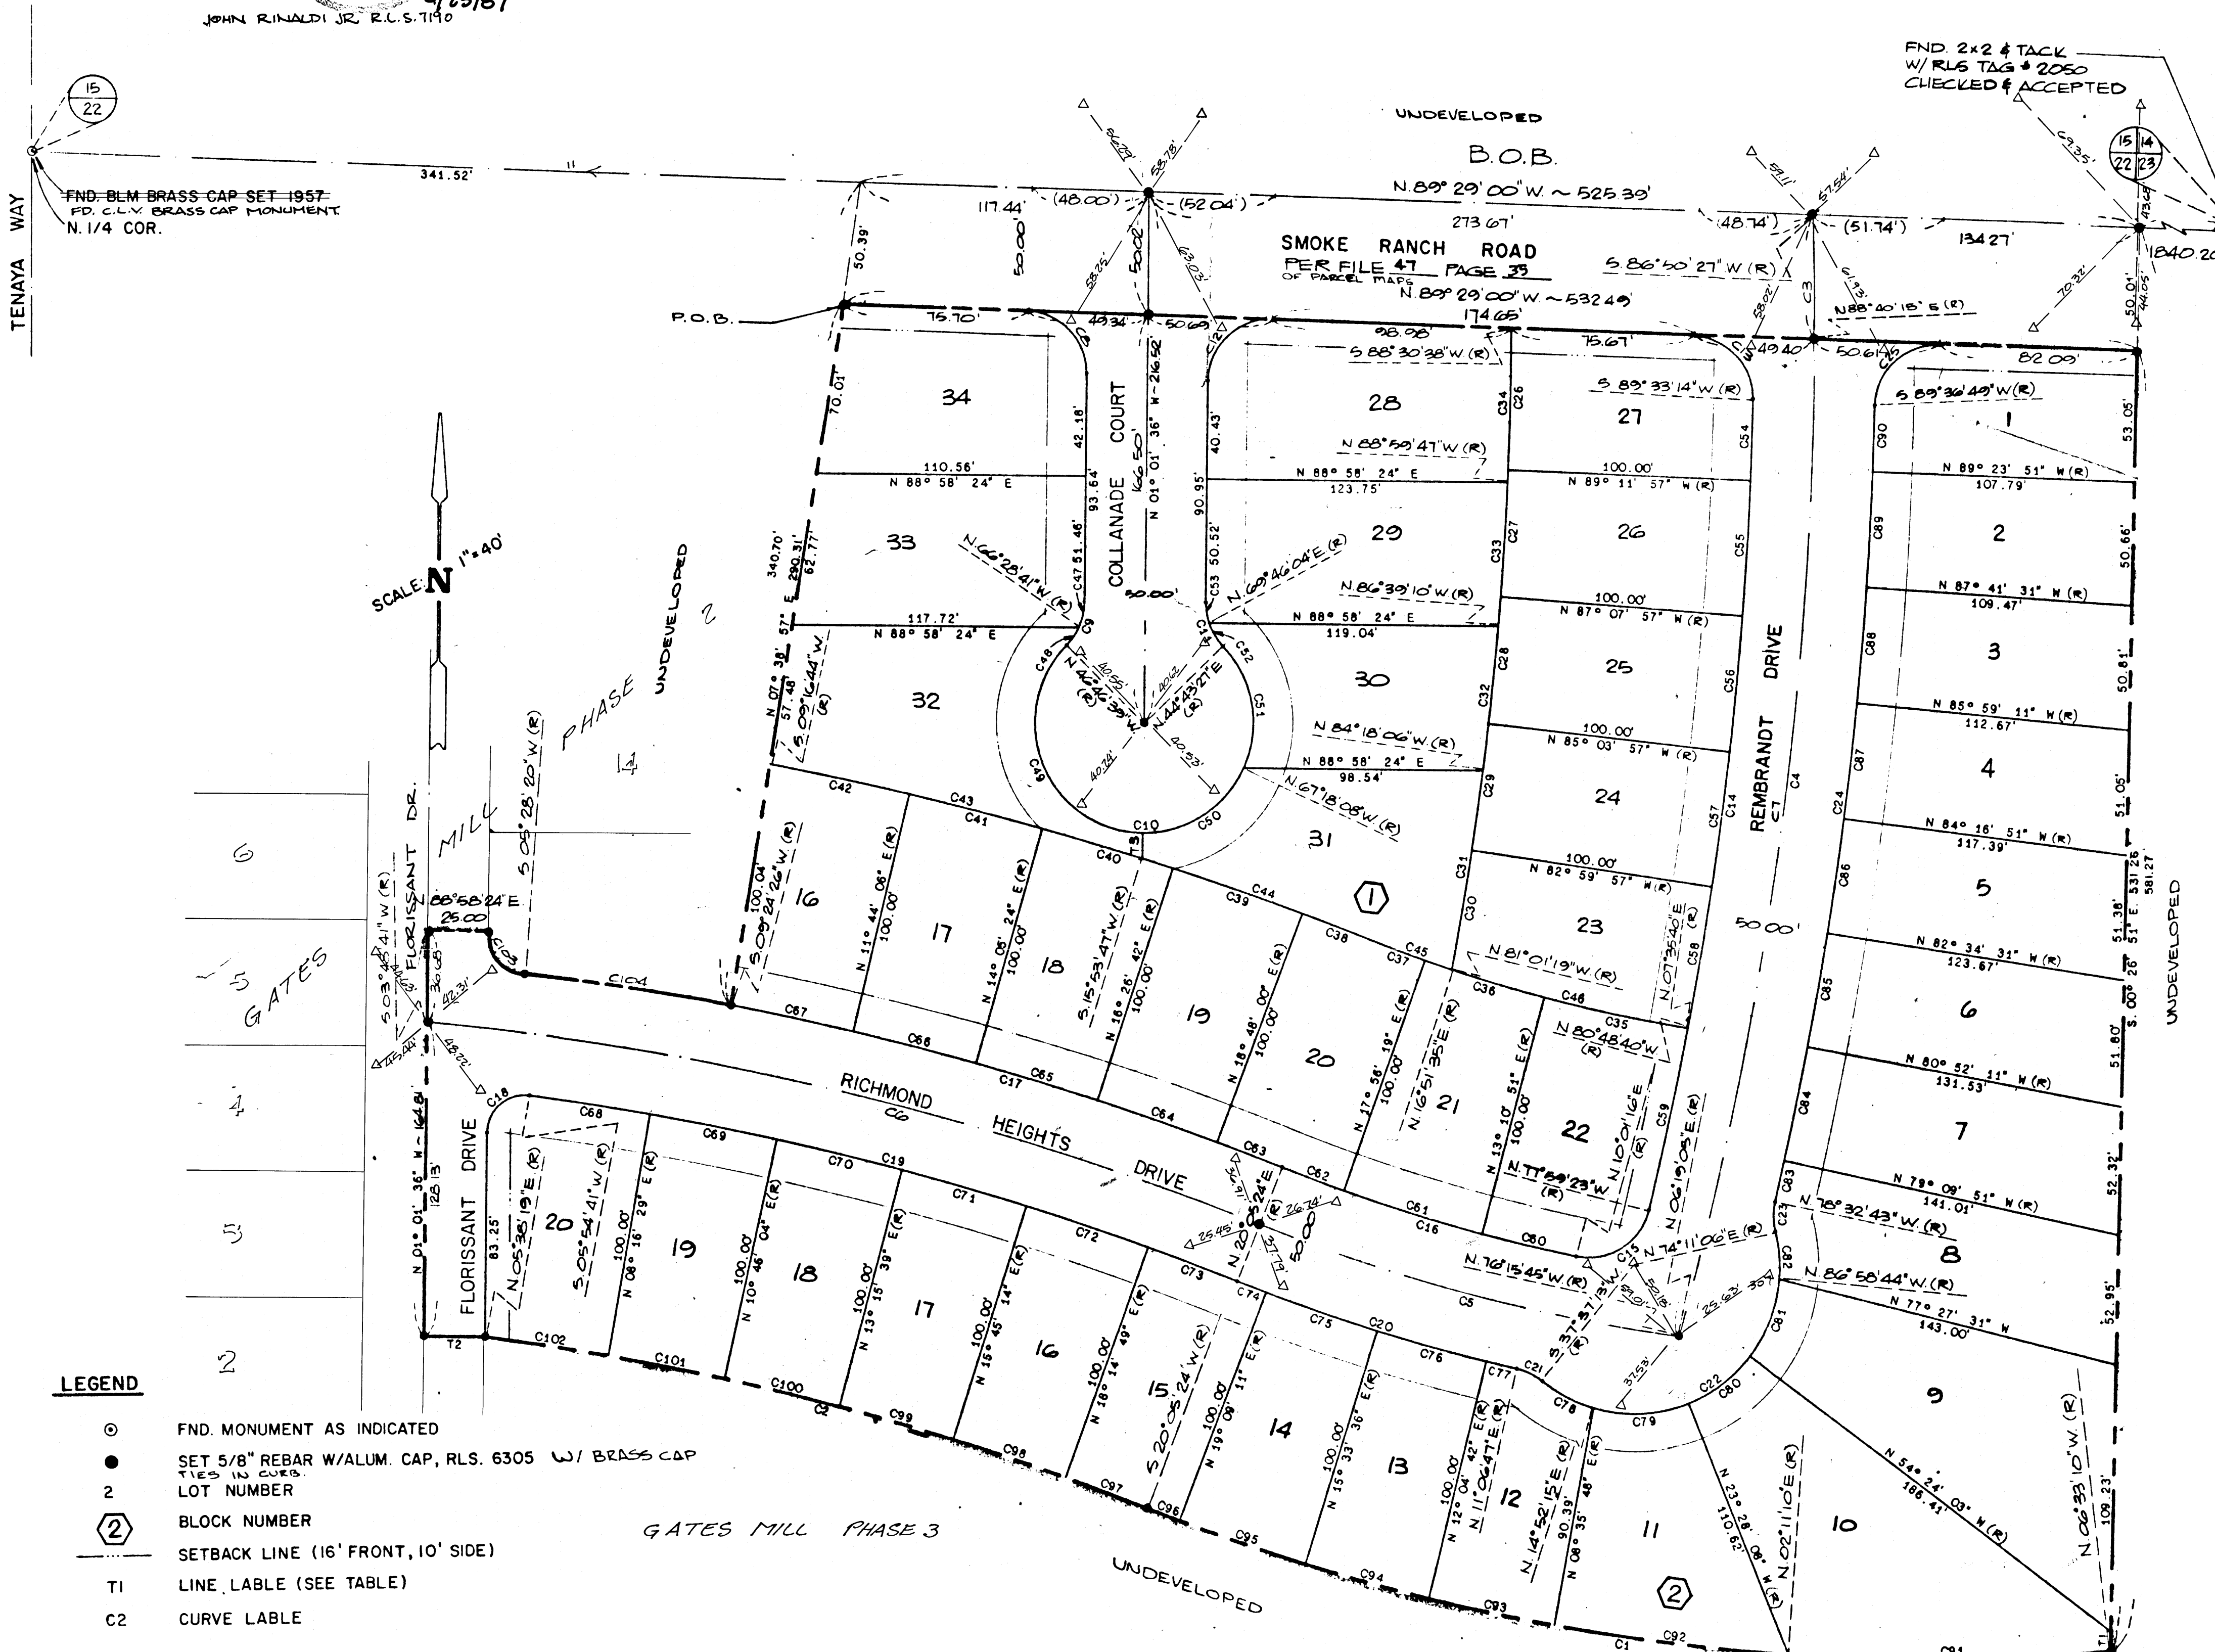

CURVE DATA TABLE

LABEL	RADIUS	CENTRAL ANGLE	ARC LENGTH	TAN. LENGTH
C1	870.00	26° 38' 34"	404.55	206.00
C2	1120.00	14° 27' 05"	282.49	142.00
C3	1567.50	01° 49' 47"	50.06	25.03
C4	1567.50	18° 53' 48"	492.28	232.85
C5	745.00	13° 46' 20"	178.07	89.97
C6	1245.00	16° 16' 44"	353.73	178.06
C7	1567.50	15° 04' 00"	412.20	207.29
C8	25.00	88° 27' 24"	38.60	24.34
C9	25.00	44° 14' 57"	19.69	10.37
C10	45.00	268° 29' 54"	210.88	107.77
C11	25.00	44° 14' 57"	19.69	10.37
C12	25.00	91° 32' 38"	39.94	25.68
C13	25.00	89° 02' 15"	38.85	24.98
C14	1542.50	12° 27' 25"	336.34	168.33
C15	25.00	88° 00' 40"	39.17	24.63
C16	720.00	10° 04' 08"	128.53	63.43
C17	1270.00	10° 40' 58"	236.78	118.74
C18	15.50	88° 55' 17"	26.22	17.50
C19	1220.00	14° 10' 43"	301.91	151.73
C20	770.00	08° 58' 38"	120.64	60.45
C21	25.00	28° 30' 27"	11.80	6.01
C22	80.00	143° 28' 07"	150.21	181.81
C23	25.00	27° 18' 11"	12.44	6.19
C24	1582.80	11° 50' 28"	329.12	165.15
C25	25.00	80° 54' 11"	39.68	25.40
C26	1442.50	02° 17' 25"	57.66	28.83
C27	1442.50	02° 04' 00"	52.03	26.02
C28	1442.50	02° 04' 00"	52.03	26.02
C29	1442.50	02° 04' 00"	52.03	26.02
C30	1442.50	01° 58' 38"	49.78	24.89
C31	1442.50	03° 18' 47"	82.57	41.30
C32	1442.50	02° 21' 04"	59.19	29.80
C33	1442.50	02° 20' 07"	58.01	29.51
C34	1442.50	02° 29' 35"	62.78	31.39
C35	620.00	05° 35' 11"	30.45	30.25
C36	620.00	04° 45' 28"	51.48	25.78
C37	620.00	02° 02' 05"	23.28	11.64
C38	1370.00	01° 17' 24"	30.85	15.42
C39	1370.00	02° 21' 18"	56.31	28.16
C40	1370.00	02° 21' 18"	56.31	28.16
C41	1370.00	02° 21' 18"	56.31	28.16
C42	1370.00	02° 21' 18"	56.31	28.16
C43	1370.00	06° 57' 05"	158.23	73.20
C44	1370.00	04° 11' 37"	100.27	50.16
C45	620.00	03° 13' 49"	34.98	17.48
C46	620.00	09° 15' 55"	100.26	50.24
C47	25.00	24° 32' 55"	10.93	5.82
C48	25.00	19° 42' 02"	8.77	4.43
C49	45.00	134° 14' 57"	105.44	106.68
C50	45.00	86° 18' 32"	52.05	29.38
C51	45.00	57° 58' 25"	53.39	30.34
C52	25.00	25° 02' 37"	11.13	5.82
C53	25.00	19° 12' 20"	8.55	4.31
C54	1542.50	01° 14' 48"	33.97	16.78
C55	1542.50	02° 04' 00"	55.64	27.92
C56	1542.50	02° 04' 00"	55.64	27.92
C57	1542.50	02° 04' 00"	55.64	27.92
C58	1542.50	02° 11' 17"	58.91	29.46
C59	1542.50	02° 49' 16"	75.95	37.98
C60	720.00	03° 09' 38"	38.71	19.86
C61	720.00	04° 45' 28"	59.78	29.81
C62	720.00	02° 08' 05"	27.04	13.52
C63	1270.00	01° 17' 24"	28.59	14.30
C64	1270.00	02° 21' 18"	52.20	26.10
C65	1270.00	02° 21' 18"	52.20	26.10
C66	1270.00	02° 21' 18"	52.20	26.10
C67	1270.00	02° 19' 40"	51.80	25.80
C68	1220.00	02° 21' 48"	50.32	25.16
C69	1220.00	02° 29' 35"	63.08	28.55
C70	1220.00	02° 29' 35"	63.08	28.55
C71	1220.00	02° 29' 35"	63.08	28.55
C72	1220.00	02° 29' 35"	63.08	28.55
C73	1220.00	01° 50' 35"	39.24	19.62
C74	770.00	00° 58' 13"	12.58	6.30
C75	770.00	03° 35' 35"	48.29	24.15
C76	770.00	03° 28' 54"	48.78	24.40
C77	770.00	00° 57' 55"	12.97	6.49
C78	80.00	22° 44' 58"	23.82	12.07
C79	80.00	38° 20' 24"	40.15	20.88
C80	80.00	30° 33' 39"	38.39	18.83
C81	80.00	32° 34' 41"	34.12	17.53
C82	80.00	18° 50' 10"	19.73	9.85
C83	1582.80	00° 37' 08"	17.20	8.80
C84	1582.80	01° 42' 20"	47.40	23.70
C85	1582.80	01° 42' 20"	47.40	23.70
C86	1582.80	01° 42' 20"	47.40	23.70
C87	1582.80	01° 42' 20"	47.40	23.70
C88	1582.80	01° 42' 20"	47.40	23.70
C89	1582.80	01° 42' 20"	47.40	23.70
C90	1582.80	00° 58' 20"	27.49	13.74
C91	870.00	08° 44' 20"	132.68	66.48
C92	870.00	06° 24' 38"	87.34	48.72
C93	870.00	03° 28' 54"	52.87	26.44
C94	870.00	03° 28' 54"	52.87	26.44
C95	870.00	03° 35' 35"	54.56	27.28
C96	870.00	00° 58' 13"	14.23	7.11
C97	1120.00	01° 50' 35"	38.03	18.02
C98	1120.00	02° 29' 35"	48.73	24.37
C99	1120.00	02° 29' 35"	48.73	24.37
C100	1120.00	02° 29' 35"	48.73	24.37
C101	1120.00	02° 29' 35"	48.73	24.37
C102	1120.00	02° 38' 10"	51.53	25.77
C103	15.50	83° 30' 04"	22.59	13.85
C104	1270.00	03° 58' 06"	87.22	43.63

LINE DATA TABLE

LINE	BEARING	DISTANCE
T1	N 00° 26' 51" W	8.02
T2	S 88° 58' 24" W	25.00
T3	N 01° 01' 36" W	10.45

NOTE: THERE SHALL BE NO DIRECT VEHICULAR ACCESS TO SMOKE RANCH ROAD FROM ABUTTING LOTS.

- LEGEND**
- ⊙ FND. MONUMENT AS INDICATED
 - SET 5/8" REBAR W/ALUM. CAP, RLS. 6305 W/ BRASS CAP TIES IN CURVE
 - 2 LOT NUMBER
 - ② BLOCK NUMBER
 - SETBACK LINE (16' FRONT, 10' SIDE)
 - T1 LINE LABEL (SEE TABLE)
 - C2 CURVE LABEL