

# GLENVIEW LANDING

A PORTION OF THE EAST HALF OF SECTION 8, T21S., R. 60E., M.D.M.


## PHASE 3

(TOWN HOMES)

### MONUMENT TIE MAP




- SET 2" B.C. IN T.C. STAMPED R.M. (DIST. NOTED)
- ▲ FND. 2" B.C. IN T.C. STAMPED R.M. (DIST. NOTED)
- SET 5/8" REBAR, R.L.S. #6902
- ◆ FOUND B/C IN CONC. MON., R.L.S. #6305
- ◎ FOUND 5/8" REBAR, R.L.S. #6305
- 2 LOT NUMBER
- C1 CURVE NUMBER (SEE TABLE)
- T2 LINE NUMBER (SEE TABLE)
- P.U.E. PUBLIC UTILITY EASEMENT

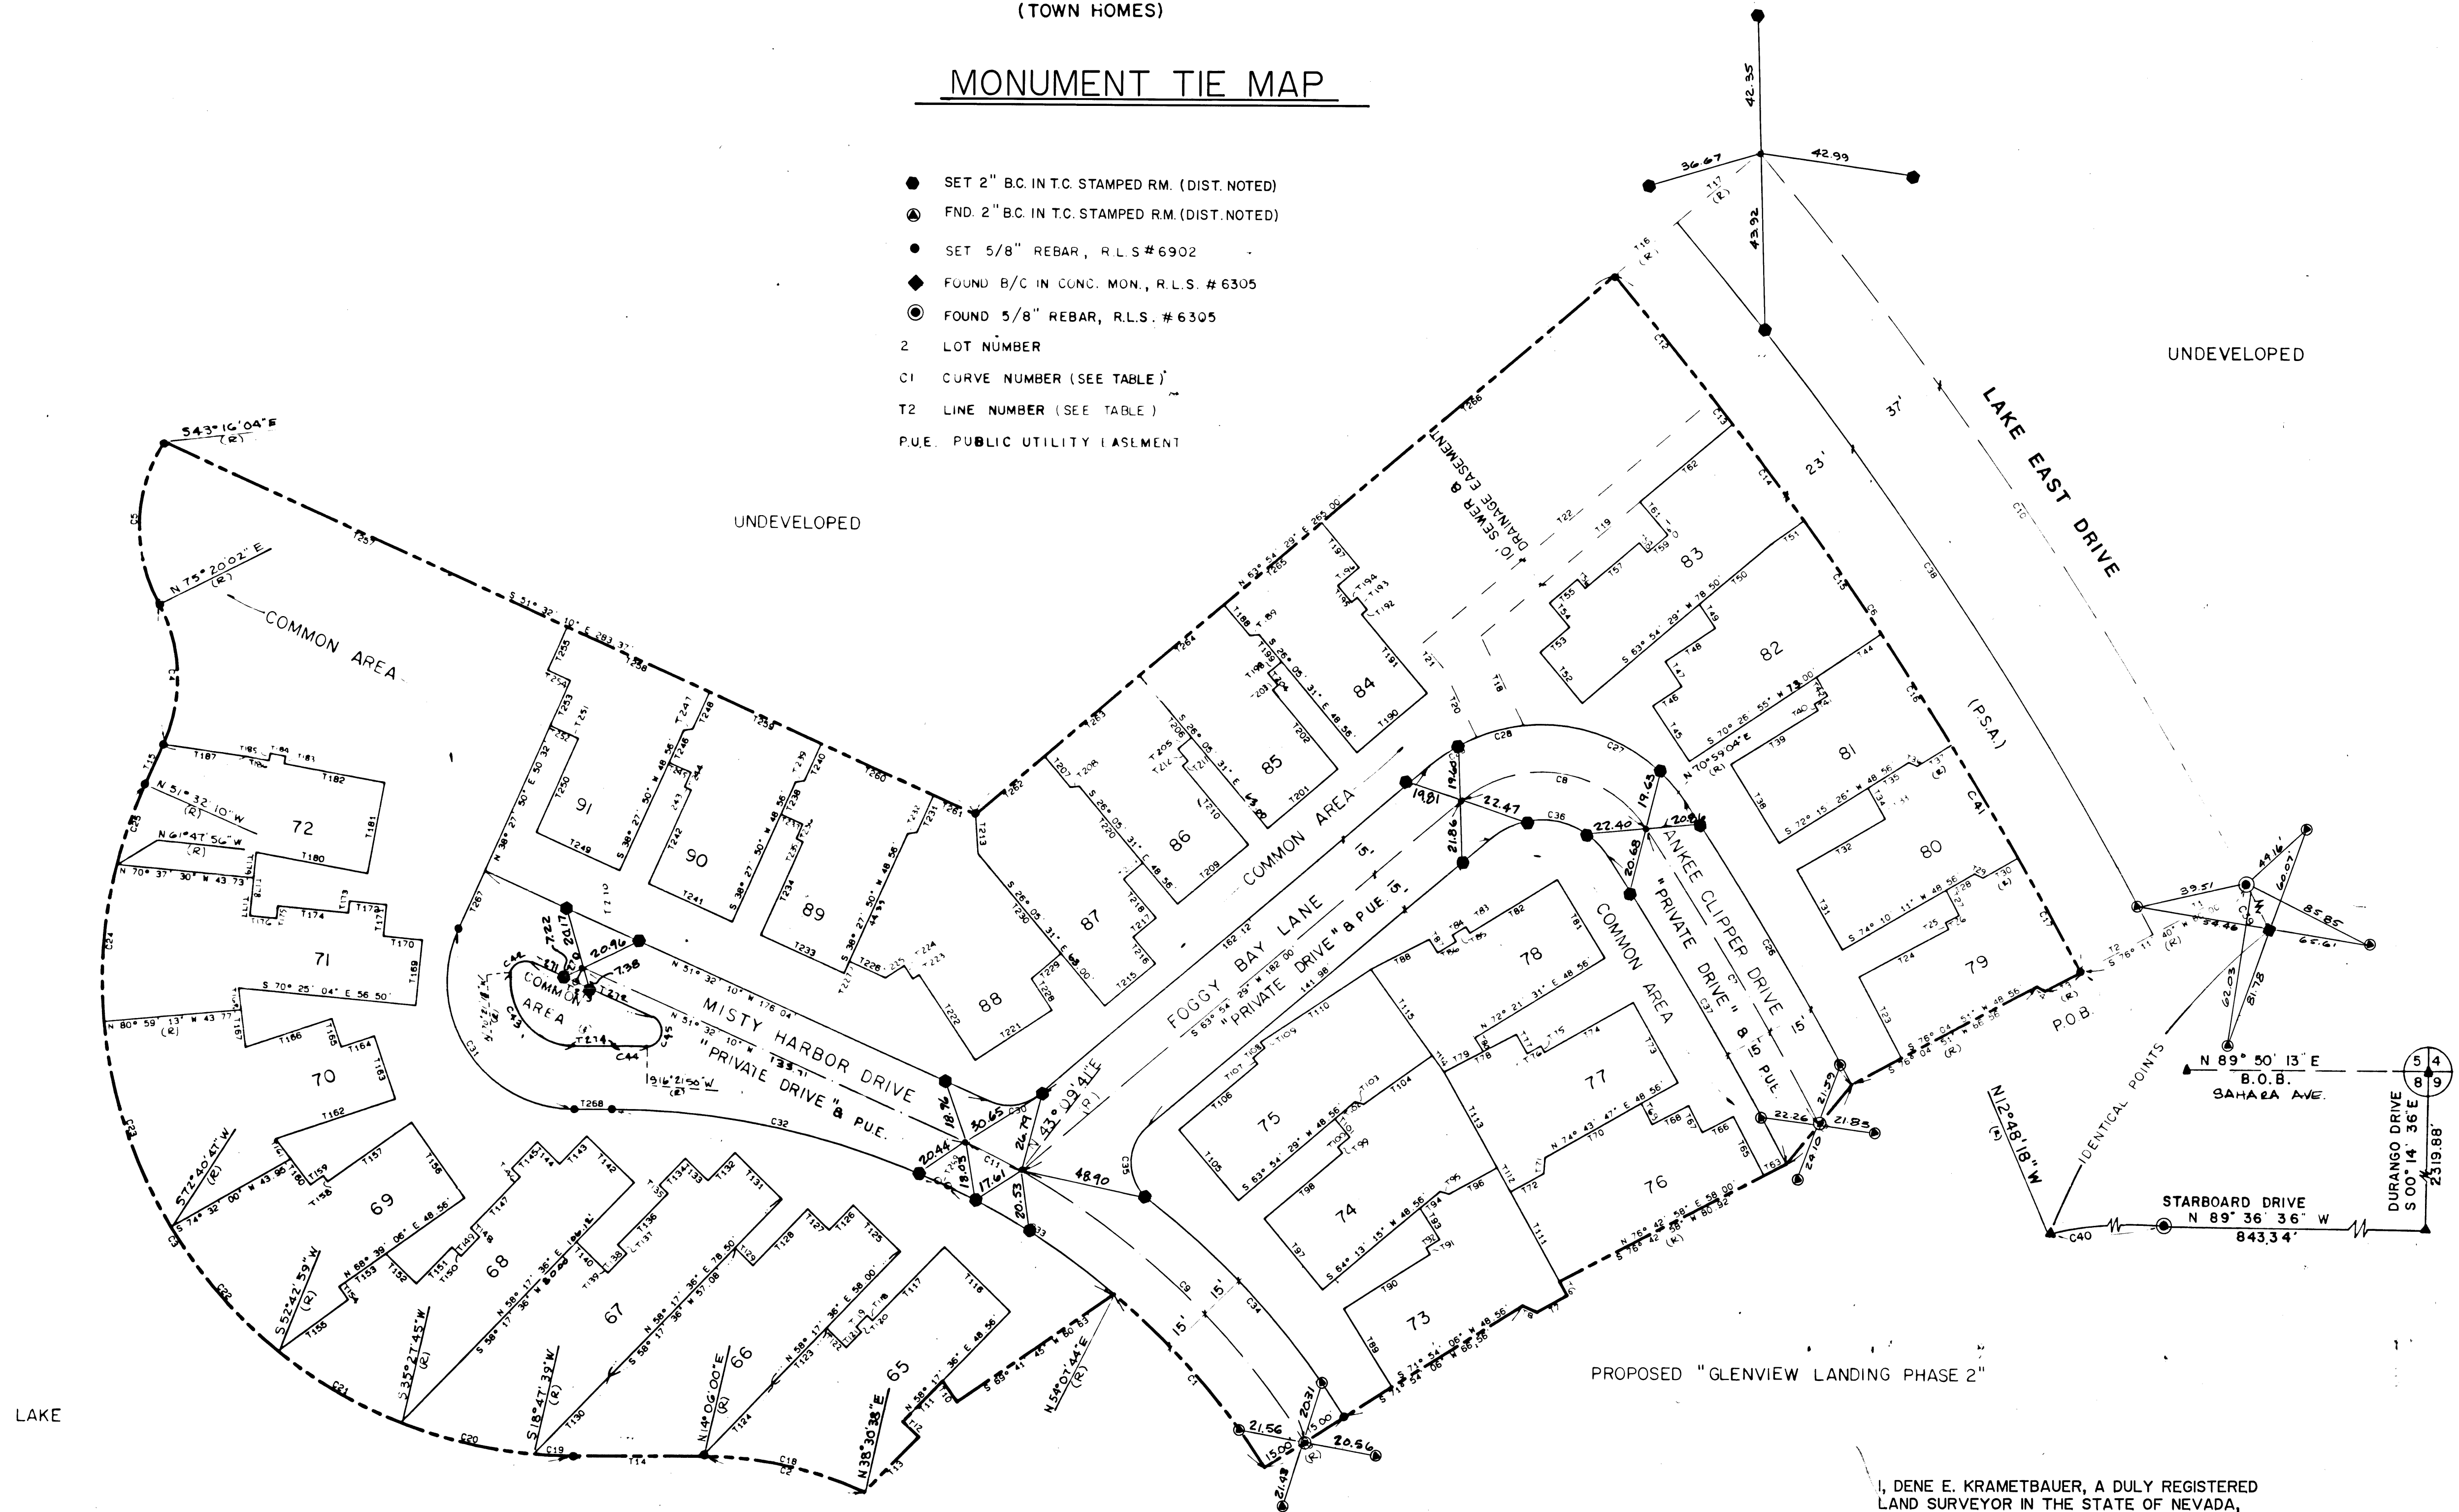

I, DENE E. KRAMETBAUER, A DULY REGISTERED LAND SURVEYOR IN THE STATE OF NEVADA, DO HEREBY CERTIFY THAT THE MONUMENTS HAVE BEEN SET AND THE TIES ESTABLISHED AS SHOWN HEREON.

DENE E. KRAMETBAUER, R.L.S. 6305

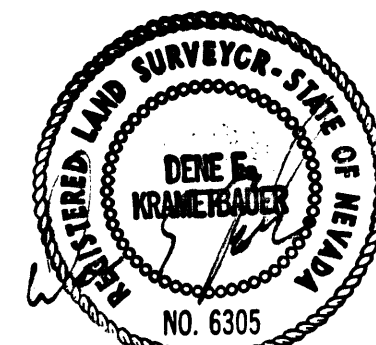

2/1/00