

MONUMENTATION MAP

FOR
HILLCREST ESTATES UNIT 1

A SUBDIVISION OF THE WESTERLY PORTION OF LOT 12 OF THE AMENDED PLAT OF
SUMMERLIN VILLAGE 1 NORTH, A PLANNED COMMUNITY, AS RECORDED FEBRUARY 8, 1990
IN PLAT BOOK 45, PAGE 10 BEING A PORTION OF SECTION 20, T 20 S, R 60 E, M.D.M.
LAS VEGAS, NEVADA




LINE TABLE

NO.	BEARING	DISTANCE
L1	S 31°47'21"E	114.23
L2	N 82°23'57"E	2.76
L3	N 42°07'06"W	22.66
L4	S 13°33'37"W	51.00
L5	S 65°59'33"W	8.44
L6	S 27°30'00"W	13.00
L7	N 82°45'00"E	13.00
L8	N 32°45'00"E	13.00
L9	N 42°30'00"W	13.00
L10	N 42°30'00"W	13.00
L11	N 30°00"E	13.00
L12	S 53°33'37"W	22.00
L13	S 85°23'00"E	22.00
L14	S 27°30'00"W	22.00
L15	S 42°30'00"E	1.48
L16	S 74°15'00"W	14.00
L17	S 53°33'37"E	5.01
L18	N 132°30'00"W	3.25

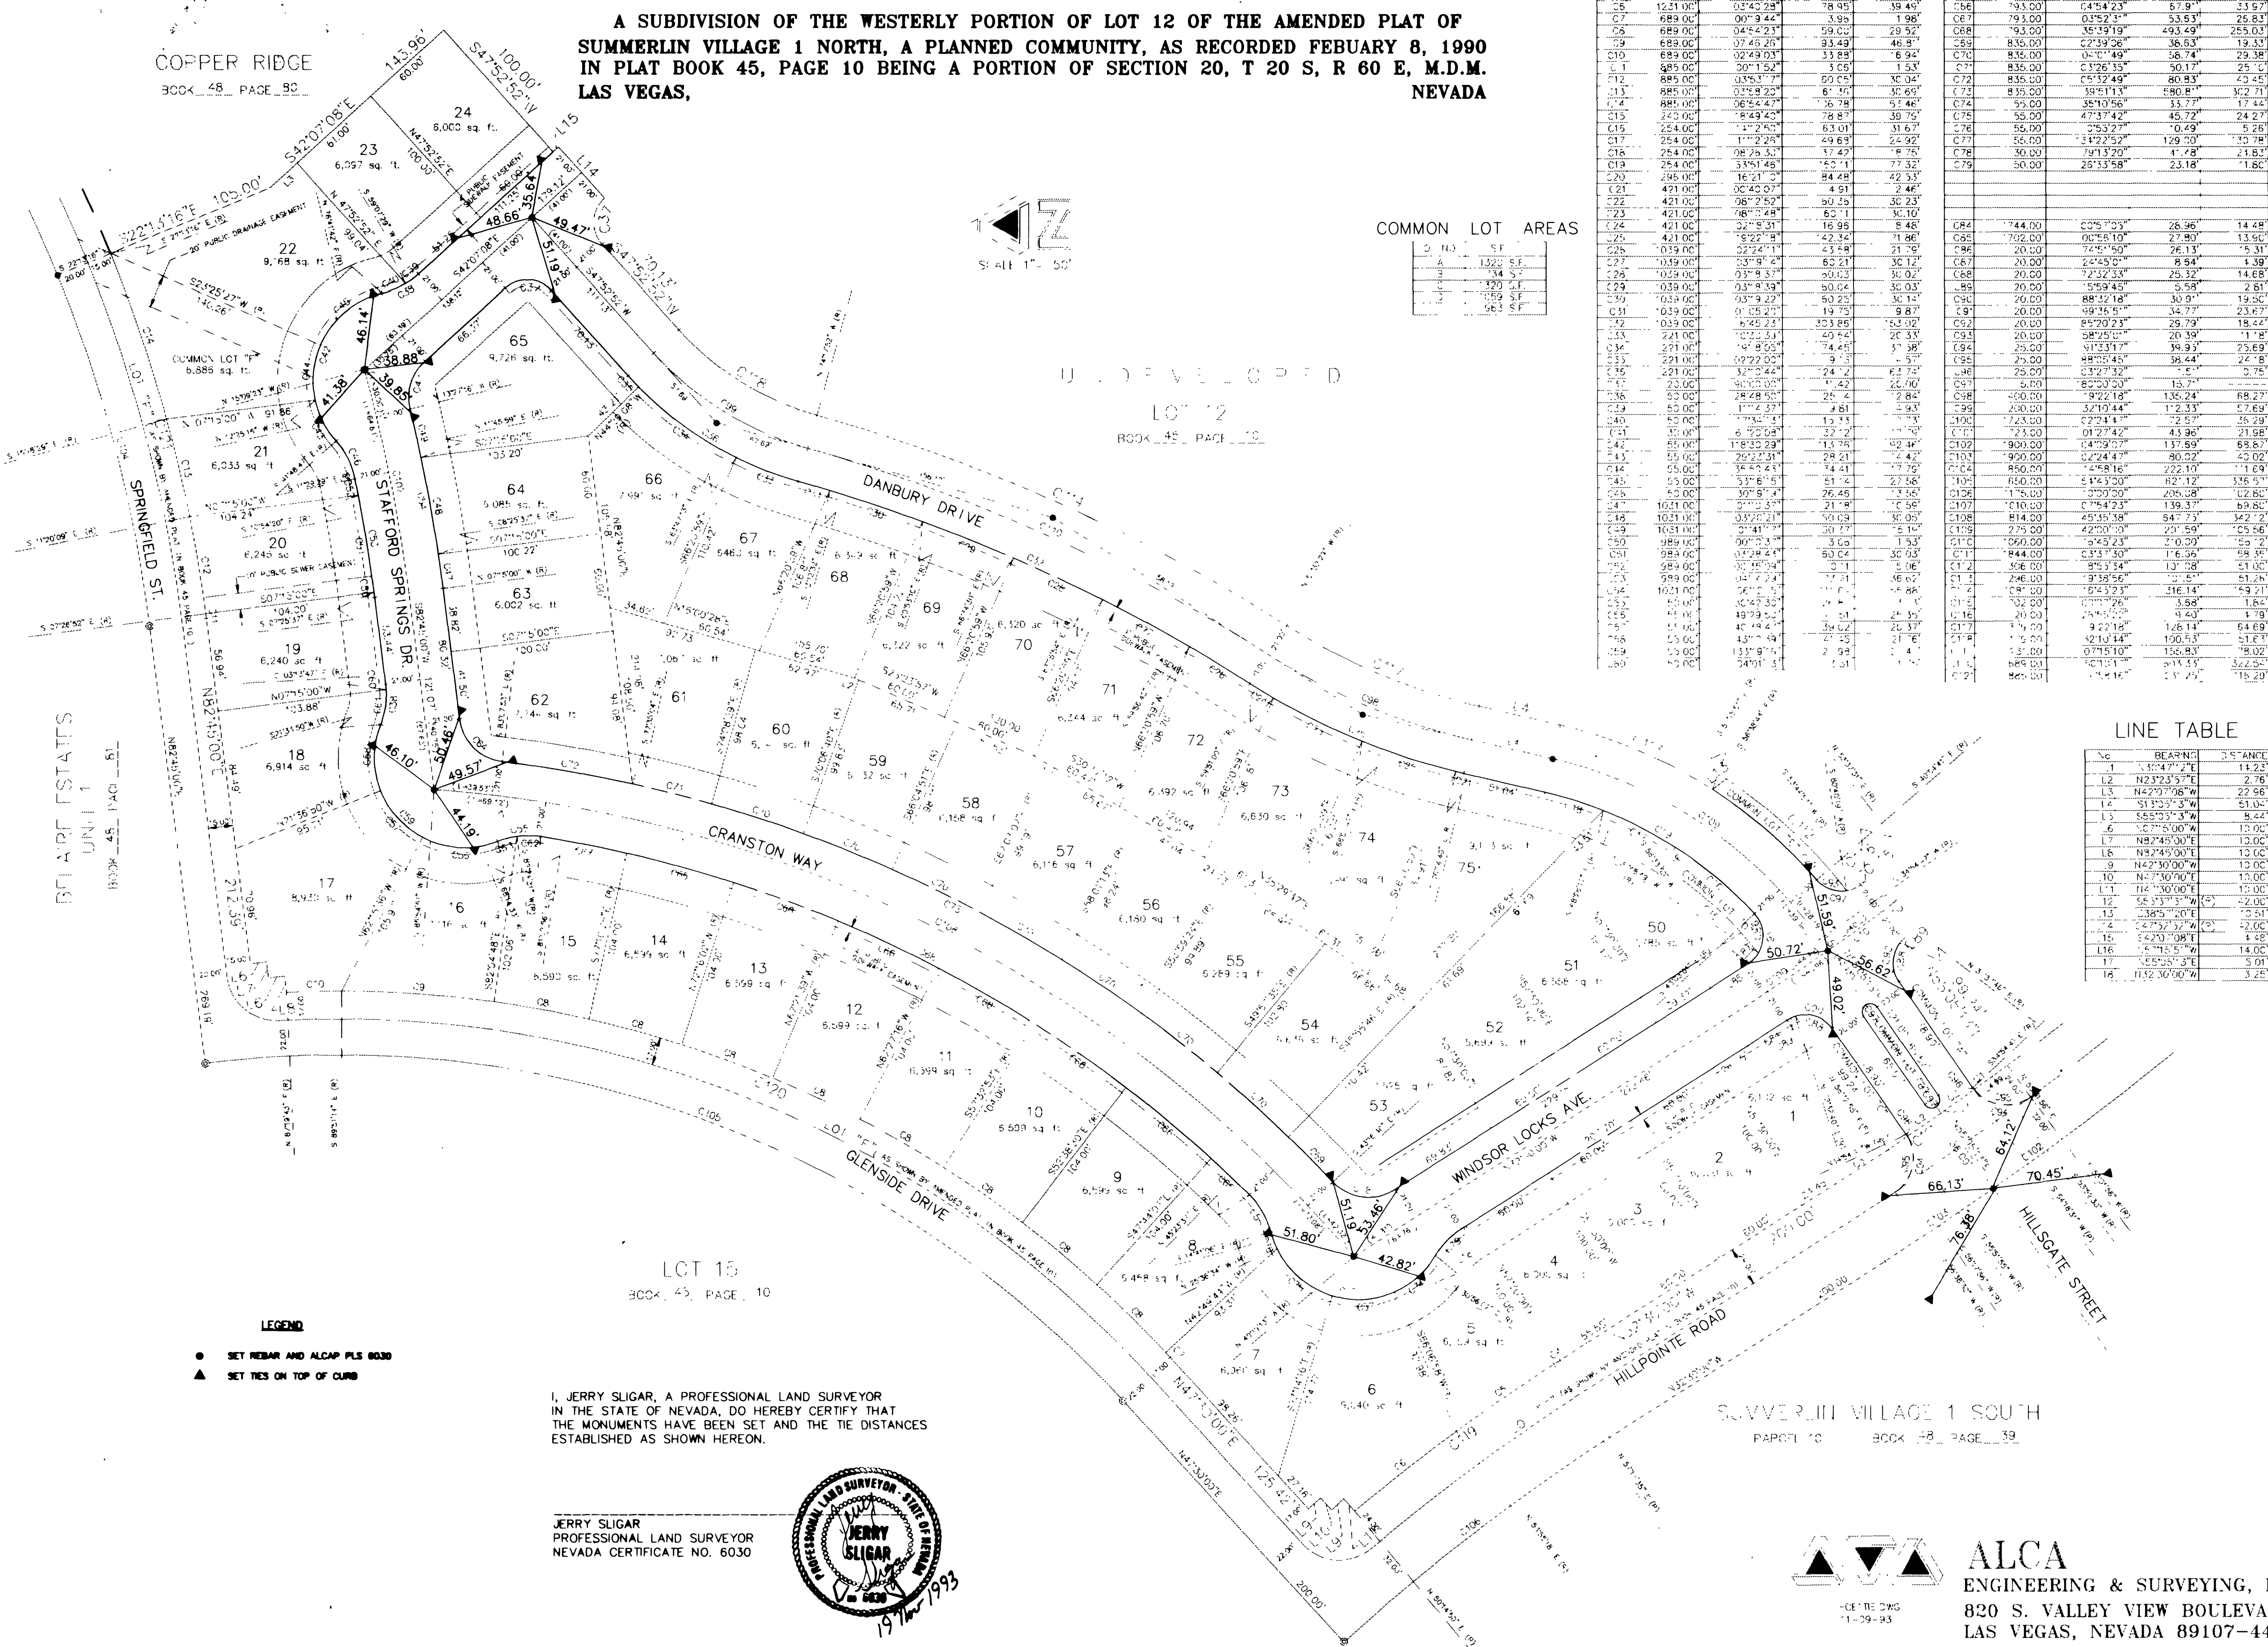


LEGEND

- SET REBAR AND ALCAP PLS 6030
- ▲ SET TIES ON TOP OF CURB

I, JERRY SLIGAR, A PROFESSIONAL LAND SURVEYOR IN THE STATE OF NEVADA, DO HEREBY CERTIFY THAT THE MONUMENTS HAVE BEEN SET AND THE TIE DISTANCES ESTABLISHED AS SHOWN HEREON.

JERRY SLIGAR
PROFESSIONAL LAND SURVEYOR
NEVADA CERTIFICATE NO. 6030

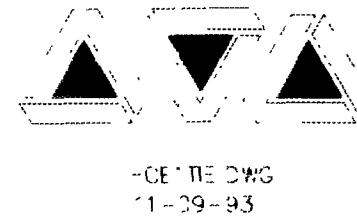

ALCA
ENGINEERING & SURVEYING, INC.
820 S. VAL

