

MONUMENTATION MAP


FOR HILLCREST ESTATES UNIT 2

A SUBDIVISION OF THE EASTERLY PORTION OF LOT 12 OF THE AMENDED PLAT OF
SUMMERLIN VILLAGE 1 NORTH, A PLANNED COMMUNITY, AS RECORDED FEBRUARY 8, 1990
IN PLAT BOOK 45, PAGE 10 BEING A PORTION OF SECTION 20, T 20 S, R 60 E, M.D.M.


LAS VEGAS

NEVADA

COPPER RIDGE AT
THE HILLS AT SUMMERLIN
BOOK 48 PAGE 80

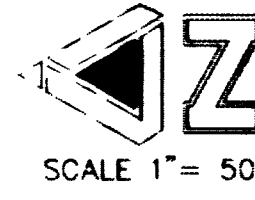

SCALE 1" = 50'

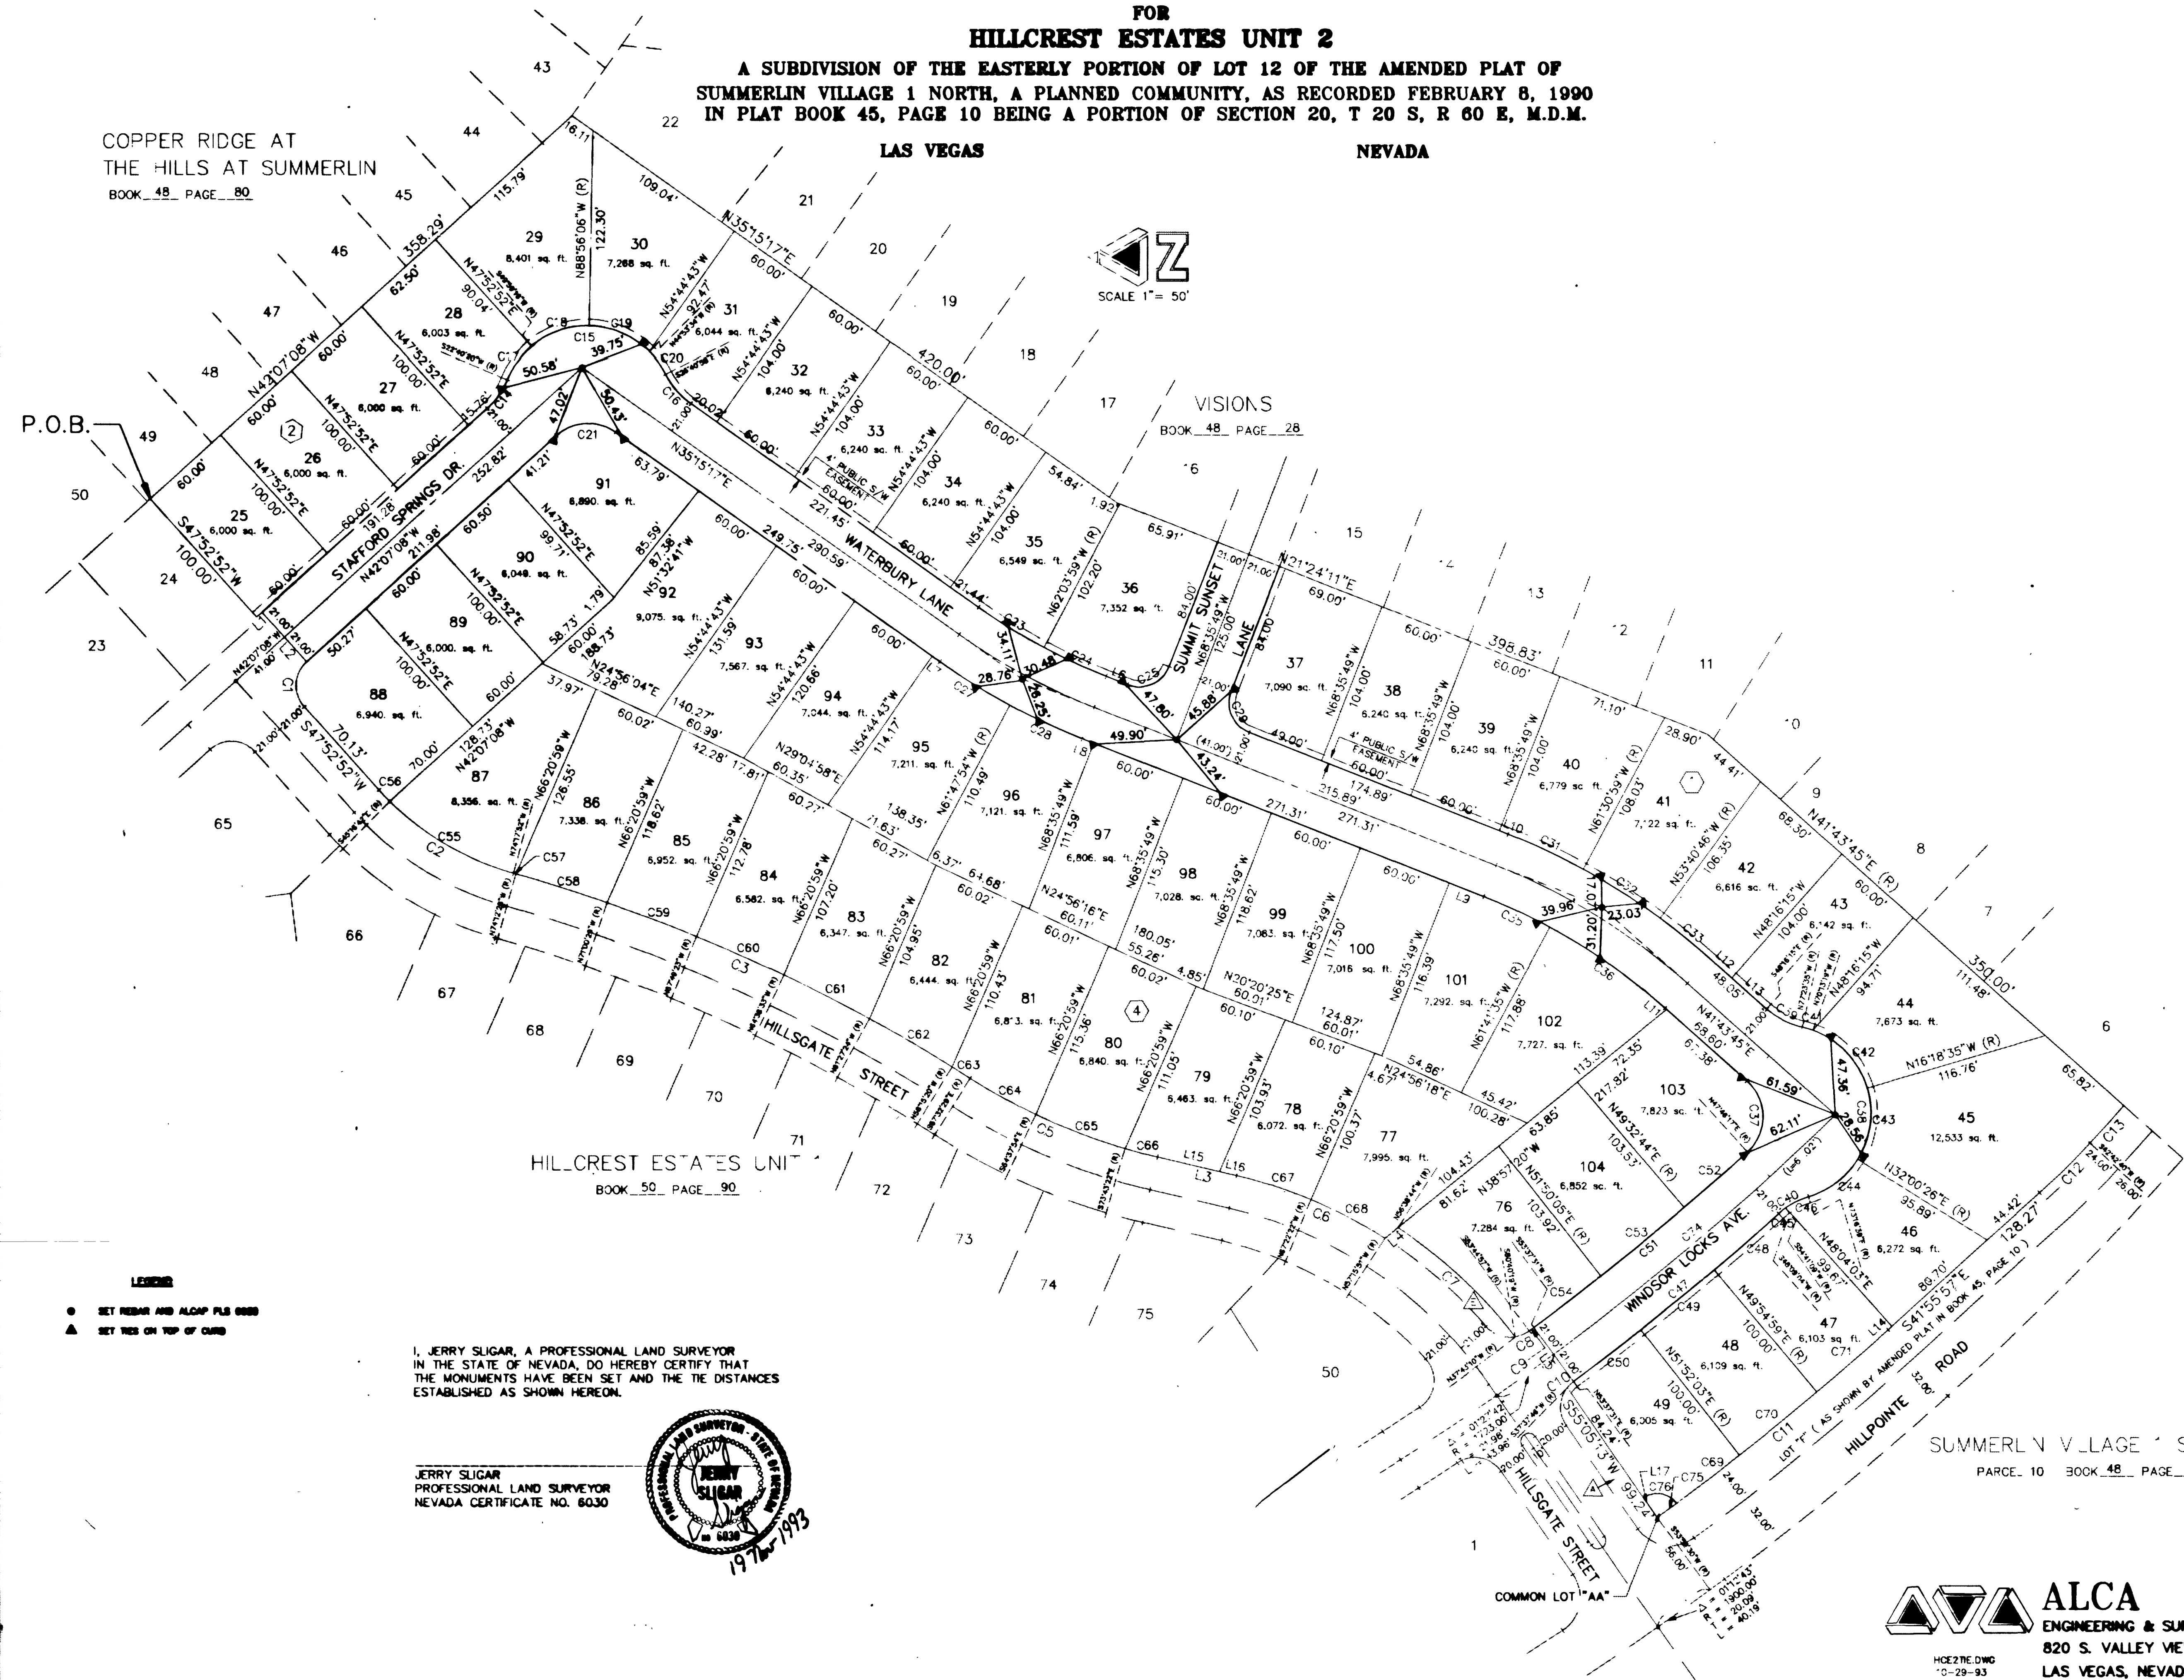

HILLCREST ESTATES UNIT
BOOK 50 PAGE 90


- LEGEND**
- SET NEAR AND ALONG PLB CURB
 - ▲ SET NEX ON TOP OF CURB

I, JERRY SLIGAR, A PROFESSIONAL LAND SURVEYOR
IN THE STATE OF NEVADA, DO HEREBY CERTIFY THAT
THE MONUMENTS HAVE BEEN SET AND THE DISTANCES
ESTABLISHED AS SHOWN HEREON.

JERRY SLIGAR
PROFESSIONAL LAND SURVEYOR
NEVADA CERTIFICATE NO. 6030



SUMMERLIN VILLAGE SOUTH
PARCE. 10 BOOK 48 PAGE 39

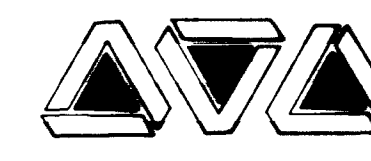

ALCA
ENGINEERING & SURVEYING, INC.
820 S. VALLEY VIEW BOULEVARD
LAS VEGAS, NEVADA 89107-4411

SHEET OF
BOOK PAGE
058-4193-2

2993 10-6-11

MONUMENTATION MAP




COPPER RIDGE AT
THE HILLS AT SUMMERHILL


SECTION

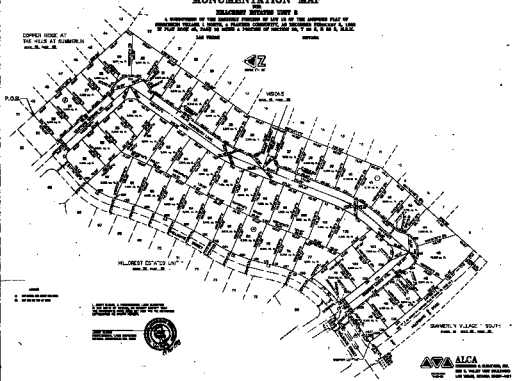




ATA ALCA

10-6-11