

GOWAN / FORT APACHE-PHASE 2 UNIT C

A PORTION OF THE SOUTHWEST QUARTER (SW 1/4) OF THE NORTHWEST QUARTER (NW 1/4)
OF SECTION 8, TOWNSHIP 20 SOUTH, RANGE 60 EAST, M.D.M.,
CITY OF LAS VEGAS, CLARK COUNTY, NEVADA

MONUMENTATION TIE MAP

CURVE TABLE

CURVE	RADIUS	LENGTH	TANGENT	DELTA
C1	16.50'	25.83'	16.42'	89°42'31"
C2	1576.00'	8.02'	4.01'	00°17'29"
C3	25.00'	38.71'	24.44'	88°42'30"
C4	26.50'	13.31'	6.80'	29°46'50"
C5	58.50'	37.05'	19.17'	36°17'18"
C6	58.50'	42.71'	22.36'	41°49'49"
C7	58.50'	47.64'	25.23'	46°39'26"
C8	58.50'	23.38'	11.85'	22°54'12"
C9	26.50'	13.02'	6.65'	28°09'24"
C10	58.50'	150.78'	201.88'	147°40'44"
C11	26.50'	41.77'	26.65'	90°19'08"
C12	16.50'	25.92'	16.50'	90°00'00"
C13	16.50'	25.92'	16.50'	90°00'00"
C14	1824.00'	72.34'	36.17'	02°16'20"
C15	1872.00'	35.85'	17.93'	01°05'50"
C16	1872.00'	24.57'	12.29'	00°45'07"
C17	1328.00'	28.43'	14.22'	01°13'36"
C18	1328.00'	61.56'	30.78'	02°39'21"
C19	1352.00'	91.62'	45.83'	03°52'58"
C20	1376.00'	93.24'	46.64'	03°52'58"
C21	1872.00'	60.42'	30.21'	01°56'57"
C22	1328.00'	89.99'	45.01'	03°52'58"
C23	1376.00'	56.59'	28.30'	02°21'24"
C24	1376.00'	36.65'	18.33'	01°31'34"
C25	1824.00'	23.14'	11.57'	00°43'37"
C26	1824.00'	49.20'	24.60'	01°32'43"
C27	1848.00'	83.57'	41.79'	02°35'28"
C28	1624.00'	73.44'	36.73'	02°35'28"
C29	1576.00'	106.80'	53.42'	03°52'58"
C30	1600.00'	72.35'	36.18'	02°35'28"
C31	1600.00'	100.29'	50.16'	03°52'58"
C32	1624.00'	101.79'	50.91'	03°52'58"
C33	1576.00'	71.27'	35.64'	02°35'28"
C34	1624.00'	48.06'	24.03'	01°41'45"
C35	1624.00'	25.38'	12.69'	00°53'43"
C36	1576.00'	35.20'	17.60'	01°16'46"
C37	1576.00'	71.60'	35.81'	02°36'11"
C38	1624.00'	89.52'	44.77'	03°09'31"
C39	1624.00'	12.27'	6.13'	00°25'58"
C40	54.00'	62.83'	35.51'	66°39'39"
C41	1576.00'	66.77'	33.39'	02°25'39"
C42	1576.00'	4.50'	2.25'	00°09'49"
C43	1624.00'	43.56'	21.78'	01°32'13"
C44	1624.00'	4.50'	2.25'	00°09'32"
C45	1624.00'	84.94'	42.48'	02°59'48"
C46	1624.00'	4.58'	2.29'	00°09'42"
C47	54.00'	20.78'	10.52'	22°02'51"
C48	54.00'	83.61'	52.80'	88°42'30"

COURSE TABLE

LINE	DIRECTION	DISTANCE
L1	S01°33'38"E	56.16'
L2	S00°16'09"E	53.51'
L3	S00°33'38"E	48.00'
L4	N89°43'51"E	3.52'
L5	N88°26'22"E	40.50'
L6	S89°43'51"W	4.54'
L7	N01°33'38"W	22.43'
L8	S89°43'51"W	2.00'
L9	S86°33'45"W	6.35'
L10	S46°27'01"E	29.76'
L11	N43°32'38"E	26.91'
L12	S09°49'43"W	9.81'
L13	S01°33'38"E	12.11'
L14	N01°33'38"W	4.59'
L15	N89°43'51"E	28.35'
L16	N88°26'22"E	40.50'
L17	S89°43'51"W	5.52'
L18	N89°43'51"E	0.98'
L19	S00°16'09"E	4.50'
L20	N44°41'21"E	29.72'
L21	N01°33'38"W	28.35'

RADIAL LINE TABLE




LINE	DIRECTION	PCC
R1	N01°33'38"W	PCC
R2	N01°43'27"W	PRC
R3	N04°09'06"W	PRC
R4	S03°43'08"E	PRC
R5	S04°09'06"E	PRC
R6	S01°33'38"E	PRC
R7	N01°43'10"W	PRC
R8	S04°09'06"E	PRC
R9	N01°52'46"W	PRC
R10	S04°09'06"E	PRC
R11	N62°46'49"W	PRC
R12	N07°33'21"W	PRC
R13	N30°27'33"W	PRC
R14	N02°18'09"W	PRC
R15	S04°09'06"E	PRC
R16	S02°55'30"E	PRC
R17	S00°43'20"E	PRC
R18	S21°46'42"W	PRC

NOTES

- PURSUANT TO NRS 278.371 ALL REAR LOT CORNERS SHALL BE SET WITH A NAIL AND TAG "P.L.S. 8421" ON BLOCK WALL AND ALL FRONT OR SIDE LOT CORNERS ADJOINING RIGHT-OF-WAY SHALL BE MARKED BY THE SAWCUTTING OF THE BACK OF CURBS ON THE PROLONGATION OF THE PROPERTY LINES.
- DIRECT VEHICULAR ACCESS TO FORT APACHE ROAD AND GOWAN ROAD FROM ABUTTING LOTS IS PROHIBITED.



ACT	DATE	BY	REVISION

FOUND 3" BLM BRASS CAP 1957

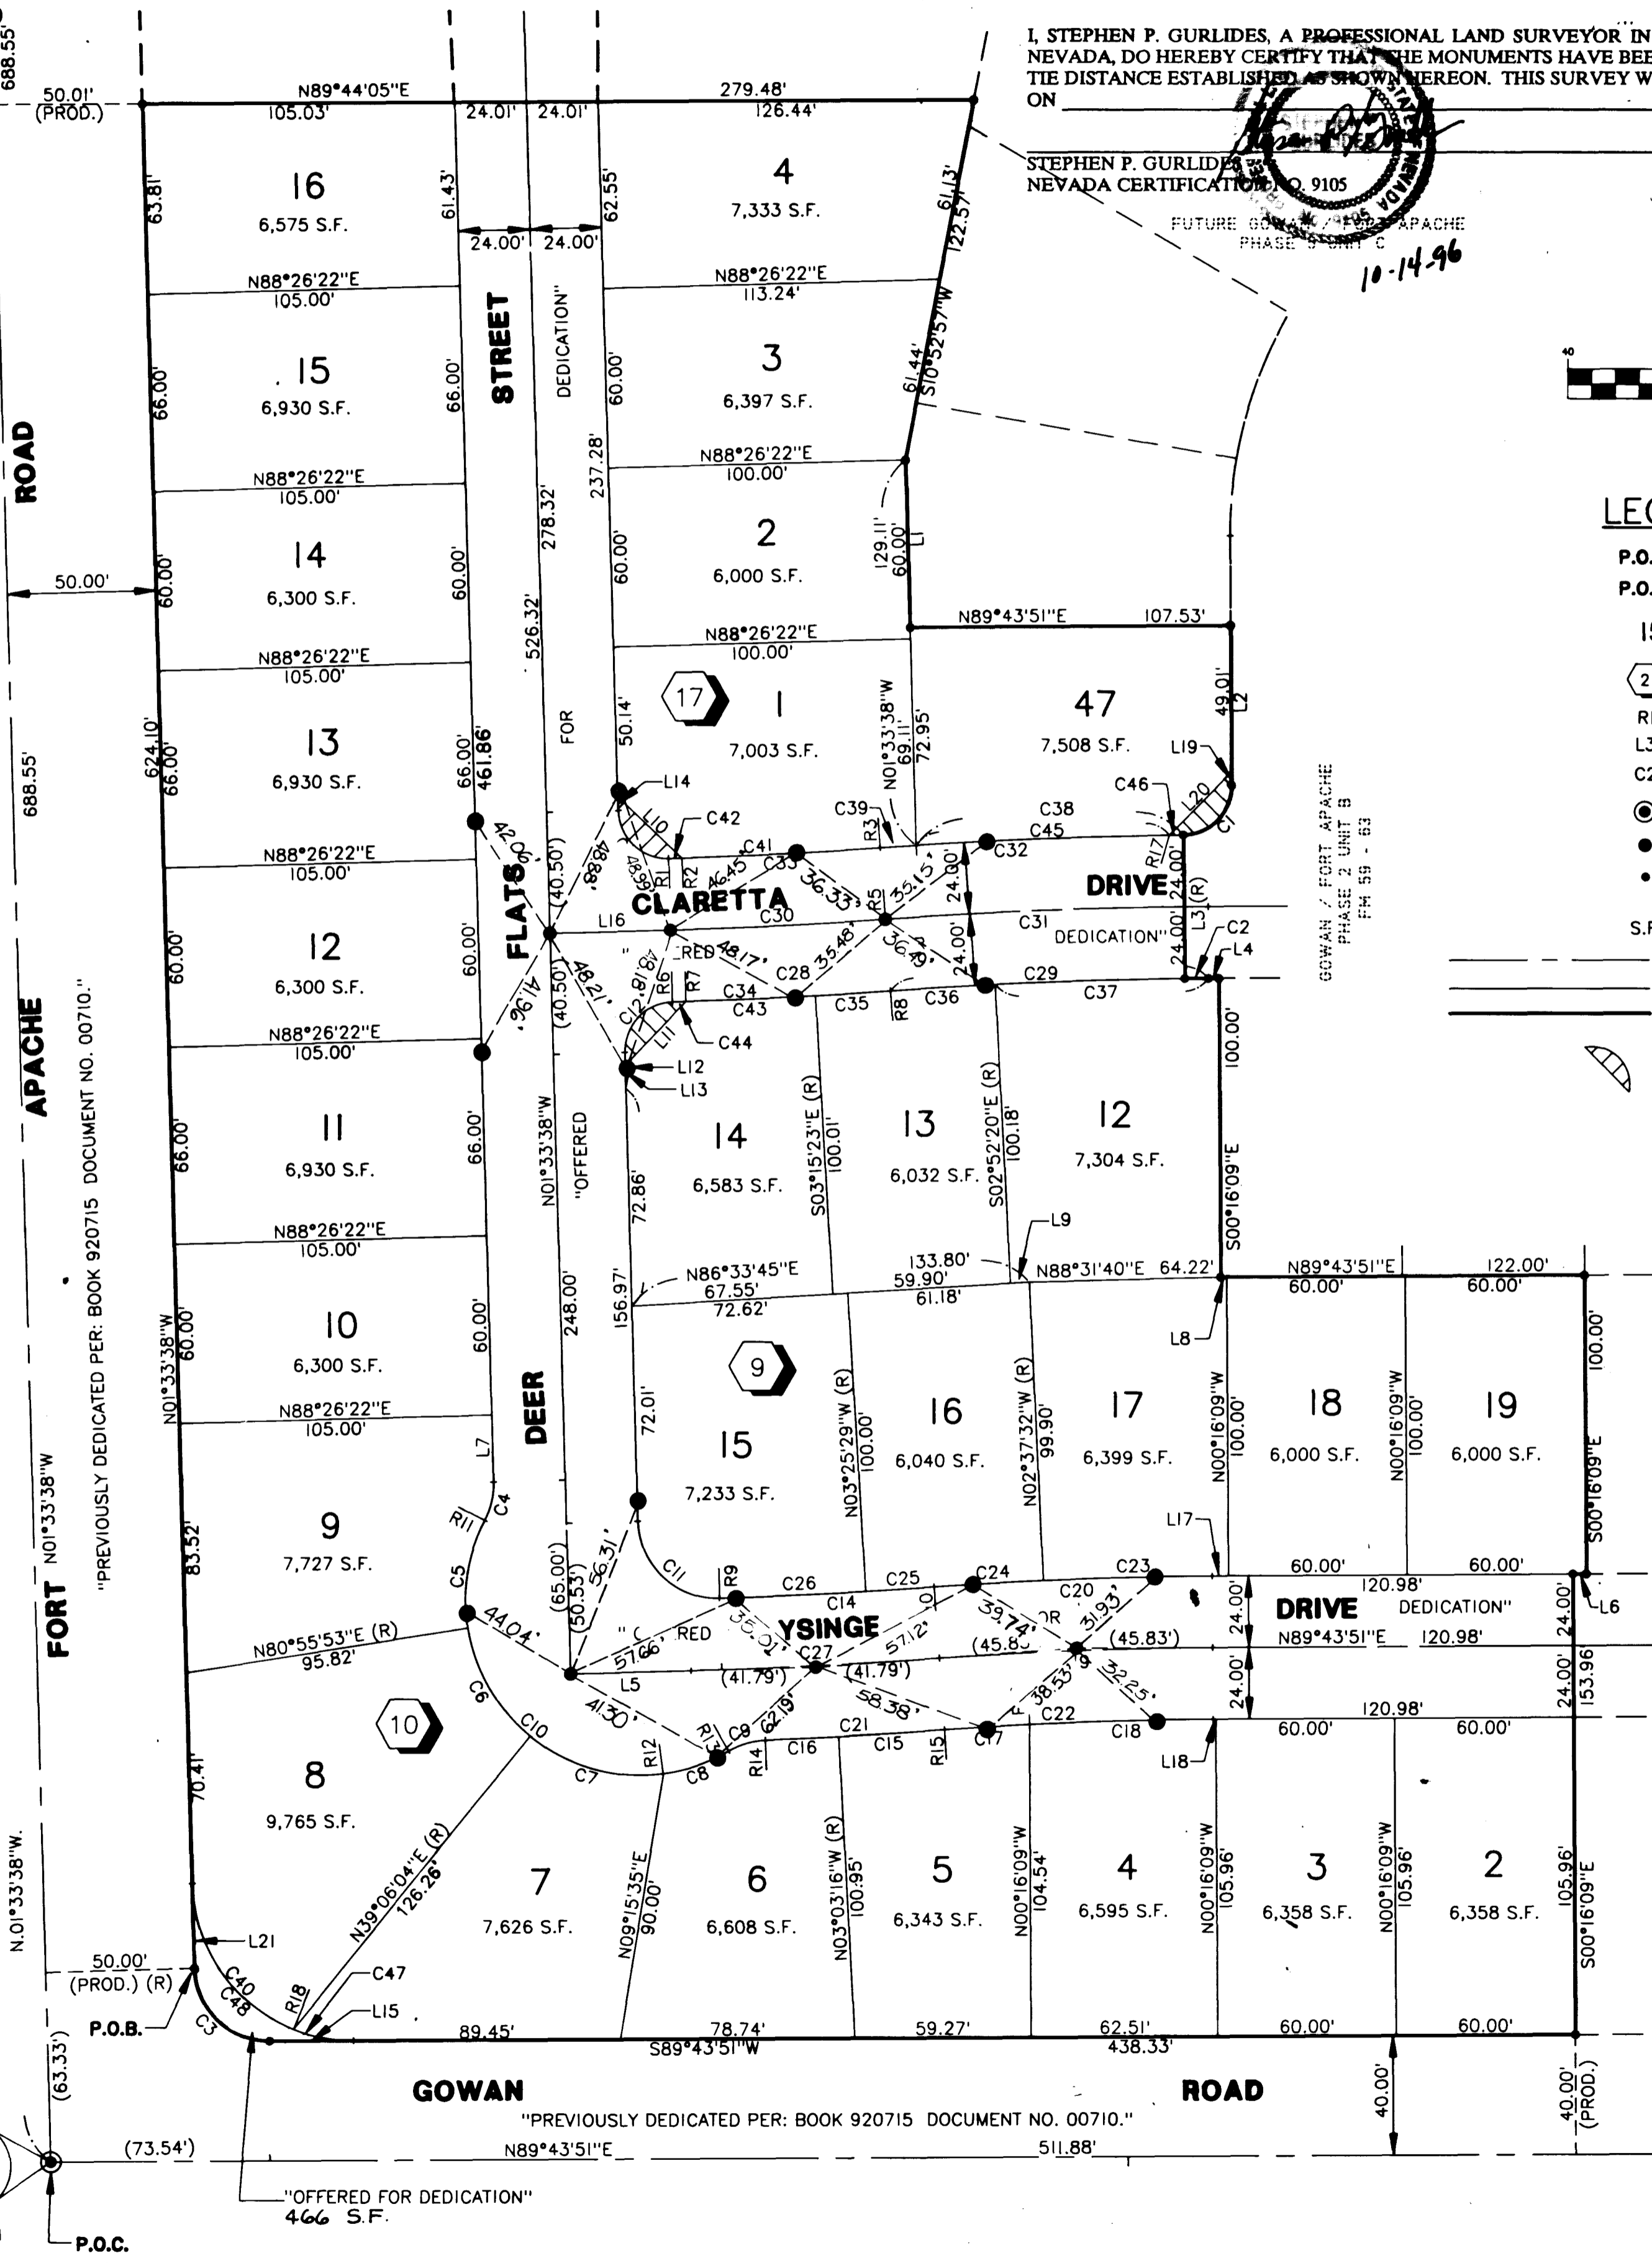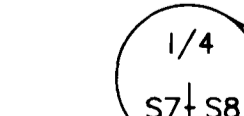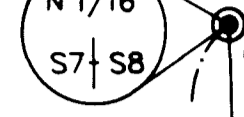

I, STEPHEN P. GURLIDES, A PROFESSIONAL LAND SURVEYOR IN THE STATE OF NEVADA, DO HEREBY CERTIFY THAT THE MONUMENTS HAVE BEEN SET AND THE TIE DISTANCE ESTABLISHED AS SHOWN HEREON. THIS SURVEY WAS COMPLETED ON 10-14-96

STEPHEN P. GURLIDES
NEVADA CERTIFICATION NO. 9105

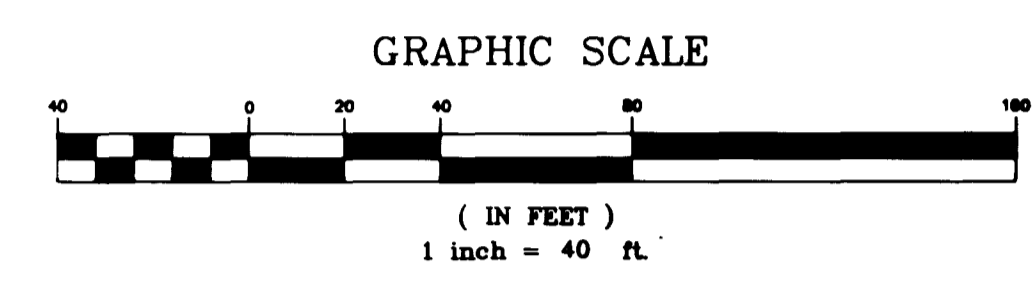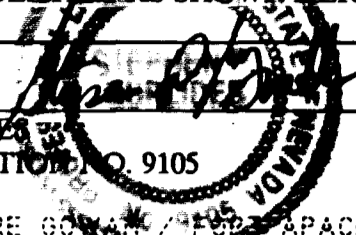

LEGEND

- P.O.C. POINT OF COMMENCEMENT
- P.O.B. POINT OF BEGINNING
- 15 LOT NUMBER / RESIDENTIAL = 28
- 2 BLOCK NUMBER
- R1 RADIAL LINE NUMBER
- L3 COURSE NUMBER
- C2 CURVE NUMBER
- FOUND MONUMENT AS DESCRIBED
- SET TYPE III MONUMENT - "VTN PLS 9105"
- SET NAIL & BRASS TAG "PLS 8421" OR SAWCUT TOP OF CURB ON PROLONGATION OF PROPERTY LINES, PER NOTE 1
- S.F. SQUARE FEET
- CENTERLINE
- LOT LINE
- BOUNDARY LINE
- SIGHT VISIBILITY RESTRICTION EASEMENT PER LAS VEGAS SUBDIVISION ORDINANCE AS SHOWN ON STANDARD DRAWING #404.1600.

GOWAN / FORT APACHE PHASE 2 UNIT A EM 58 - 64

2674

Book 68 Page 2

GOWAN / FORT APACHE - PHASE 2 UNIT C


















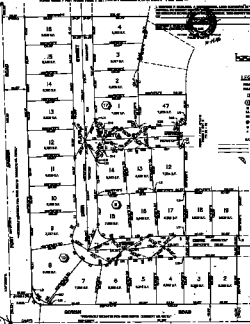


