INDIAN MELLS CONDOMINIUMS

BEING A PORTION OF THE NORTHWEST QUARTER (NW 1/4) OF THE NORTHWEST QUARTER (NW 1/4) OF THE SOUTHWEST QUARTER (SW 1/4) OF SECTION 22, TOWNSHIP 20 SOUTH, RANGE 60 EAST, M.D.M., CITY OF LAS VEGAS, CLARK COUNTY, NEVADA.

MONUMENT TIE MAP

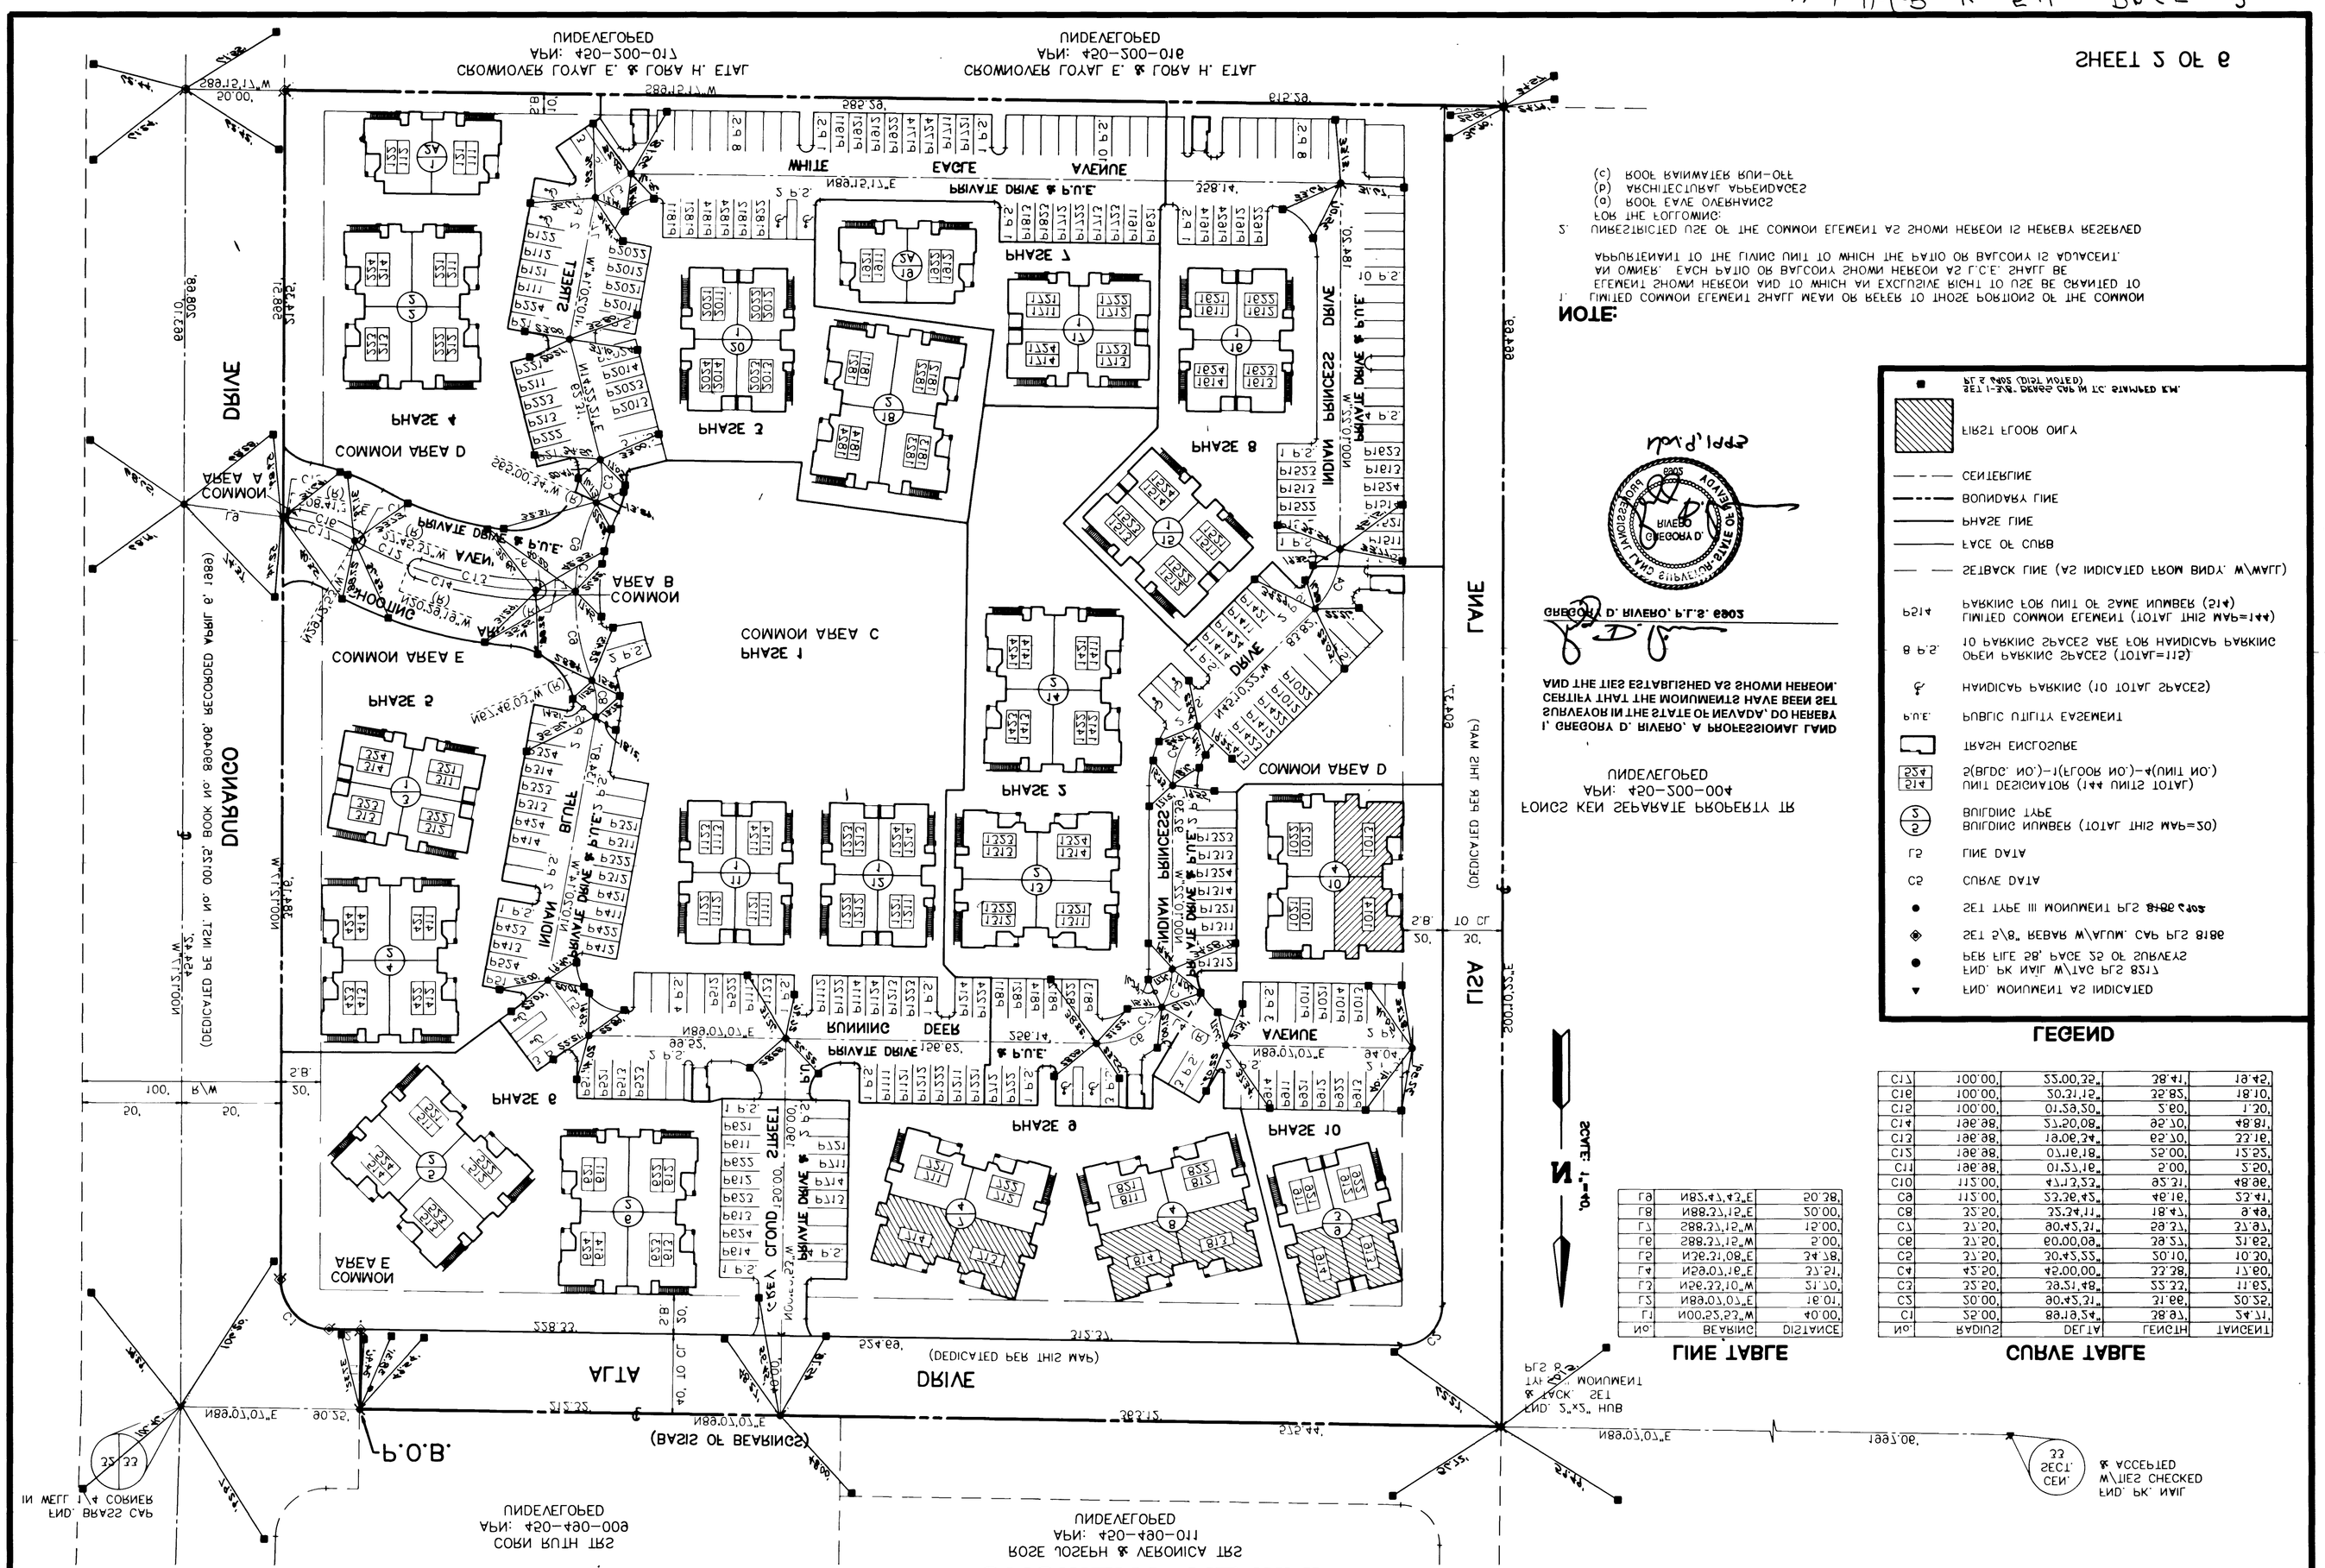

LINE TABLE

NO.	BEARING	DISTANCE

INDIAN WELLS CONDOMINIUMS


MONUMENT TIE MAP

LANE
DRIVE
WAY
DURANGO
COMMON AREA C
COMMON AREA B
COMMON AREA D
COMMON AREA E
