


- MONUMENT LEGEND
- ⊙ FOUND MONUMENT AS DESCRIBED
  - FOUND REFERENCE MONUMENT
  - ◊ SET TYPE I MONUMENT
  - SET TYPE II MONUMENT
  - ▲ SET TYPE III MONUMENT
  - SET TYPE IV MONUMENT

I, DANNY L. RIDER JR., A PROFESSIONAL LAND SURVEYOR IN THE STATE OF NEVADA DO HEREBY CERTIFY THAT THE MONUMENTS HAVE BEEN SET, AND THE DISTANCES HAVE BEEN ESTABLISHED AS SHOWN HEREON. THIS SURVEY WAS COMPLETED ON JULY 10, 1996.

*Danny L. Rider*  
 DANNY L. RIDER JR., PLS/  
 NEVADA CERTIFICATE NO. 7169

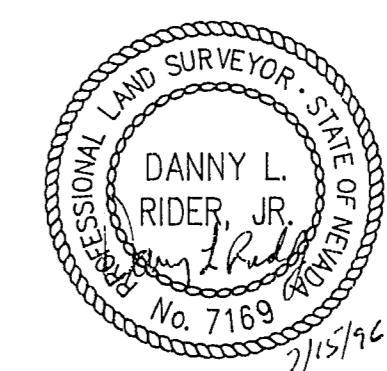

CENTERLINE TIE PLAN PORTION OF LOT 1, FINAL MAP OF ROCK SPORT SUBDIVISION, A COMMERCIAL SUBDIVISION BOOK 67, PAGE 29, CLARK COUNTY RECORDER NW 1/4, SECTION 4, T21S, R80E, M.D.M. CITY OF LAS VEGAS, CLARK COUNTY, NEVADA			
<b>GREAT WEST          SURVEYING, INC.</b> <small>2245 NORTH DECATUR BOULEVARD SUITE D          LAS VEGAS, NEVADA 89108          (702) 646-4641 FAX: 646-3393</small>			
DRAWN BY:	DWG NAME:	JOB #	
CHECKED BY:	DWG DATE:		
SECTION	TOWNSHIP	SOUTH, RANGE	EAST, M.D.M. SHEET OF

058-4399