
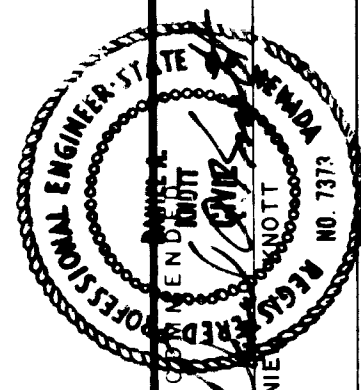


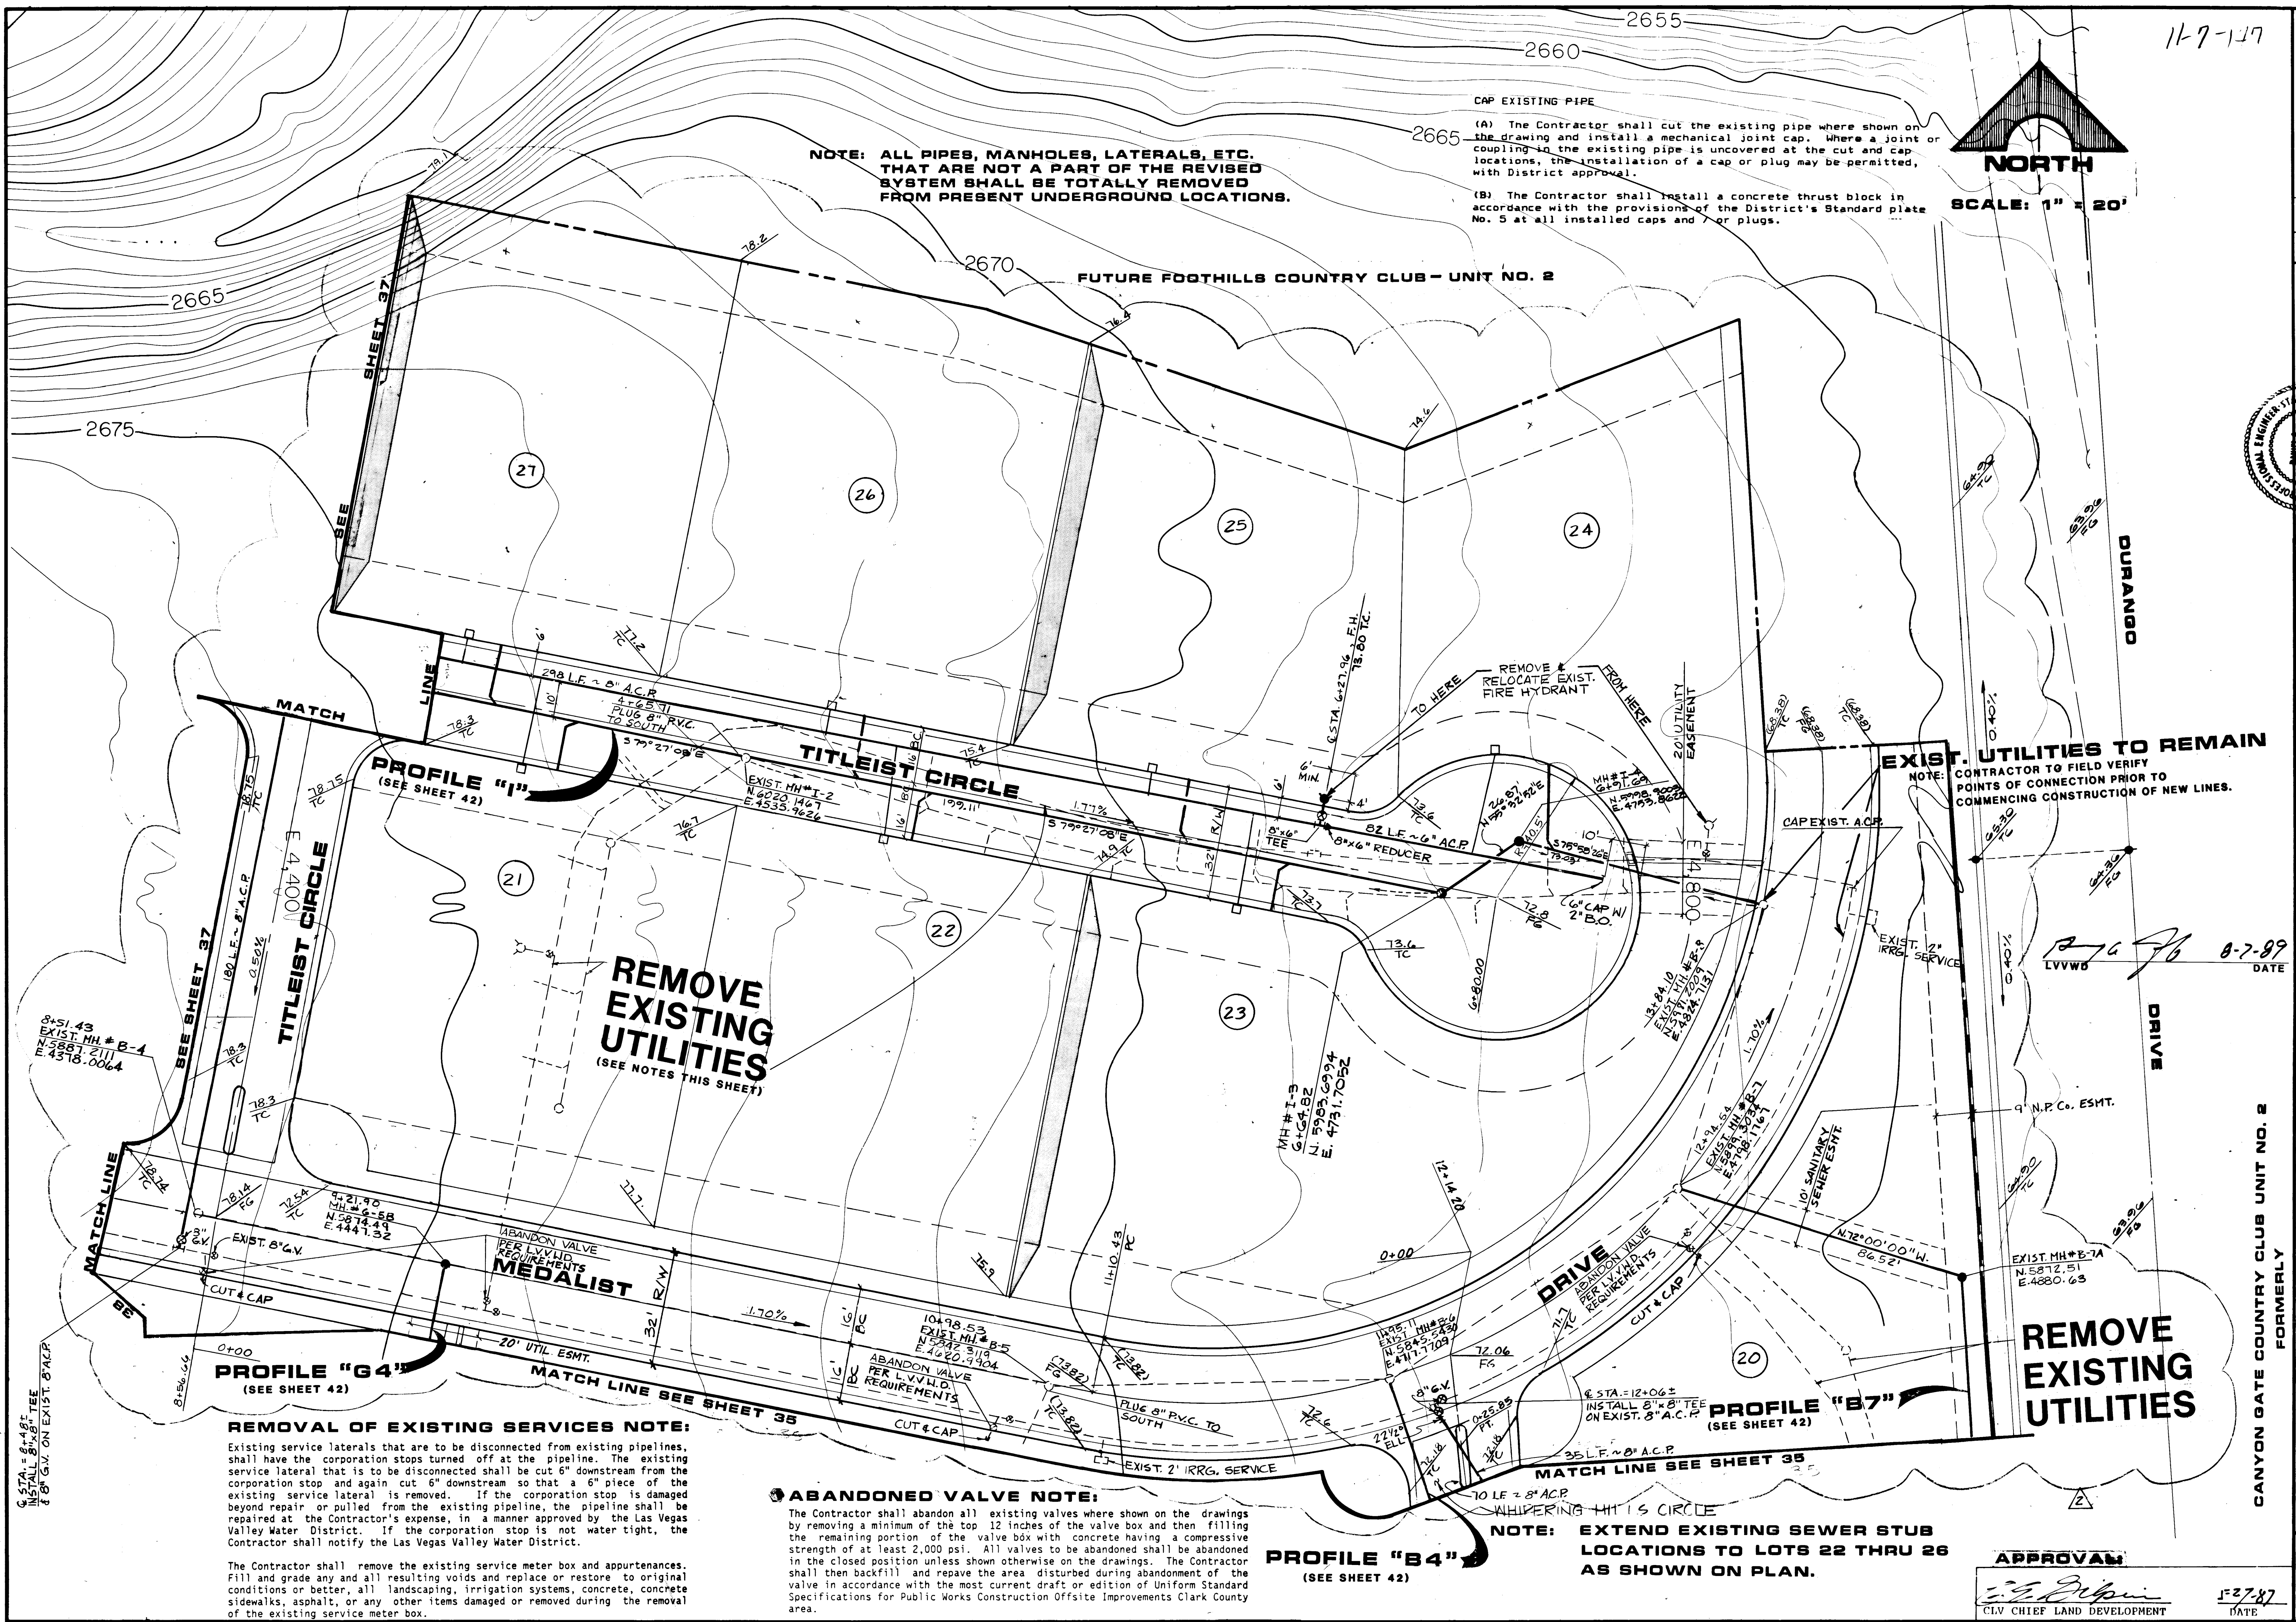

1555 SOUTH RAINBOW BLVD. LAS VEGAS, NEVADA 89102

G.C. WALLACE, INC.
Engineering/Architecture

CANYON GATE COUNTRY CLUB UNIT NO. 2
FORMERLY
FOOTHILLS COUNTRY CLUB UNIT NO. 1
AT PECOLLE RANCH
UTILITY PLANS - UNIT NO. 1
FAIRWAY ESTATES

SHEET
36
OF 52 SHEETS

