


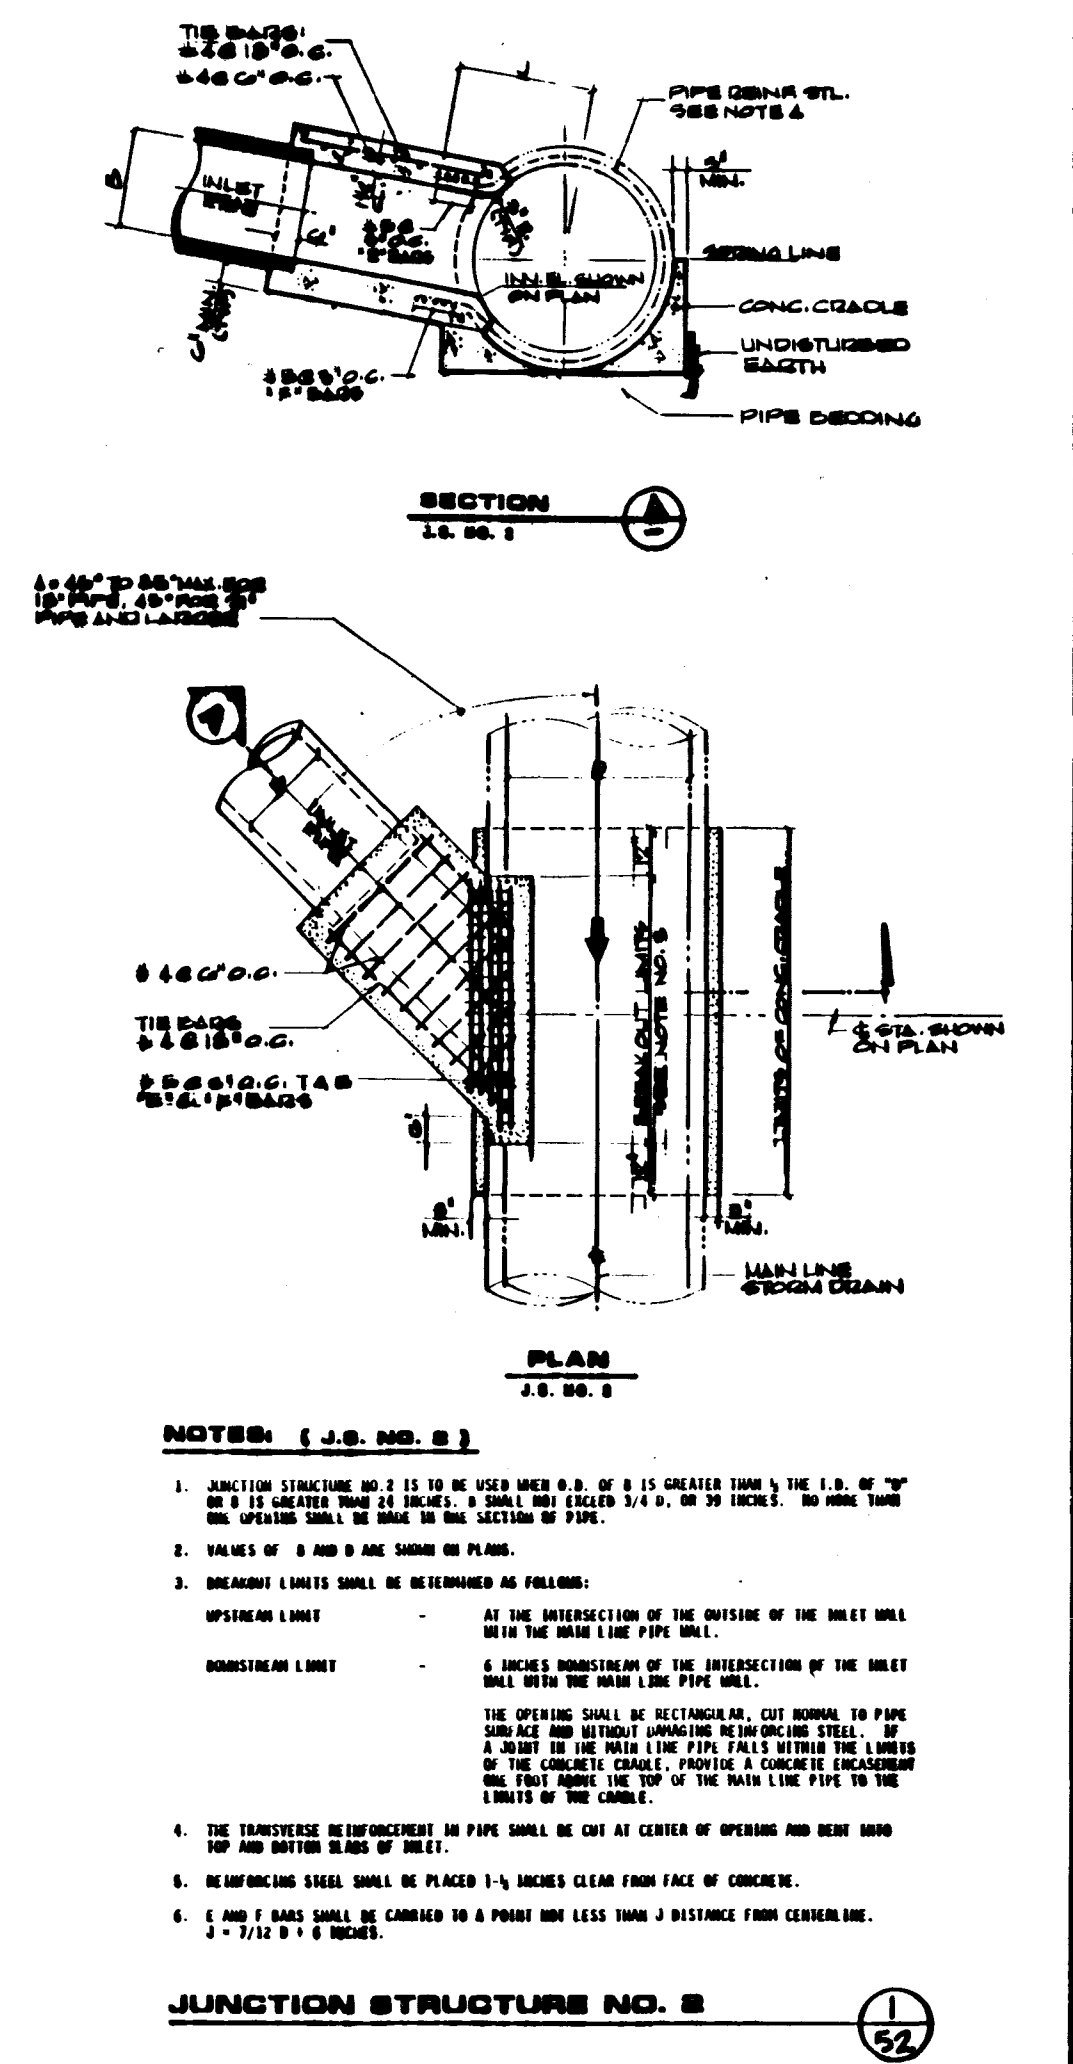
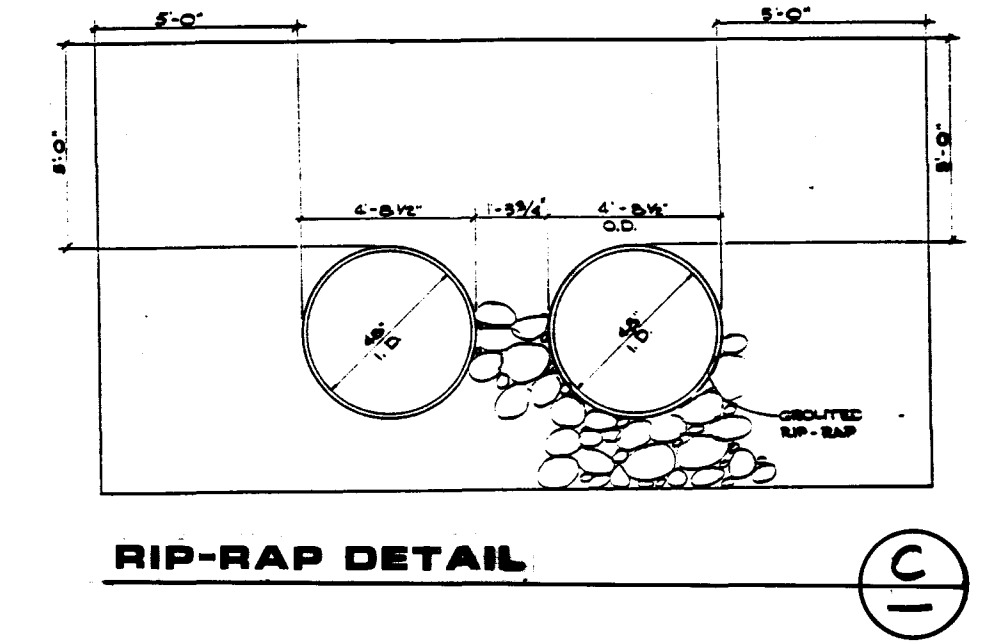
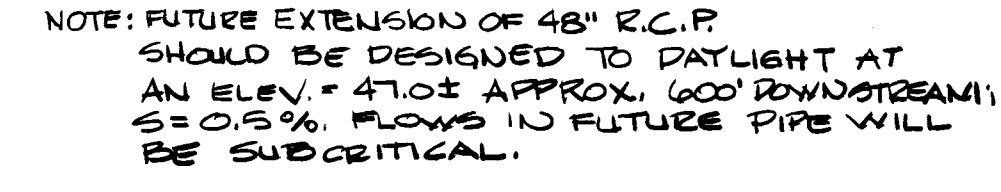
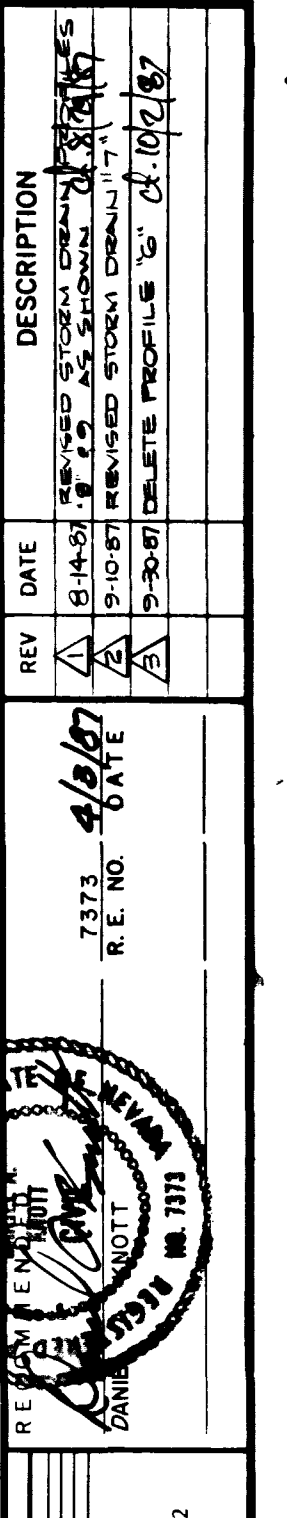


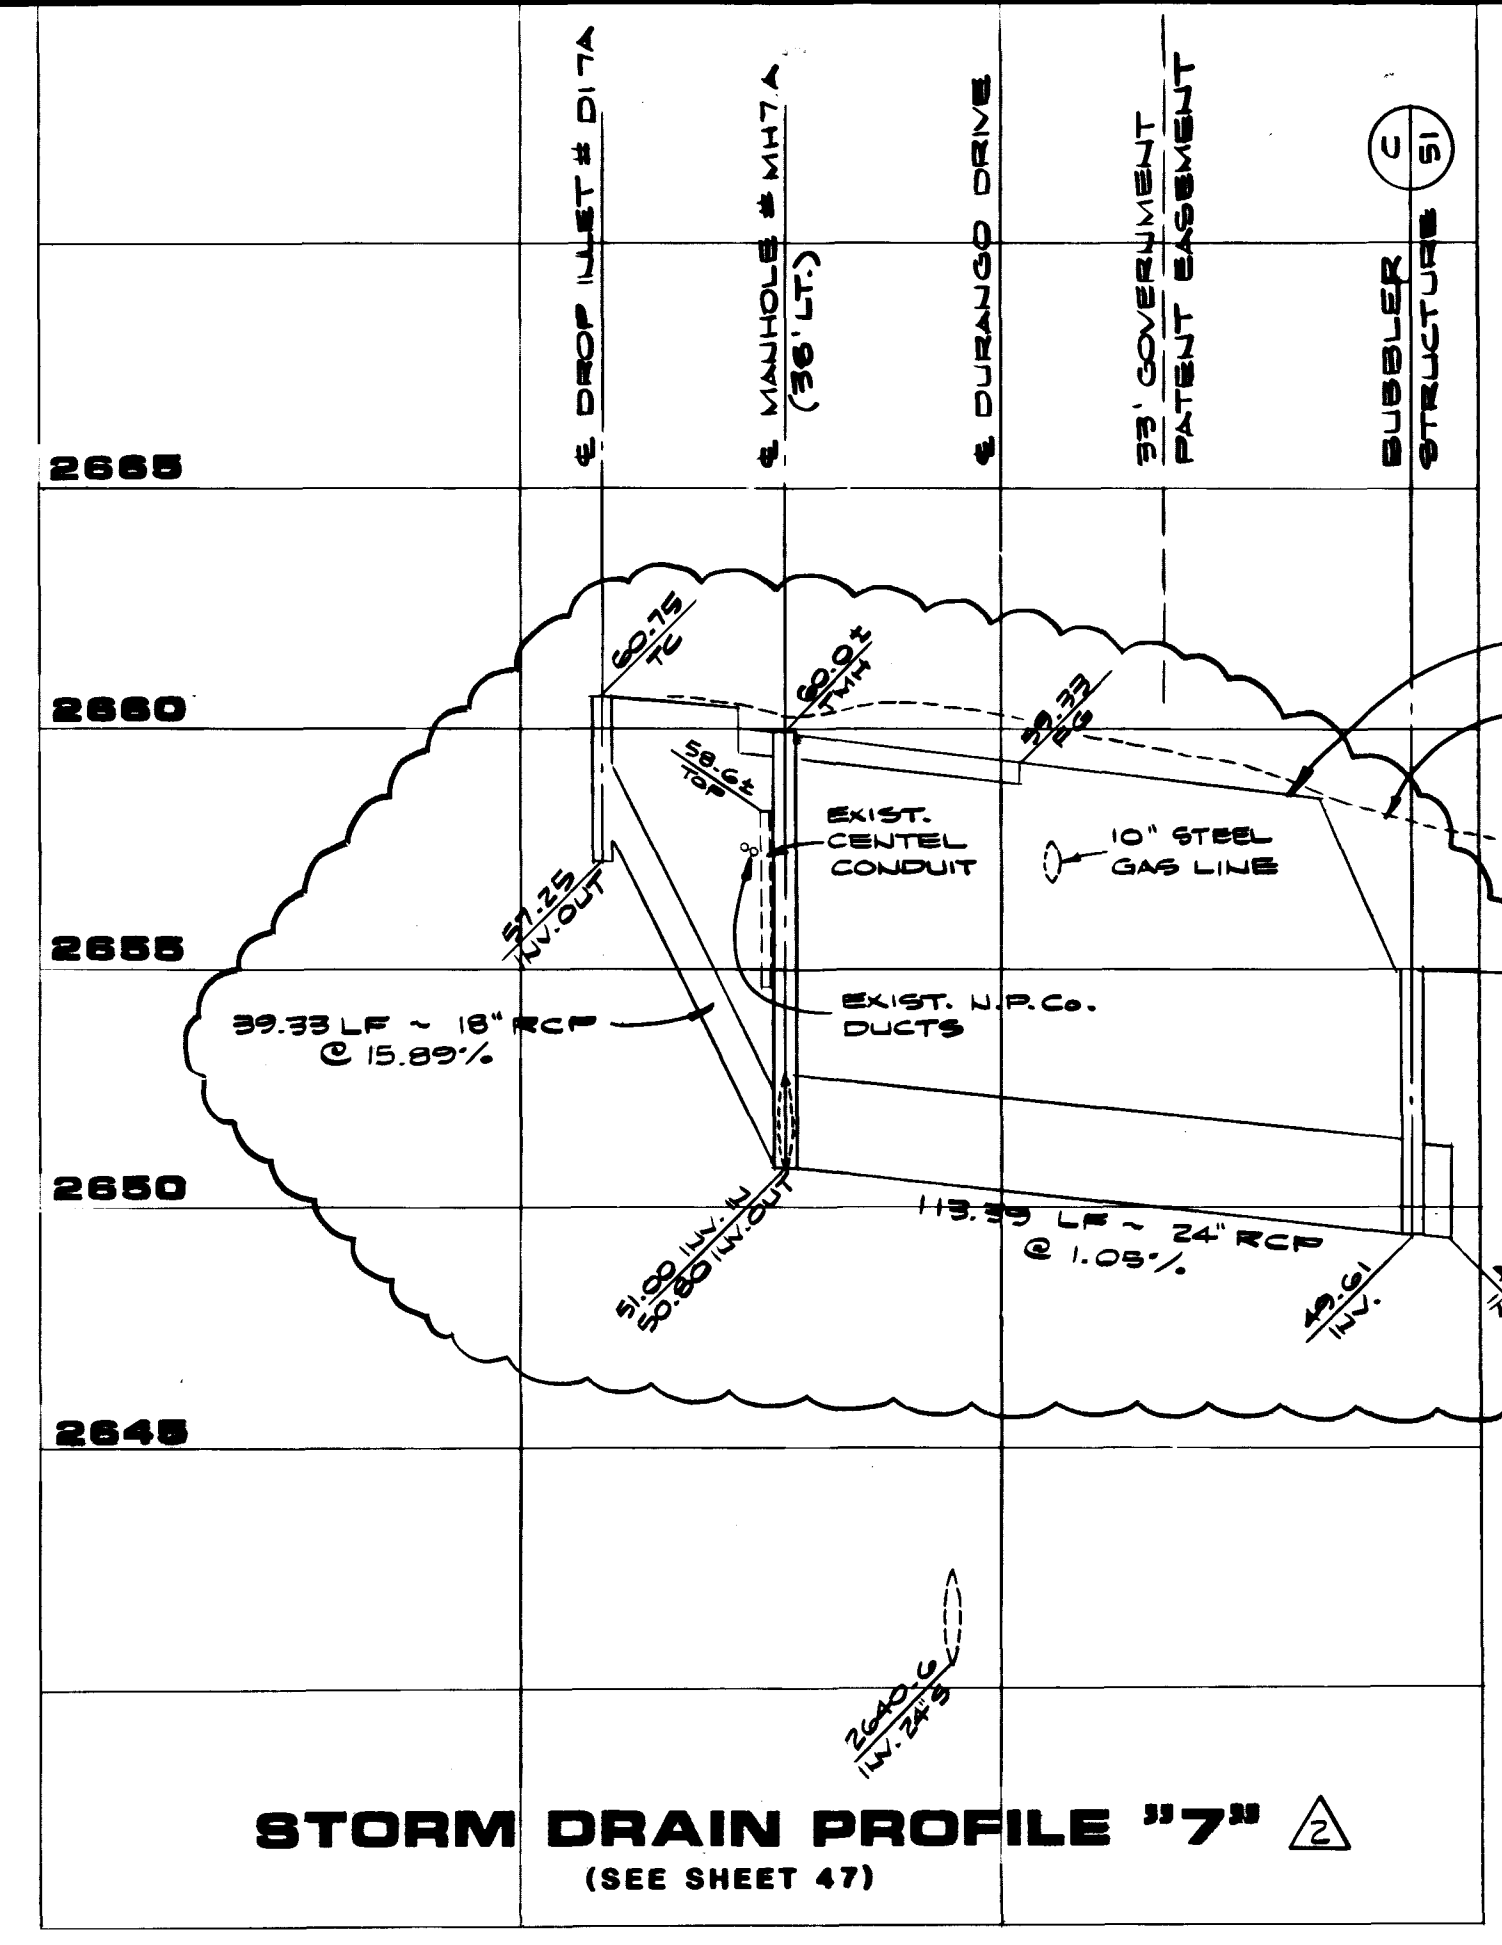


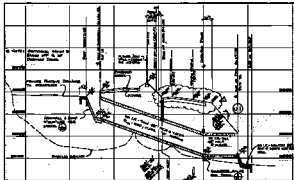


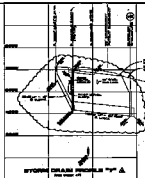


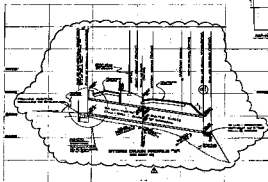





[illegible]