


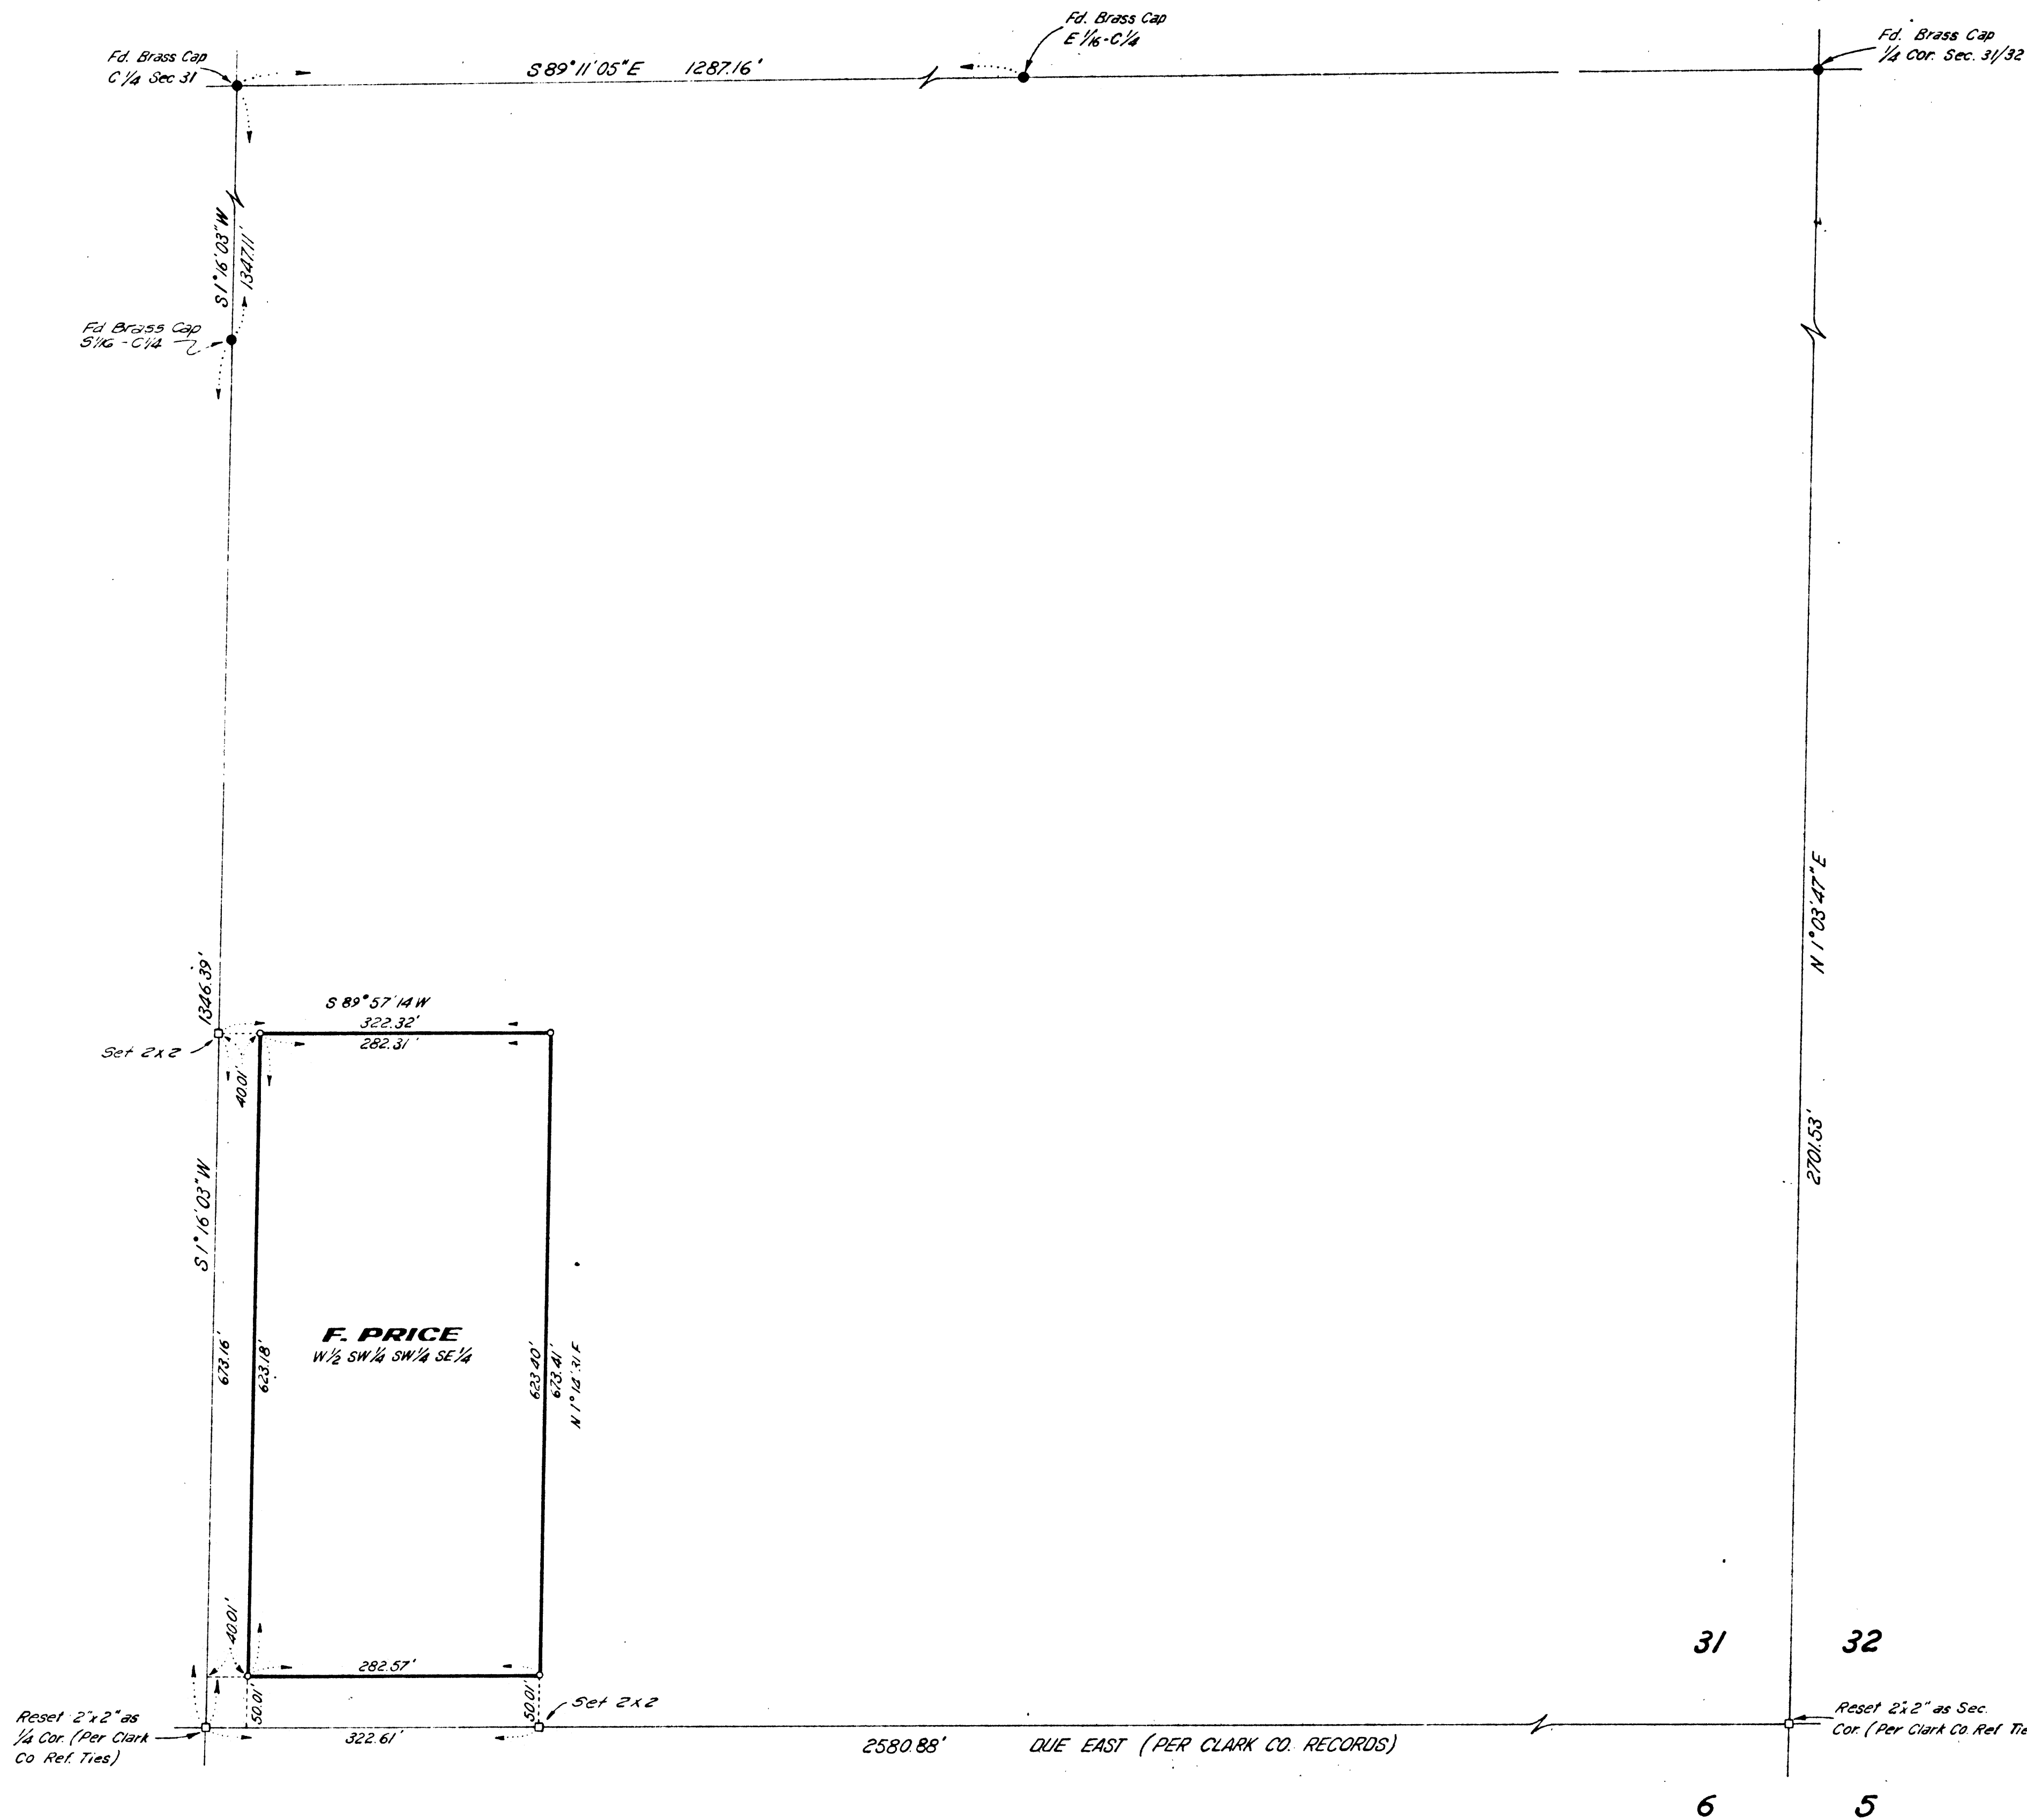

CERTIFICATE

I, RALPH L. KRAEMER, A DULY REGISTERED PROFESSIONAL ENGINEER AND LICENSED LAND SURVEYOR, STATE OF NEVADA, DO HEREBY CERTIFY THAT THIS MAP CORRECTLY DELINEATES A SURVEY DONE BY ME AT THE INSTANCE OF F. PRICE; THAT THE SURVEY HAS BEEN DONE IN STRICT ACCORDANCE WITH APPLICABLE LAWS AND IS NOT INTENDED TO BE A SUBDIVISION. THIS SURVEY WAS COMPLETED MAY 31, 1969.

Ralph L. Kraemer
RALPH L. KRAEMER
R.P.E. - R.L.S. 1096-1349

765270

FILED AT THE REQUEST OF
RALPH L. KRAEMER
Date **6-2-69** at **12:11 P.M.**
FILE **19** PAGE **29**
of Survey
OFFICIAL RECORDS BOOK NO. **953**
CLARK COUNTY, NEVADA, RECORDS
PAUL E. HORN, RECORDER
Page **2.50** E.M. Deputy

**MAP FOR RECORD
OF SURVEY**
PREPARED FOR
F. PRICE
W 1/2 SW 1/4 SW 1/4 SE 1/4 SEC 31, T. 19 S., R. 60 E.,
M.D.B.F.M.
COUNTY OF CLARK
STATE OF NEVADA