


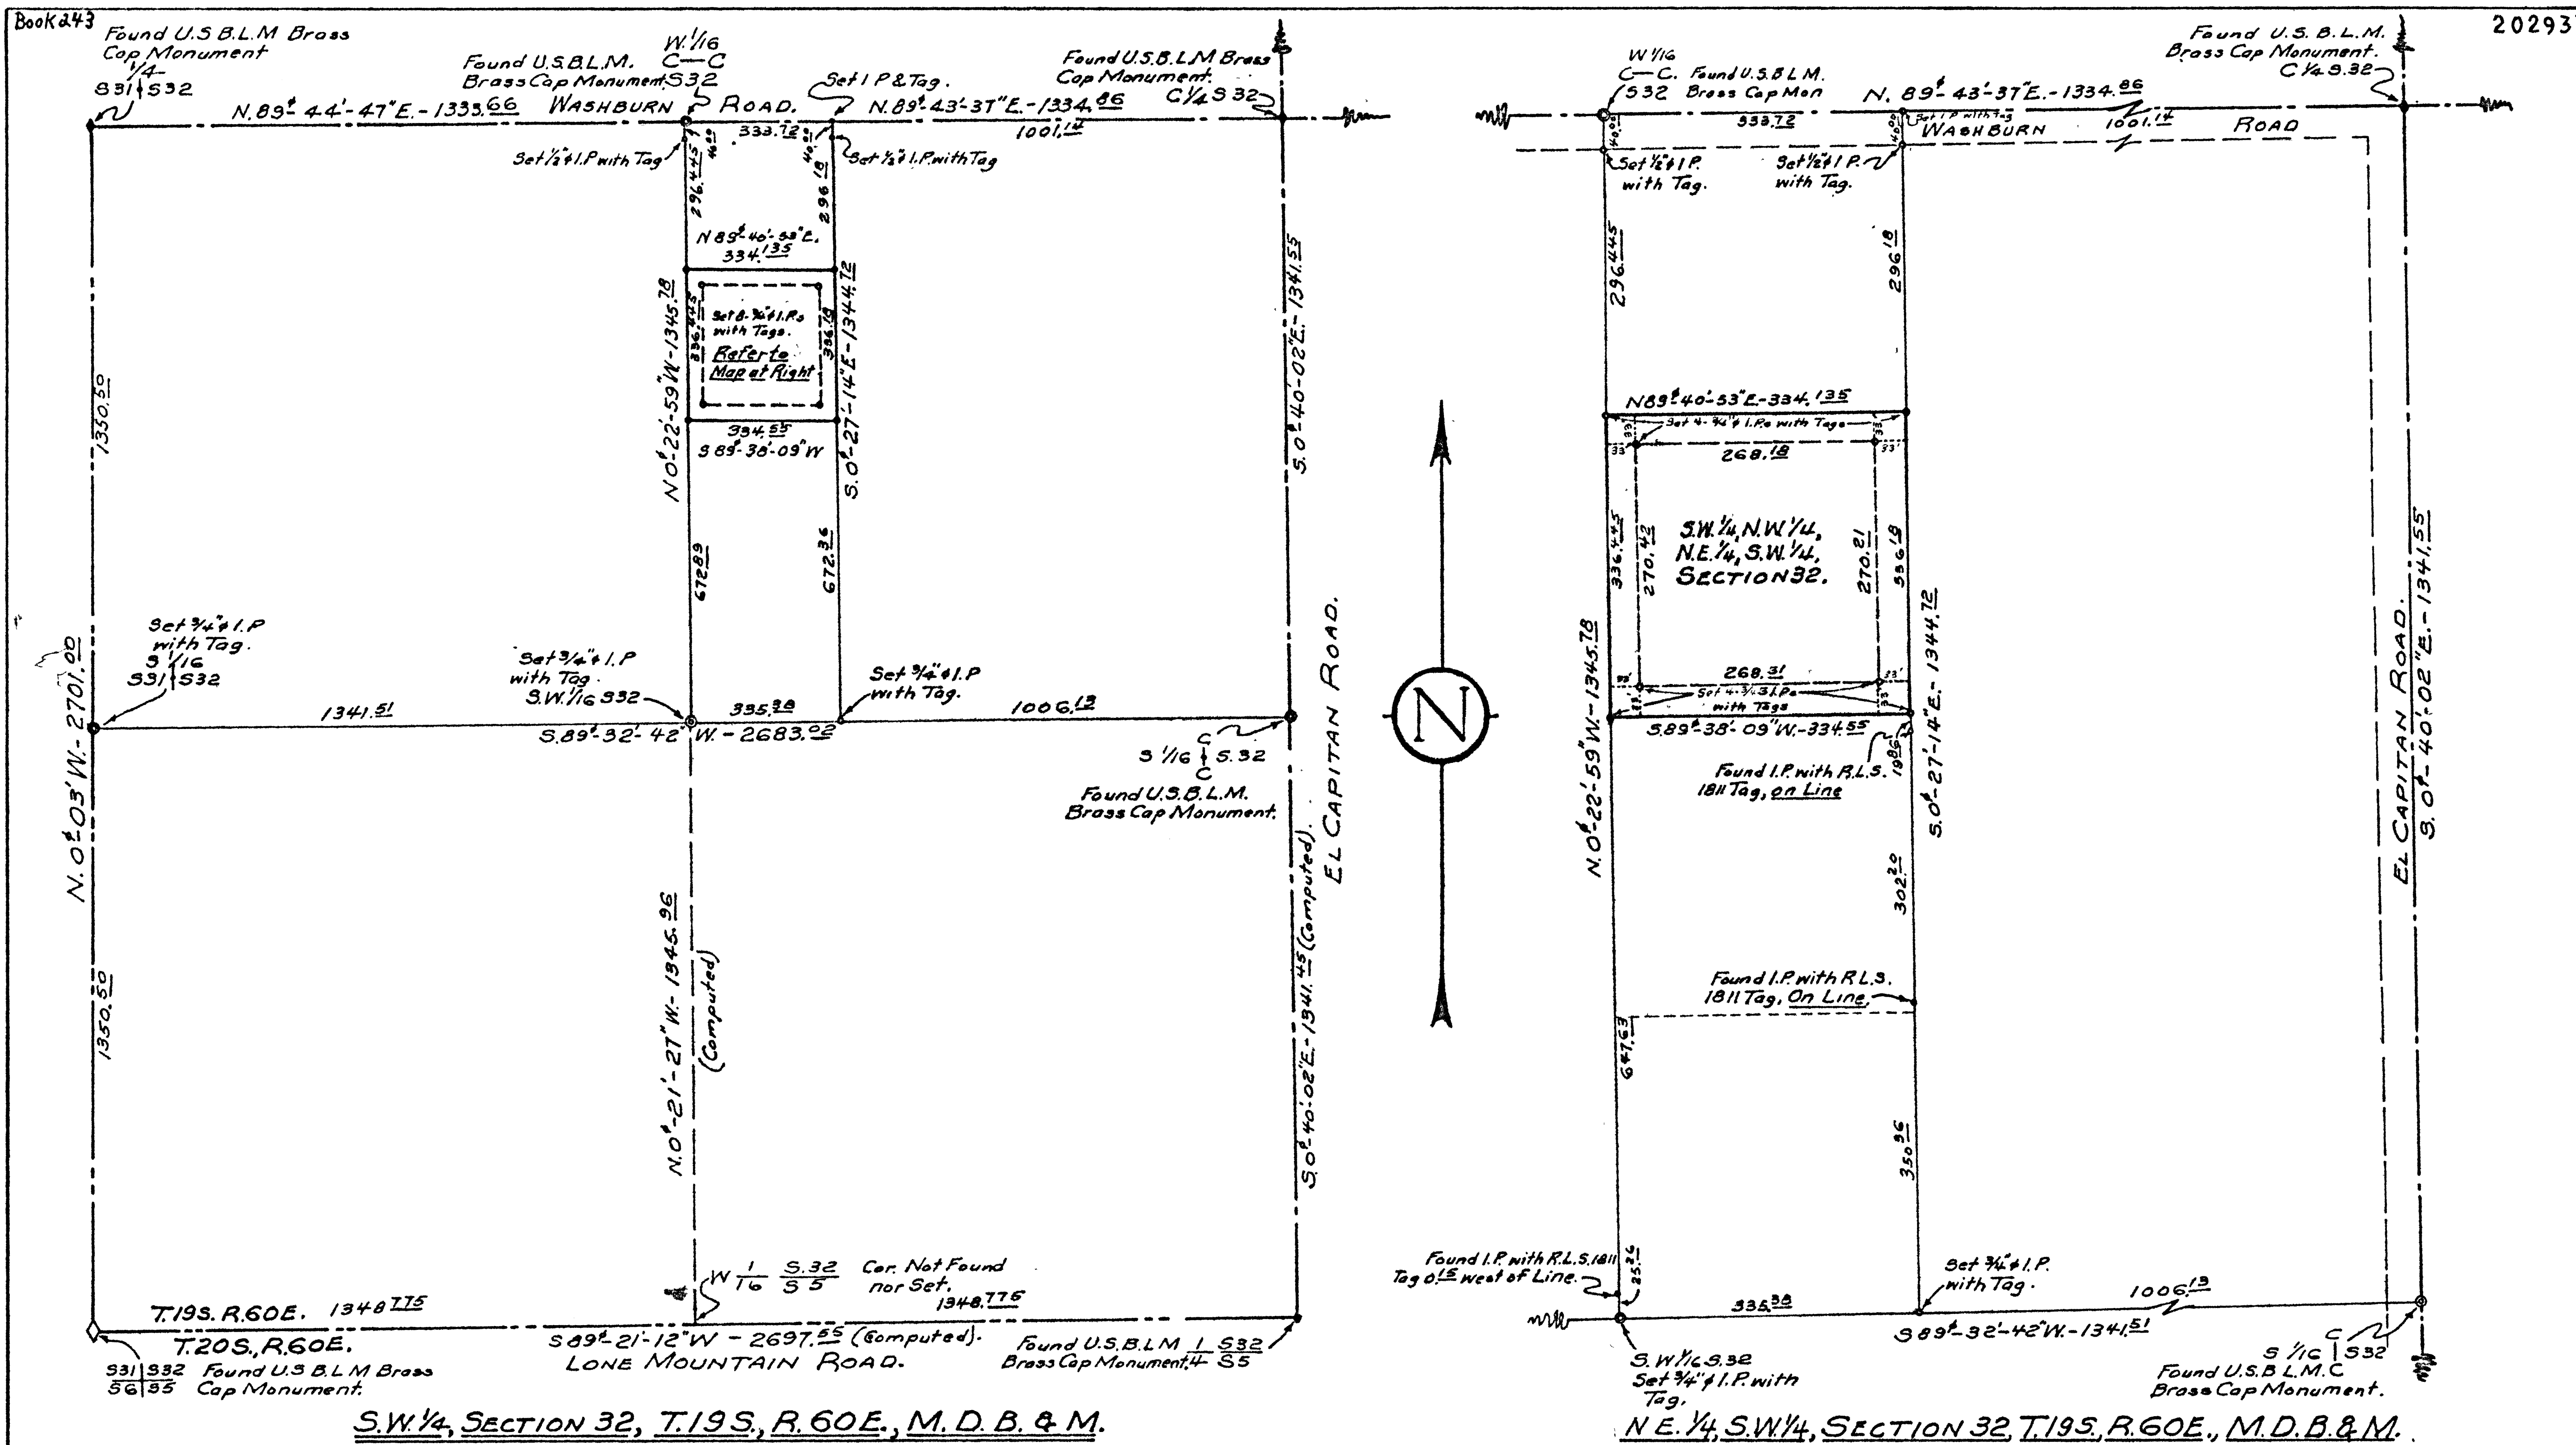

BASIS OF BEARINGS:


The basis of Bearings for this survey was the west boundary line of the S.W. 1/4 of Section 32, T.19S, R.60E, M.D.B. & M. which bears N. 0° 03' W. on the U.S. B.L.M. Plat of T.19S, R.60E, M.D.B. & M. dated March 24, 1959.

ENGINEER-SURVEYOR'S CERTIFICATE:

I, Ernest H. Clary, P.E., Land Surveyor, in the state of Nevada, do hereby certify that I have surveyed the parcels of land portrayed on this map at the instance of Glade & Helen Smith and Robert & Tona Duncan; that this map shows correctly the physical conditions portrayed thereon and the monuments shown thereon are sufficient to enable this survey to be retraced; that the particular parcel surveyed lies within the SW 1/4 of the NW 1/4 of the NE 1/4 of the S.W. 1/4 of Section 32, T.19S, R.60E, M.D.B. & M., Nevada.

This survey was completed on June 7, 1972 and is not intended to be a subdivision as defined by Nevada Law.

Ernest H. Clary
Ernest H. Clary,
Civil, Geological, Land Surveyor,
State Water Right Surveyor.

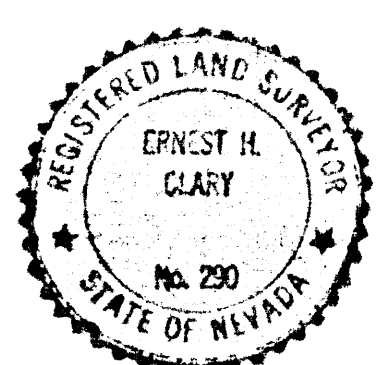

No. 202933	MAP FOR RECORD OF SURVEY FOR
FILED AT THE REQUEST OF	GLADE & HELEN SMITH (HUSBAND
ERNEST H. CLARY	& WIFE) AND ROBERT & TONA
Date 7-3-72 at 9:27 A.M.	DUNCAN (HUSBAND & WIFE); THE
FILE 23 PAGE 24	SW 1/4 OF THE NW 1/4 OF THE NE 1/4
of Surveys	OF THE S.W. 1/4 OF SECTION 32,
OFFICIAL RECORDS BOOK	T.19S, R.60E, M.D.B. & M. IN
No. 243	CLARK COUNTY, NEVADA.
CLARK COUNTY, NEVADA,	
RECORDS.	
PAULE HORN, RECORDER.	
Fee \$ 2.50 R.M. DEPUTY.	