


MEDIAN FACE CURVE DATA

NO.	Δ	R	L	T
1	180°00'00"	6.00'	13.85'	—
2	11°28'43"	300.00'	60.10'	30.15'
3	11°28'43"	300.00'	60.10'	30.15'

BCR CURVE DATA

NO.	Δ	R	L	T
1	90°00'00"	25.00'	39.27'	25.00'
2	90°00'00"	25.00'	39.27'	25.00'


APPROVAL:
 [Signature]
 CIVIL CHIEF LAND DEVELOPMENT
 5-27-87 DATE

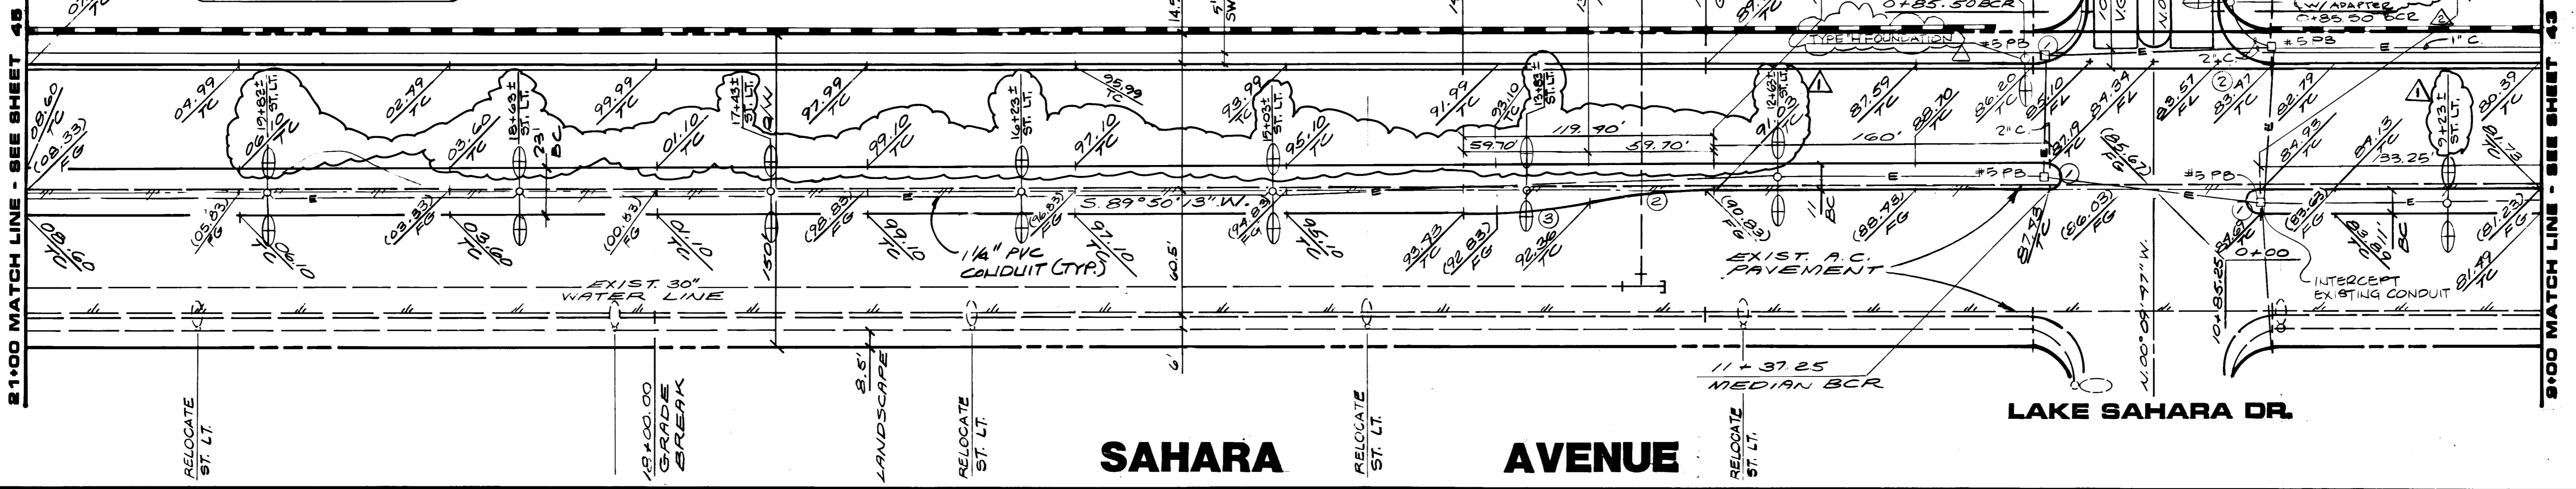

SAHARA AVENUE

SEE SHEET 18
PECCOLE RANCH ROAD
 CANYON GATE DRIVE

LAKE SAHARA DR.

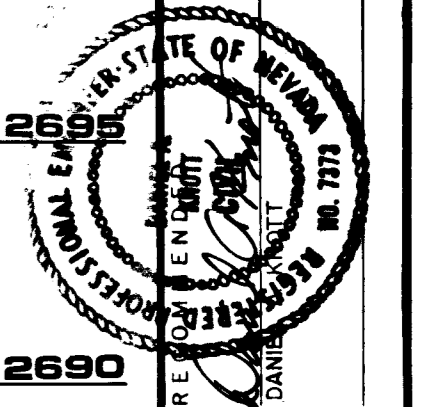

G.C. WALLACE, INC.
 Engineering/Architecture
 1555 SOUTH RAINBOW BLVD., LAS VEGAS, NEVADA 89102

FOOTHILLS COUNTRY CLUB UNIT NO. 1
 AT PECCOLE RANCH
SAHARA AVENUE
 STA. 9+00.00 TO 2+100.00

SHEET
44
 OF 52 SHEETS

JOB NO. 543.324

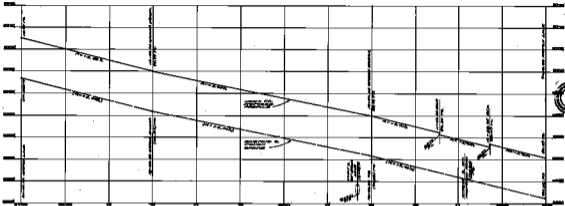
















