
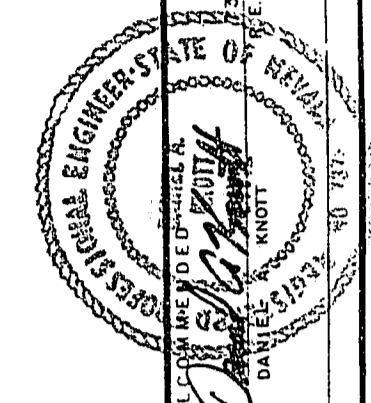
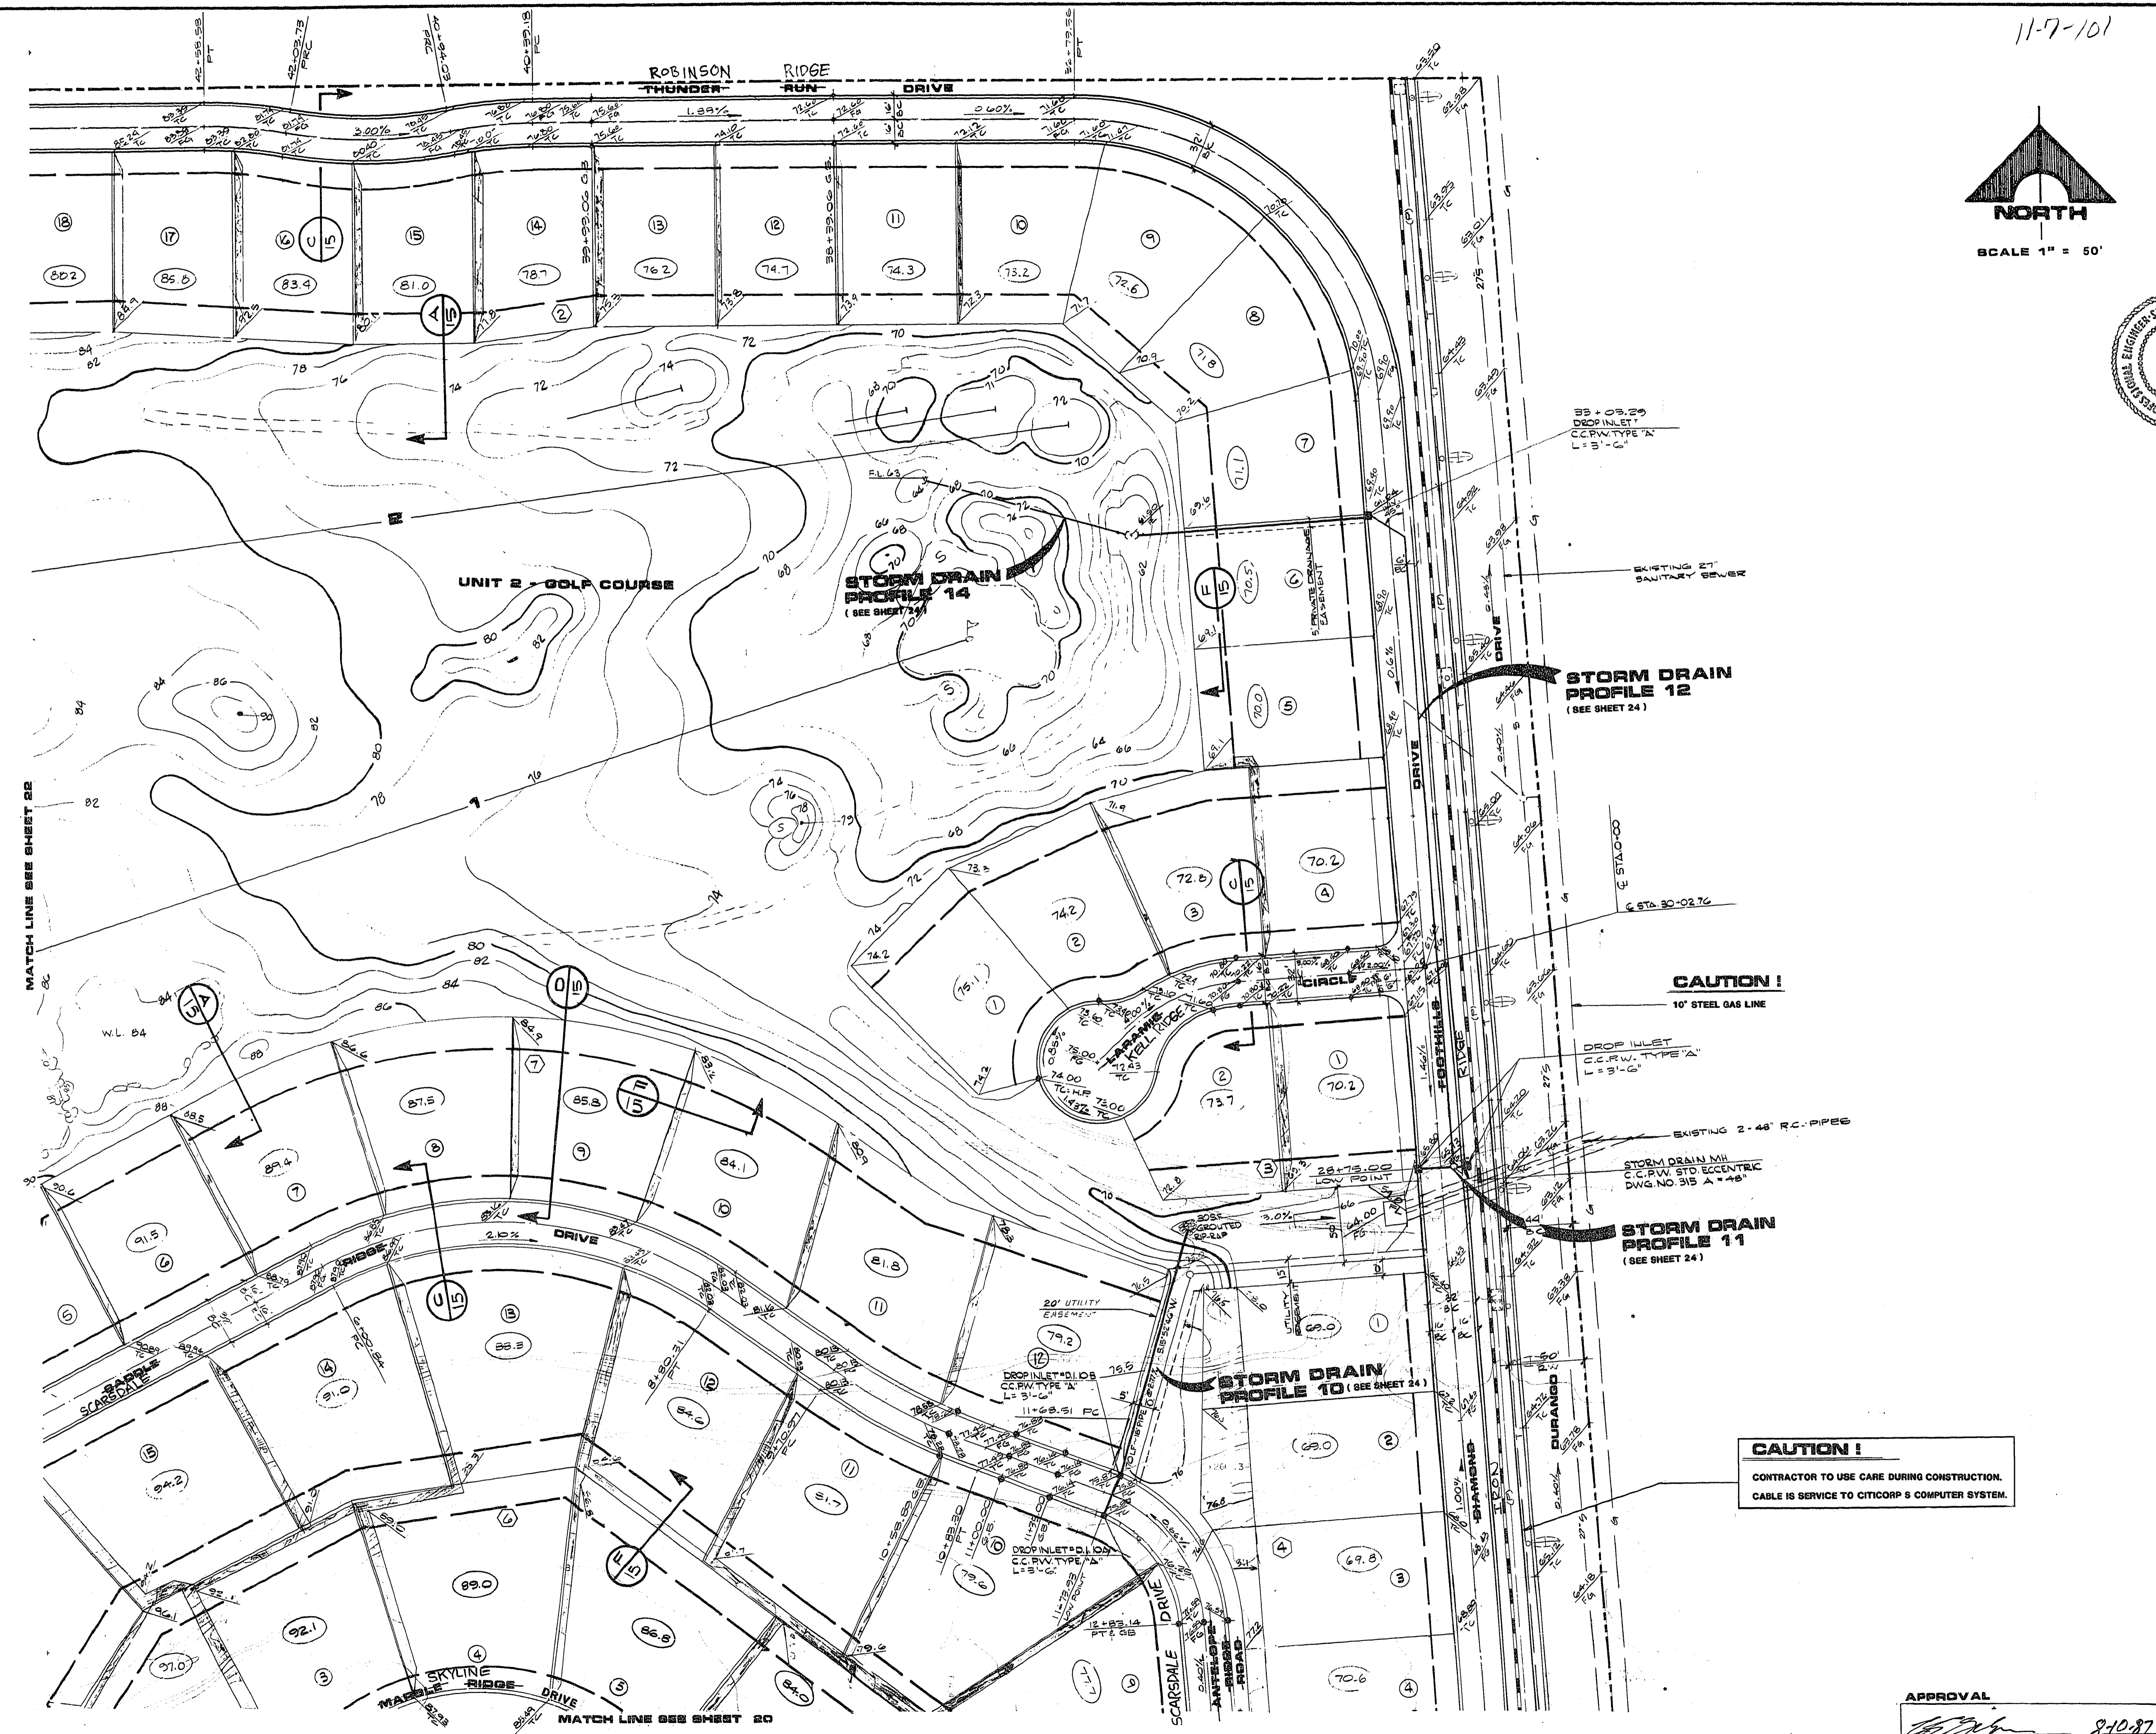


11-7-101

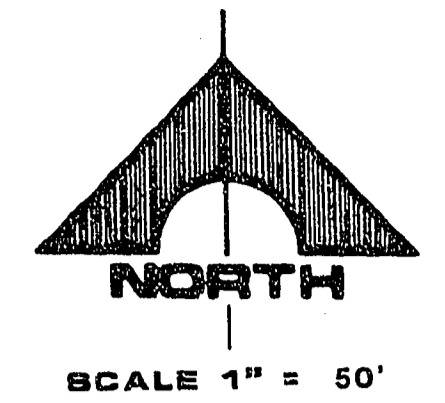

REV	DATE	DESCRIPTION
1	11-7-101	DATE
2	11-7-101	DATE
JOB NO.	DATE	DRAWN	CHECK
543-524			

FOOTHILLS COUNTRY CLUB UNIT NO. 2
AT PECOLE RANCH
GRADING PLAN UNIT NO. 2

G.C. WALLACE, INC.
Engineering/Architecture

SHEET	DATE
21	8-10-87

CAUTION!
CONTRACTOR TO USE CARE DURING CONSTRUCTION.
CABLE IS SERVICE TO CITICORP'S COMPUTER SYSTEM.

APPROVAL
CLV CHIEF LAND DEVELOPMENT
DATE 8-10-87

JOB NO. 543-524

1074-1407-2