

Book 910118



00744

# INCLINE VILLAGE SUBDIVISION

THE WEST HALF (W<sup>1</sup>/<sub>2</sub>) OF THE NORTHEAST QUARTER (NE<sup>1</sup>/<sub>4</sub>) OF THE SOUTHWEST QUARTER (SW<sup>1</sup>/<sub>4</sub>)  
OF THE SOUTHEAST QUARTER (SE<sup>1</sup>/<sub>4</sub>) OF SECTION 4, TOWNSHIP 21 SOUTH, RANGE 60 EAST, M.D.B. & M.  
CITY OF LAS VEGAS CLARK COUNTY NEVADA

## MONUMENTATION PLAN

SCALE  
1"=40'

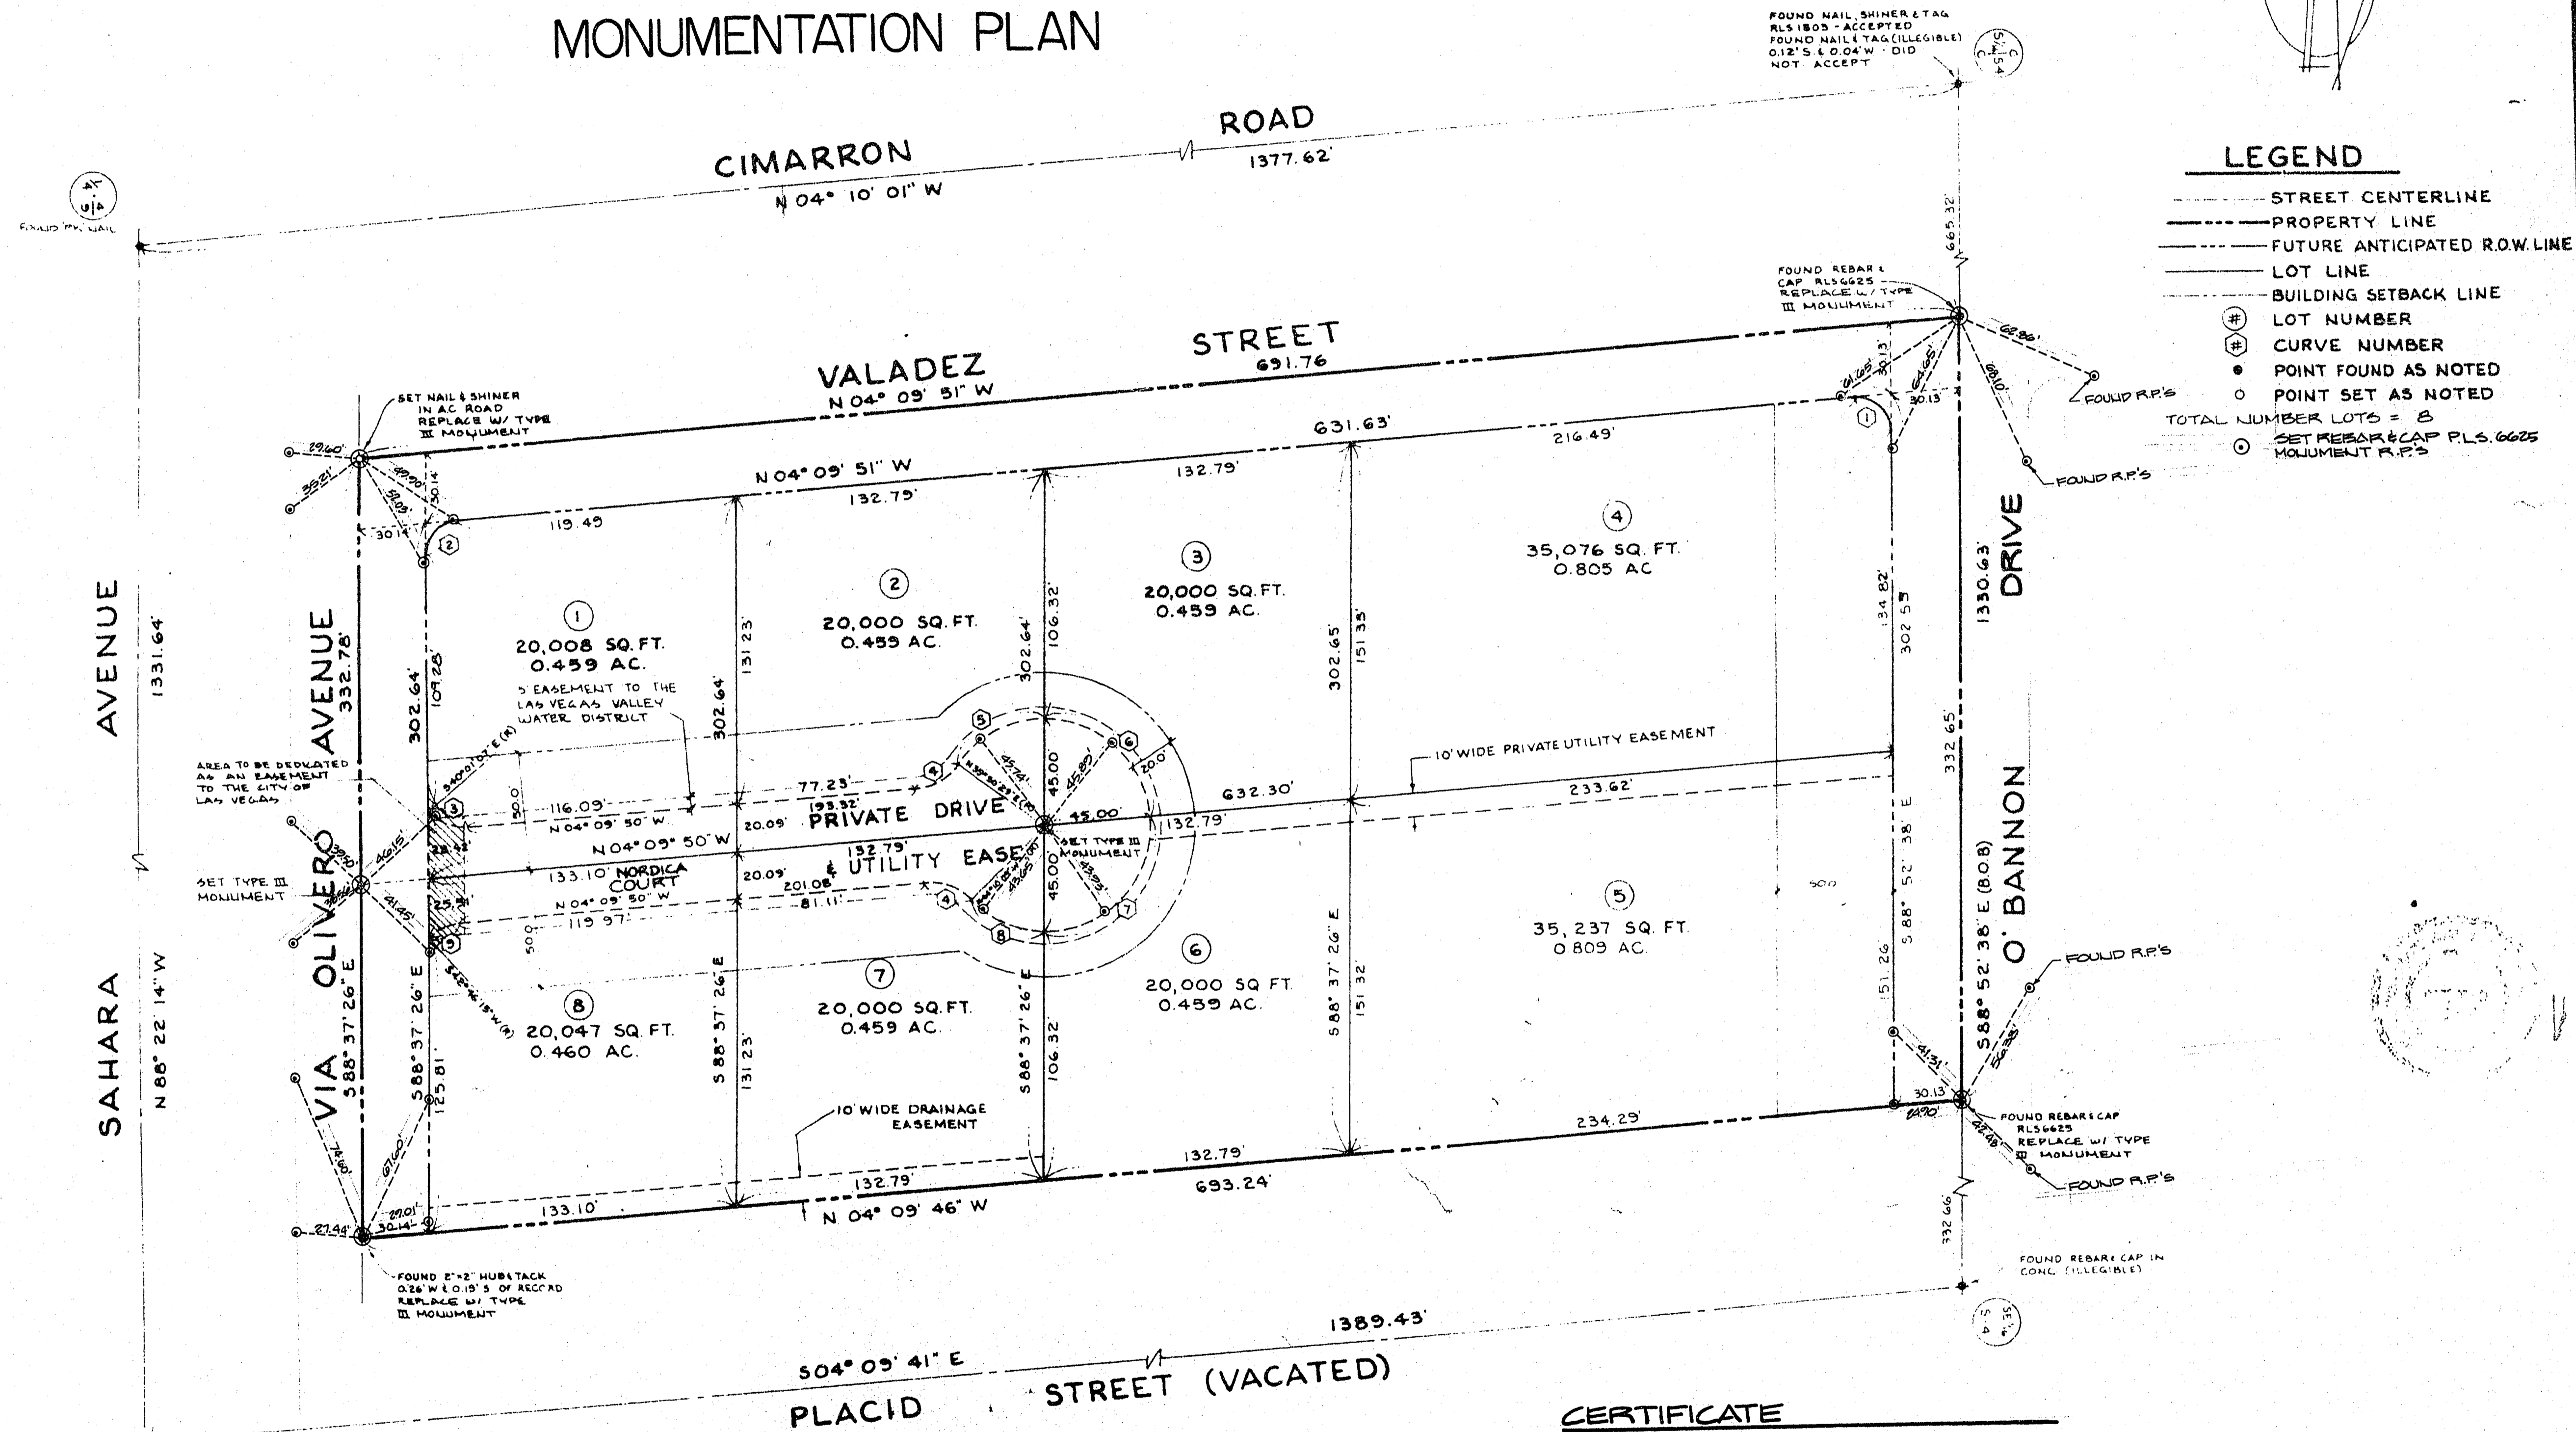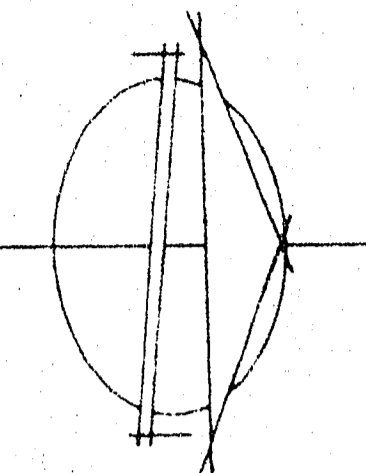


- LEGEND**
- STREET CENTERLINE
  - PROPERTY LINE
  - FUTURE ANTICIPATED R.O.W. LINE
  - LOT LINE
  - BUILDING SETBACK LINE
  - ① LOT NUMBER
  - ⊕ CURVE NUMBER
  - POINT FOUND AS NOTED
  - POINT SET AS NOTED
  - TOTAL NUMBER LOTS = 8
  - ⊕ SET REBAR & CAP P.L.S. 6625
  - MONUMENT P.P.'S

**CURVE DATA**

#	R	Δ	L	T
1	15.00'	95°17'13"	24.95'	16.45'
2	15.00'	64°27'35"	22.11'	13.62'
3	20.00'	54°08'43"	18.90'	10.22'
4	25.00'	49°59'41"	21.81'	11.66'
5	45.00'	55°32'05"	43.62'	23.69'
6	45.00'	84°27'36"	66.34'	40.85'
7	45.00'	95°32'24"	75.04'	49.58'
8	45.00'	44°27'17"	34.92'	18.39'
9	20.00'	43°03'55"	15.03'	7.89'

**CERTIFICATE**


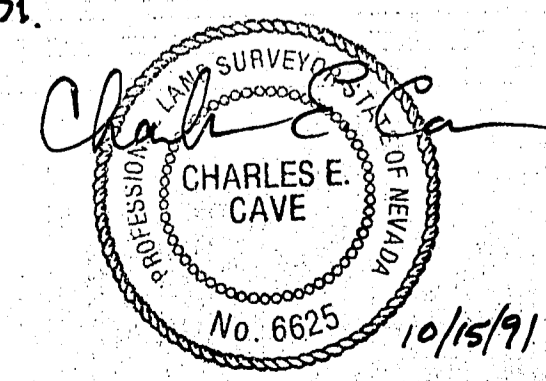

10-6-80 058-4148  
Book 41 Page 61