

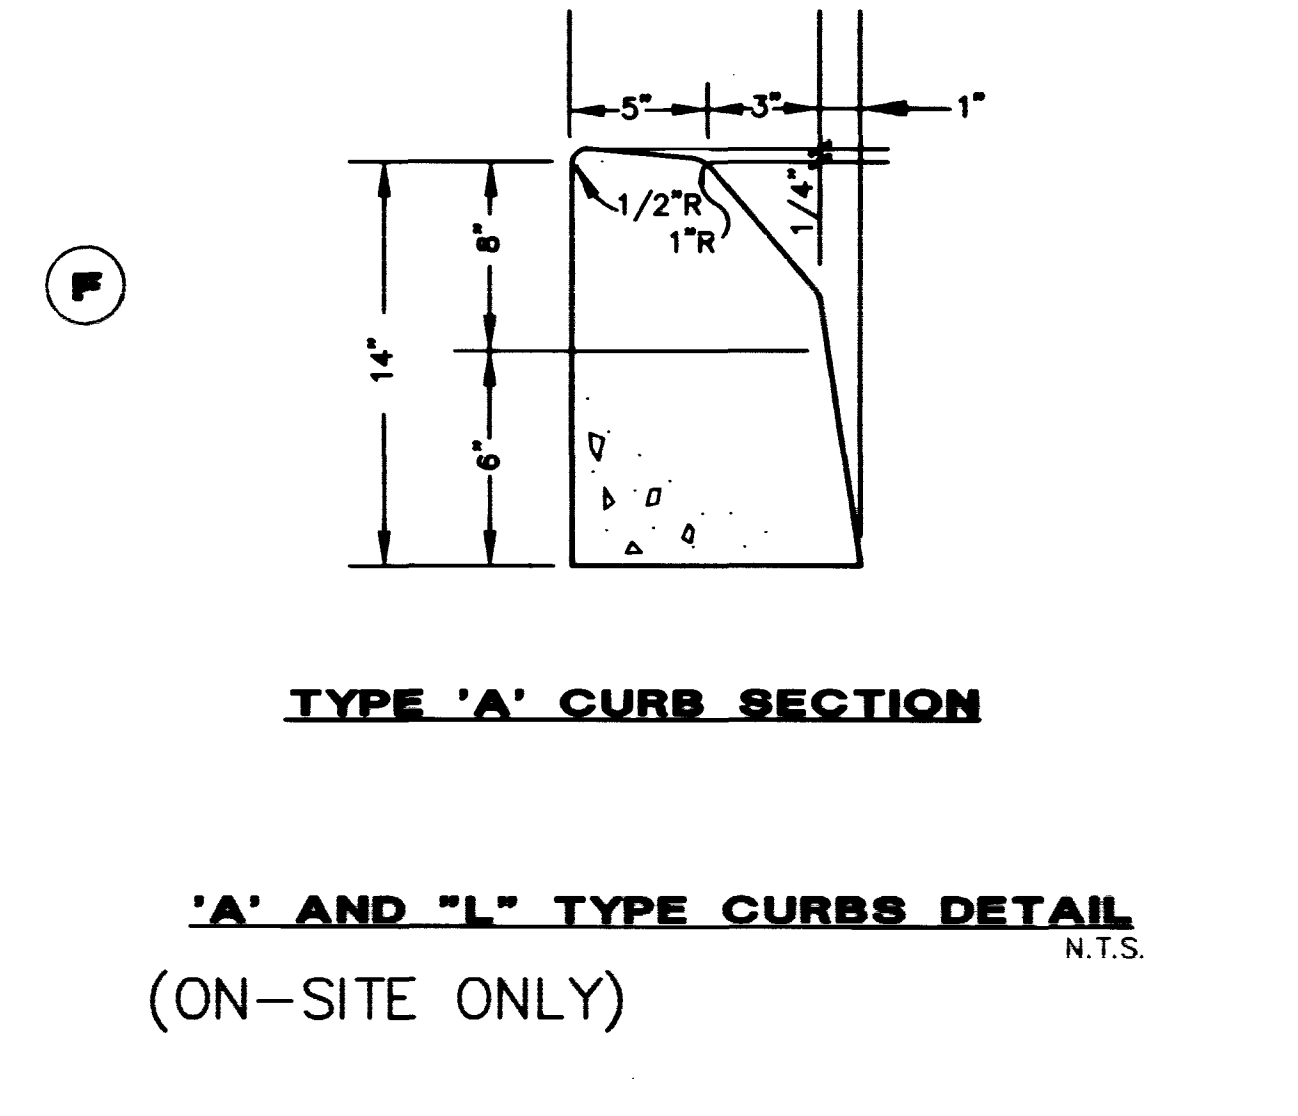
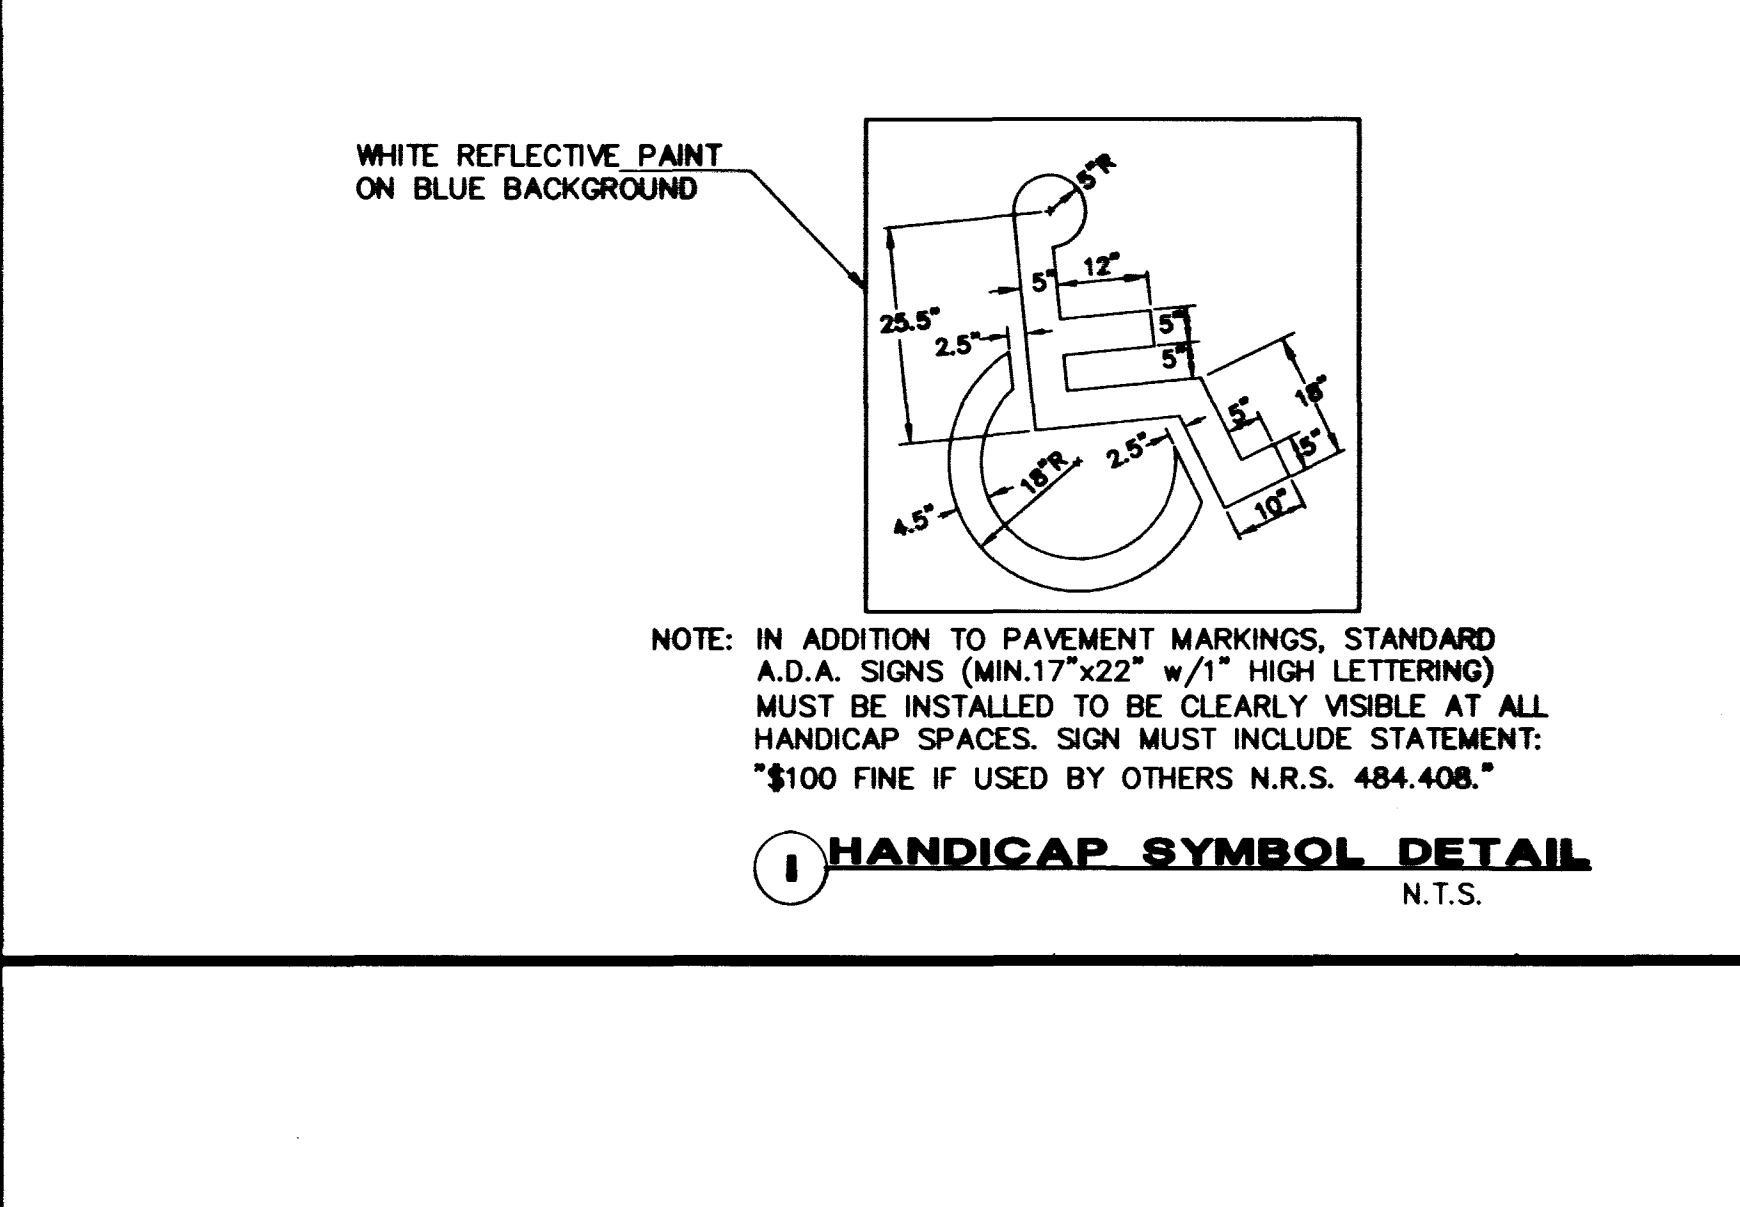
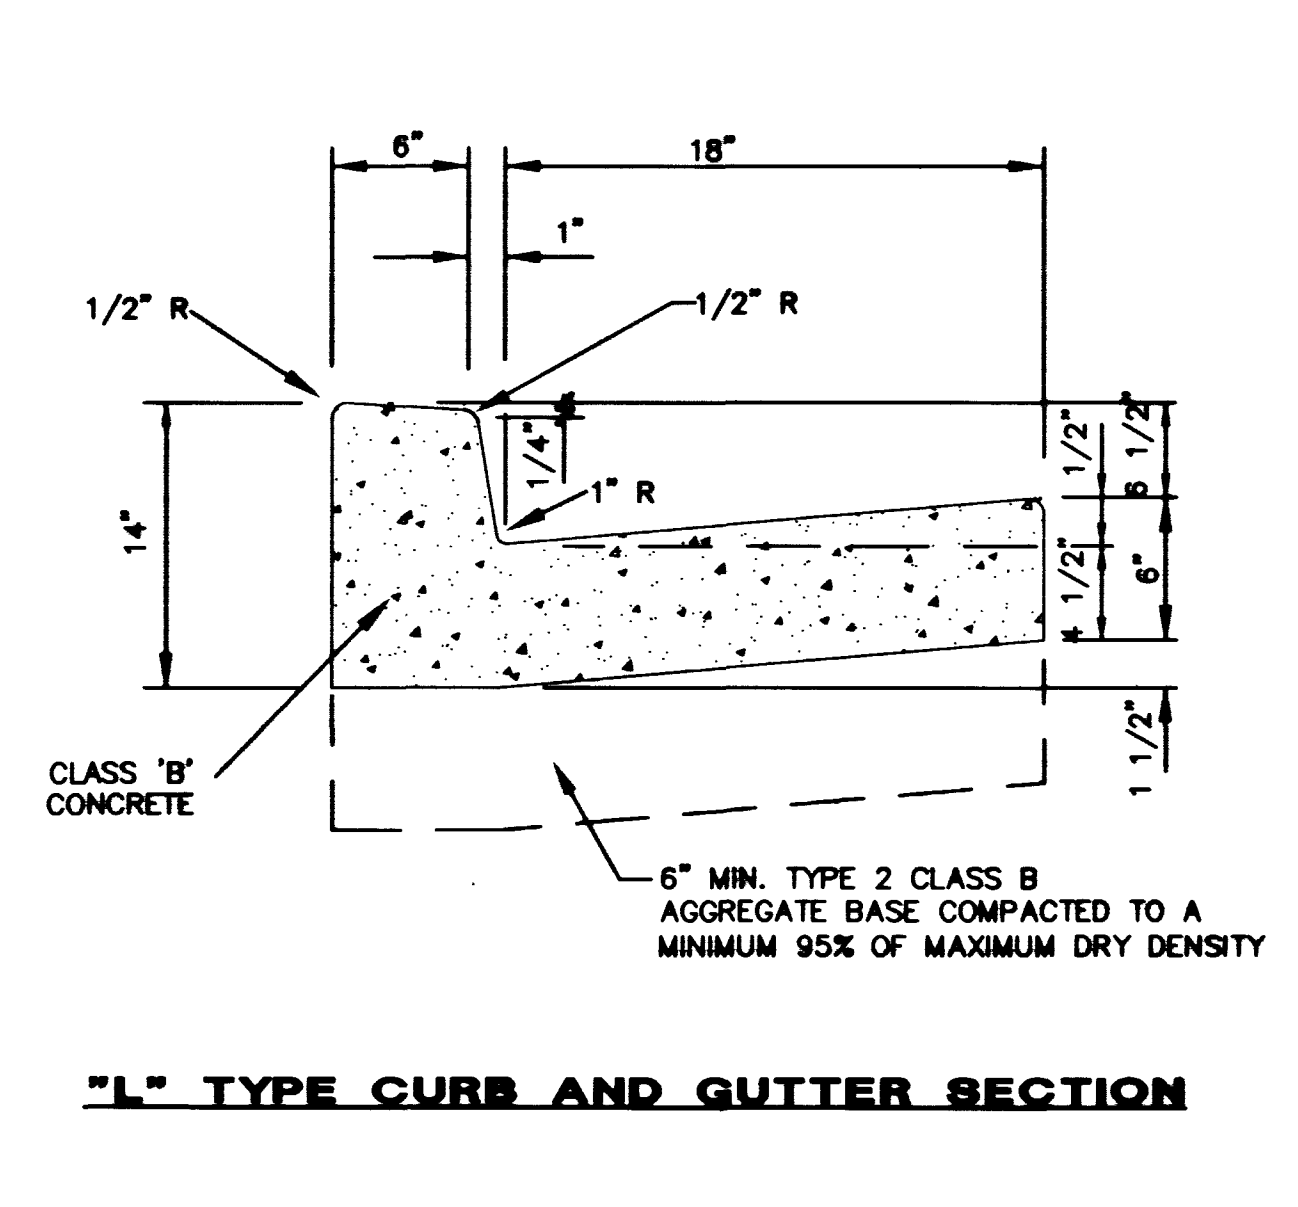
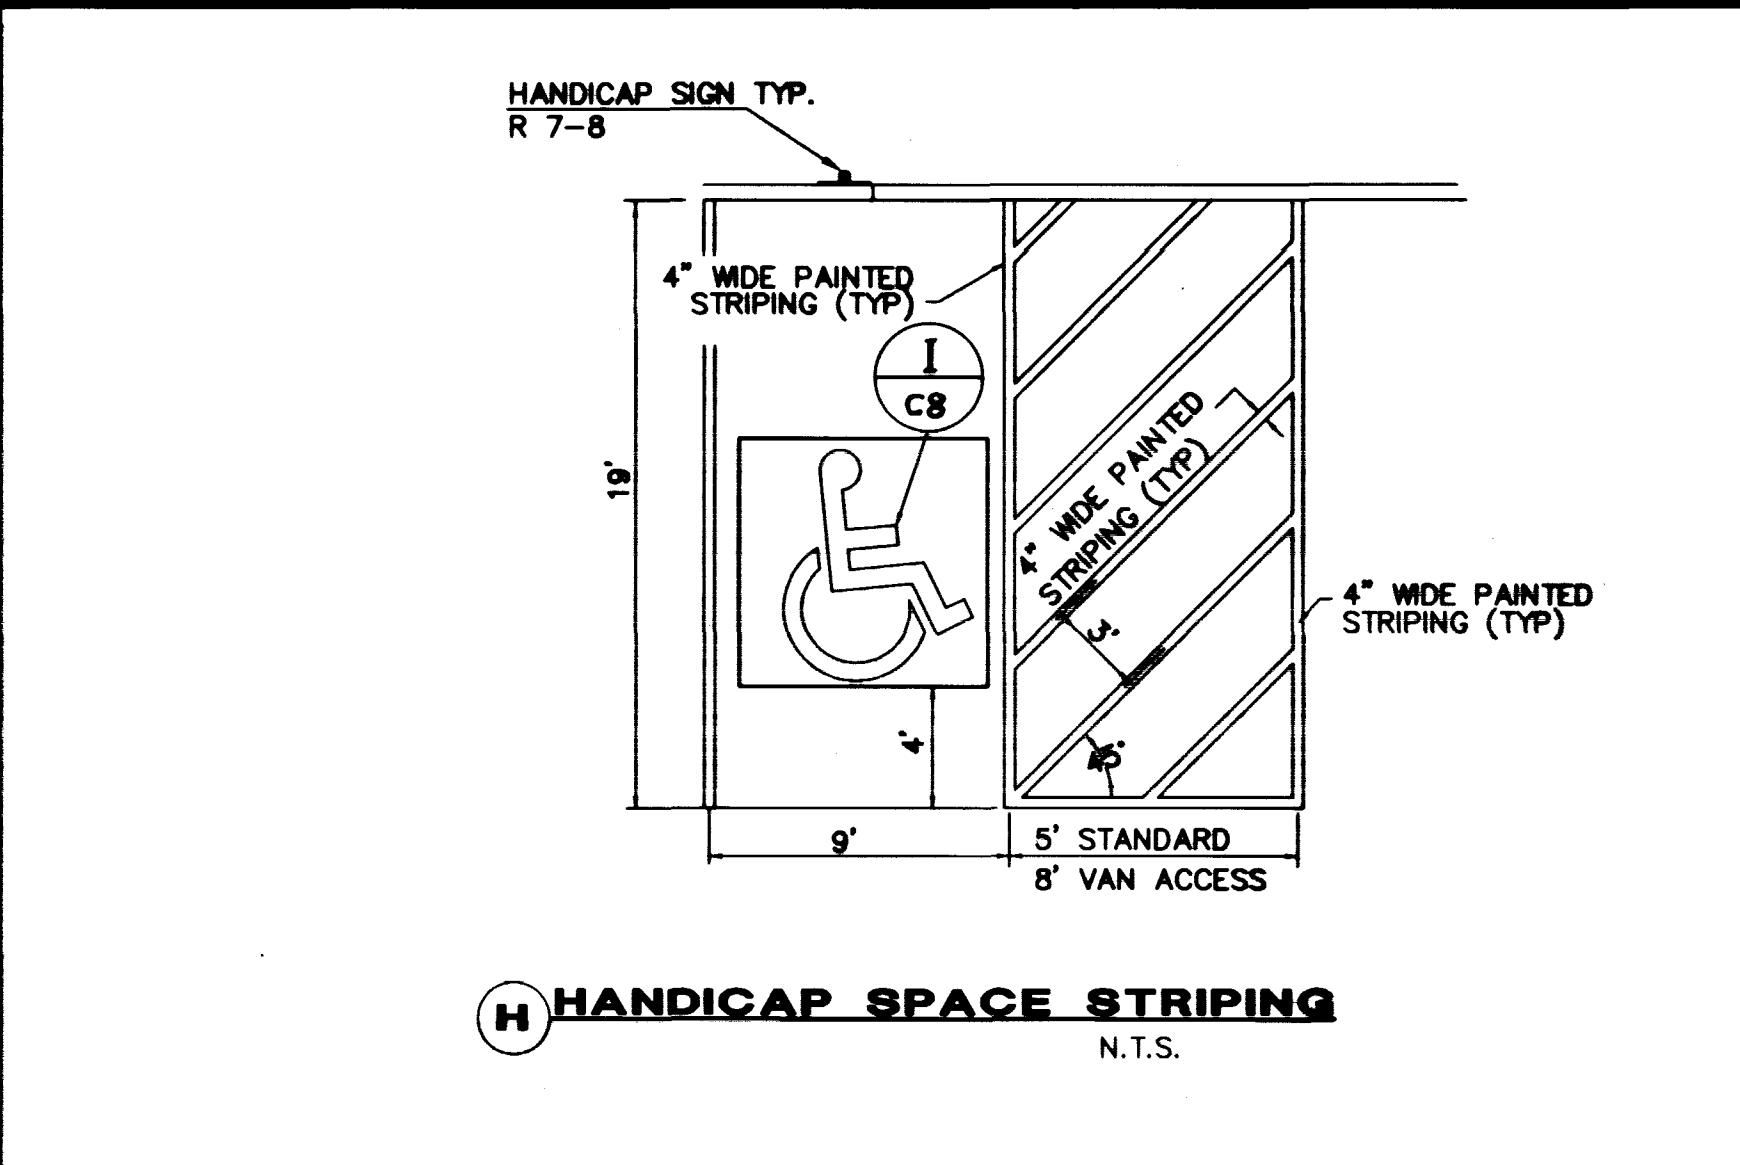
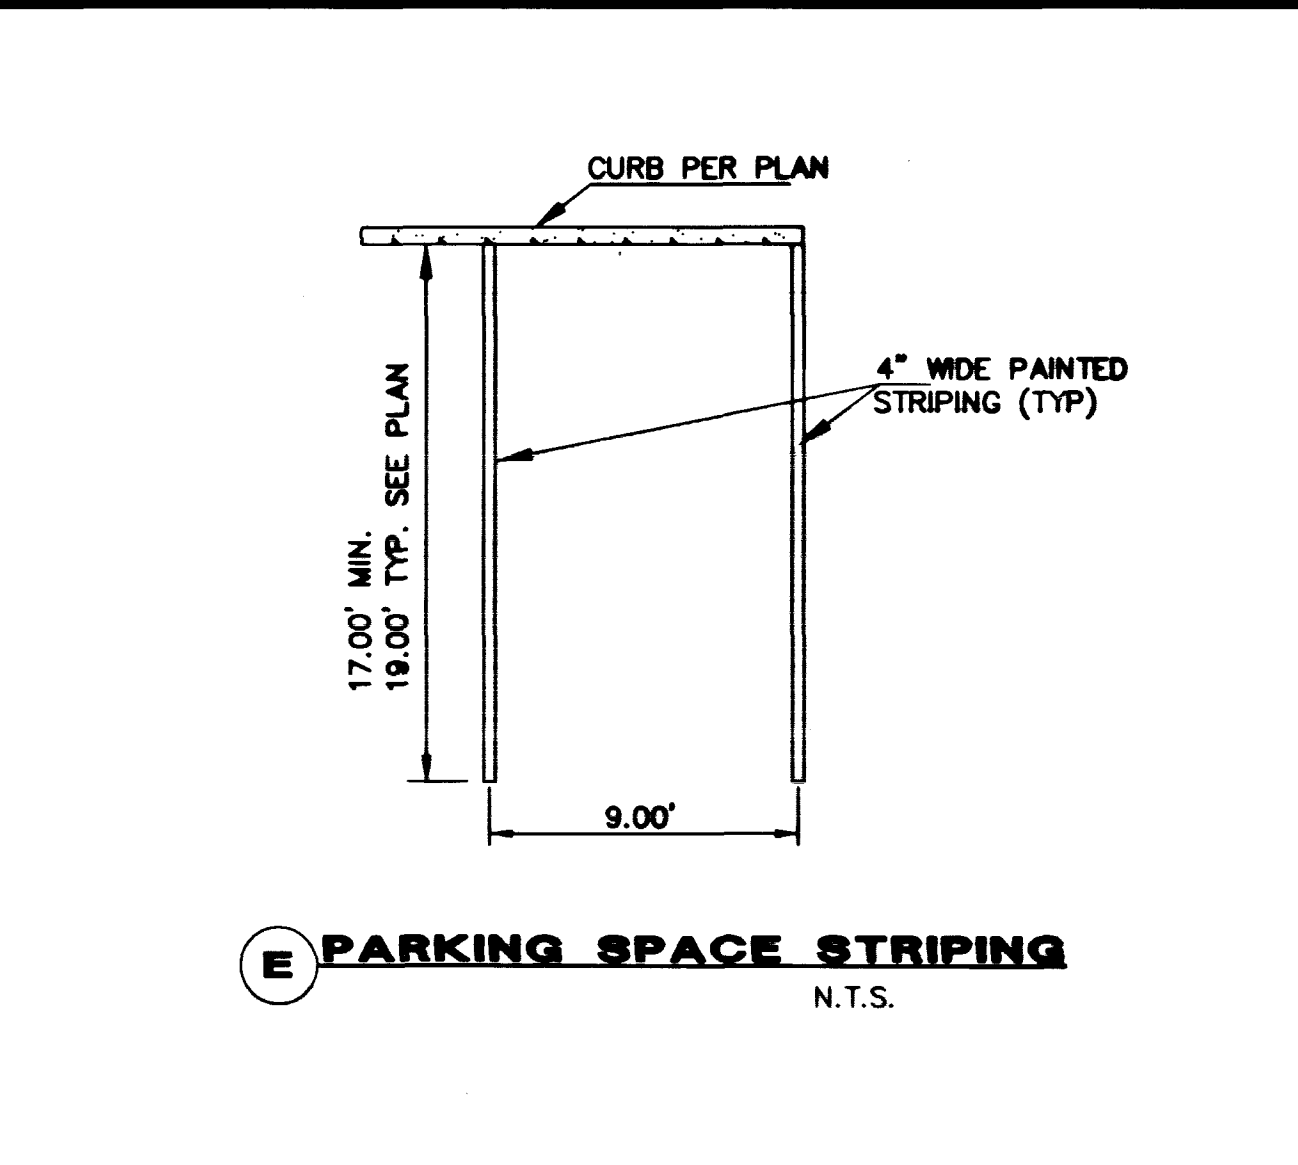
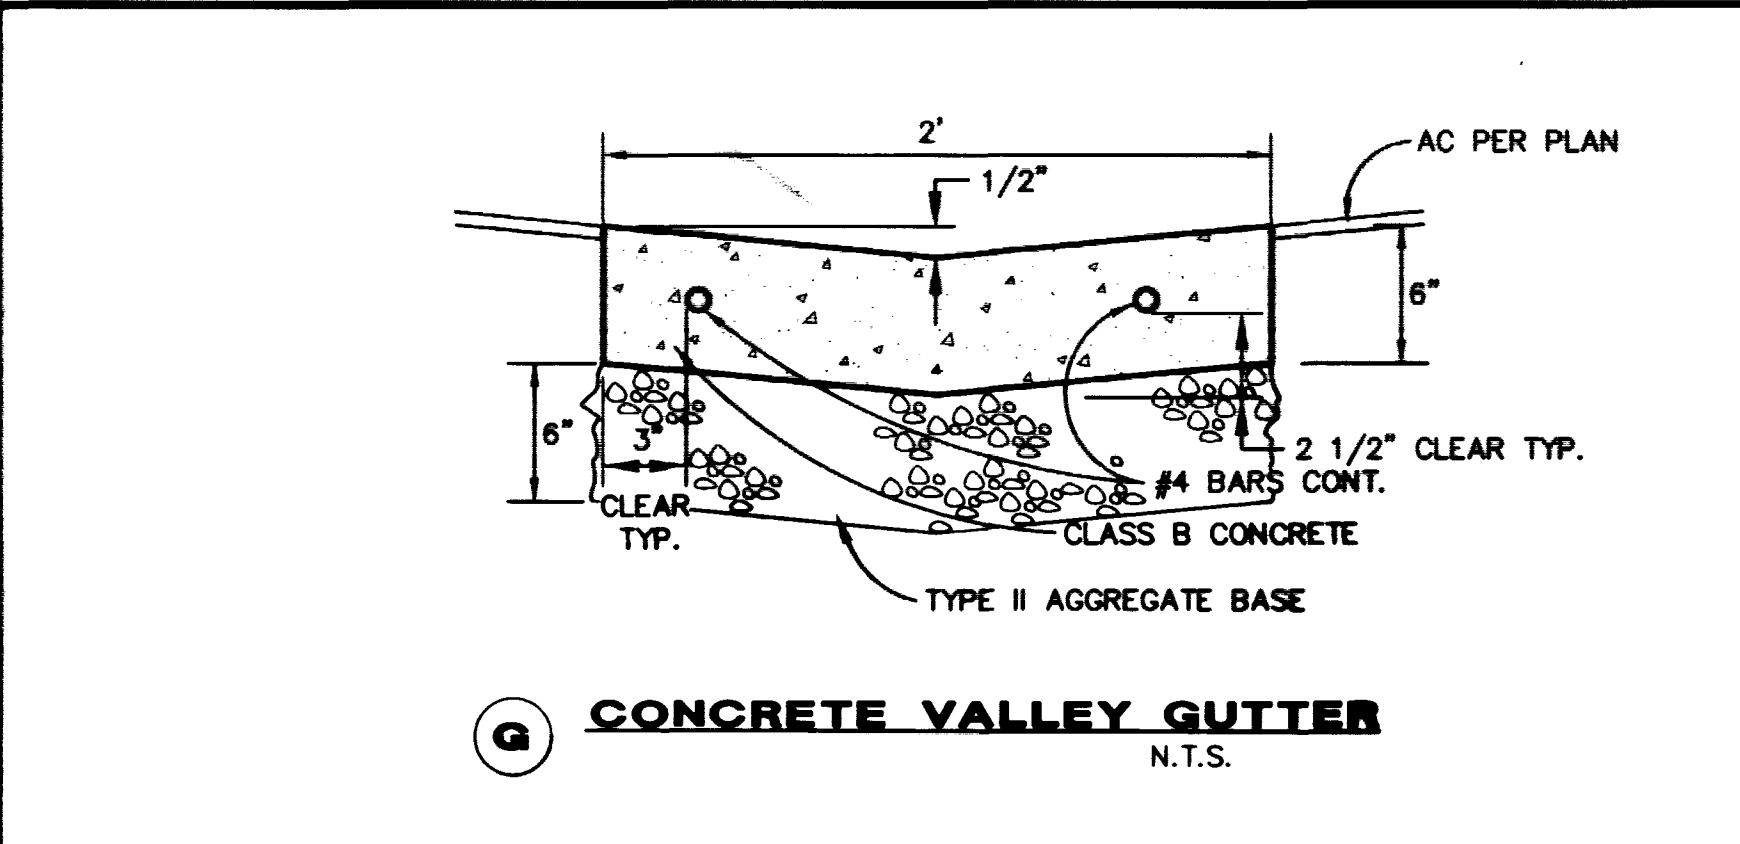
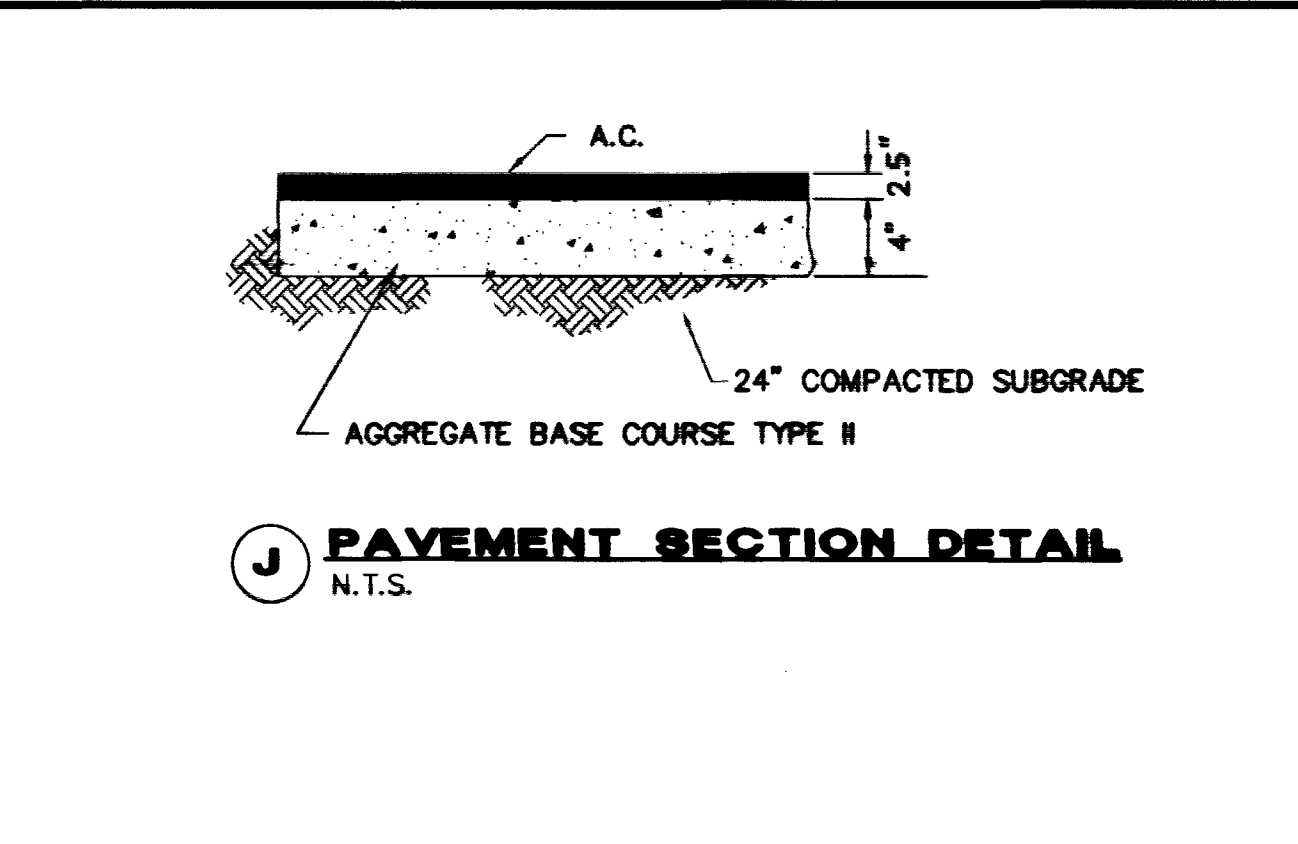
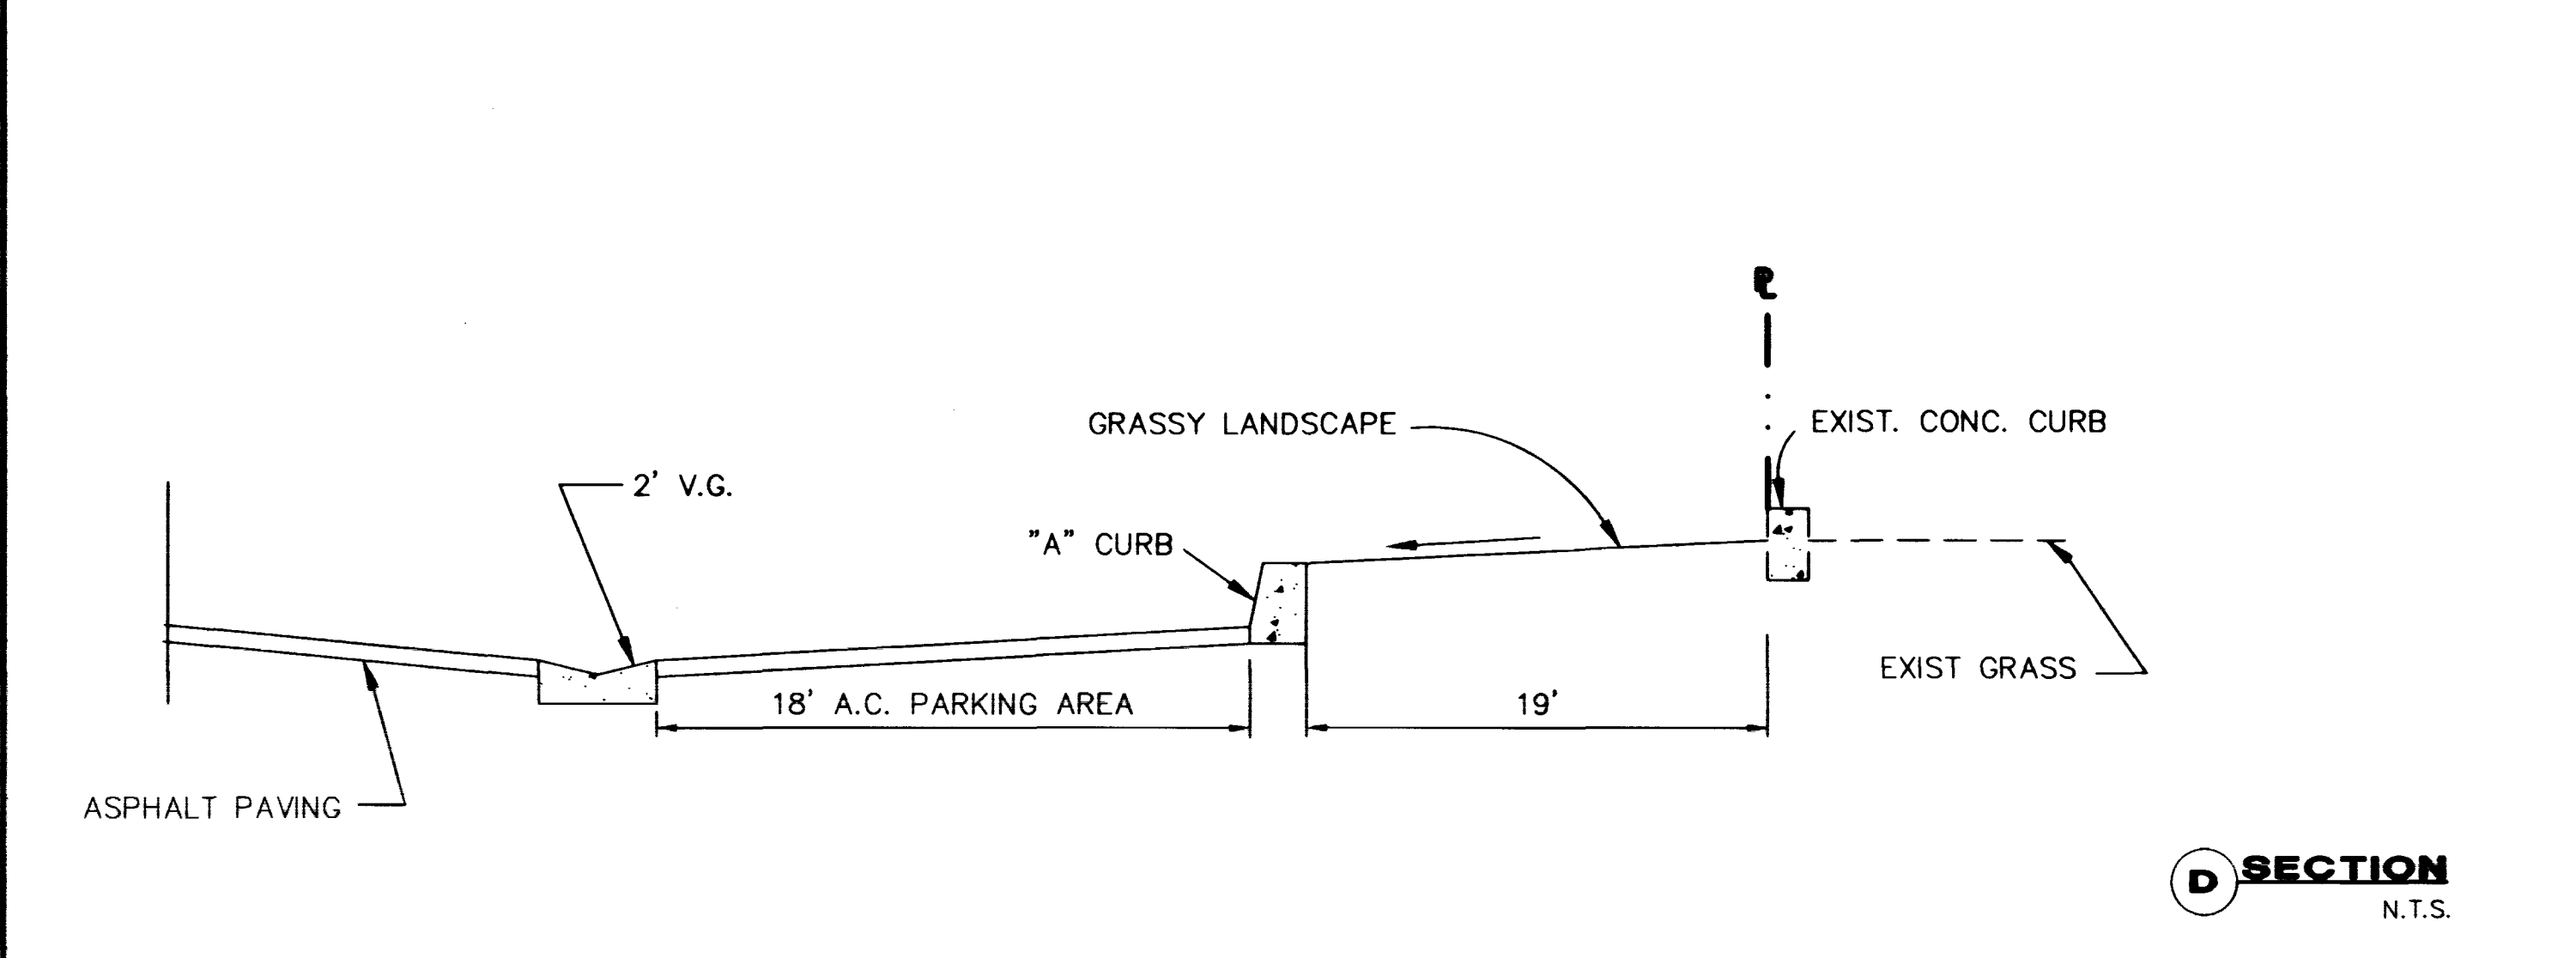
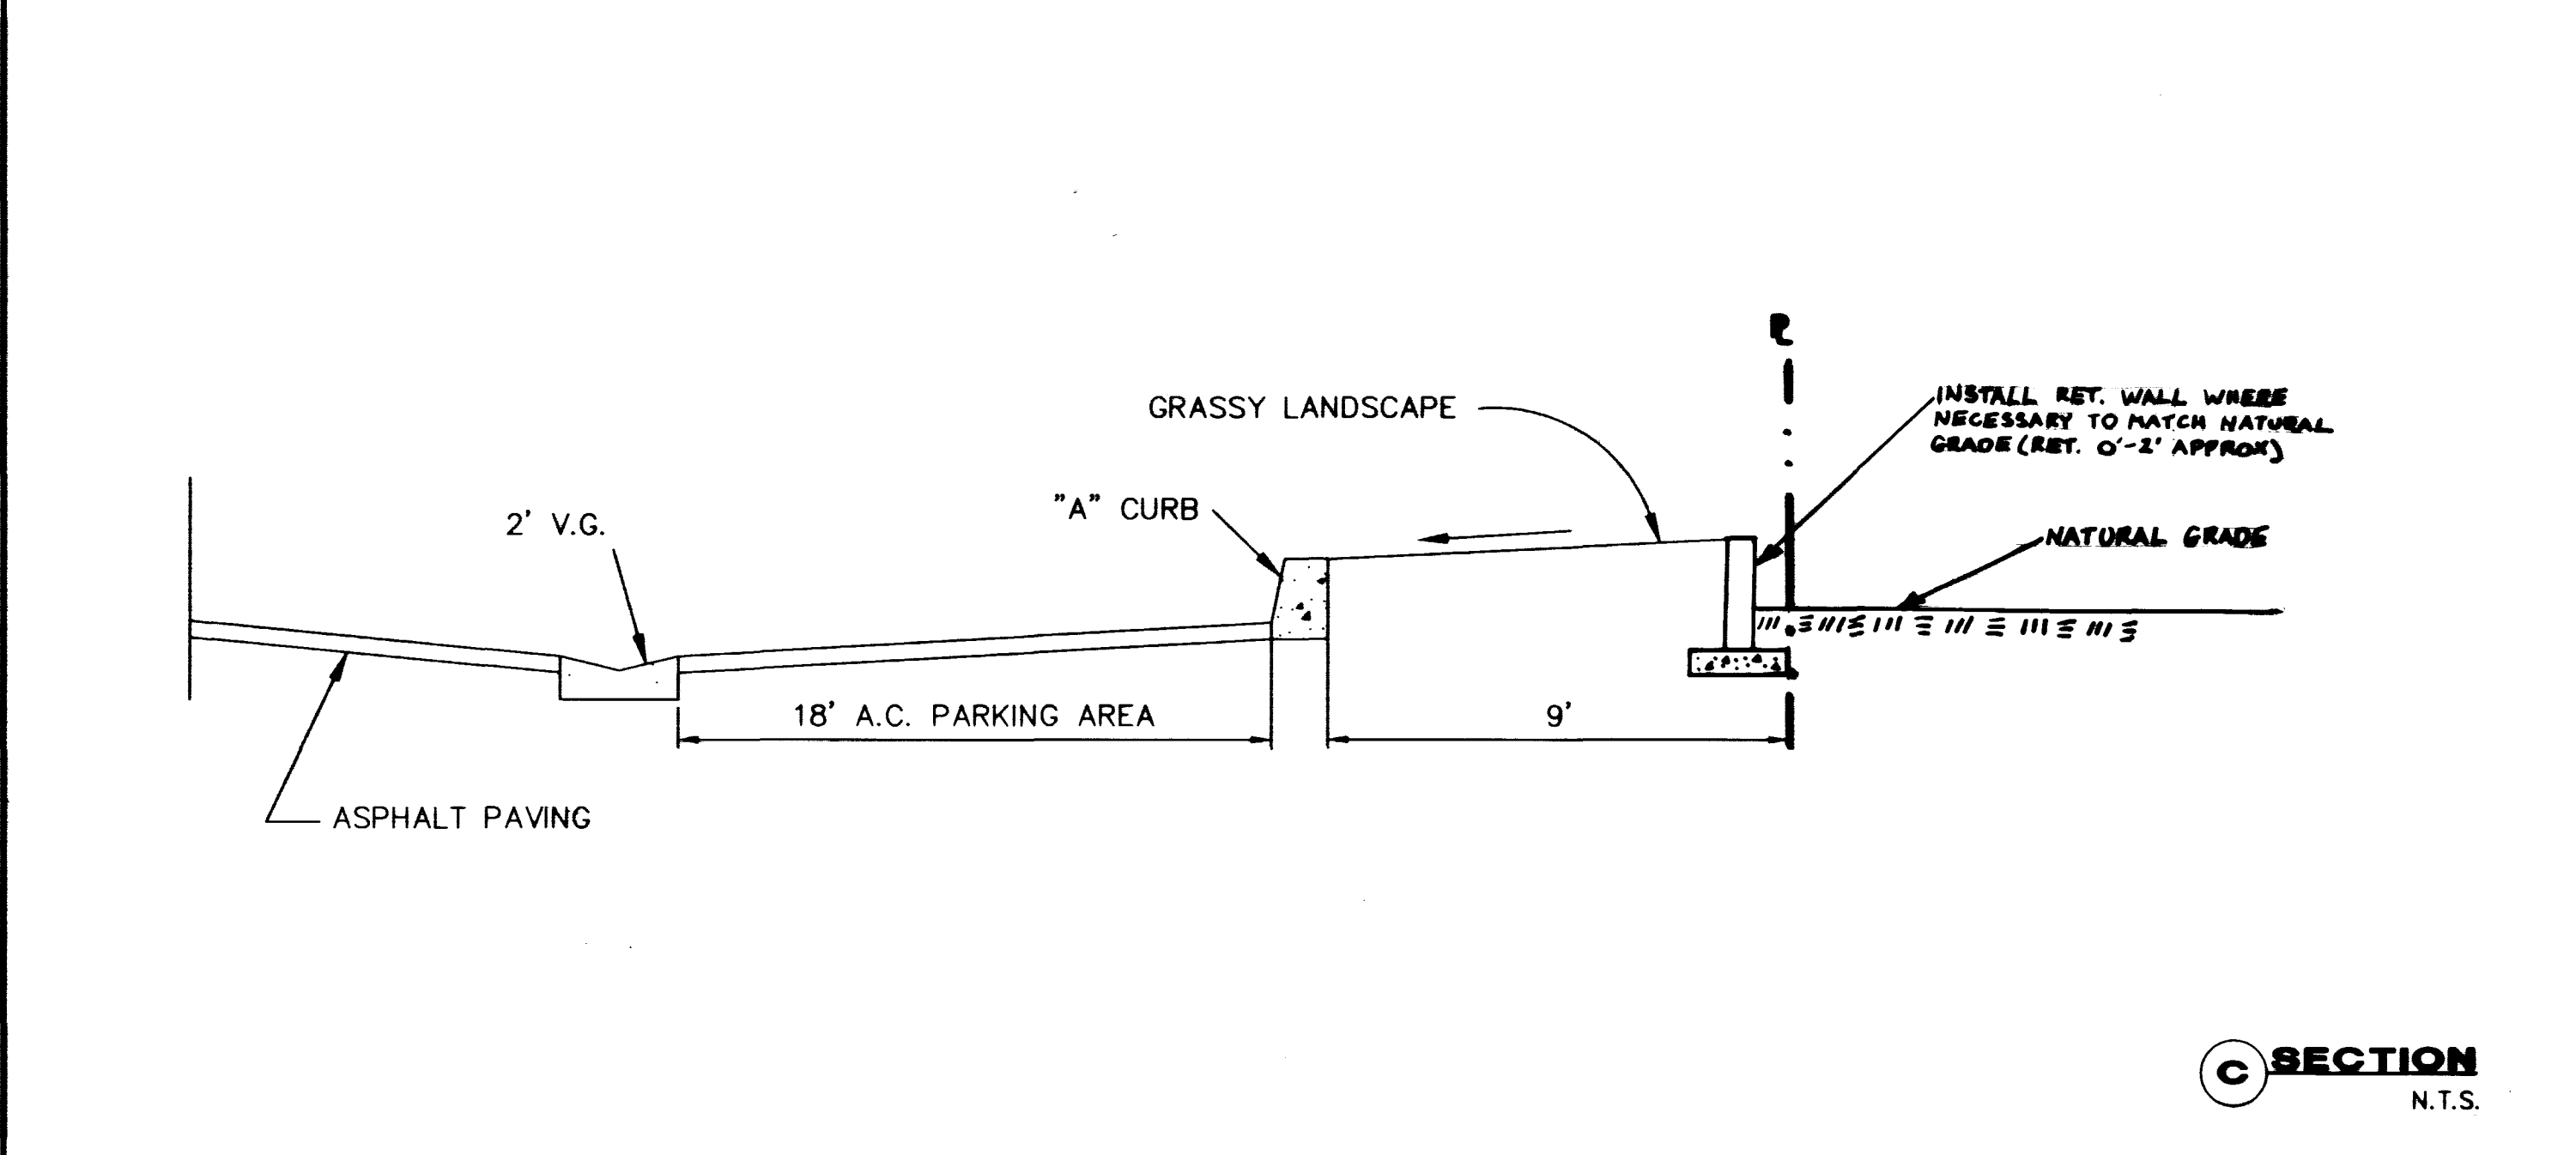


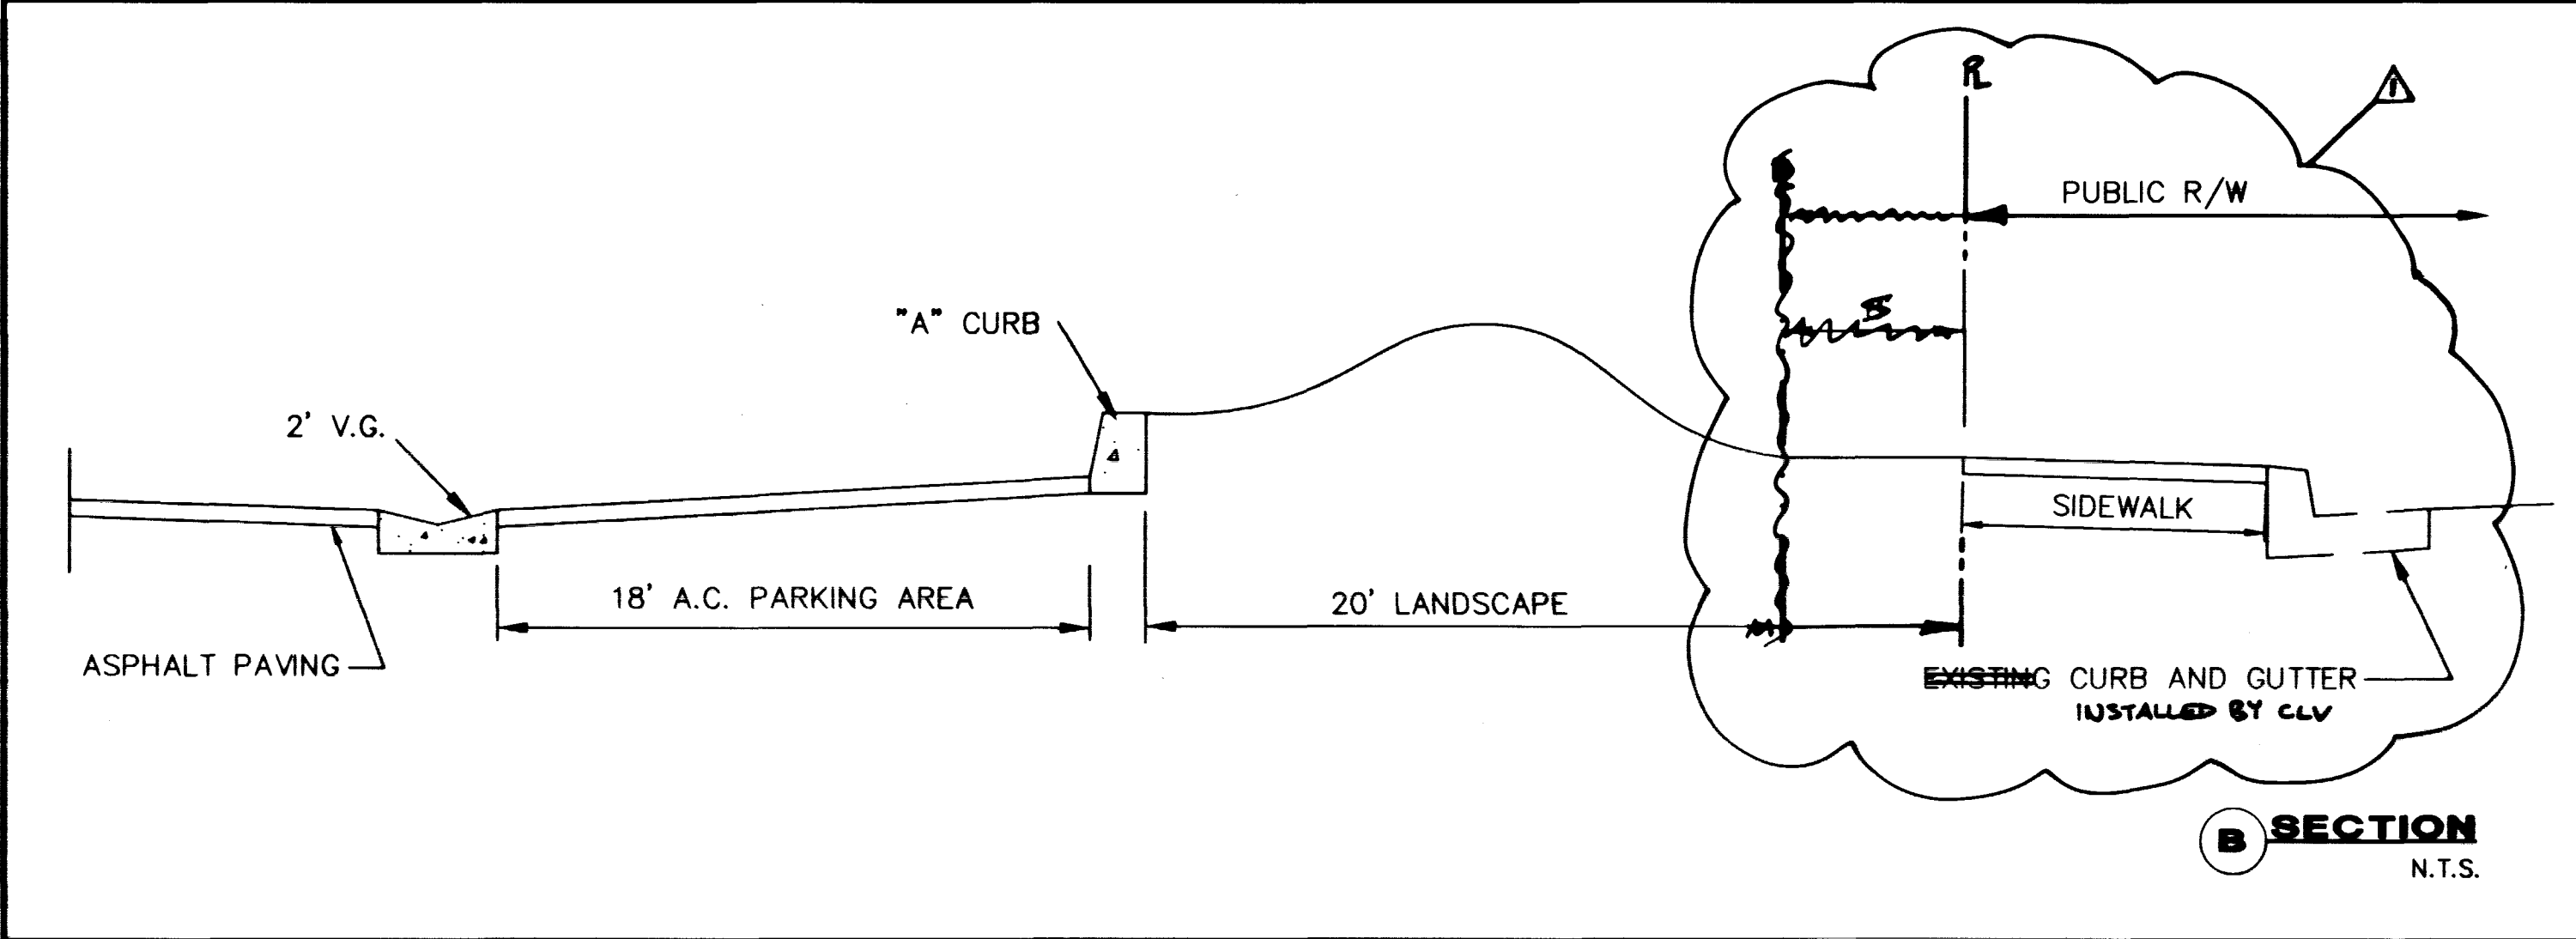

Call before you Dig.
1-800-227-2600
UNDERGROUND SERVICE ALERT

J.W.M. INVESTMENTS 8500 W. Sahara Ave., Suite 400 Las Vegas, NV 89123 (702) 227-3630		The WLB Group Inc. Engineering • Landscape Architecture Planning • Urban Design • Surveying 2251 N. Green Valley Pkwy., Suite A425 HENDERSON, NV 89014(702) 458-2551	
SHEET TITLE: DETAIL SHEET		PROJECT: LAS VEGAS MP	
Drawn by: GYT	6/30/98	Checked by: ANS	Scale: N/A
Designed by: BKB		Project No.: 498031	N/A
SEAL PROFESSIONAL ENGINEER-STATE OF NEVADA CIVIL No. 7549 11/24/97		SHEET C8 8 OF 8 SHEETS	
DRAWING NO. 107-V2935			

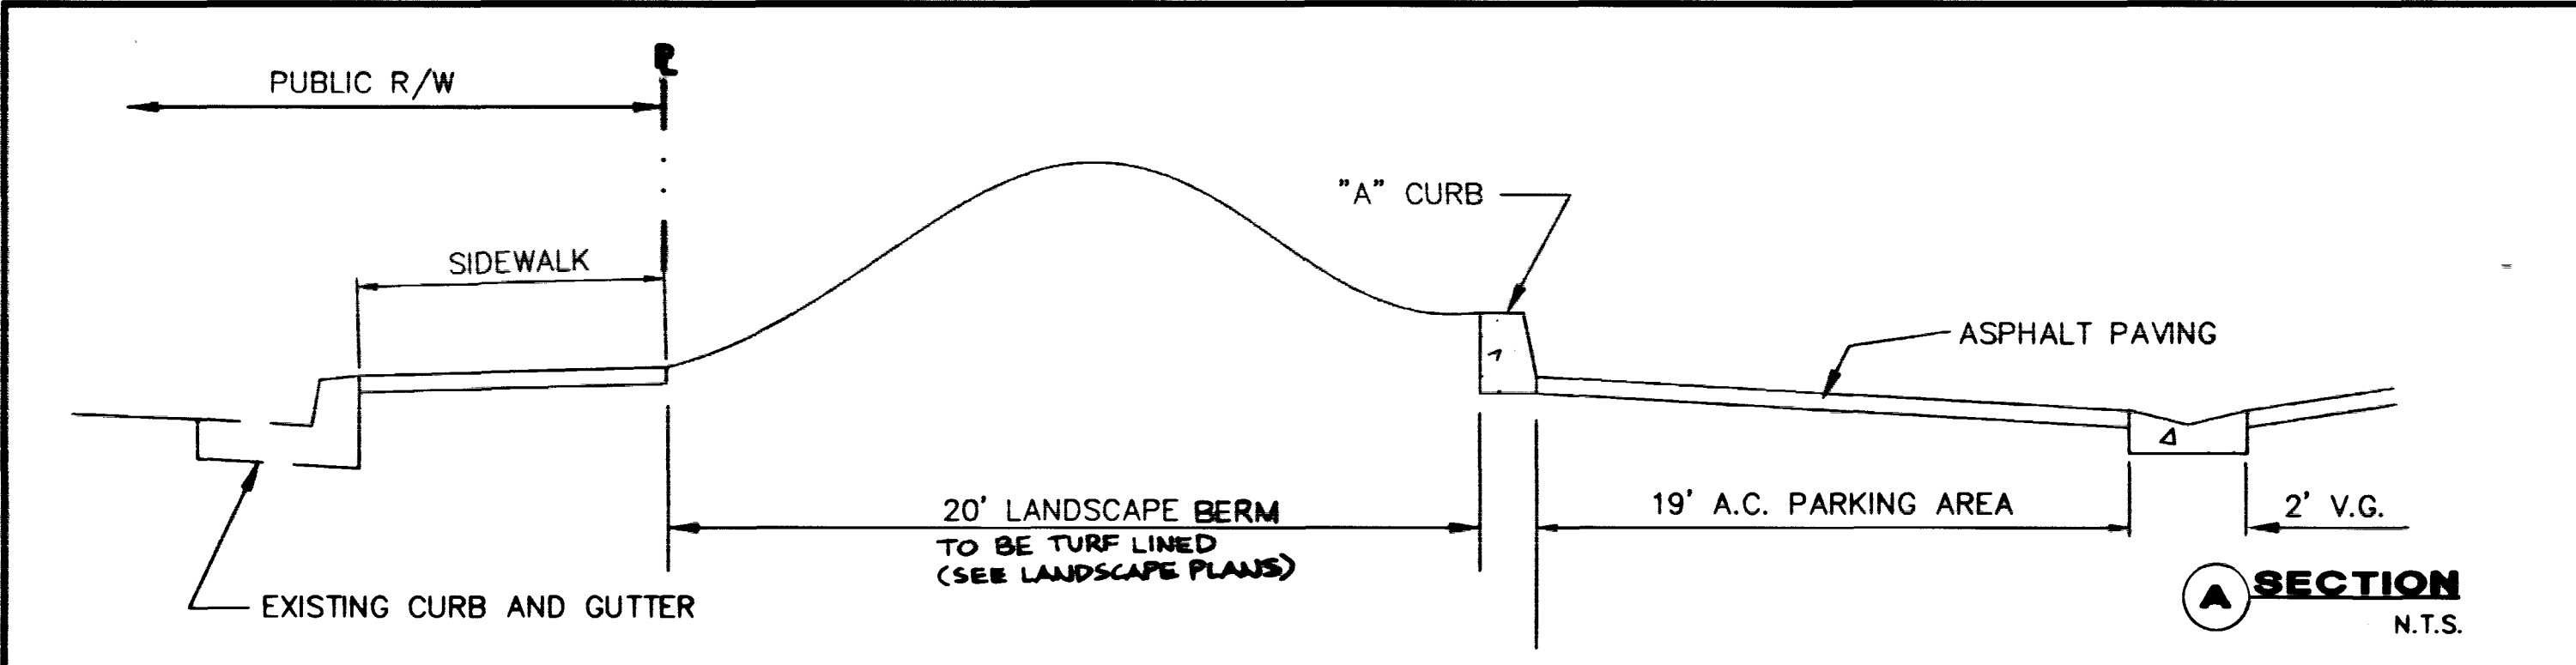