


CONSTRUCTION NOTES

- 1 CONSTRUCT 2" AC OVER 7" TYPE II AB OVER 6" TYPE I AB
- 2 CONSTRUCT 3" AC OVER 8" TYPE II AB OVER 9" TYPE I AB
- 3 CONSTRUCT CONCRETE SIDEWALK PER STD DWG 234
- 4 CONSTRUCT "L" TYPE CURB AND GUTTER PER STD DWG 216
- 5 CONSTRUCT 8" CROSS GUTTER PER STD DWG 228
- 6 CONSTRUCT SIDEWALK RAMP PER STD DWG 235 (TYPE PER PLAN)
- 7 CONSTRUCT SIDEWALK UNDER DRAIN PER STD DWG 236
- 8 CONSTRUCT 6" WIDE "U" CHANNEL PER DETAIL 9 ON SHEET 12
- 9 CONSTRUCT 6" WIDE x 32 TALL THRU WALL DRAIN PER DETAIL 8 ON SHEET 12
- 10 CONSTRUCT 6" LONG 0" - 6" CURB FACE TRANSITION
- 11 CONSTRUCT MODIFIED "A" TYPE ISLAND CURB WITH 6" CURB FACE PER DETAIL 16 ON SHEET 13
- 12 CONSTRUCT 3" WIDE VALLEY GUTTER PER DETAIL 7 ON SHEET 12
- 13 SAWCUT EXISTING CONCRETE CURB AND GUTTER, REMOVE AND DISPOSE OF CONCRETE DEBRIS OFFSITE
- 14 CONSTRUCT 12" CONCRETE OVER 12" TYPE II AB OVER 24" TYPE I AB W/ # 4 BARS 24" OC
- 15 CONSTRUCT 2" WIDE "U" CHANNEL PER DETAIL 9 ON SHEET 12
- 16 CONSTRUCT C. M. U. FENCE PER STD B-102 ACCESS EASEMENT THROUGH LANDSCAPE AREA DEDICATED PER SEPARATE DOCUMENT
- 17 CONSTRUCT RETAINING WALL W/ C. M. U. FENCE PER STD B-101
- 18 CONSTRUCT TRASH ENCLOSURE PER ARCHITECTURAL PLANS
- 19 CONSTRUCT 24" WIDE 0" CURB FACE OPENING
- 20 PROTECT IN PLACE
- 21 CONSTRUCT MODIFIED "A" TYPE ISLAND CURB WITH 12" CURB FACE PER STD DWG 219 AND DETAIL 15 ON SHEET 13
- 22 CONSTRUCT 10' LONG 6" - 12" CURB FACE TRANSITION
- 23 CONSTRUCT CASE III HANDICAP ACCESS RAMP PER CCSD NO. 235
- 24 CONSTRUCT PERIMETER SCREEN WALL PER ARCHITECTURAL PLANS
- 25 CONSTRUCT PERIMETER SCREEN WALL WITH EVERY OTHER BLOCK ALONG BOTTOM COURSE ROTATED 90 DEGREES FOR DRAINAGE PURPOSES


EASEMENT NOTES

- 1 24' PUBLIC DRAINAGE EASEMENT, TO BE PRIVATELY MAINTAINED.
- 2 SIGHT VISIBILITY EASEMENT
- 3 PUBLIC ACCESS EASEMENT

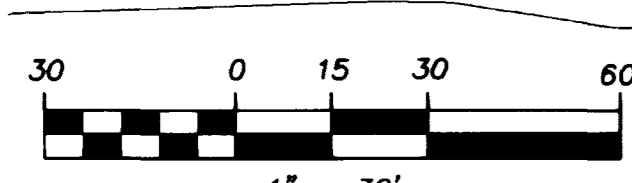

RAMP TRANSITION LENGTH TABLE
PER USDCCA DWG NO. 235 CASE III

RAMP NO.	GRADE (%) "B" TO "A"	"A" (FEET) MINIMUM	"B" (FEET) MINIMUM
HCR-1	-8.66%	4.5	21.5
HCR-2	+4.07%	15.0	4.5
HCR-3	-2.52%	4.5	9.5
HCR-4	0.00%	8.0	8.0
HCR-5	+3.53%	12.0	4.5
HCR-6	+0.00%	8.0	8.0
HCR-7	-0.80%	8.0	8.0
HCR-8	+0.00%	8.0	8.0

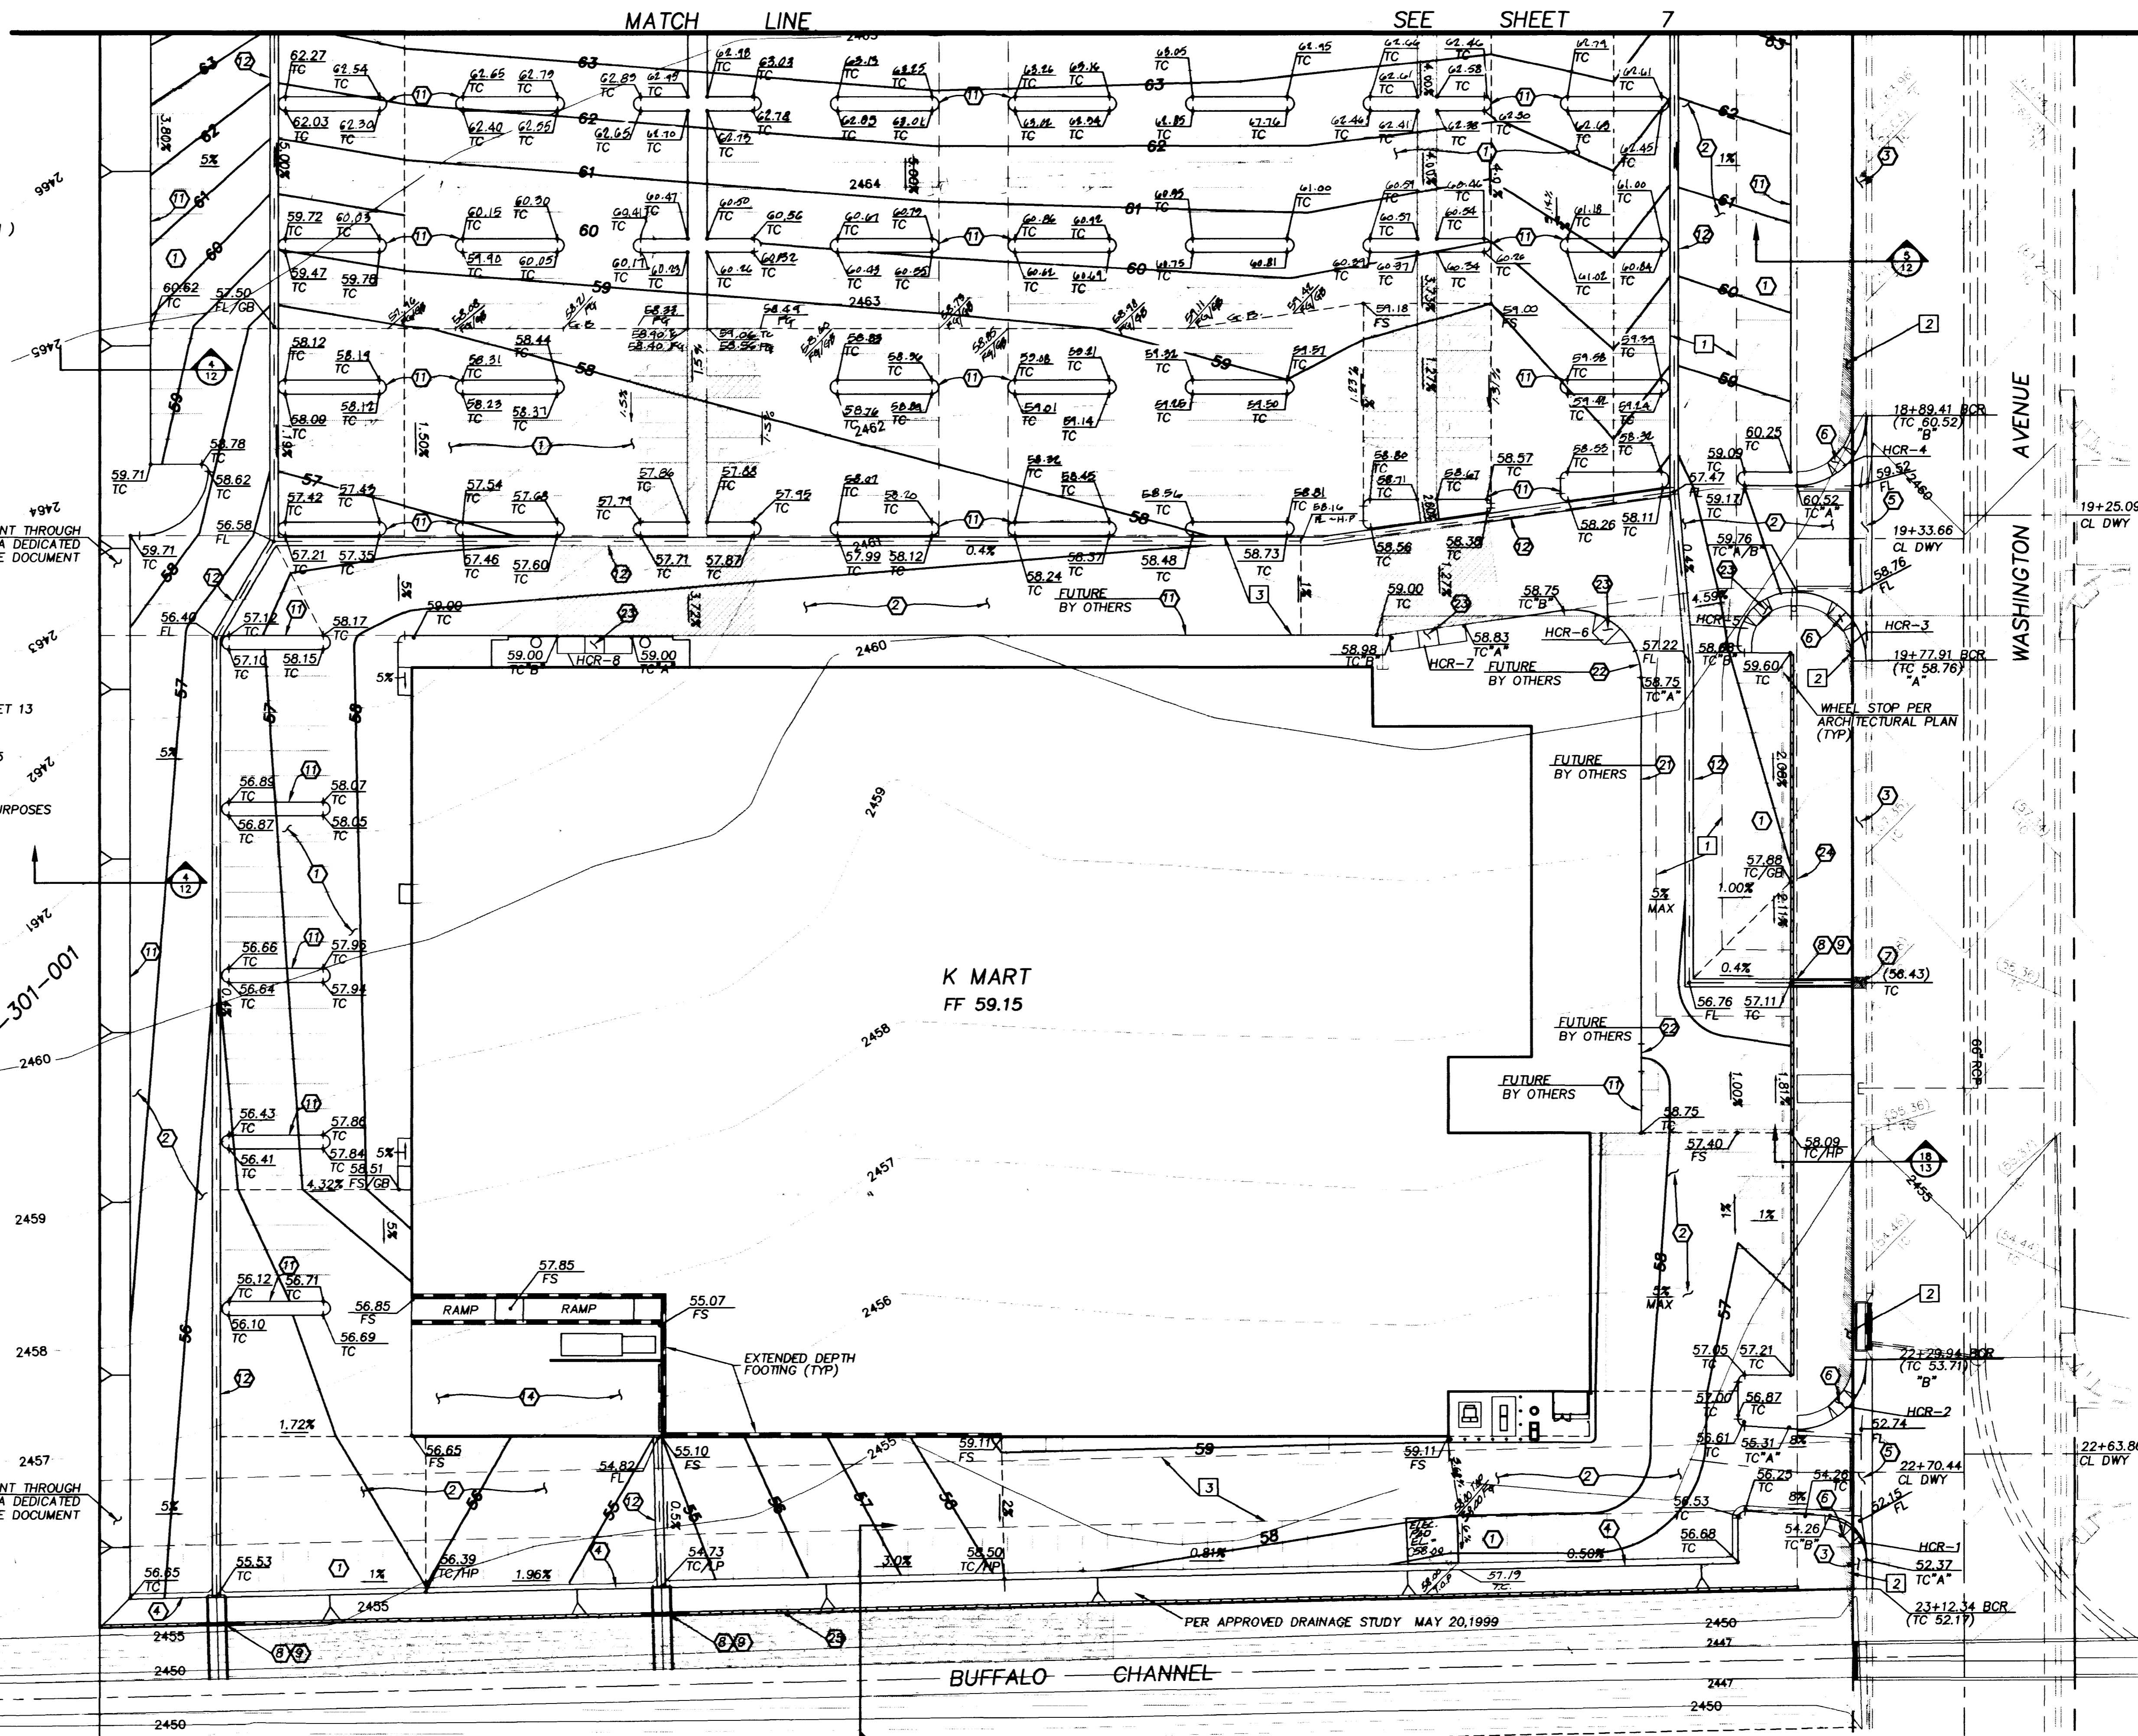

ACCESS EASEMENT THROUGH LANDSCAPE AREA DEDICATED PER SEPARATE DOCUMENT

PER APPROVED DRAINAGE STUDY MAY 20, 1999

Call before you Dig. It's a Law.
1-800-227-2600

AVOID HITTING OVERHEAD POWER LINES. IT'S COSTLY.
CALL BEFORE YOU DO OVERHEAD.
CALL 1-702-593-8111

DRAINAGE CERTIFICATION
I CERTIFY THAT THIS GRADING PLAN IS IN CONFORMANCE WITH THE APPROVED DRAINAGE STUDY ON FILE AT THE CITY OF LAS VEGAS FOR THIS PROJECT.

DATE: 6/2/1999
Signature: Kevin K. Elliott P.E. #12758

LAURICH PROPERTIES, INC. (K-MART #9389)
2500 WEST SARAH AVENUE, SUITE 211
LAS VEGAS, NV 89102
(702) 220-4500

AGRA Infrastructure, Inc.
ENGINEERING GLOBAL SOLUTIONS
CHARLESTON BOULEVARD, SUITE 180
LAS VEGAS, NEVADA 89102
PHONE: (702) 878-3617
FAX: (702) 878-3716

GRADING PLAN
K-MART #9389
7500 BLOCK OF WASHINGTON
300' EAST OF BUFFALO
CITY OF LAS VEGAS

SCALE: 1" = 30'

11 of 17 SHEETS
DRAWING NO. 107-V3110

J:\1998\100\98130\8130P602.dwg Thu Jun 10 09:16:55 1999








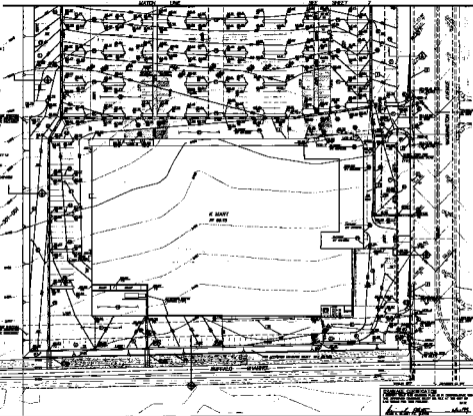


