



JADE PARK UNIT N^o 2

Being a Portion of the N¹/₂ of the SW¹/₄ of section 2, T.20S., R.60E., M.D.M.,
City of Las Vegas, County of Clark, State of Nevada

Curve Data														
N ^o	d	R	L	T	N ^o	d	R	L	T	N ^o	d	R	L	T
1	91°39'44"	15.00	24.00	15.44	23	34°42'03"	45.50	43.44	23.53	45	04°04'19"	214.09	15.34	7.48
2	14°12'57"	620.00	153.83	77.31	24	62°17'45"	45.50	49.47	27.50	46	25°34'50"	216.09	97.10	49.40
3	15°52'41"	529.44	145.64	72.99	25	18°52'17"	25.00	8.09	4.08	47	25°44'51"	216.09	97.10	49.39
4	15°52'41"	499.44	136.74	68.87	26	25°42'40"	25.00	11.22	5.71	48	53°34'00"	216.09	209.56	113.85
5	17°30'35"	463.44	99.10	46.70	27	06°02'23"	374.50	39.48	19.76	49	58°44'17"	241.59	247.67	135.76
6	78°29'25"	15.00	20.55	12.25	28	06°02'23"	400.00	42.17	21.70	50	15°25'29"	241.59	65.04	32.72
7	101°01'07"	15.00	26.45	18.20	29	06°02'23"	425.50	44.85	22.45	51	43°18'48"	241.59	182.43	95.93
8	171°42'05"	650.00	225.28	102.37	30	07°42'44"	425.50	20.14	10.07	52	26°35'20"	247.09	123.95	63.11
9	03°53'43"	650.00	45.34	22.65	31	03°10'39"	25.00	24.71	12.34	53	11°02'17"	247.09	53.32	22.09
10	03°53'43"	650.00	248.48	125.74	32	06°08'13"	25.00	41.90	20.78	54	14°18'28"	247.09	65.53	32.93
11	17°02'18"	680.00	209.27	101.86	33	24°34'17"	25.00	11.41	5.91	55	01°05'35"	247.09	5.10	2.55
12	07°24'25"	680.00	87.91	44.01	34	149°14'57"	60.00	156.29	218.19	56	64°43'	25.00	28.24	14.84
13	05°40'41"	680.00	67.39	34.72	35	31°33'32"	60.00	33.05	16.94	57	159°29'50"	60.00	47.02	23.67
14	03°57'12"	680.00	46.92	23.47	36	38°11'50"	60.00	40.00	20.74	58	32°29'01"	60.00	33.27	17.79
15	96°01'11"	15.00	25.14	16.64	37	38°11'49"	60.00	40.00	20.74	59	48°25'12"	60.00	50.71	26.95
16	83°58'49"	15.00	21.98	13.50	38	41°17'46"	60.00	43.24	22.41	60	44°19'07"	60.00	44.21	24.84
17	90°00'00"	15.00	23.54	15.00	39	16°29'28"	25.00	7.20	3.62	61	34°36'04"	60.00	36.28	18.63
18	44°14'57"	25.00	19.31	10.16	40	10°06'49"	25.00	4.41	2.21	62	61°45'52"	25.00	24.95	14.95
19	268°29'54"	45.50	213.22	101.09	41	55°34'00"	111.09	107.74	58.59	63	02°02'18"	271.59	9.66	4.83
20	40°48'00"	45.50	31.88	16.62	42	25°44'51"	111.09	49.92	25.39	64	83°53'58"	20.00	29.29	17.28
21	60°59'34"	45.50	48.44	26.80	43	25°44'50"	111.09	49.92	25.39	65	60°10'16"	20.00	41.00	11.59
22	50°22'12"	45.50	40.00	21.40	44	04°04'19"	111.09	7.83	3.95	66	23°35'42"	20.00	3.29	4.40

Legend

- 5' Utility Easement
- ◇ Monument and
- Monument Set
- (16) Curve Number
- (4) Block Number
- 34 Lot Number
- 20' Front Set Back
- 15' Side Set Back

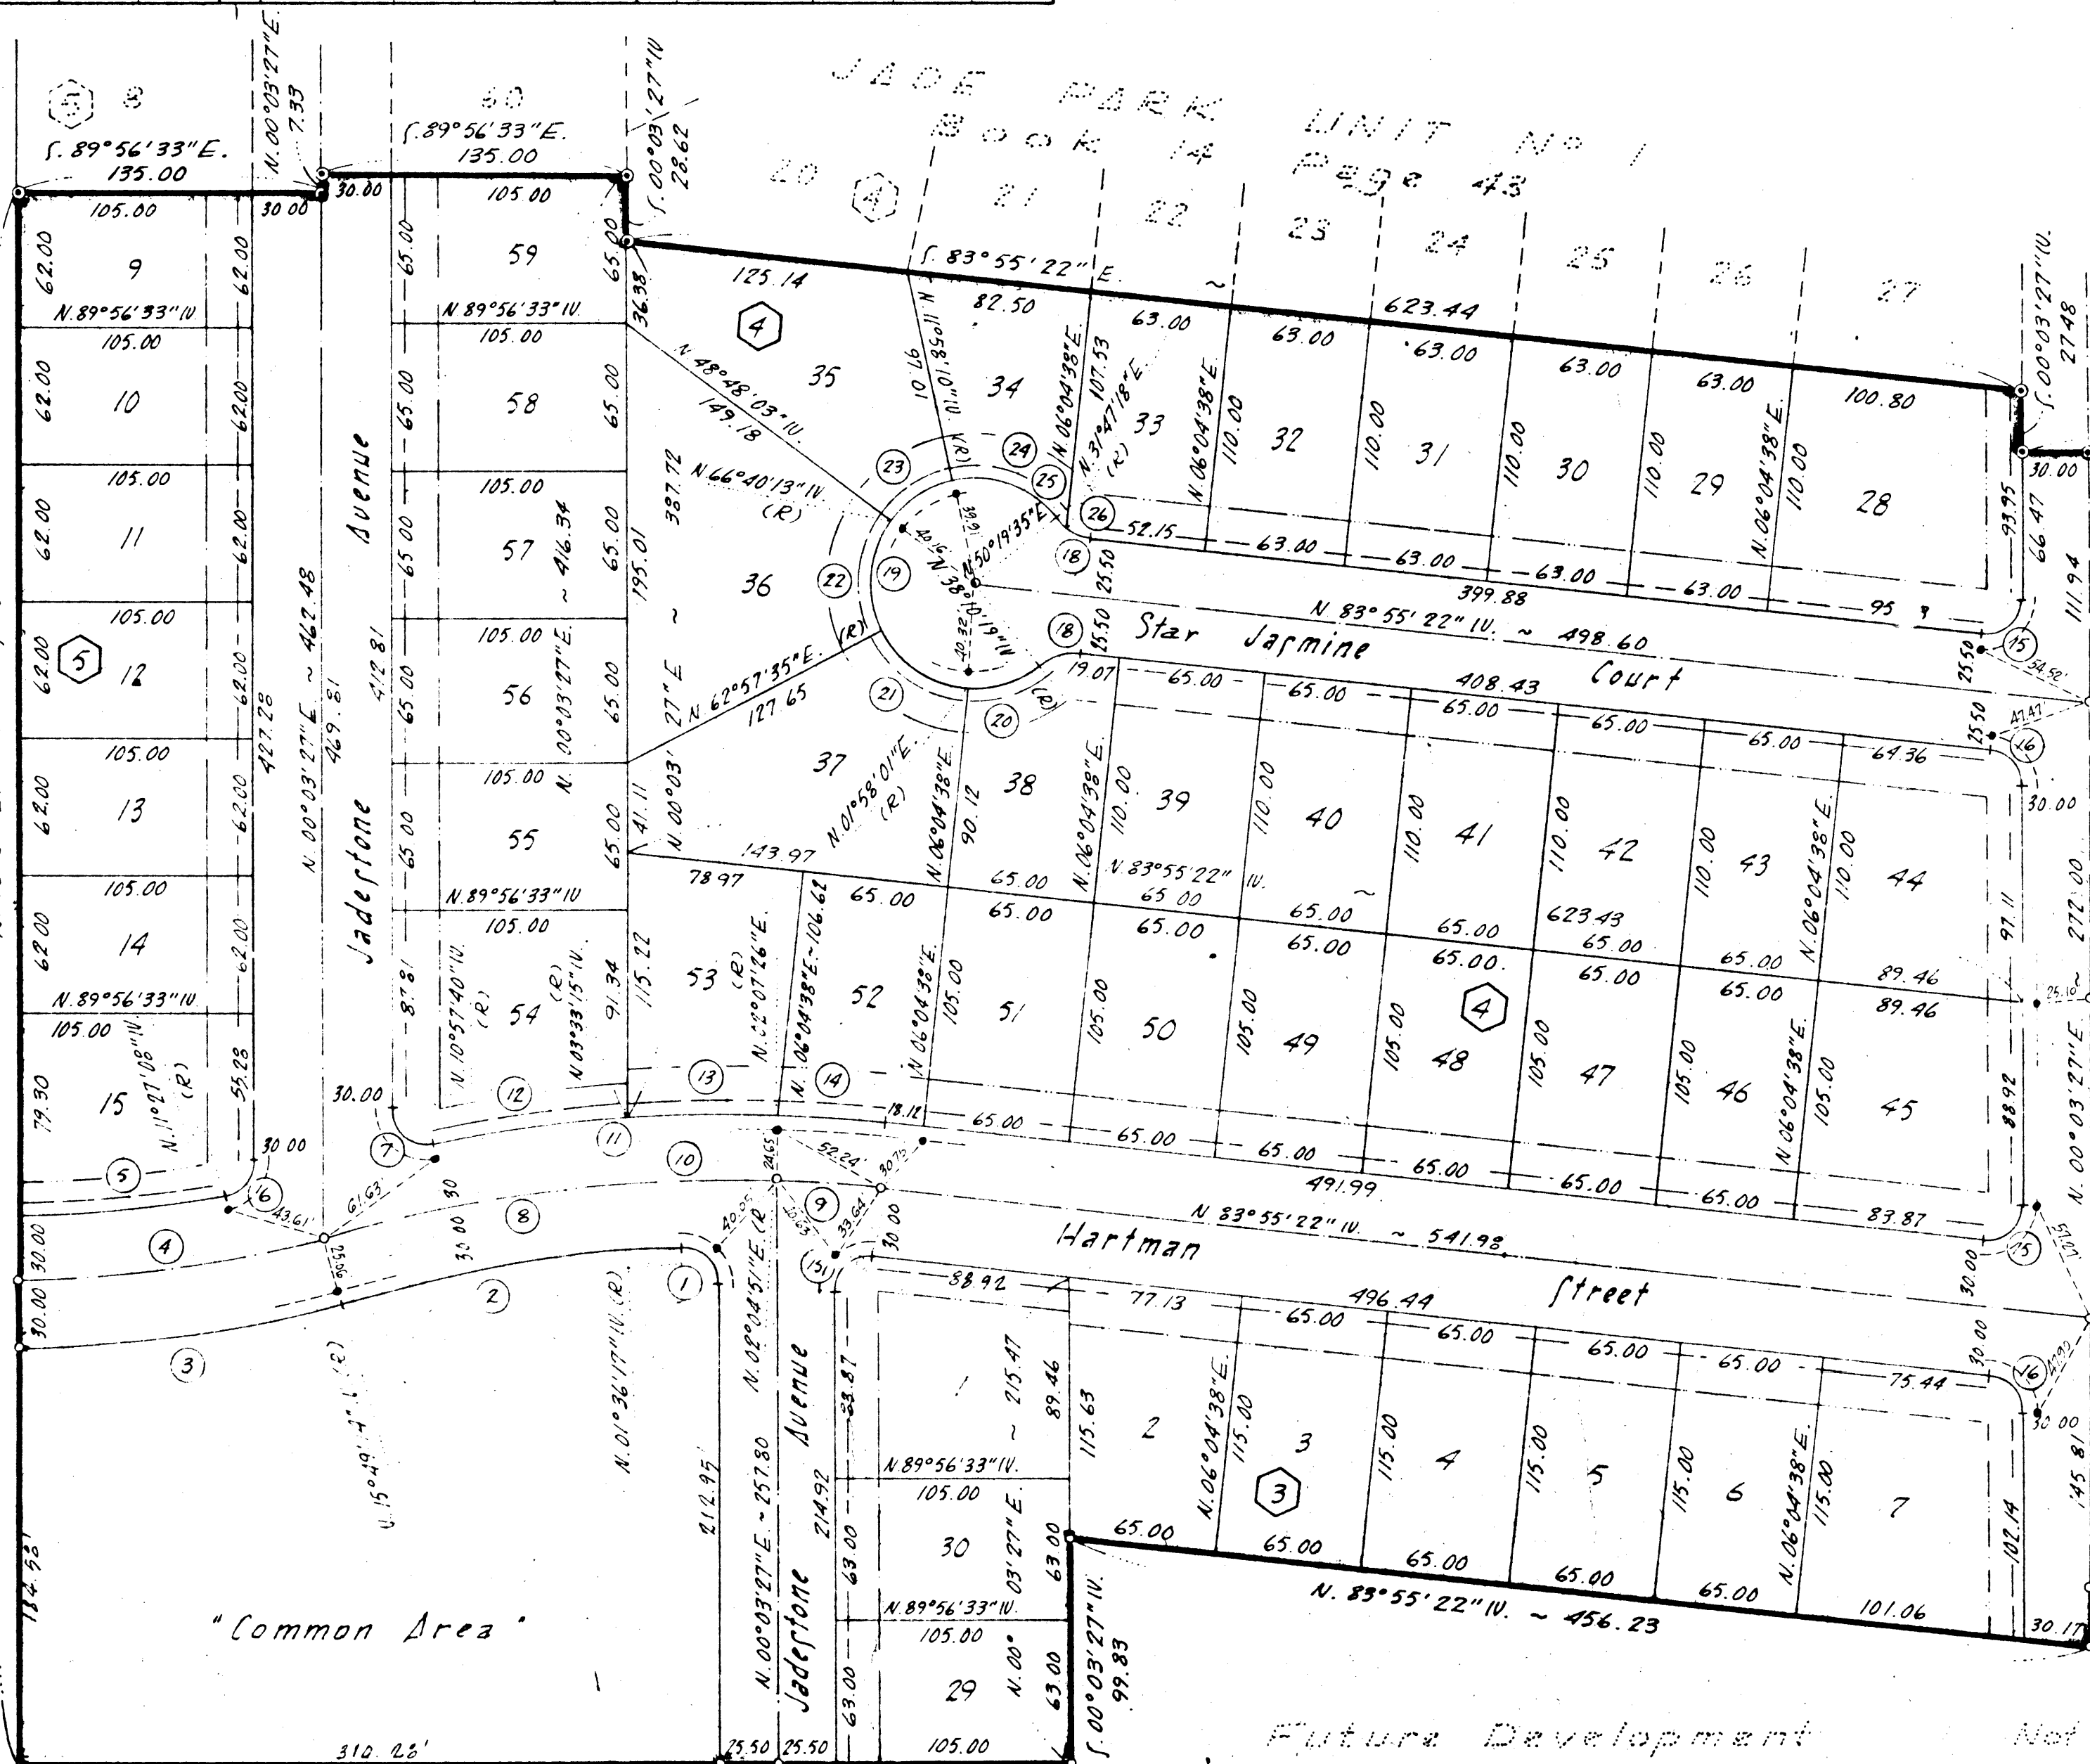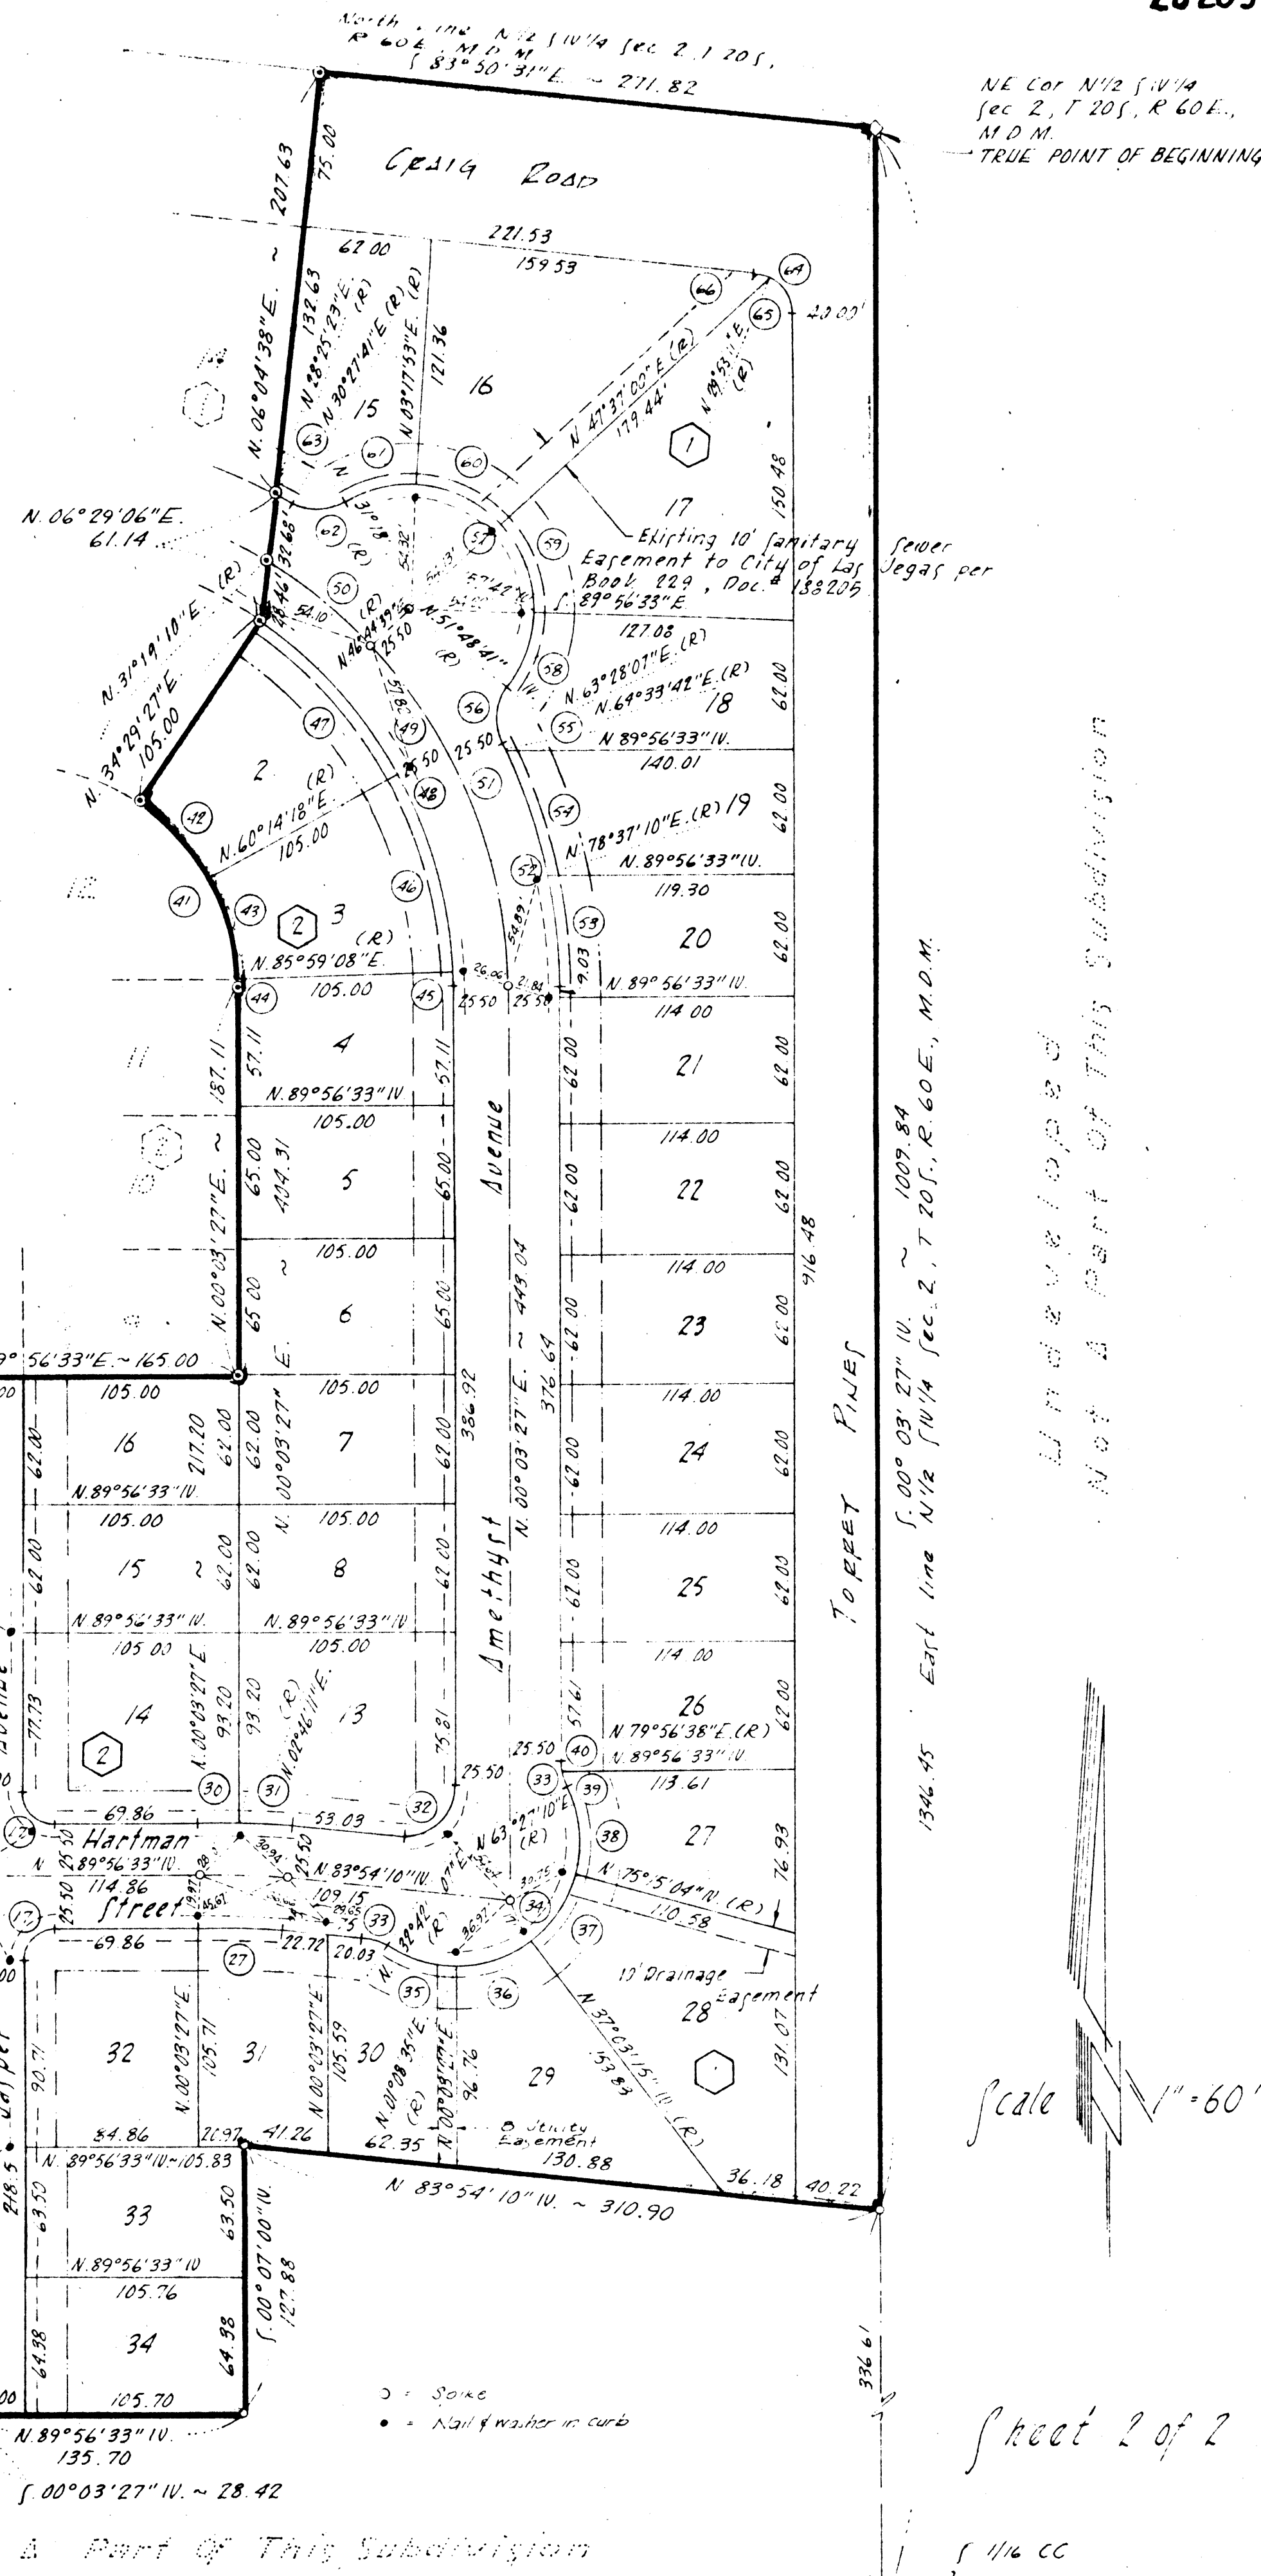

Not a Part of This Subdivision

Not a Part of This Subdivision

Scale 1" = 60'

Sheet 2 of 2

MONUMENTATION MAP - 6/15/74