

Book 2036

LEWIS HOMES — SAHARA NO. 12-C

1995805

A PORTION OF THE SOUTH HALF (S.1/2) OF THE SOUTHWEST QUARTER (SW.1/4)
OF SECTION 2, T. 21 S., R. 60 E., M.D.M.
CITY OF LAS VEGAS, CLARK COUNTY, NEVADA

WILDWOOD RANCH
ESTATES NO. 2
Bk. 18 - Pg. 79

REDWOOD ST.

SW 1/16
S. 2


FND. BRASS CAP
RLS 4046

UNDEVELOPED

EXIST. R/W

FND. 5/8" REBAR
AND ALUM. CAP
R.L.S. 2050

S 1/16
C.C.

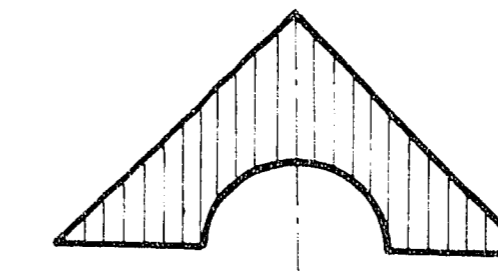

SCALE: 1" = 50'

S 1/16
3-2
FND. 5/8" REBAR
AND ALUM. CAP
R.L.S. 2050
LEWIS HOMES
SAHARA NO. 12-B

RAINBOW BLVD.

UNDEVELOPED

N 02°40'14" W ~ 1578.03'

5091.4

7150'

6900'

6900'

FND. NAIL
AND TIN

W 1/16
2
11

UNDEVELOPED

SAHARA AVE.

FND. N.H.D.
BRASS CAP

1/4 COR.
2
11

LEGEND

- 13 LOT NUMBER
- (A) BLOCK NUMBER
- LEGAL BOUNDARY
- SETBACK:
20' MIN. FRONT YARD
15' MIN. SIDE YARD - CORNER
- FND. MON. AS SHOWN
- SET NAIL AND BRASS TAG R.L.S. 2050 W/
BRASS CAP REF. TIES SET IN T.O.C.


CURVE DATA

NO.	Δ	R	L	T
1	87°15'19"	15.00'	22.84'	14.30'
2	92°44'41"	15.00'	24.28'	15.74'
23	87°15'19"	25.00'	38.07'	23.83'
24	24°27'12"	50.00'	21.49'	10.91'
25	126°29'43"	60.00'	142.94'	150.37'
26	30°20'56"	60.00'	31.78'	16.27'
27	42°23'04"	60.00'	44.39'	23.26'
28	46°53'58"	60.00'	49.11'	26.03'
29	16°51'45"	60.00'	17.66'	8.89'

SURVEYOR'S CERTIFICATE

THIS IS TO CERTIFY THAT THE MONUMENTS HAVE BEEN SET AND TIES ESTABLISHED AS SHOWN HEREON.

Ray J. Adams
RAY J. ADAMS
REGISTERED LAND SURVEYOR
NEVADA CERTIFICATE NO. 2050

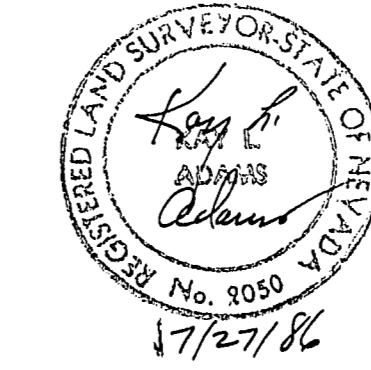

MONUMENT TIE MAP

SHEET 2 OF 2

5-6-133

058-2027-12C

BOOK 32 PAGE 45